


4


3

2

1

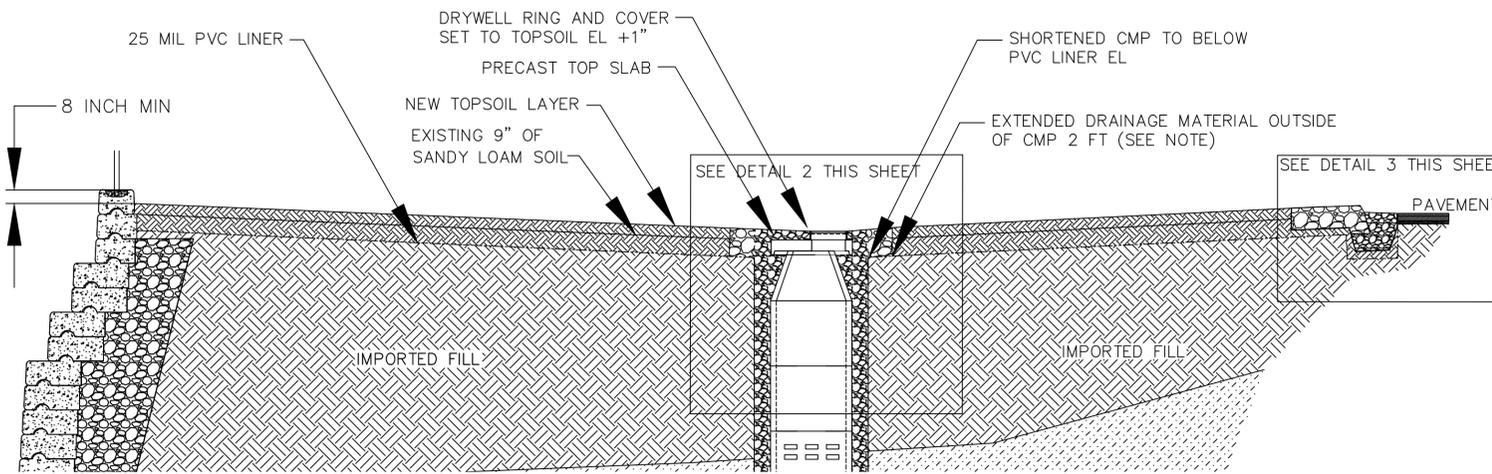

1 IMPROVED DRAINAGE DETAIL
 NOT TO SCALE

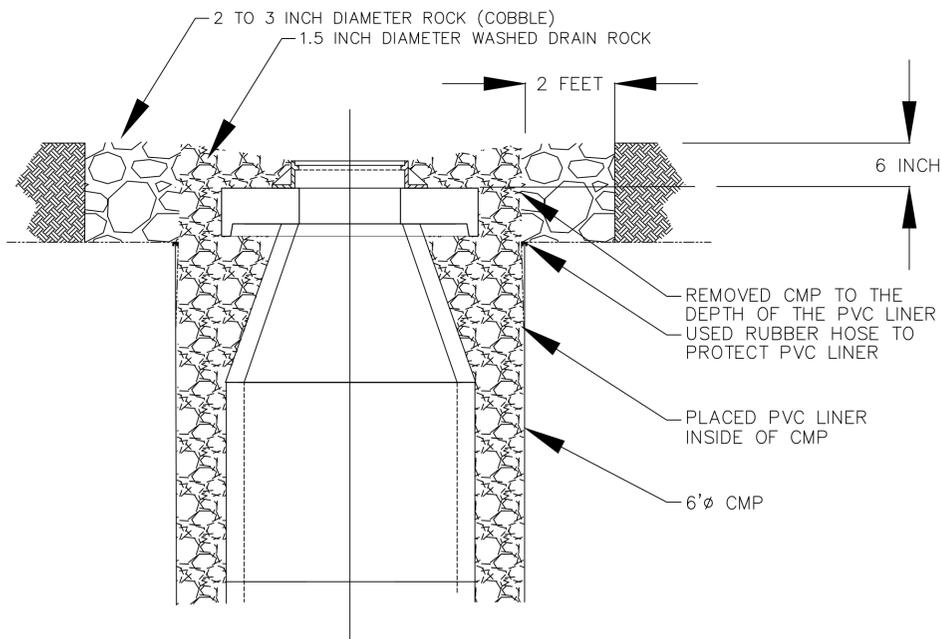


2 DRYWELL DRAINAGE DETAIL
 NOT TO SCALE

DRAINAGE MATERIAL SPECIFICATION NOTES

1. WASHED ROCK APRON PLACED ALONG PARKING LOT TO EXISTING SANDY LOAM LAYER INTERFACE CONSISTS OF 1.5-INCH WASHED DRAIN ROCK, AND A TRANSITION OF 2 TO 3-INCH WASHED DRAIN ROCK (COBBLE) WAS PLACED AT THE NEW TOPSOIL INTERFACE (SEE DETAIL 3 THIS SHEET). GEOTEXTILE AT THE INTERFACE MATCHES GEOTEXTILE SPECIFICATIONS (SEE NOTE THIS SHEET).
2. DRYWELL DRAINAGE TO BE PLACED AROUND THE DRYWELL UP TO THE GRADE OF THE DRYWELL INLET CONSISTS OF 1.5-INCH WASHED DRAIN ROCK WITH 2 TO 3 INCH WASHED DRAIN ROCK(COBBLE) TO THE GRASS (SEE DETAIL 1 THIS SHEET).

GEOTEXTILE NOTES

1. GEOTEXTILE WAS USED AS A SEPARATION MATERIAL BETWEEN ASBESTOS-CONTAMINATED FILL MATERIALS AND THE RETAINING WALL AGGREGATE DRAINAGE LAYER, BETWEEN ASBESTOS-CONTAMINATED FILL AND CLEAN FILL IN DRY POND AREAS, AND AS NEEDED TO SEPARATE ASBESTOS CONTAMINATED FILL FROM CLEAN FILL OR SOIL LAYERS FROM AGGREGATE LAYERS.

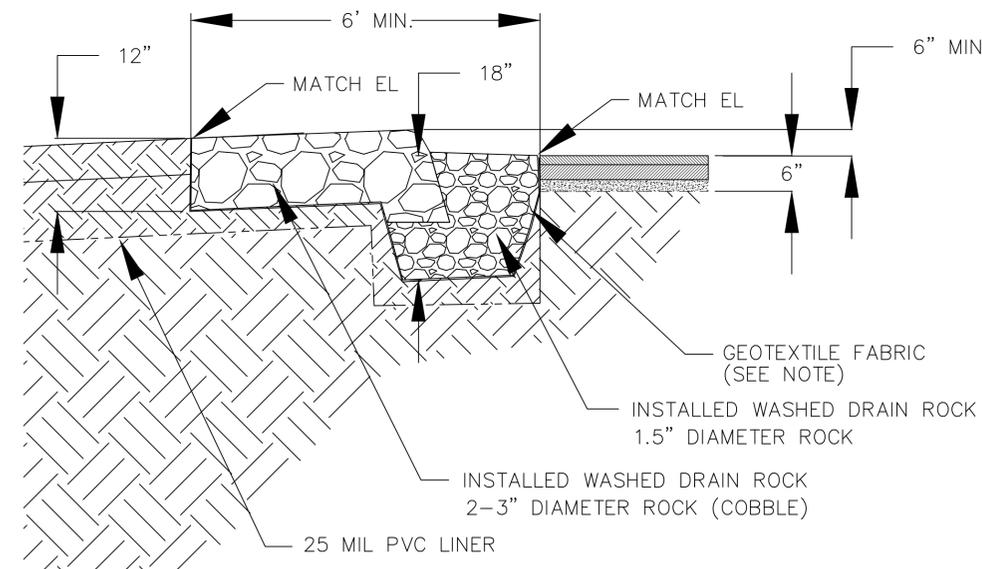

3 GRAVEL APRON DETAIL
 NOT TO SCALE

RECORD
DRAWING



Symbol	Description	Date	TC	Approver
1	RECORD DRAWING ISSUED	07-14-15	TC	
0	ISSUED FOR CONSTRUCTION	04-17-15	TC	

SIZE D
IF SHEET IS LESS THAN 22"X34" IT IS REDUCED PRINT-SCALE REDUCED ACCORDINGLY
ONE INCH

Date	Rev.
07/2015	1

Designed by: M. FULTON
 Drawn by: TCC
 Spec. No.: 14-07-0012
 Reviewed by: S. HALL
 Approved by: ANJUCPELL
 IDAHO REGISTRATION NO. 1013846
 File name: Orefine_041715.dwg
 Plot date: 05-28-2015
 Dwg. Date: 05-28-2015

ecology and environment, inc.
 Global Environmental Specialists
 333 SW Fifth Avenue, Suite 600
 Portland, Oregon 97204
 (503) 248-5600



IDAHO
 CLEARWATER COUNTY
 2015 SITE RESTORATION REPAIRS
 OROFINO, CLEARWATER COUNTY, IDAHO
 DRY RETENTION BASIN
 DRAINAGE DETAILS

Sheet reference number:
C-3
 SHEET 3 OF 6