

EXHIBIT A

1044086

- LEGEND**
- o - VALVE
  - - PUMP
  - - FILTER
  - a - CENTRIFUGE
  - b - FILTER SYSTEM
  - c - HEATER
  - △ - FIRE EXTINGUISHERS

BLUE LINES - TREATED WATER TO POTW  
 BLACK LINES - FLOC TRANSFER  
 GREEN LINES - UNTREATED WATER TRANSFER  
 RED LINES - OIL PROCESS TRANSFER  
 PURPLE LINES - CHEMICAL FEED

REVISED and UPDATED  
 March 30, 1994  
 REVISED and UPDATED  
 March 20, 1995

RECEIVED  
 MAR 30 1994  
 Industrial Pre-treatment

RECEIVED  
 MAR 30 1994  
 Industrial Pre-treatment

(PROPOSED)


SLUDGE (PROPOSED) RECEIVING

WATER (PROPOSED) FROM FILTER PRESS

SLUDGE (PROPOSED) FILTER PRESS

RECEIVED  
 MAR 30 1994  
 Industrial Pre-treatment

REVISED and UPDATED  
 March 20, 1994

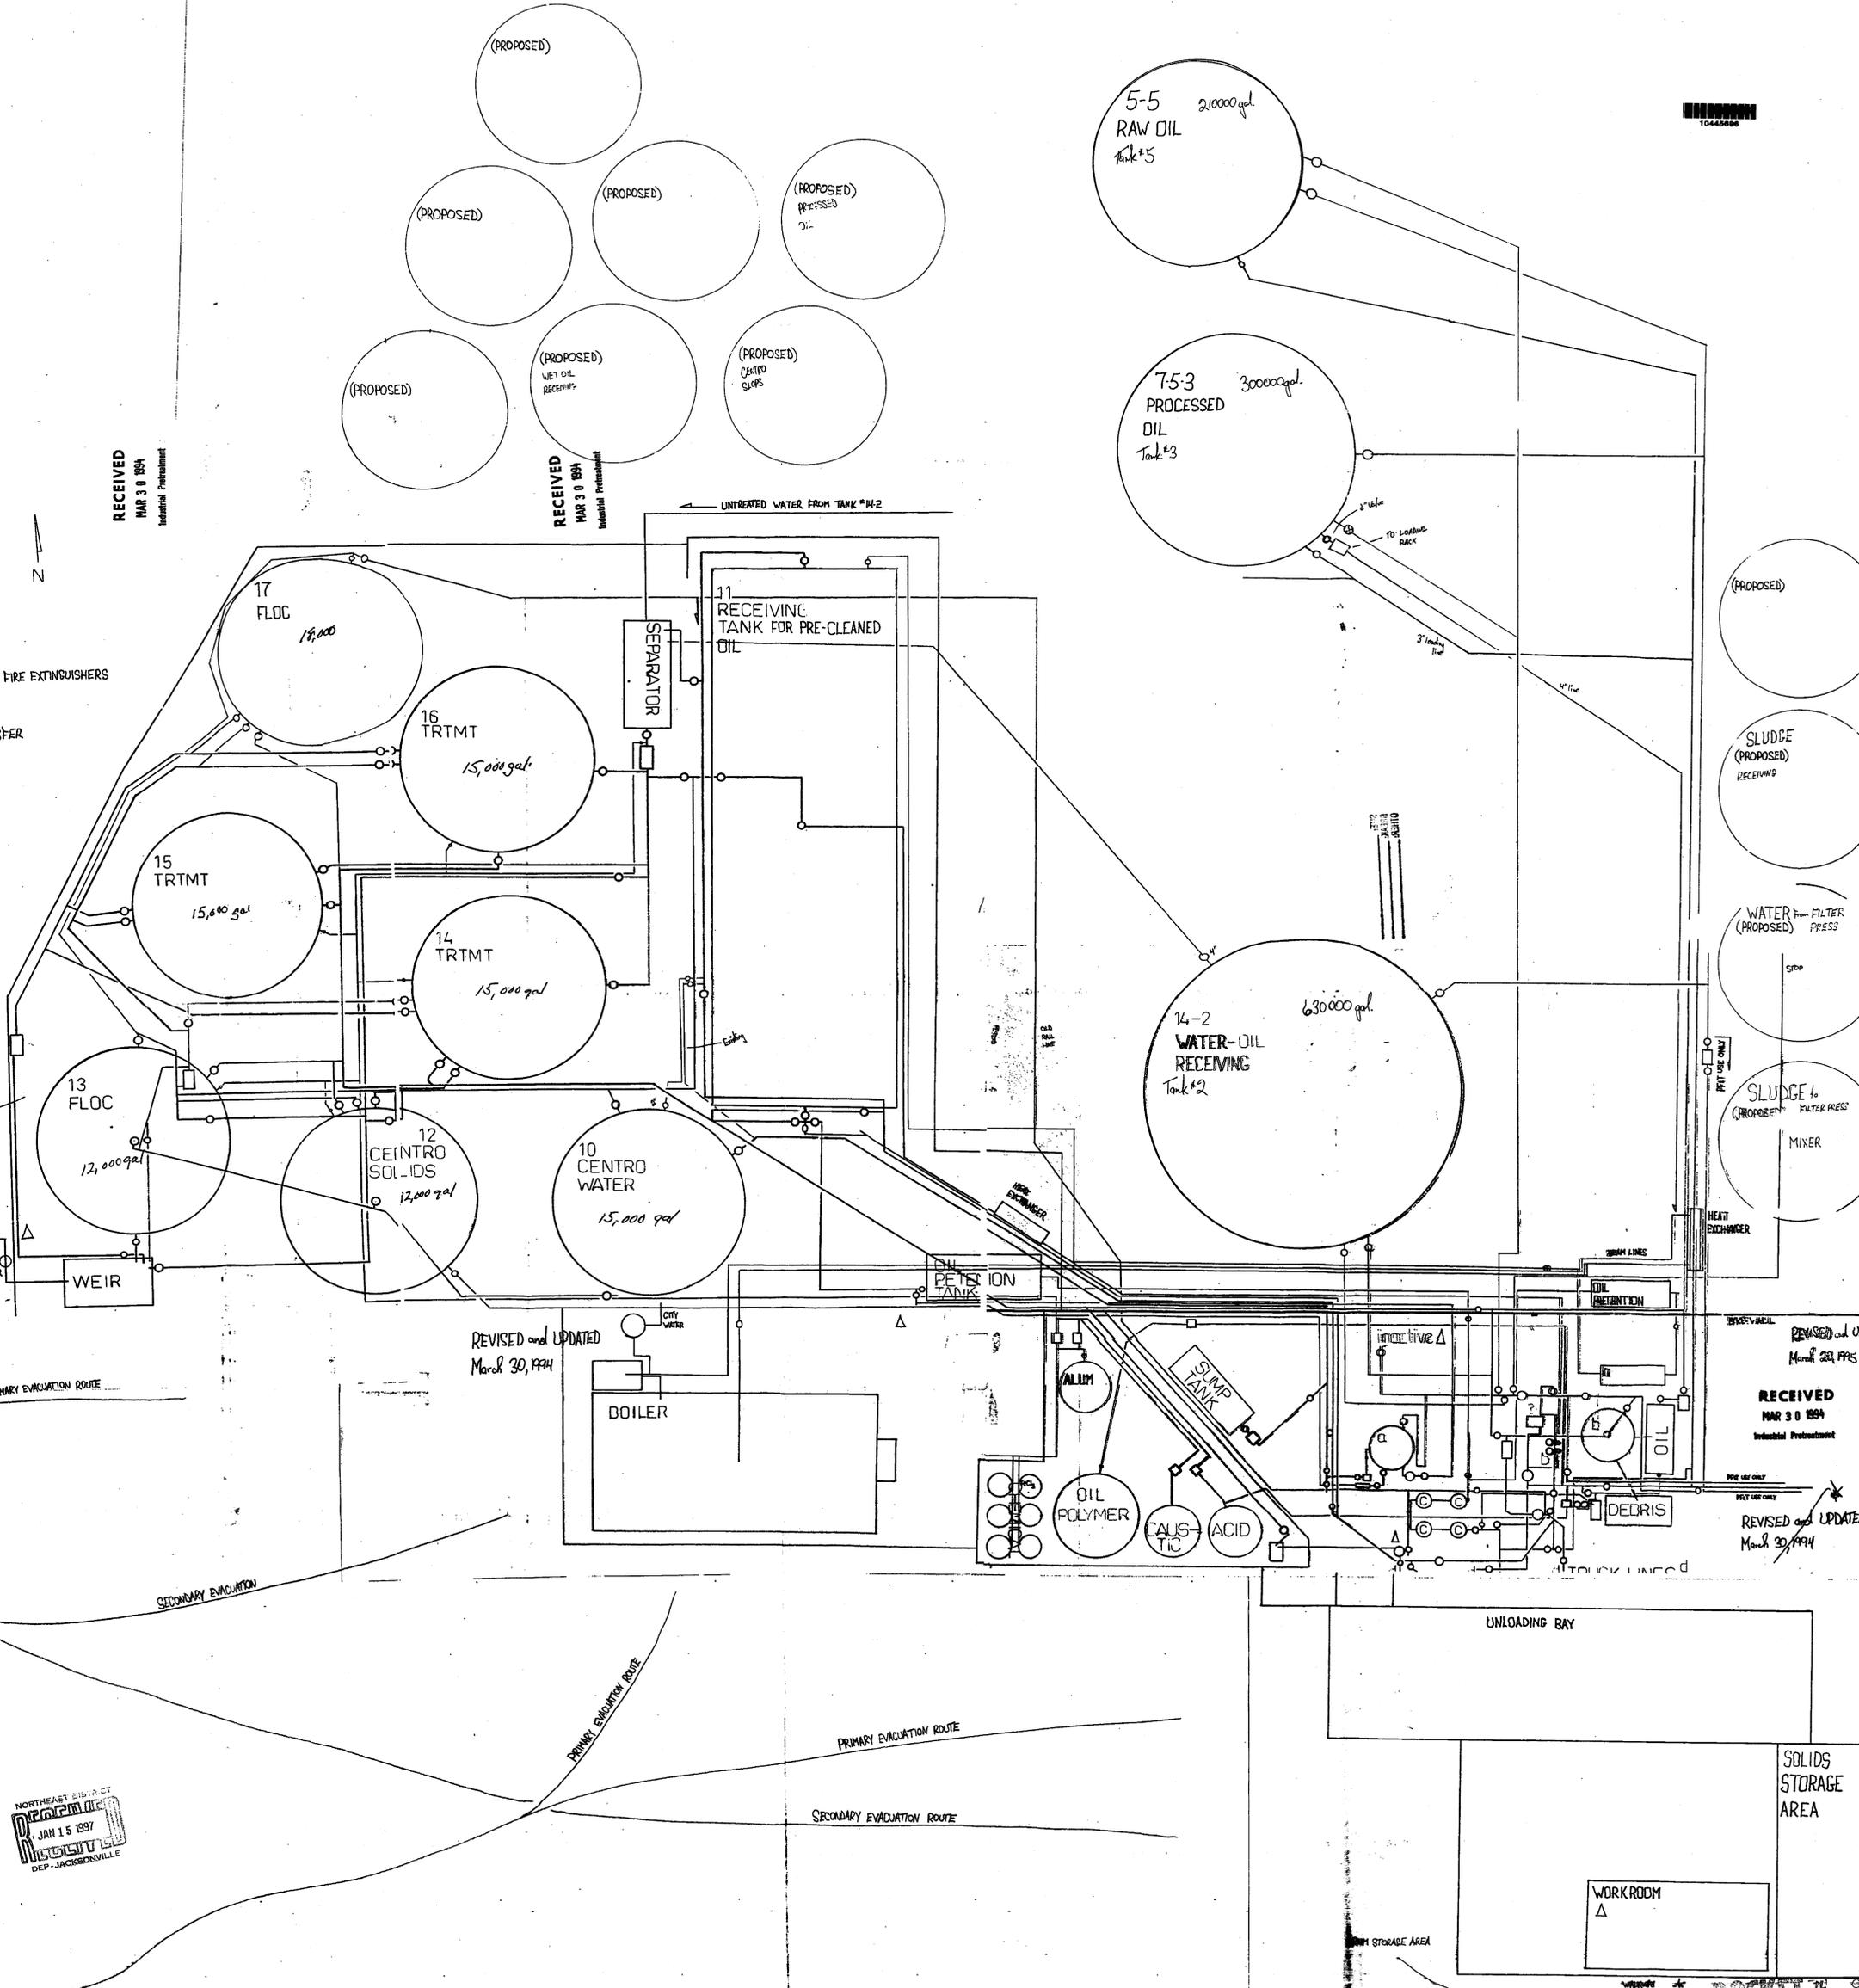

NORTH EAST DISTRICT  
 RECEIVED  
 JAN 15 1997  
 DEP - JACKSONVILLE

EXHIBIT A

IP

USE

DRUM STORAGE AREA DOCKET # 971

BRYAN ST.

E. ADAMS ST.