
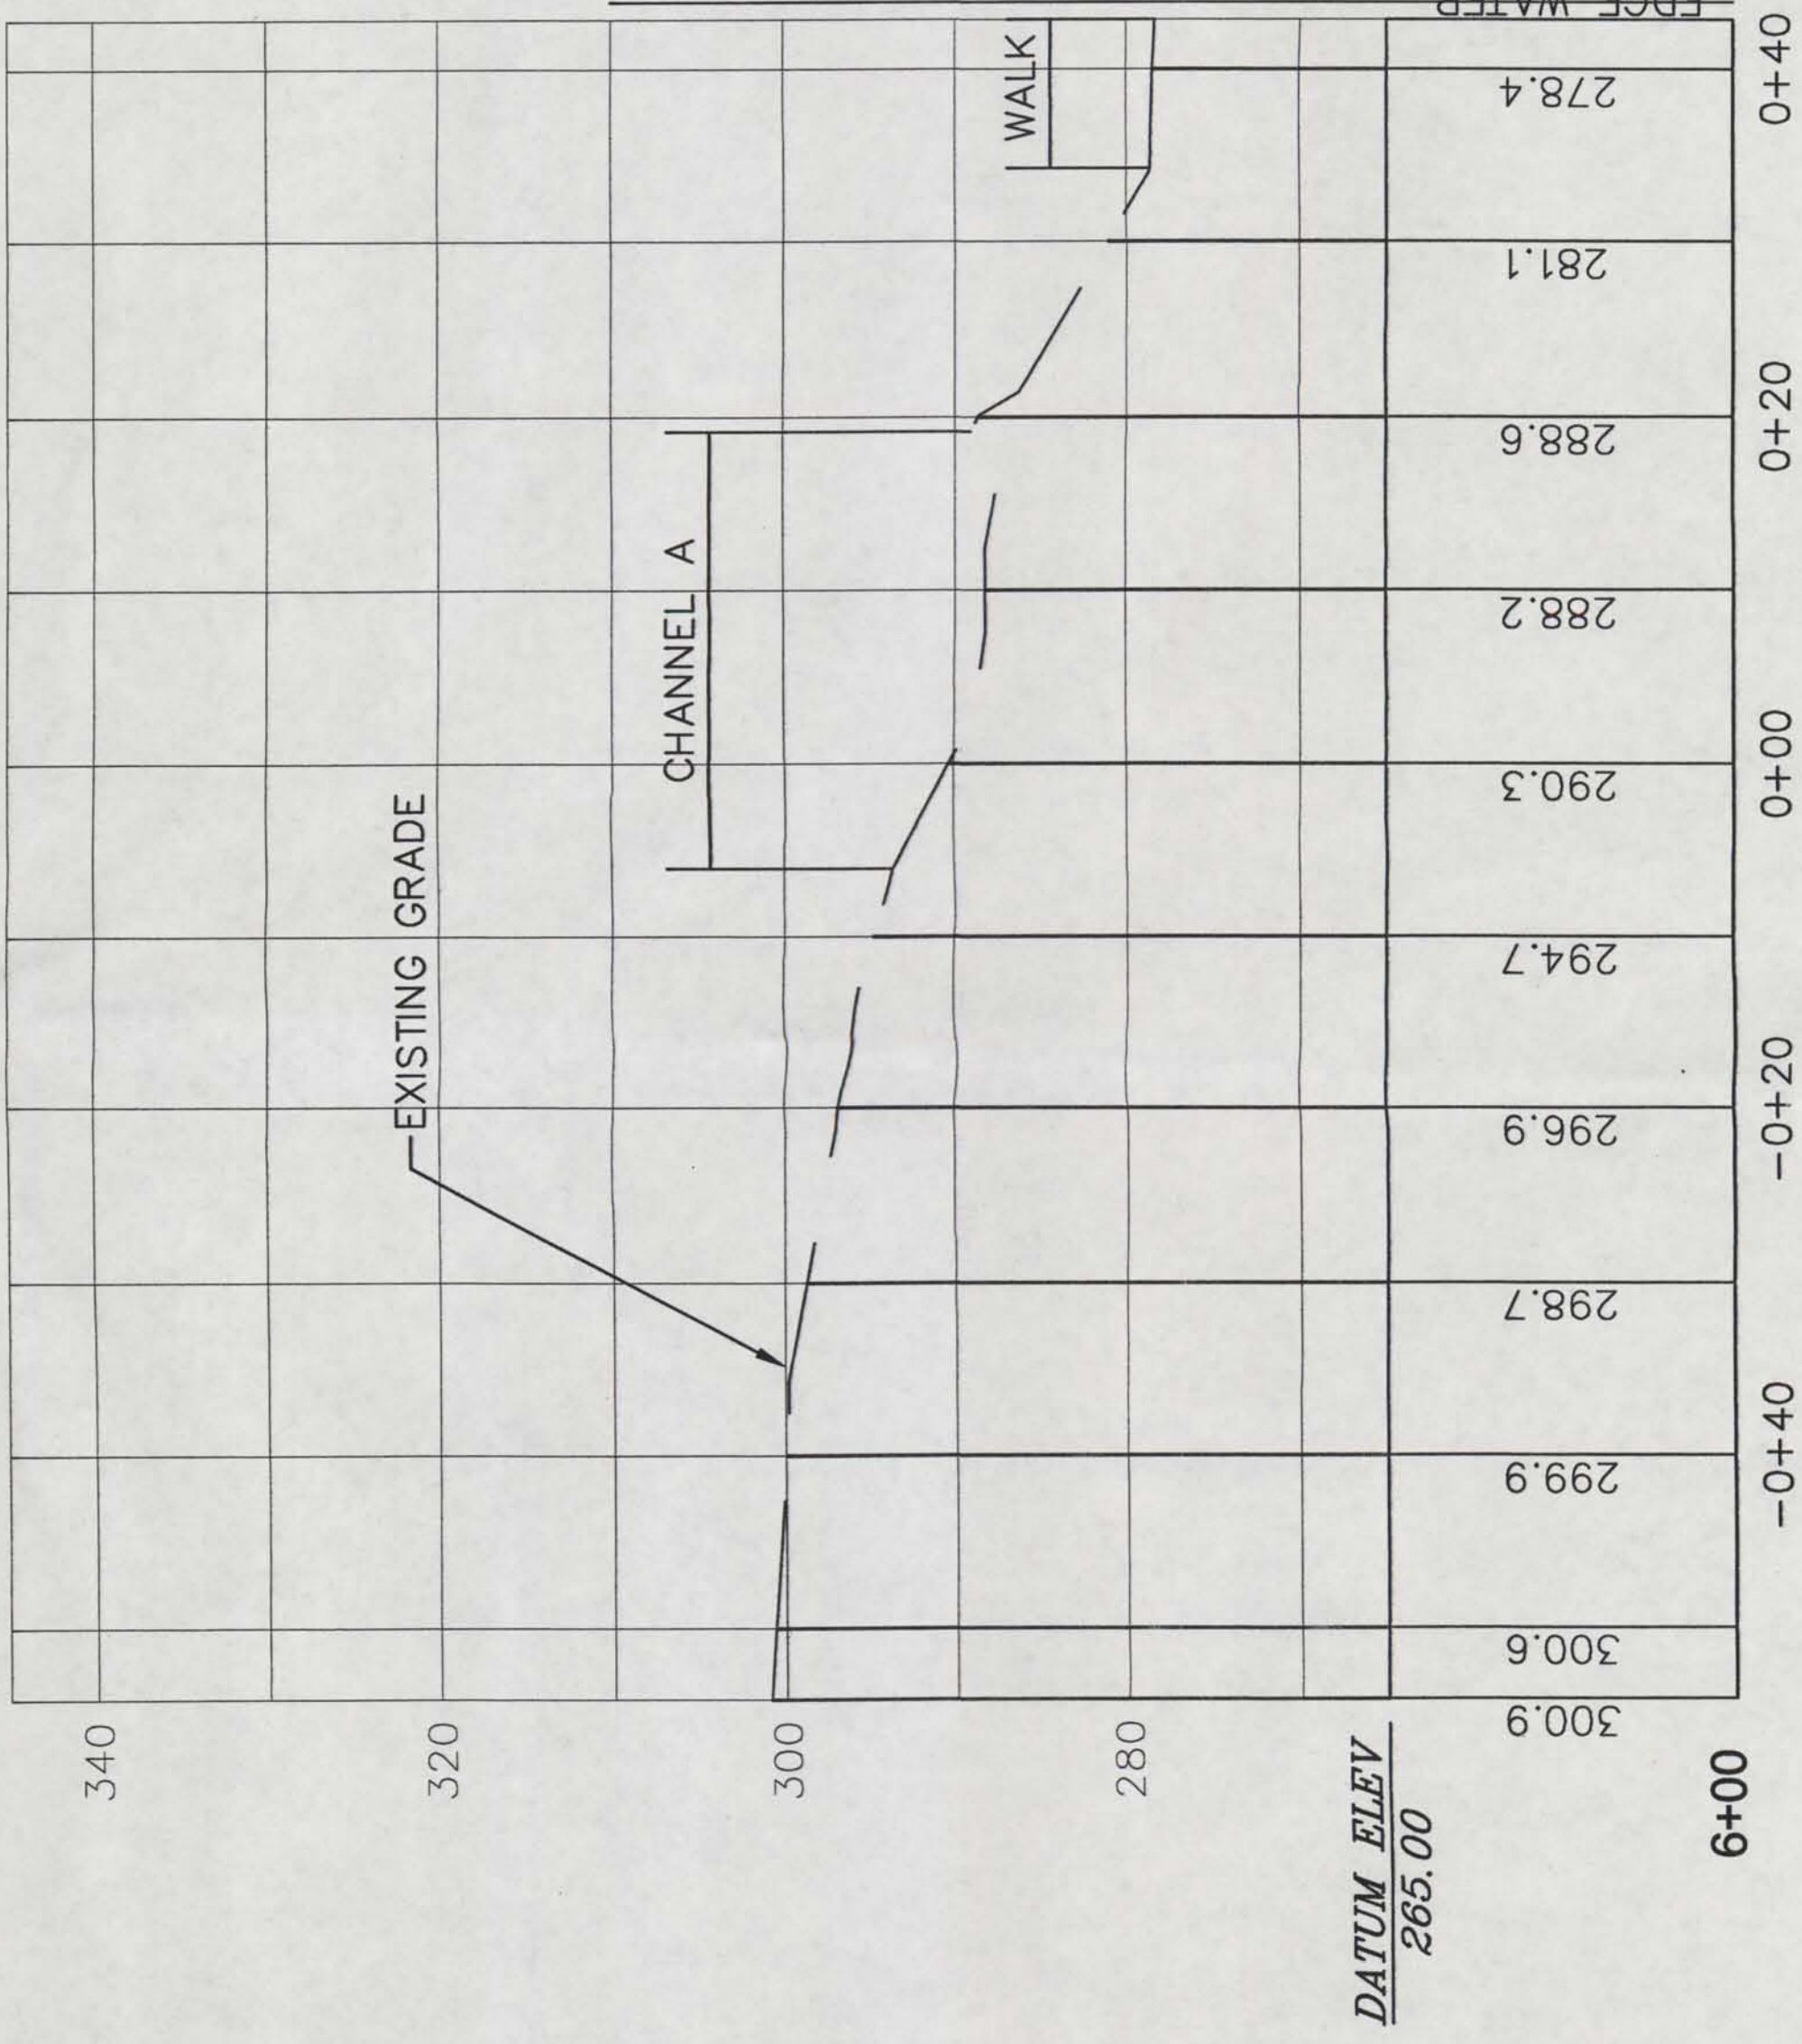


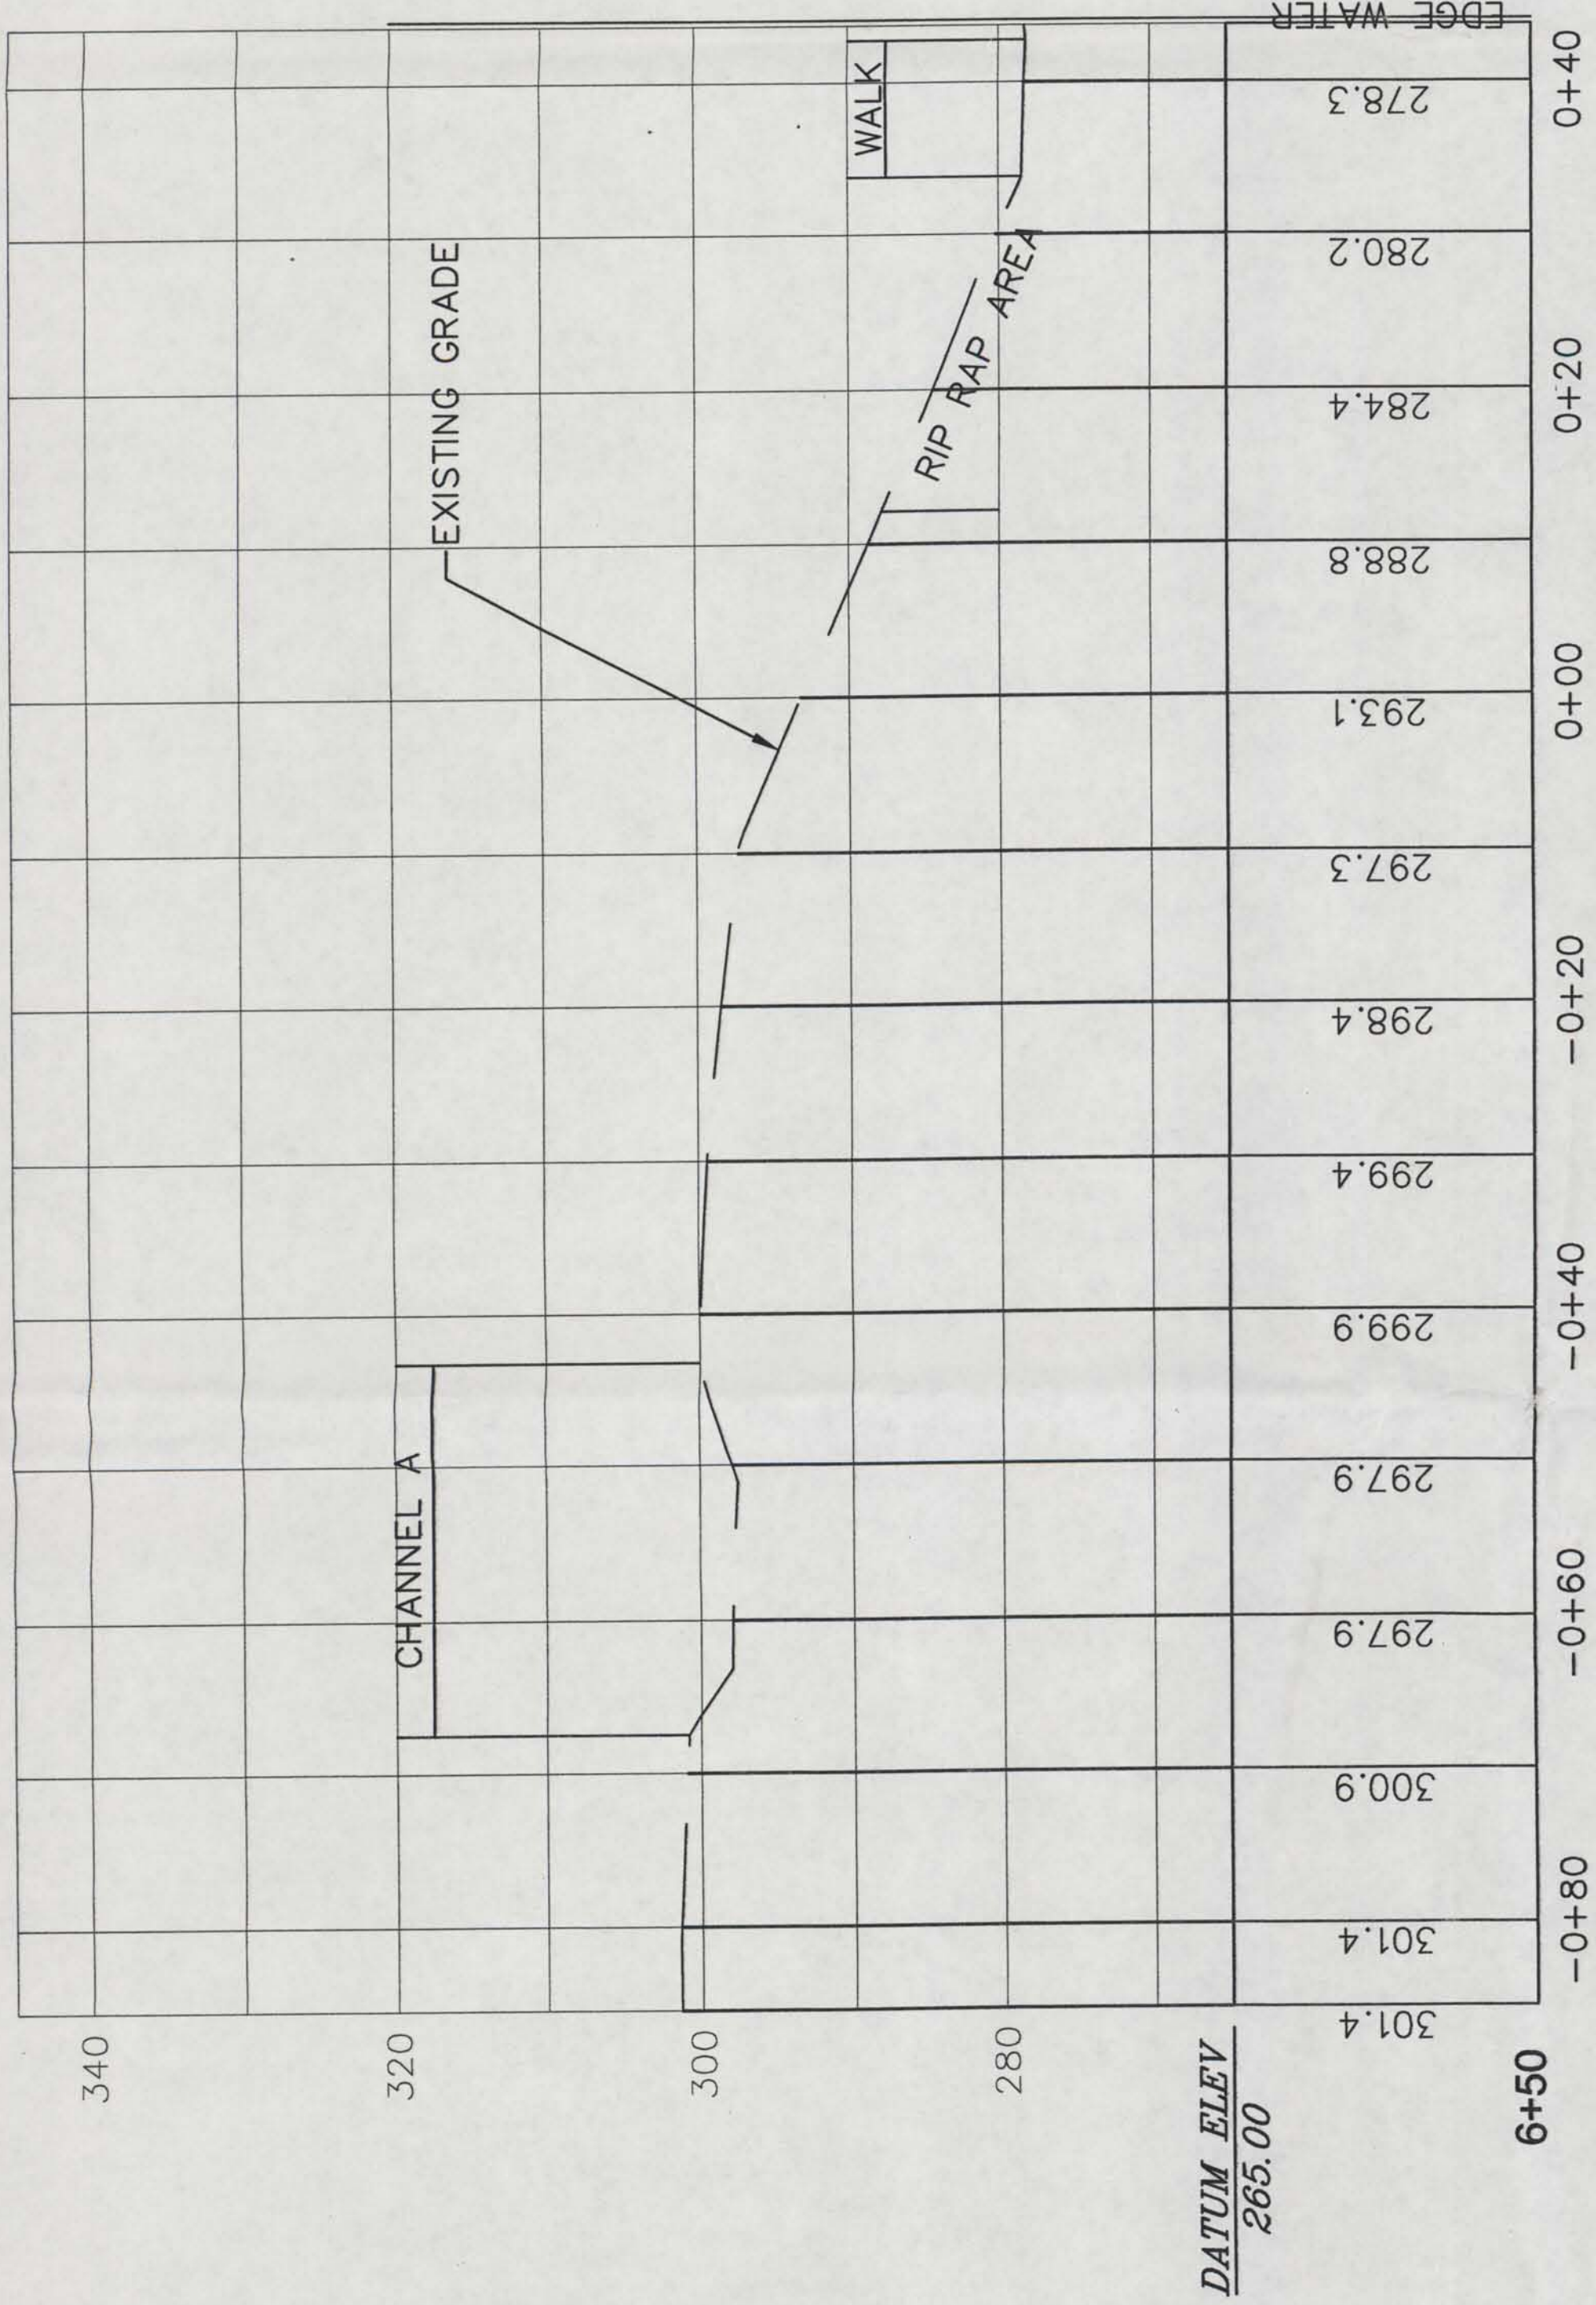

**UTILITIES Disclaimer:**  
The underground utilities shown have been located from field survey information and existing drawings. The utility owner is responsible for the accuracy of the underground utilities shown comprise all such utilities in the area either in service or abandoned. The engineer does not warrant that the location of the underground utilities shown are in the exact location indicated although he does declare that they are located as accurately as possible from information available. The engineer does not warrant that the location of the underground utilities shown are not physically located the underground utilities.

REVISIONS TO THESE PLANS BY ANYONE OTHER THAN KJA SHALL MAKE THESE PLANS NULL AND VOID. KJA SHALL TAKE NO RESPONSIBILITY FOR SAID REVISIONS.

|           |                                     |
|-----------|-------------------------------------|
| REVISION: |                                     |
| REVISION: |                                     |
| REVISION: |                                     |
| PROJECT:  | 202\CS1\Watertown-201382-chasebrass |
| DRAWN BY: |                                     |
| SEAL:     |                                     |

**SURVEY NOTES:**  
THIS MAP HAS BEEN PREPARED IN ACCORDANCE WITH THE PROFESSIONAL STANDARDS FOR SURVEYING AND MAPS IN THE STATE OF CONNECTICUT AS ADOPTED FOR USE BY THE REGULATIONS OF CONNECTICUT STATE AGENCIES ON SEPTEMBER 25, 1995. (C) SECTIONS 20-3000-1 TO 20-3000-20.

THE TYPE OF SURVEY PERFORMED IS AN: IMPROVEMENT LOCATION MAP.

BOUNDARY DETERMINATION IS BASED UPON: A DEPENDENT RESURVEY.

THIS SURVEY CONFORMS TO A: CLASS A-2 & T-2.

TO THE BEST OF MY KNOWLEDGE AND BELIEF THIS MAP IS SUBSTANTIALLY CORRECT AS NOTED HEREON.

*John D. Kratzert*  
CIVIL ENGINEER  
CT P.E. & L.S. #13302

**kratzert, jones & associates, inc.**  
CIVIL ENGINEERS • LAND SURVEYORS  
SITE PLANNERS • BUILDING ENGINEERS

P.O. BOX 337  
1755 MAIN STREET, WATERBURY RD.  
WATERBURY, CT 06497-0337  
PHONE: (860) 621-3638  
FAX: (860) 621-5839  
EMAIL: [kja@aol.com](mailto:kja@aol.com)

# AS-BUILT CROSS SECTIONS

for  
Watertown Construction

CHASE BRASS  
AND COPPER  
SITE

WATERBURY, CT

SCALE: 1" = 10'

DATE: MAY 13, 2002

ONE INCHES TWO INCHES  
INCHES ON ORIGINAL

KJA FILE NO. : DRAWING NO. :

201-382 05-1