
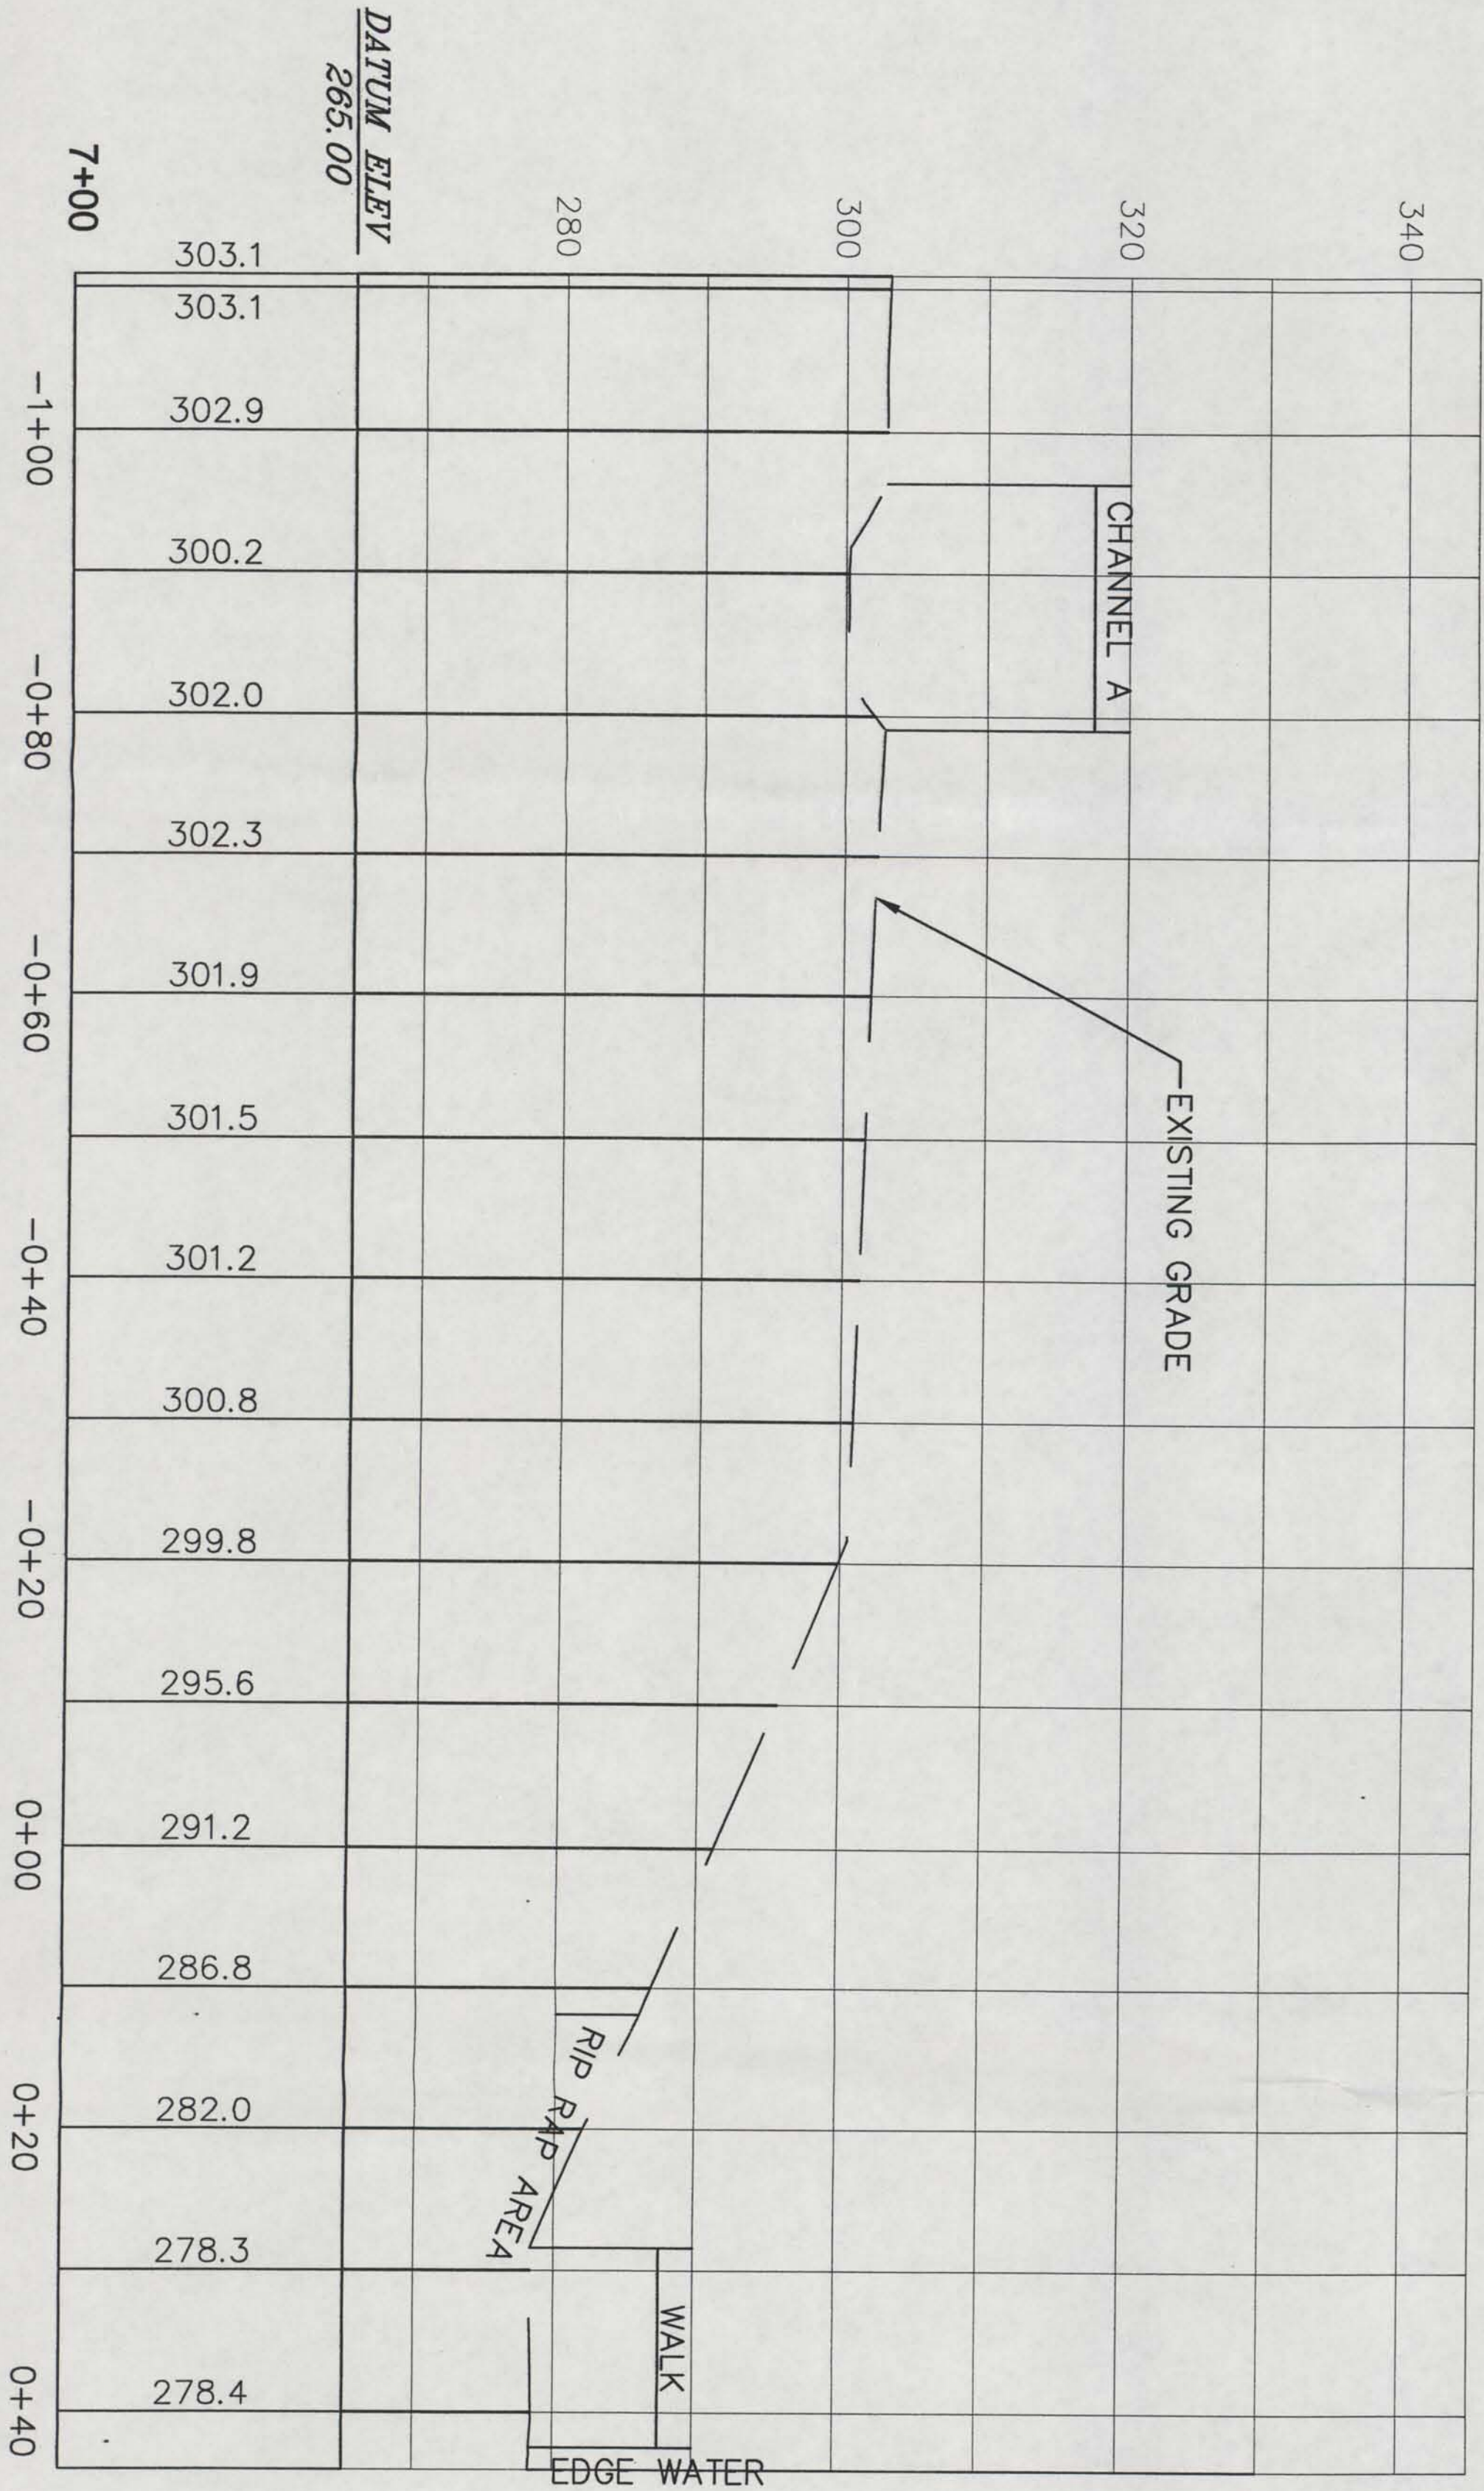


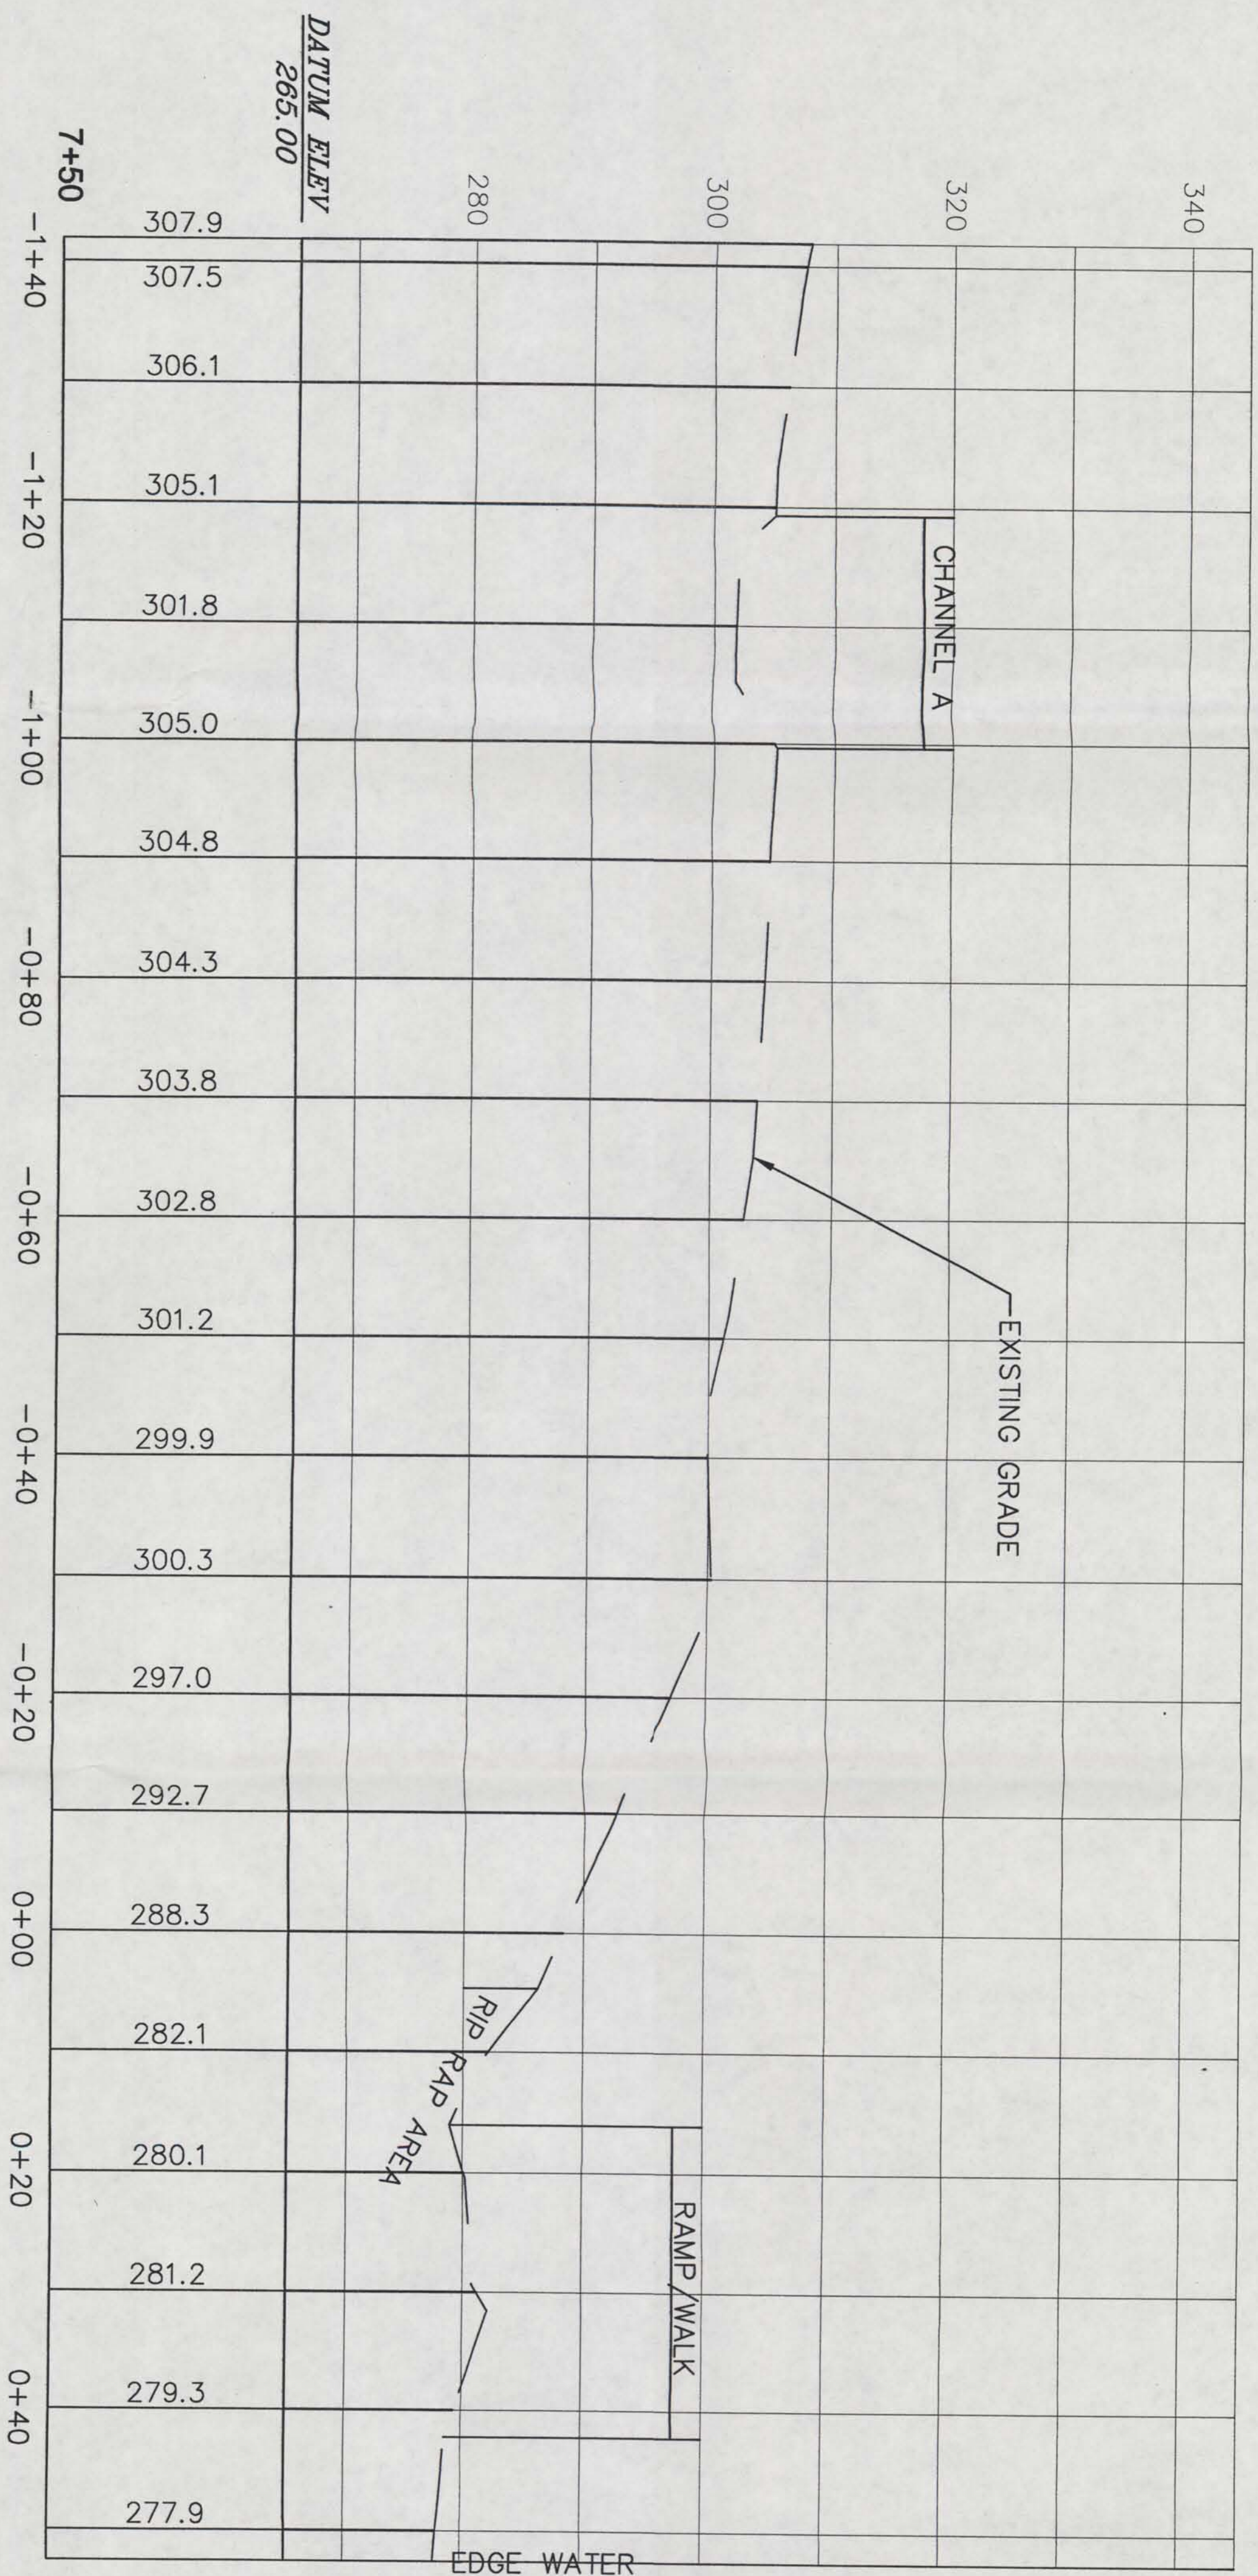

Utilities Disclaimer:
The underground utilities shown have been located from field survey information and existing drawings. The surveyor makes no guarantee that the location, depth, or condition of the utilities shown is correct. The surveyor further does not warrant that the information shown on this drawing is the exact location of the utilities. The surveyor has not physically located the underground utilities.

REVISIONS TO THESE PLANS BY ANYONE OTHER THAN THE SURVEYOR SHALL BE AT THE SURVEYOR'S RISK. K&A SHALL TAKE NO RESPONSIBILITY FOR SAID REVISIONS.

REVISION:
REVISION:
REVISION:
PROJECT: 202\CS1\watertown-201382-chasebrass
DRAWN BY:
SCALE:

SURVEY NOTES:
THIS MAP HAS BEEN PREPARED IN ACCORDANCE WITH THE SURVEYING STANDARDS FOR SURVEYS AND MAPS IN THE STATE OF CONNECTICUT ADOPTED FOR USE BY THE REGULATIONS OF THE CONNECTICUT STATE AGENCIES ON SEPTEMBER 20, 2000.
THE TYPE OF SURVEY PERFORMED IS AN: IMPROVED LOCATION MAP.
BOUNDARY DETERMINATION IS BASED UPON: A DEPENDENT RESURVEY.
THIS SURVEY CONFORMS TO A: CLASS A-2 & I-2.
TO THE BEST OF MY KNOWLEDGE AND BELIEF THIS MAP IS SUBSTANTIALLY CORRECT AS NOTED HEREON.

James J. Kratzert
CIT PE & LS #11302

Kratzert, Jones & associates, inc.
CIVIL ENGINEERS AND SURVEYORS
SITE PLANNERS BUILDING ENGINEERS
P.O. BOX 337
WATERBURY, CT 06702-0337
PHONE: (860) 621-3538
FAX: (860) 621-3539
EMAIL: K&A@K&A.COM

AS-BUILT CROSS SECTIONS

for
Watertown Construction
CHASE BRASS AND COPPER SITE
WATERBURY, CT

SCALE: 1" = 10'
DATE: MAY 13, 2002
K&A FILE NO.:
DRAWING NO.:
201-382
INCHES ON ORIGINAL