
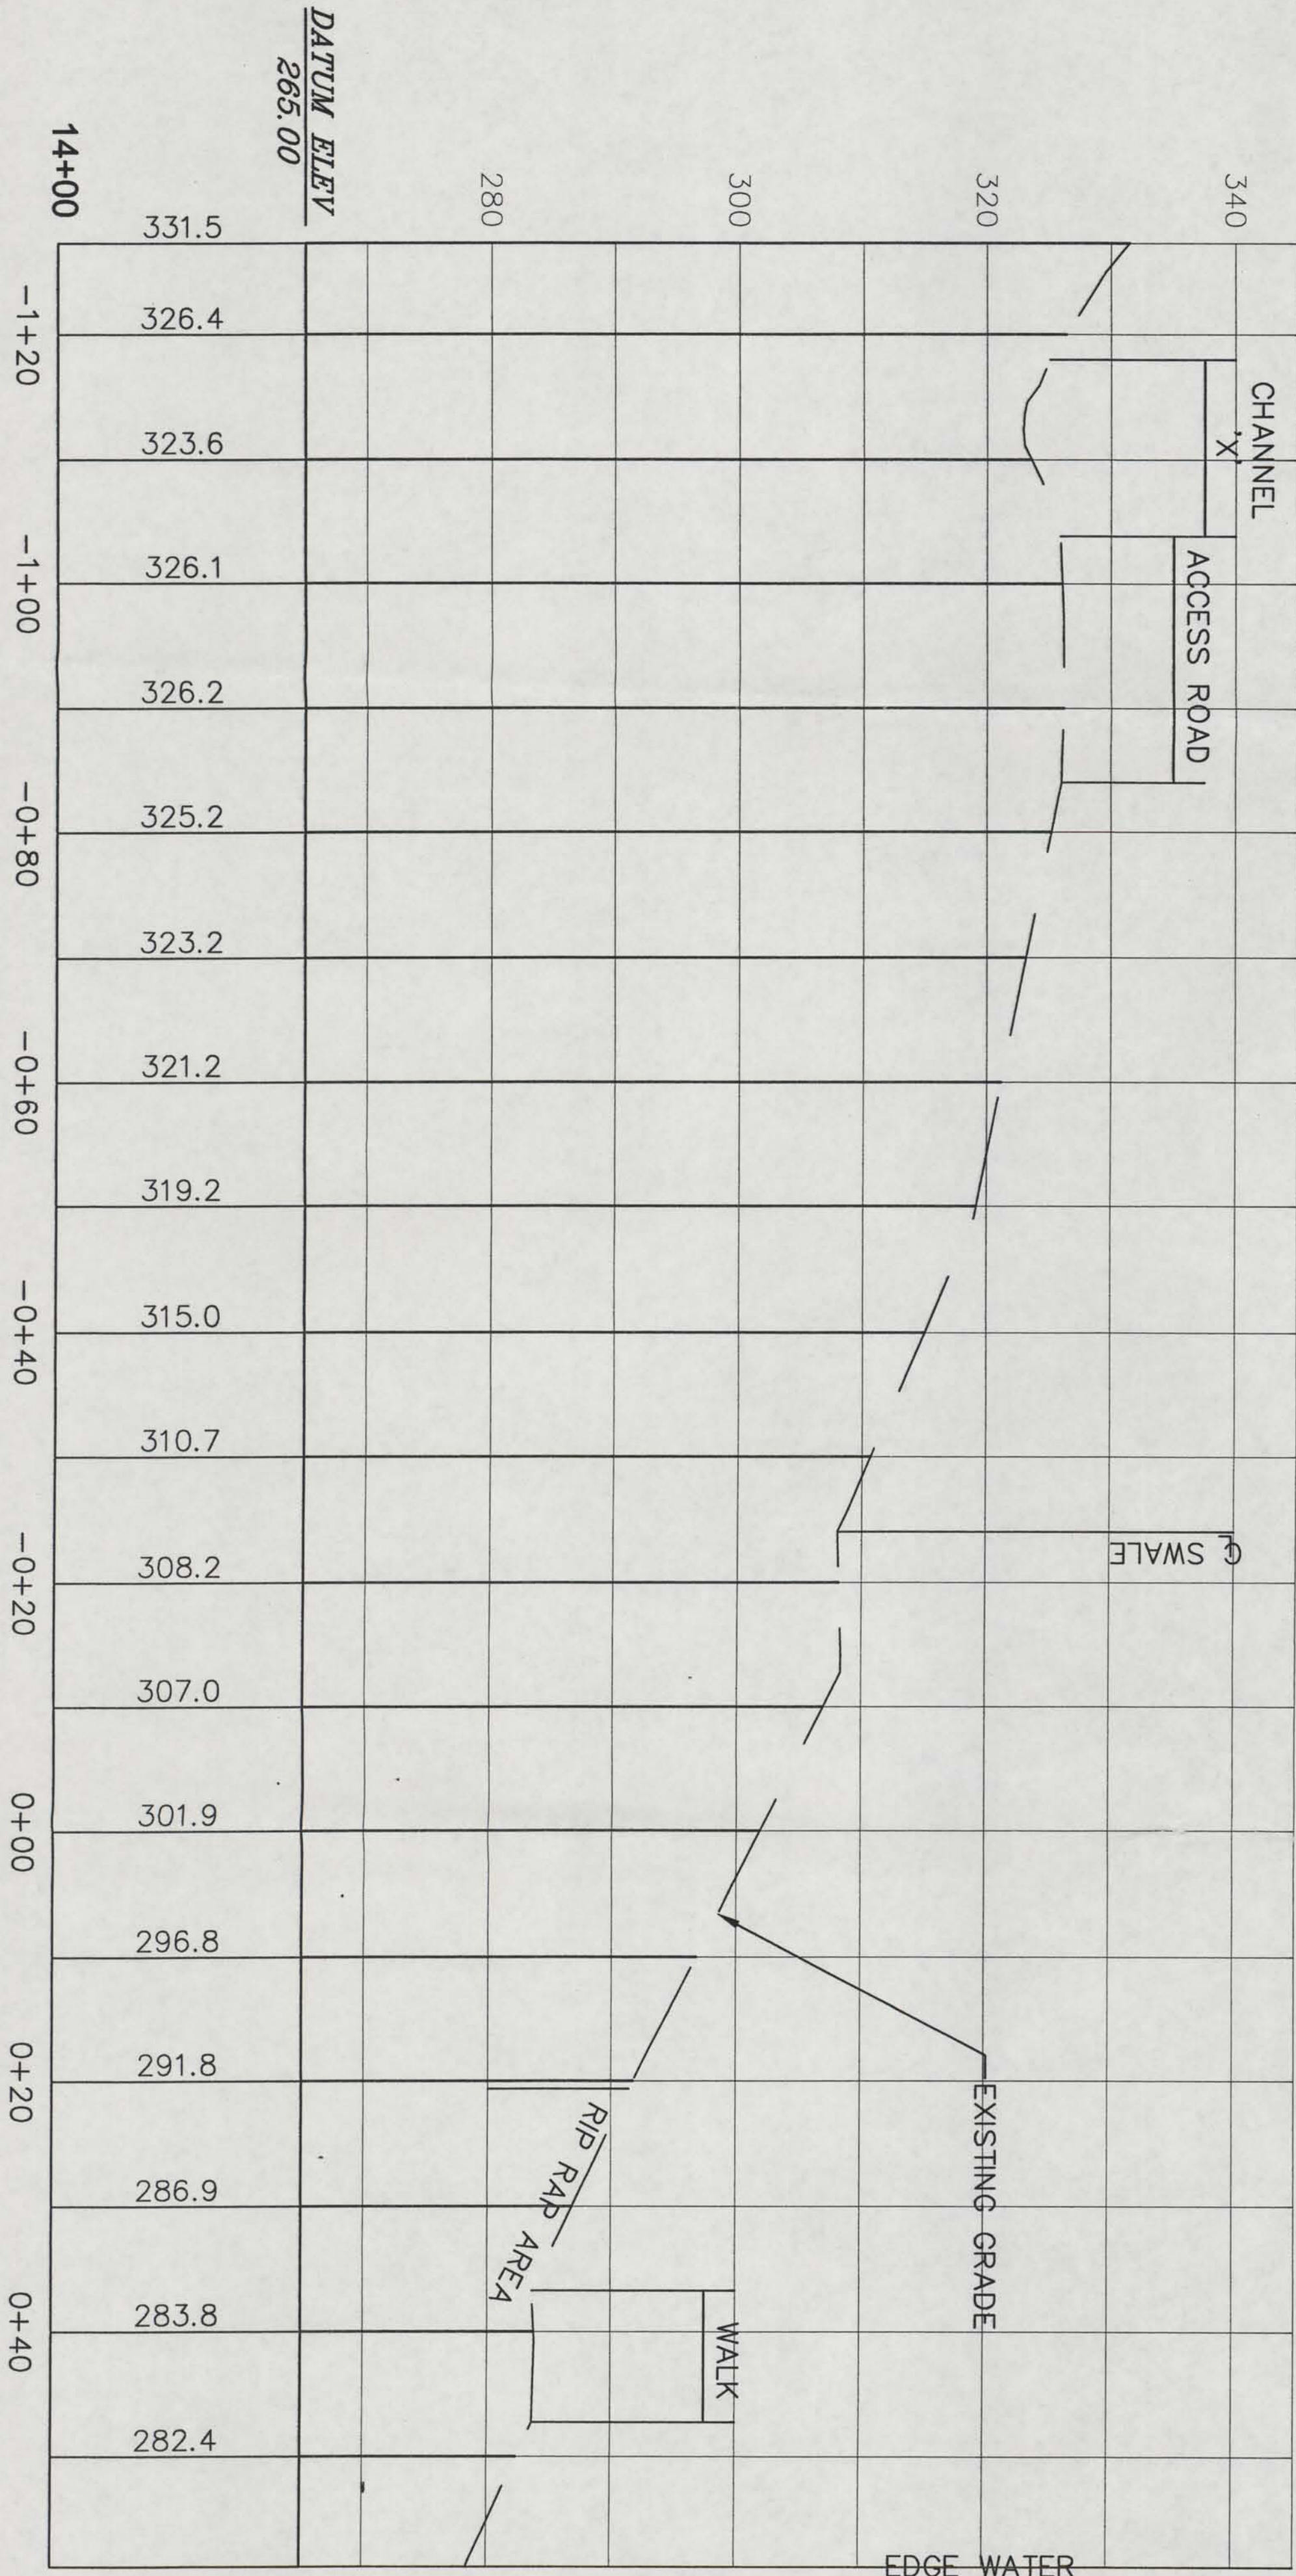


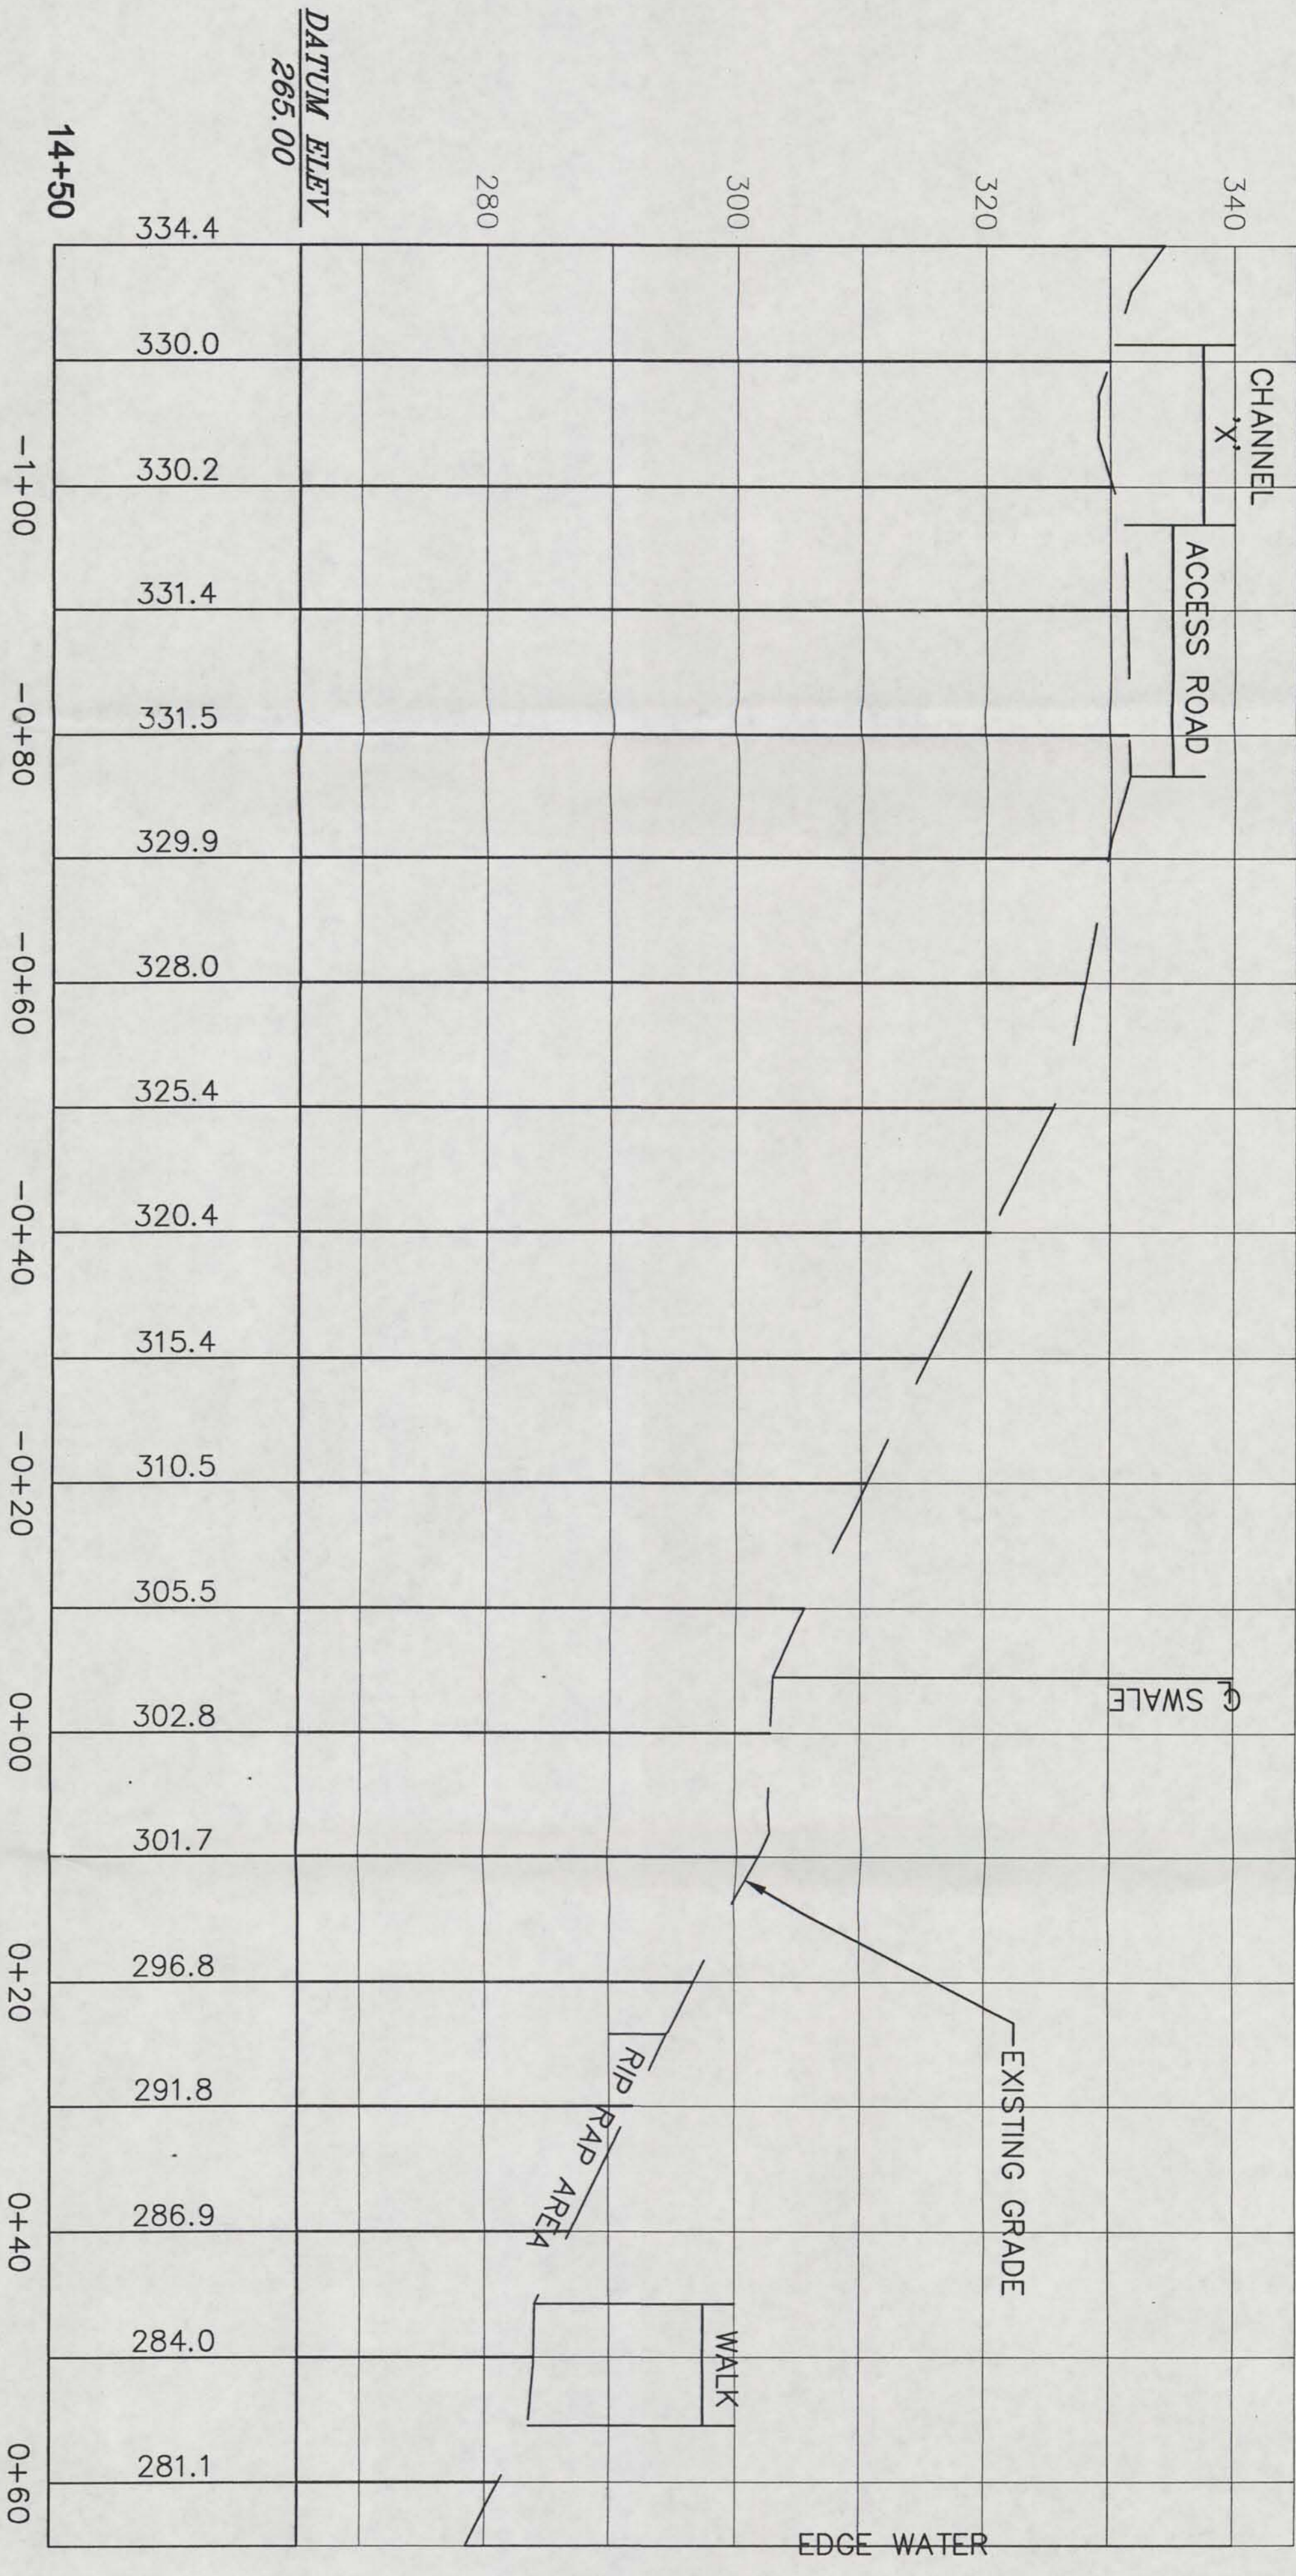

Utilities Disclaimer:  
The underground utilities shown have been located by the surveyor and are shown as best as can be determined. The surveyor makes no guarantee that the location, depth, or nature of the utilities shown is correct. The surveyor shall not be held responsible for any damage to or loss of property resulting from the use of these plans. The surveyor shall not be held responsible for any damage to or loss of property resulting from the use of these plans.

REVISIONS TO THESE PLANS BY ANYONE OTHER THAN KJA SHALL MAKE THESE PLANS NULL AND VOID. NO REVISIONS SHALL BE MADE WITHOUT THE WRITTEN CONSENT OF KJA.

REVISION:  
REVISION:  
REVISION:  
REVISION:  
PROJECT: 2021\CS\Watertown-201382-chasebrass  
DRAWN BY:  
SCALE:

SURVEY NOTES:  
THIS MAP HAS BEEN PREPARED IN ACCORDANCE WITH THE MINIMUM STANDARDS FOR SURVEYS AND MAPS IN THE STATE OF CONNECTICUT AS ADOPTED BY THE BOARD OF SURVEYORS AND MAPPERS OF THE STATE OF CONNECTICUT ON SEPTEMBER 26, 1986. (CT SECTIONS 20-300b-1 TO 20-300b-20).

THE TYPE OF SURVEY PERFORMED IS AN IMPROVEMENT LOCATION MAP. BOUNDARY DETERMINATION IS BASED UPON A DEPENDENT RESURVEY.

THIS SURVEY CONFORMS TO A CLASS A-2 KIT-2. TO THE BEST OF MY KNOWLEDGE AND BELIEF, THE MAPS ACCURATELY REPRESENT THE NOTED HEREON.

*James H. Sawinick*  
James H. Sawinick  
CT PE & LS #11302

**kratzer, jones & associates, inc.**  
CIVIL ENGINEERS • LAND SURVEYORS  
SITE PLANNERS • BUILDING ENGINEERS  
P.O. BOX 337  
1755 WERDEN-WATERBURY RD.  
MILDALE, CT 06457-0337  
PHONE: (860) 621-3538  
FAX: (860) 621-9609  
EMAIL: KJA@AOL.COM

**AS-BUILT CROSS SECTIONS**

for  
Watertown Construction

**CHASE BRASS AND COPPER SITE**

**WATERBURY, CT**

**SCALE: 1" = 10'**  
**DATE: MAY 13, 2002**

**KJA** ONE INCH = 10 FEET  
KJA ONE INCH = 10 FEET  
KJA ONE INCH = 10 FEET

KJA FILE NO.: **201-382**  
DRAWING NO.: **CS-9**