

**REMOVAL PROGRAM
AFTER ACTION REPORT
FOR THE
BALDWINVILLE RESIDENTIAL PROPERTIES
BALDWINVILLE, WORCESTER COUNTY, MASSACHUSETTS
5 AUGUST 2004 THROUGH 13 JUNE 2007**

Prepared For:

U.S. Environmental Protection Agency
Region I
Emergency Planning and Response Branch
One Congress Street, Suite 1100
Boston, Massachusetts 02114-2023

CONTRACT NO. EP-W-05-042

TDD NO. 05-07-0013

TASK NO. 0011

DC NO. R-4905

Submitted By:

Weston Solutions, Inc.
Superfund Technical Assessment and Response Team III
3 Riverside Drive
Andover, Massachusetts 01810

May 2008

TABLE OF CONTENTS

	<u>Page</u>
LIST OF APPENDICES.....	iii
1.0 INTRODUCTION	1
2.0 SITE CONDITIONS AND BACKGROUND.....	1
2.1 Site Location and Description.....	1
2.2 Site History/Previous Actions.....	1
3.0 SUMMARY OF FEDERAL RESPONSE ACTIONS	2
3.1 Organization of the Response	2
3.2 Mobilization and Site Preparation	6
3.3 Site Activities.....	6
3.4 Chronology of Removal Activities	7
4.0 ESTIMATED COSTS OF THE REMOVAL ACTION.....	9

LIST OF APPENDICES

Appendix A	Site Location Diagram (Figure 1)
Appendix B	Baldwinville Residential Properties Diagram (Figure 1A)
Appendix C	PA/SI Property Diagrams
Appendix D	Removal Excavation Diagrams
Appendix E	Waste Disposal Summary Table (Table 1)
Appendix F	Baldwinville Residential Properties Table (Table 2)

1.0 INTRODUCTION

The following report, entitled *Removal Program After Action Report for the Baldwinville Residential Properties, Baldwinville, Worcester County, Massachusetts, 5 August 2004 through 13 June 2007*, is a summary of the response actions taken by the U.S. Environmental Protection Agency (EPA) Region I Emergency Planning and Response Branch (EPRB). The report details the situation as it developed, the actions taken, and the resources committed.

Site activities included the following: establishing the exclusion zone (EZ), contamination reduction zone (CRZ), and clean zone (CZ); relocating or removing non-hazardous debris to access staging areas used for work and equipment; conducting particulate air monitoring; performing in-situ screening for lead using X-Ray Fluorescence (XRF); establishing excavation grids; excavating soil; installing erosion/siltation control devices; collecting air samples for polychlorinated biphenyl (PCB) analysis; collecting soil samples for PCB analysis; performing on-site field screening for PCBs in soil; procuring laboratory services for sample analysis; documenting site conditions; coordinating disposal of contaminated materials at EPA-approved facilities; performing site restoration and revegetation; and demobilizing personnel and equipment.

2.0 SITE CONDITIONS AND BACKGROUND

2.1 Site Location and Description

The approximate center of the Baldwinville Residential Properties (BRP) site (the site) is located along Holman Road, in Baldwinville, Worcester County, Massachusetts (MA) at 42° 36' 54" north latitude and 72° 04' 33" west longitude [see Appendix A – Site Location Diagram (Figure 1)] [1]. The site consists of 69 residential properties that surround the Temple Stuart Superfund Removal site (Temple Stuart site) and are located along the following streets: Winchester Street, Holman Street, Harris Street, Elm Street, Bridge Street, Wilson Court, Beech Street, Walnut Street, Edgar Street, Chestnut Street, Pine Street, Fisher Street, Mason Street, Circle Street, Forest Street, Myrtle Street, Claire Avenue, and Winchendon Road [see Appendix B – Baldwinville Residential Properties Diagram (Figure 1A)] [2].

2.2 Site History/Previous Actions

Analytical results of surface soil samples collected during an EPA Removal Action at the Temple Stuart site indicated the presence of PCBs at concentrations as high as 44 parts per million (ppm) in surface soils located close to a residential property. As a result, EPA initiated BRP Preliminary Assessment/Site Investigation (PA/SI) sampling activities at residential properties in close proximity to the Temple Stuart site.

From 9 June 2003 through 22 July 2003 and on 14 August 2003, Weston Solutions, Inc., Superfund Technical Assessment and Response Team (START) members collected a total of 512 surface soil samples from 35 residential properties for PCB field screening analysis as part of the BRP Phase I PA/SI (see Appendix C – PA/SI Property Diagrams: Section 1 - Phase I PA/SI Diagrams) [2]. Chain-of-custody (COC) documentation was completed for each sample

collected, and is located in the EPA BRP PA/SI site file. Surficial PCB contamination was detected at concentrations as high as 75 ppm at one residential property. Analytical results for Phase I PA/SI properties that required removal actions have been included on the PA/SI Property Diagrams located in Appendix C.

EPA On-Scene Coordinator (OSC) Mary Ellen Stanton identified shallow dug wells with wide casings at six residential properties that required sampling. On 20 and 21 August 2003, START performed groundwater sampling at two of these residential properties; the wells at the remaining four properties were found to be inactive upon investigation. No contamination exceeding Massachusetts Oil and Hazardous Material List (MOHML) Reporting Category RCGW-1 groundwater standards was detected in the groundwater samples [3]. Analytical results of groundwater samples are located in the EPA BRP PA/SI site file.

Upon completion of sampling activities, it was determined that an EPA Removal Action was required at 26 of the 35 BRP Phase I PA/SI properties. EPA OSC Mike Barry selected 10 of the 26 residential properties for the collection of subsurface soil samples to determine if vertical migration of PCB contamination had occurred. On 19 and 20 July 2004 and from 9 through 11 August 2004, the EPA Office of Environmental Measurement and Evaluation New England Regional Laboratory (OEME NERL) Geoprobe Team collected soil cores in 1-foot intervals to 3 feet below ground surface (bgs). START personnel collected soil samples from each soil core and submitted the samples to EPA OEME NERL located in North Chelmsford, MA for PCB analysis as part of BRP Phase I PA/SI sampling activities. The maximum concentration of PCB contamination detected in soil core samples was determined to be 14 ppm at a depth of 1 foot bgs. Analytical results for depth soil samples are located in the EPA BRP PA/SI site file.

3.0 SUMMARY OF FEDERAL RESPONSE ACTIONS

3.1 Organization of the Response

ORGANIZATION OF THE RESPONSE		
Organization	Representatives	Responsibilities
U.S. Environmental Protection Agency (EPA) Emergency Planning and Response Branch (EPRB) One Congress Street, Suite 1100 Boston, Massachusetts (MA) 02114-2023 Mike Barry: (617) 918-1344 Mary Ellen Stanton: (617) 918-1256	Mike Barry and Mary Ellen Stanton	EPA On-scene Coordinators (OSCs) responsible for the initiation, oversight, and completion of all removal activities. The OSCs coordinated with state and local officials.
Weston Solutions, Inc. Superfund Technical Assessment and Response Team (START) 3 Riverside Drive Andover, Massachusetts 01810 (978) 552-2100	Kyle Brennan	START Site Leader that provided the OSCs with technical assistance, sampling support, analytical support, site documentation, site health and safety monitoring, air monitoring, and draft and final report preparation.

ORGANIZATION OF THE RESPONSE (Continued)

Organization	Representatives	Responsibilities
Shaw Environmental & Infrastructure (Shaw) Emergency Rapid Response Services (ERRS) 88C Elm Street Hopkinton, MA 01748-1656 (508) 435-9561	Mike Blodgett	Response Manager (RM) for ERRS contractor who performed removal activities. The RM was responsible for oversight and organization of mobilization, excavation, disposal, and demobilization activities.
Environmental Services Assistance Team (ESAT) Based at Region 1 New England Regional Laboratory (NERL) 11 Technology Drive North Chelmsford, MA 01863-2431 (617) 918-8300	Matt Hein	EPA subcontractor responsible for performing on-site polychlorinated biphenyl (PCB) field screening activities.
A&G Rental of Gardner, Inc. DBA Taylor Rental Center 22 Union Square, Gardner, MA 01440 (978) 632-8800	Representative	ERRS subcontractor responsible for providing rental equipment.
Allgreen Hydroseeding 527 High Street Clinton, MA 01510 (978) 368-1519	Jim O'Toole	ERRS subcontractor responsible for hydroseeding activities.
American Tree Service 211 Nichols Street Gardner, MA 01440 (978) 632-9255	Representative	ERRS subcontractor responsible for portions of tree removal service.
American Waste Management One American Way Warren, Ohio 44484 (330) 856-8800	Transportation Coordinator	ERRS disposal facility responsible for accepting PCB debris and wood stump waste.
Amro Environmental Labs 111 Herrick Street Merrimack, NH 03054 (603) 424-2022	Sample Custodian	ERRS subcontractor responsible for performing confirmatory analysis of PCB soil samples.
Better Irrigation Incorporated 80 Mechanic Street Marlborough, MA 01752 (508) 485-9008	Representative	ERRS subcontractor responsible for performing repairs to a residential irrigation system.
Brox Industries 1471 Methuen Street Dracut, MA 01826 (978) 454-9105	Tom White	ERRS subcontractor responsible for the delivery of backfill material.
Copiers Inc. Plus 27 Walnut Street Suite 2S Peabody, MA 01960 (978) 977-9220	Representative	ERRS subcontractor responsible for providing office copying and fax equipment.
EQ Northeast 185 Industrial Road P.O. Box 617 Wrentham, MA 02093 (508) 384-6151	Kevin Franklin	ERRS subcontractor responsible for transportation and disposal of PCB-contaminated materials.

ORGANIZATION OF THE RESPONSE (Continued)

Organization	Representatives	Responsibilities
EW Sykes General Contractor, Inc. 5567 South Athol Road P.O. Box 178 Athol, MA 01331 (978) 249-7655	Clint Sykes	ERRS subcontractor responsible for the delivery of backfill material.
Fillion Landscaping, Inc. 111 Carver Street Granby, MA 01033 (413) 467-2662	Scott Fillion	ERRS subcontractor responsible for revegetation activities.
Gary T Young Trucking a/k/a/ Templeton Paving 228 Hubbardston Road Templeton, MA 01468 (978) 939-4269	Gary Young	ERRS subcontractor responsible for repairing residential sidewalks and front walkways.
George of the Jungle Tree & Stump 99 Willard Road, Ashburnham, MA 01430 (978) 827-9600	George Gorrell	ERRS subcontractor responsible for portions of tree removal services.
Global Remediation Services One Westinghouse Plaza Boston, MA 02137 (617) 364-0012	Paul Mastradomenico	ERRS subcontractor responsible for transportation and disposal of PCB-contaminated soil.
GVC Construction & Engineering, Inc. P.O. Box 693 Leominster, MA 01453 (978) 630-5400	Representative	ERRS subcontractor responsible for repairing residential sidewalks and front walkways.
Hertz Equipment 2815 N. Sam Houston Parkway E. Houston, TX 77032 (888) 777-3500	Representative	ERRS subcontractor responsible for providing rental equipment.
Hillview Equipment & Leasing, Inc. 11 Commercial Way Milford, MA 01757 (508) 473-7361	Pat Kennelly	ERRS subcontractor responsible for providing rental equipment.
Huhtala Oil Company 198 Patriots Road P.O. Box 417 East Templeton, MA 01438 (978) 632-1221	David Huhtala	ERRS subcontractor responsible for fuel delivery to equipment on site.
Industrial Safety & Supply Company P.O. Box 330720 West Hartford, CT 06133 (800) 243-2316	Rosemary Moore	ERRS subcontractor responsible for delivery of safety supplies including personal protective equipment (PPE).
Jennian Enterprises LLC Six Eastment Place Suite 201 Melrose, MA 02176 (781) 665-7915	Bill Hughes	ERRS subcontractor responsible for providing erosion control matting.
Landscaping Etc. Incorporated P.O. Box 437 Sutton, MA 01590 (508) 865-4367	Steve Christy	ERRS subcontractor responsible for landscaping activities.

ORGANIZATION OF THE RESPONSE (Continued)

Organization	Representatives	Responsibilities
Lock-Tite Protection Services 284 Park Street Gardner, MA 01440 (978) 630-4867	Steve or Deb Landry	ERRS subcontractor responsible for site security during non-working hours.
Mill City Environmental Corporation 116 John Street Lowell, MA 01852 (978) 654-6741	John Rourke	ERRS subcontractor responsible for coordination of transport and disposal of contaminated material.
NES Rentals 15 Whitman Road Canton, MA 02021 (781) 828-4300	Gary Oldenberg	ERRS subcontractor responsible for providing rental equipment.
Northern Land Clearing, Inc. 1290 Park Street P.O. Box 504 Palmer, MA 01069 (413) 596-6132	Calvin Layton	ERRS subcontractor responsible for portions of tree removal service.
Page Electrical Corp. 60 Elm Hill Avenue Leominster, MA 01453 (978) 537-8437	Joe Droogan	ERRS subcontractor responsible for installation of electrical service.
Red Technologies LLC 10 Northwood Drive Bloomfield, CT 06002 (860) 818-3664	Representative	ERRS subcontractor responsible for transportation and disposal of PCB-contaminated soil.
RS Rental Equipment Company, Inc. 29000 County Street P.O. Box 350 Somerset, MA 02726 (800) 696-3600	Mark Andrade	ERRS subcontractor responsible for providing rental equipment.
Taylor Oil NE, Inc. 176 Center Street Holbrook, MA 02343 (781) 767-5400	Pete Gamache	ERRS subcontractor responsible for fuel delivery to equipment on site.
Templeton Police Department 33 South Road Templeton, MA 01468 (978) 939-5638	Templeton Police Chief	ERRS subcontractor responsible for site security and traffic control.
Tolman Construction Service, Inc. 74 Maple Street Baldwinville, MA 01436 (978) 939-5653	Richard Tolman	ERRS subcontractor responsible for the delivery of backfill material.
TruGreen Chemlawn 21 Forge Park Franklin, MA 02038 (508) 520-6717	Representative	ERRS subcontractor responsible for the application of lawn-care solutions.
United Fence Corporation 300 Oak Street Suite 210 Pembroke, MA 02359 (781) 826-9655	Representative	ERRS subcontractor responsible for repair of residential split-rail fencing.

ORGANIZATION OF THE RESPONSE (Concluded)		
Organization	Representatives	Responsibilities
United Rentals 133 South Hampton Street Boston, MA 02118 (617) 445-6700	Peter Lewis	ERRS subcontractor responsible for providing rental equipment.
Williams Scotsman, Inc. 48 Dick Tracy Drive Pelham, NH 03076 (603) 882-2823	Megan Brown	ERRS subcontractor responsible for providing rental office, crew, and lab trailers.
Wood & Wire Fence Company 124 Reservoir Avenue Pawtucket, RI 02860 (401) 727-0806	Representative	ERRS subcontractor responsible for installation of temporary security fence.
Powell Stone and Gravel 259 Leominster Shirley Road Lunenburg, MA 01462 (978) 537-8100	Kevin Sierra	ERRS subcontractor responsible for the delivery of backfill material (sand).

3.2 Mobilization and Site Preparation

The site-specific removal health and safety plan (HASP) was reviewed and signed by all site personnel before any site work commenced. In addition, emergency telephone numbers and directions to the hospital were posted and site work zones were delineated. All site activities were performed in appropriate personal protective equipment (PPE) in accordance with the HASP. The site HASP was prepared by START personnel as a separate document, entitled *Health and Safety Plan for the Baldwinville Residential Properties Site, Templeton, Worcester County, Massachusetts*.

On 5 August 2004, the mobilization and staging of Emergency Rapid Response Services (ERRS) equipment was initiated. Site preparation activities conducted by ERRS personnel consisted of clearing and grubbing the work zone and command post areas; improving the existing truck access road; and constructing a truck turnaround and soil staging area on site.

3.3 Site Activities

The following section presents an overall description of removal actions performed at each property accessed during removal activities. At each property, START and ERRS personnel established an excavation grid over those sections that were determined to require excavation. The excavation grid system was established using a sample point as the center node for each grid. START personnel used a Trimble™ Pathfinder Pro XRS Global Positioning System (GPS) unit to identify sample locations established during the PA/SI. Only those sample points determined by the OSC to require soil excavation and removal were located. Portions of grids that were inaccessible due to obstruction by stationary objects (*i.e.*, pavement, pool, buildings, *etc.*) were not excavated. Soil excavation and removal activities were performed by the ERRS contractor.

START performed soil sample collection activities after each grid was excavated to a depth of approximately 1 foot bgs. A five-point composite soil sample was collected from the floor of each excavated grid, and a two-point composite soil sample was collected from each of the walls of each excavated grid. A wall sample was not collected if an abutting grid was to be excavated. Soil samples were collected using dedicated plastic sampling scoops; and samples were placed in dedicated polyethylene sample bags; homogenized; and relinquished for PCB analysis. Confirmation analysis was performed on approximately 10% of the soil samples by EPA OEME NERL. Two of the confirmation soil samples collected from each property were sent for further PCB confirmation analysis at Amro Environmental Labs, a private laboratory located in Merrimack, New Hampshire. If a sample was reported to have a PCB concentration above the removal criteria, additional excavation activities were performed and additional soil samples were collected from the newly excavated areas. Excavation and sampling activities continued until analytical sample data indicated that contamination levels were below the removal criteria. Analytical results of floor samples are included on the Excavation Diagram (Figure 3) of each respective property (see Appendix D – Removal Excavation Diagrams) [2, 4]. Removal analytical data, including wall and confirmation sample results, are located in the EPA BRP removal site file.

START personnel completed COC documentation and entered sample information into a Scribe database, documenting sample information from the time of sample collection through sample transport and analysis. COC documentation can be found in the EPA BRP removal site file. In addition, START personnel photodocumented removal actions throughout the duration of site activities. Photodocumentation Logs are located in the EPA BRP removal site file, on a CD-ROM entitled *Baldwinville Residential Properties Removal Photodocumentation: Phases I through IV*.

Upon completion of excavation activities, ERRS personnel performed site restoration activities. Site restoration activities included backfilling excavated areas; grading topsoil; spreading hydroseed; and conducting revegetation activities, as needed.

3.4 Chronology of Removal Activities

From 19 August 2004 through 12 January 2005, Phase I Removal activities were conducted at 26 residential properties (see Appendix D – Removal Excavation Diagrams: Section 1 - Phase I Removal Diagrams) [2]. During Phase I Removal activities, soil sampling (for excavation clearance and disposal) was conducted for lead and PCB analyses. Concentrations of lead detected generally ranged from 200 to 500 ppm. Samples of excavated soil were screened for lead on site via XRF to facilitate segregation of excavated soil for disposal purposes [see Appendix E – Waste Disposal Summary Table (Table 1)]. If lead concentrations greater than 300 ppm were detected, excavated soil was segregated in the disposal area, and additional samples were collected by the ERRS contractor for further lead analysis. Additional activities conducted during Phase I Removal included the collection of air samples by START personnel. From 29 November 2004 through 4 January 2005, START collected 22 air samples for PCB analysis. No PCB contamination was detected in any air samples for the duration of air sampling

activities. Based on these analytical results, EPA OSC Barry determined that air sampling for PCB analysis was no longer necessary.

From 11 October 2004 through 4 November 2004 and on 8 December 2004, START mobilized to the site to perform BRP Phase II PA/SI sampling activities at an additional 26 residential properties, as designated by EPA OSC Barry (see Appendix C – PA/SI Property Diagrams: Section 2 - Phase II PA/SI Diagrams) [2, 4]. Phase II PA/SI sampling was performed concurrently with Phase I Removal activities. START collected 1,171 surface soil samples and relinquished the samples to a START analytical team for on-site PCB field screening analysis. Surficial PCB contamination was detected at concentrations as high as 110 ppm on one residential property. Analytical sample results for Phase II PA/SI properties which required removal actions are included on each property's respective PA/SI Property Diagram located in Appendix C.

On 2 November 2004, START accessed Property R-079 to collect three sediment samples from a swale running perpendicular to Route 202 (Elm Street), and also accessed Property R-081 to collect three sediment samples from an intermittent drainage area located in the western portion of the property. Sample locations were determined by EPA OSC Barry prior to sampling activities. The sediment samples were relinquished to the START analytical team for PCB field screening analysis. Analytical results of sediment samples indicated PCB concentrations ranging from 1.2 to 2.2 ppm.

From 21 April 2005 through 17 August 2005, START mobilized to the site to perform Phase II Removal activities at 22 of the 26 Phase II PA/SI properties. START collected a total of 934 soil samples from excavated areas to determine that removal criteria were met and that removal actions were complete. Phase II Removal activities were also conducted at Property R-030, which had been investigated during Phase I PA/SI activities (see Appendix D – Removal Excavation Diagrams: Section 2 - Phase II Removal Diagrams) [2].

From 17 October 2005 through 3 November 2005 and on 15 and 16 November 2005, START mobilized to the site to perform BRP Phase III PA/SI sampling activities at an additional 36 residential properties, as designated by EPA OSC Barry (see Appendix C – PA/SI Property Diagrams: Section 3 - Phase III PA/SI Diagrams) [2, 4]. START collected 1,230 surface soil samples and transported the samples to EPA OEME NERL for PCB screening analysis. Surficial PCB contamination was detected at concentrations as high as 42.5 ppm at one residential property. Analytical sample results for Phase III PA/SI properties that required removal actions are included on each property's respective PA/SI Property Diagram located in Appendix C.

From 18 April 2006 through 12 June 2006, START mobilized to the site to perform Phase III Removal activities at 12 of the 36 Phase III PA/SI properties. START collected a total of 182 soil samples from the excavated areas to determine that removal criteria were met and that removal actions were complete (see Appendix D – Removal Excavation Diagrams: Section 3 - Phase III Removal Diagrams) [2, 4].

Phase IV PA/SI sampling activities were initiated on site on 17 April 2006, and were performed concurrently with Phase III Removal activities (see Appendix C – PA/SI Property Diagrams: Section 4 - Phase IV PA/SI Diagrams) [2, 4]. On 17 April 2006, 58 surface soil samples were collected from one additional property and were transported to EPA OEME NERL for PCB screening analysis. From 8 through 10 May 2006, 396 surface soil samples and three sediment samples were collected from seven additional properties and were transported to EPA OEME NERL for PCB screening analysis. From 12 through 15 June 2006, 302 surface soil samples were collected from six additional properties and 72 surface soil samples were collected from two previously accessed Phase IV PA/SI properties, and samples were transported to EPA OEME NERL for PCB screening analysis. On 27 and 28 June 2006, 80 surface soil samples were collected from one additional property and were relinquished to the START analytical team for on-site PCB field screening. On 19 October 2006, 50 surface soil samples were collected from one additional property and were transported to EPA OEME NERL for PCB screening analysis. Analytical sample results for Phase IV PA/SI properties that required removal actions are included on each property’s respective PA/SI Property Diagram located in Appendix C.

From 13 June 2006 through 2 November 2006, Phase IV Removal activities were performed at six of the 15 Phase IV PA/SI properties. START collected a total of 407 soil samples from the excavated areas to determine that removal criteria were met and that removal actions were complete. In addition, removal activities were performed on Property R-008 (which had been investigated during the Phase I PA/SI) during Phase IV Removal activities (see Appendix D – Removal Excavation Diagrams: Section 4 - Phase IV Removal Diagrams) [2, 4].

From 6 June 2007 to 13 June 2007, an ERRS subcontractor accessed five residential properties to perform revegetation activities as part of Phase IV Removal activities. On 13 June 2007, START personnel photodocumented property features and demobilized from the site.

A summary of property-specific dates of activity; PCB concentrations; total number of grids accessed; and total number of removal samples collected are included as an attachment [see Attachment F – Baldwinville Residential Properties Table (Table 2)].

4.0 ESTIMATED COSTS OF THE REMOVAL ACTION

EPA resources committed under this Removal Action, conducted from 5 August 2004 through 13 June 2007, are summarized below:

Extramural Costs

Regional Allowance Costs	
ERRS Contractor	\$ 6,017,873.00
START	<u>\$ 1,211,293.90</u>
Subtotal, Extramural Costs	\$ 7,229,166.90
Total, Extramural Costs	\$ 7,229,166.90

This accounting of expenditures is an estimate based on figures known to the OSC at the time this report was written. The cost accounting provided in this report does not necessarily represent an exact monetary figure which the government may include in any claim for cost recovery.

REFERENCES

- [1] USGS (U.S. Geological Survey). 1981. Templeton, MA and Winchendon, MA Quadrangles (7.5-minute series topographic map).
- [2] Town of Templeton, Massachusetts. April 1964. Tax Assessor's Maps Nos. 6-4, and No. 6.5. Revised January 2001.
- [3] Massachusetts Department of Environmental Protection (MassDEP). May 2002. Massachusetts Oil and Hazardous Materials List (MOHML).
- [4] Weston Solution, Inc. Superfund Technical Assessment and Response Team III (START). 2004-2005. Data collected using *TrimbleTM Pathfinder Pro XRS Global Positioning System (GPS) with TSCI Data Logger*.

Appendices

Appendix A

Site Location Diagram (Figure 1)

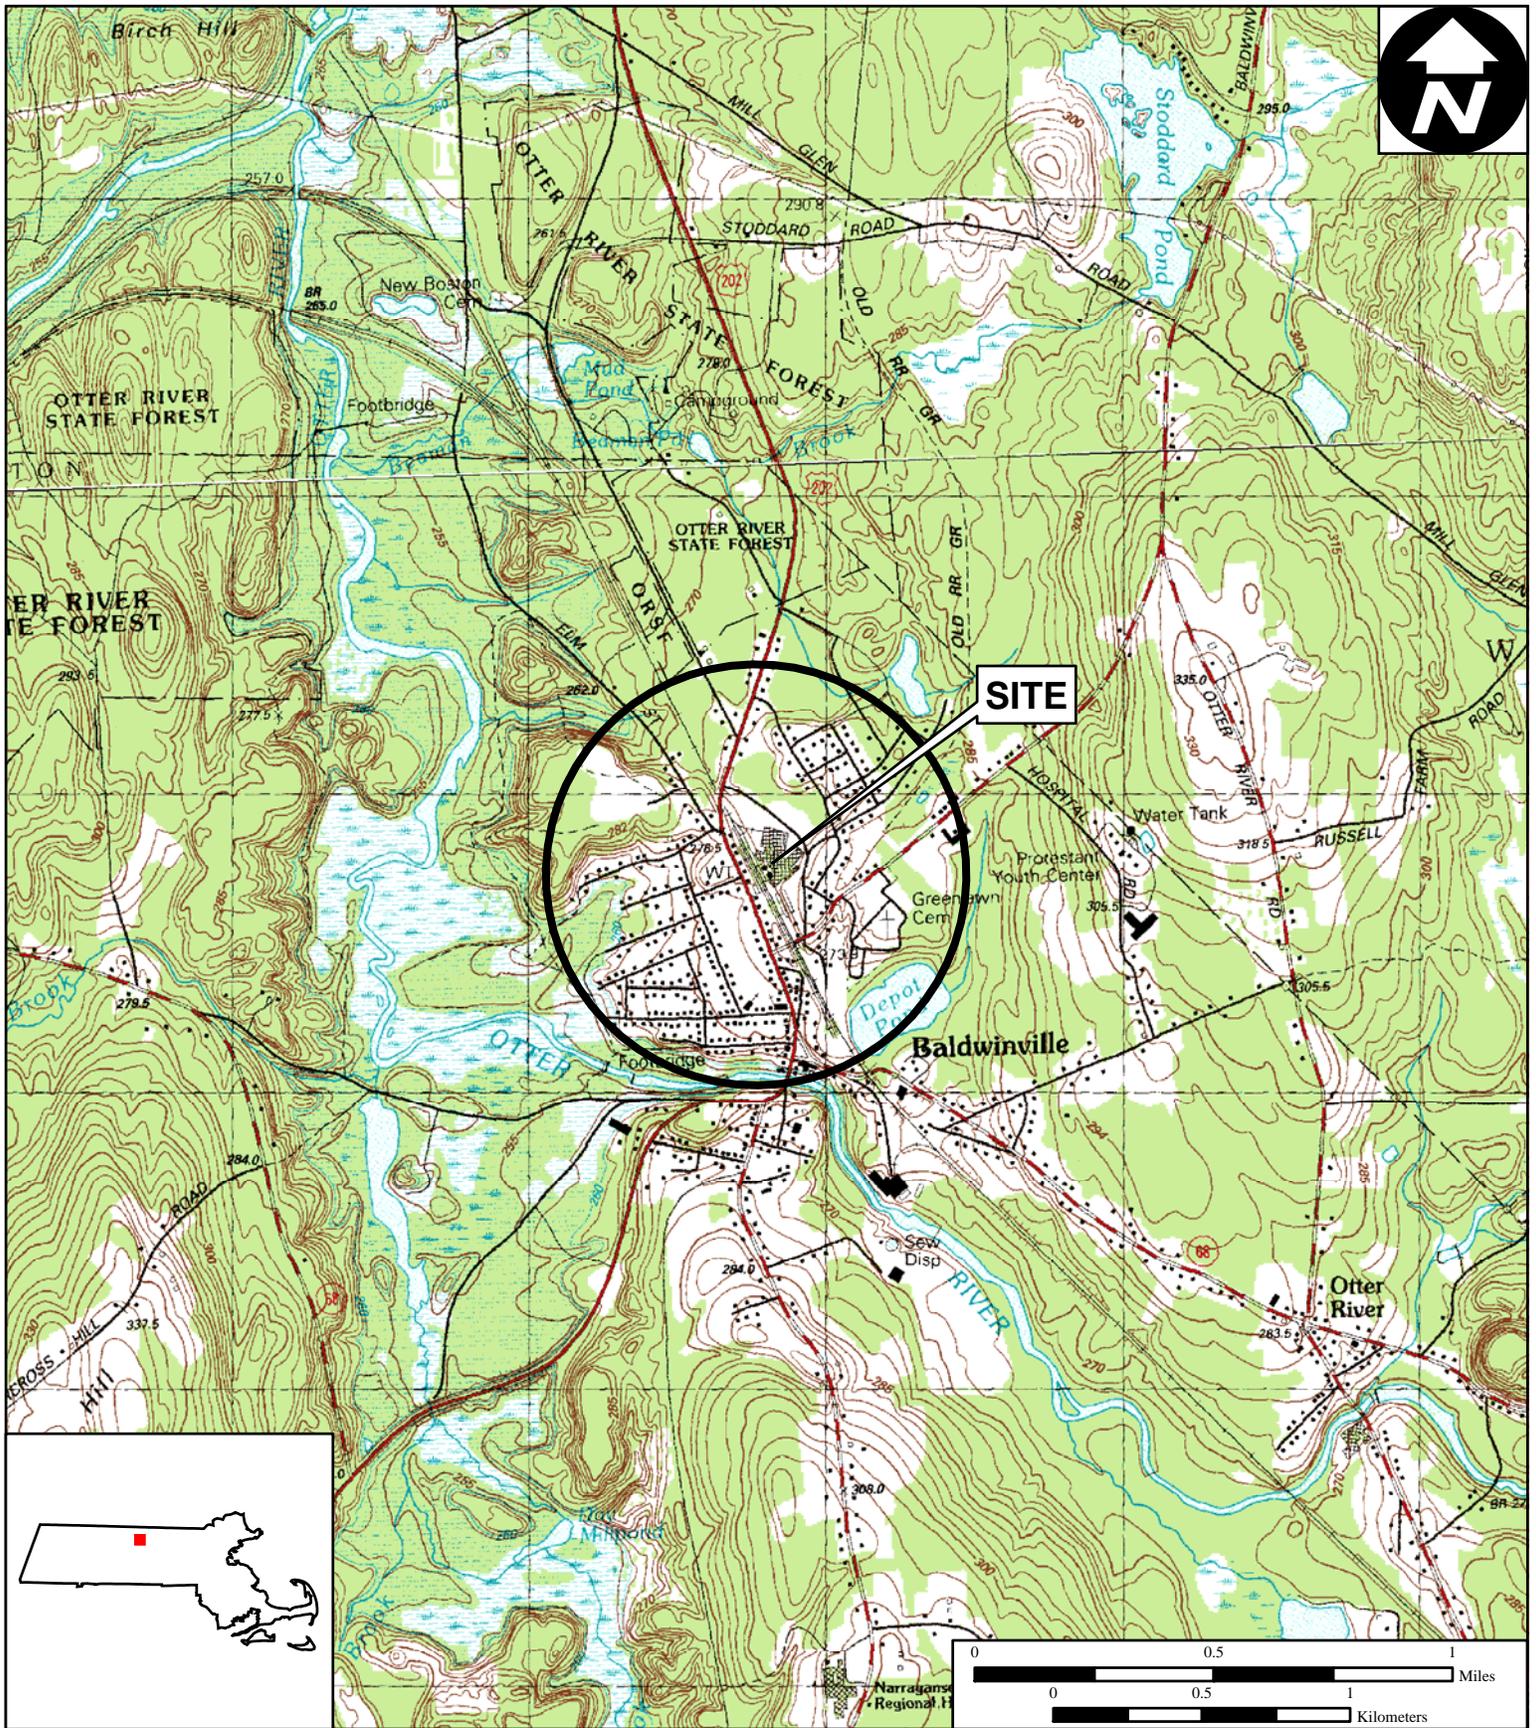


Figure 1

Site Location Diagram

**Baldwinville Residential Properties
Baldwinville, Massachusetts**

**EPA Region I
Superfund Technical Assessment and
Response Team (START) III
Contract No. EP-W-05-042**


TDD Number: 05-07-0013
 Created by: Kyle Brennan
 Created on: 1 March 2007
 Modified by: Kyle Brennan
 Modified on: 6 March 2007

Data Sources:
 Topos: MicroPath/USGS
 Quadrangle Names: Templeton, MA
 Winchendon, MA
 All other data: START



Appendix B

Baldwinville Residential Properties Diagram (Figure 1A)

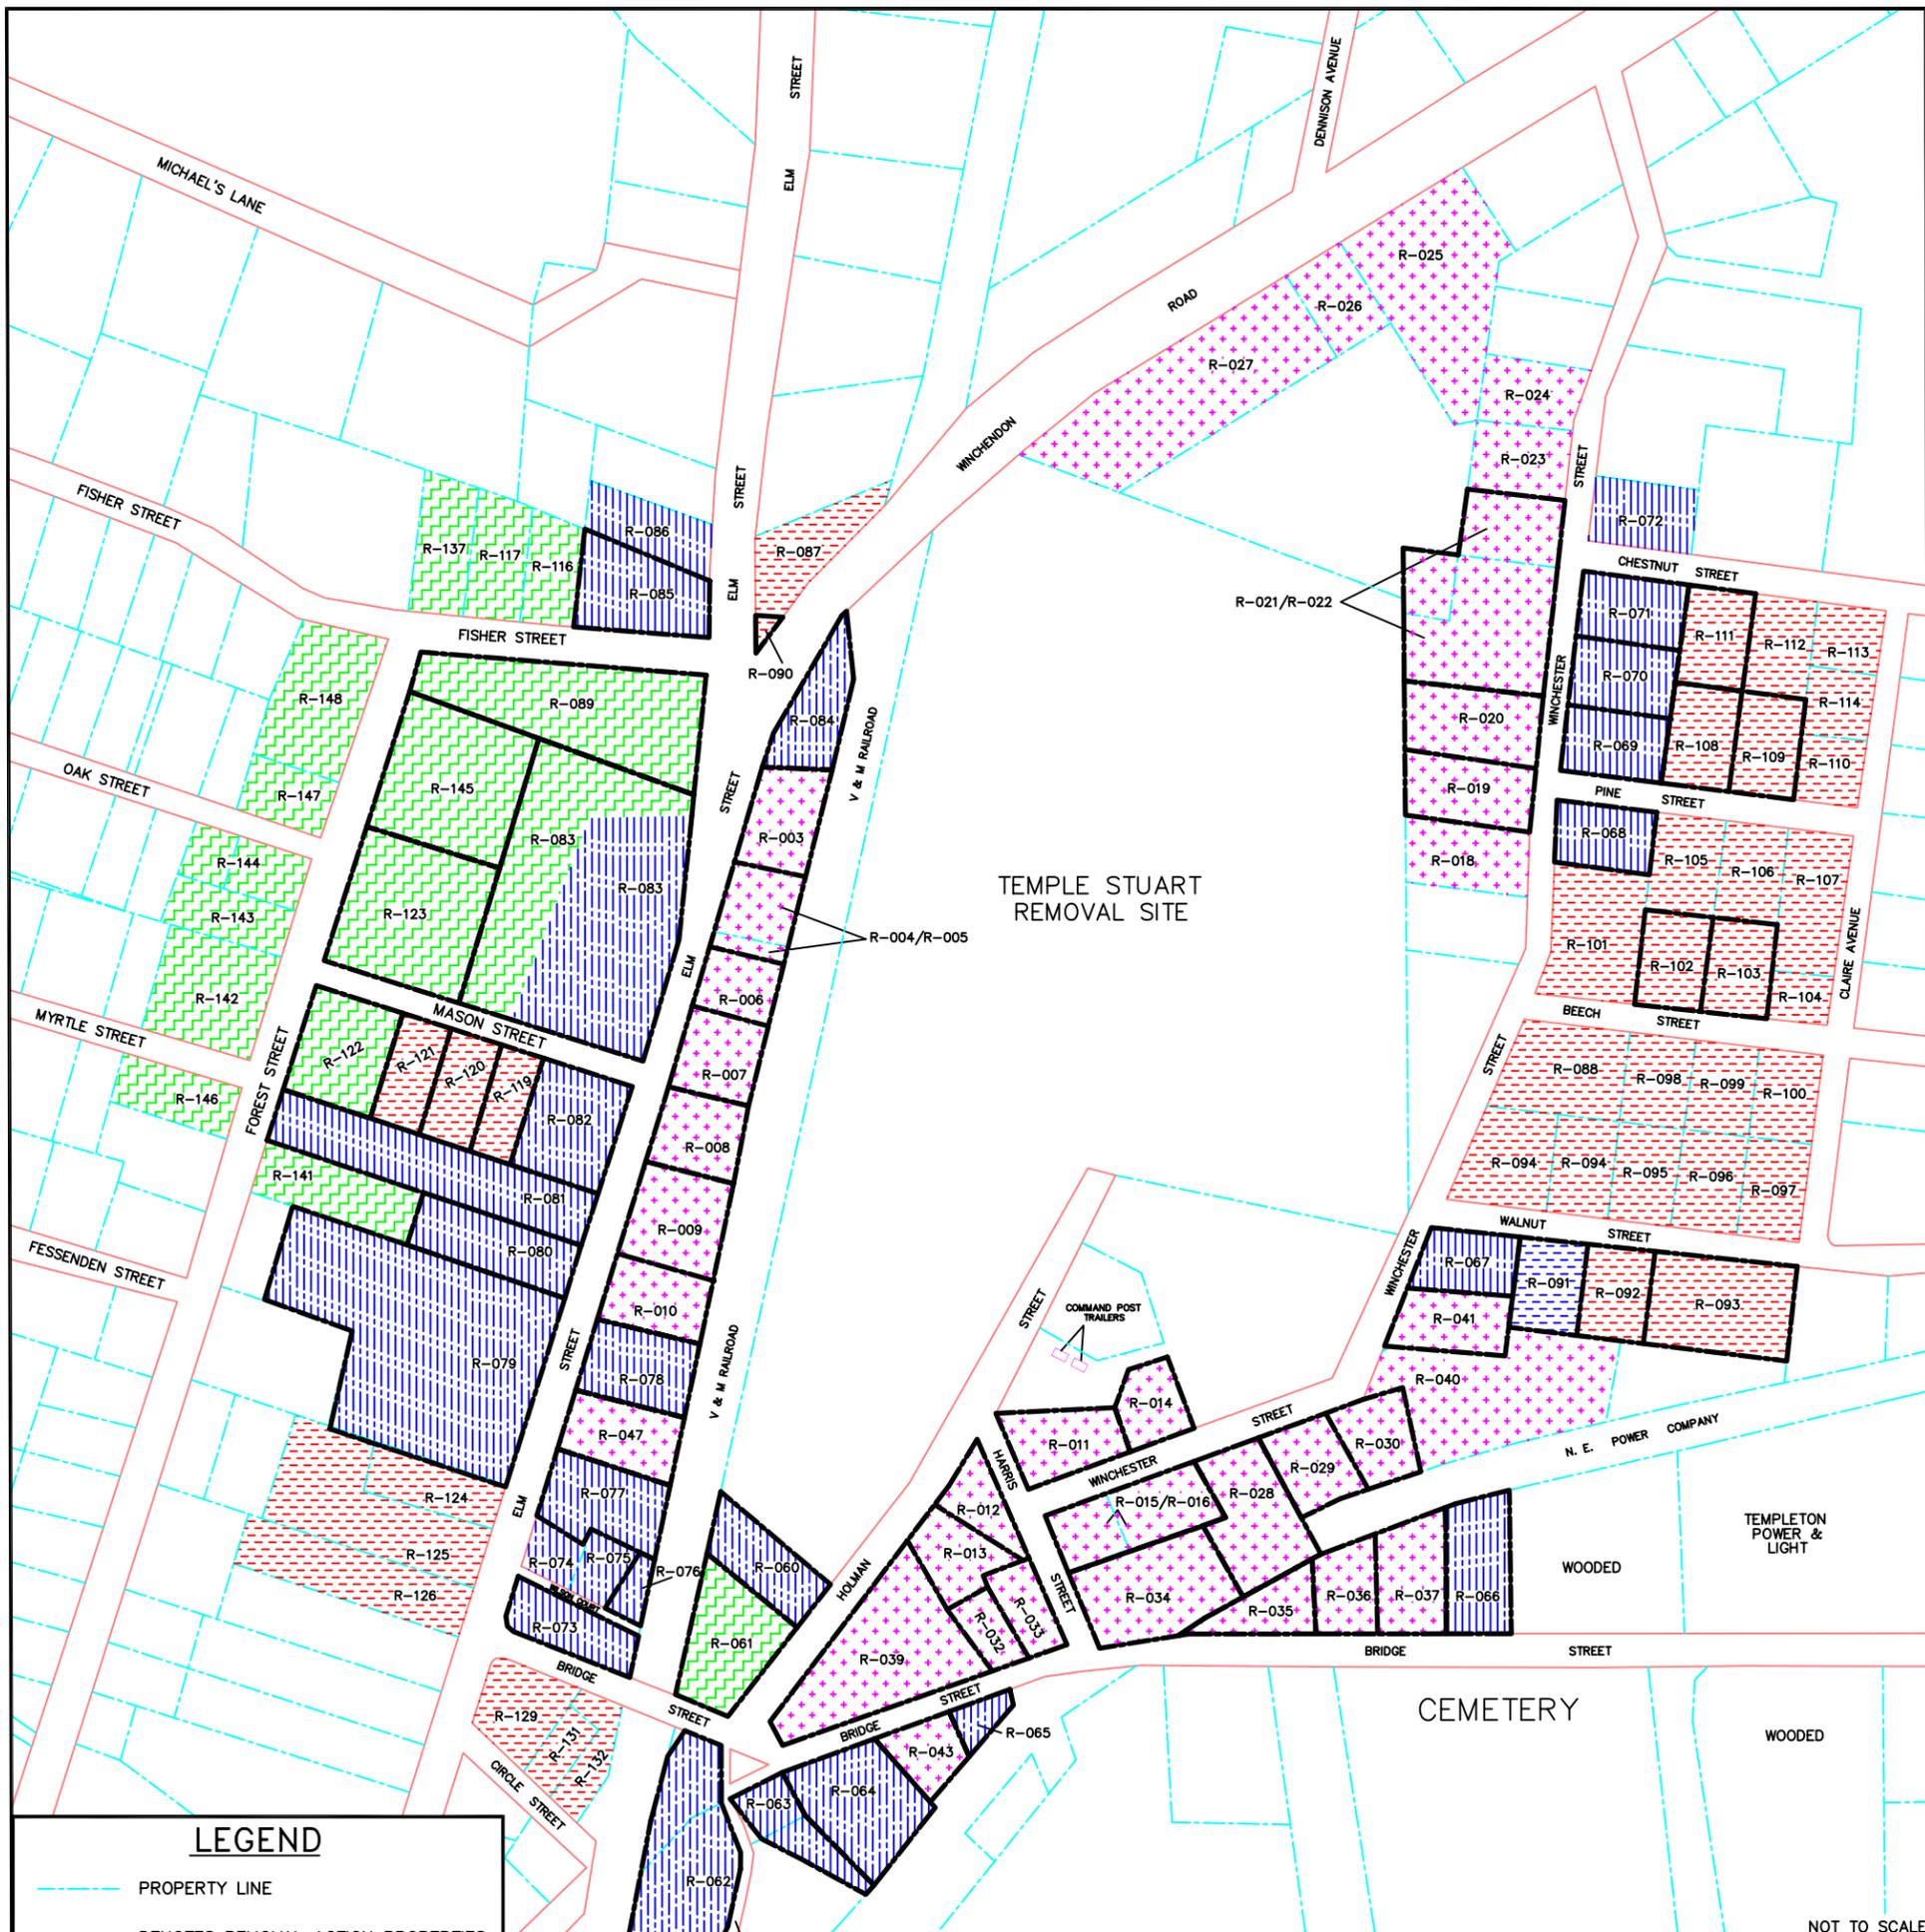

LEGEND

- PROPERTY LINE
- DENOTES REMOVAL ACTION PROPERTIES
- PHASE 1 PA/SI SAMPLING
- PHASE 2 PA/SI SAMPLING
- PHASE 3 PA/SI SAMPLING
- PHASE 4 PA/SI SAMPLING

NOTE: PROPERTY R-030 WAS SAMPLED DURING PHASE I PA/SI ACTIVITIES; REMOVAL ACTIONS WERE PERFORMED ON PROPERTY R-030 DURING PHASE II REMOVAL ACTIVITIES. PROPERTY R-008 WAS SAMPLED DURING PHASE I PA/SI ACTIVITIES; REMOVAL ACTIONS WERE PERFORMED ON PROPERTY R-008 DURING PHASE IV REMOVAL ACTIVITIES.

SOURCES: TOWN OF TEMPLETON, MASSACHUSETTS TAX ASSESSORS MAPS NOS. 6-4, AND 6.5 APRIL 1964, REVISED JANUARY 2001

NOT TO SCALE

REGION I SUPERFUND TECHNICAL ASSESSMENT AND RESPONSE TEAM

BALDWINVILLE RESIDENTIAL PROPERTIES DIAGRAM

BALDWINVILLE RESIDENTIAL PROPERTIES SITE
BALDWINVILLE, MASSACHUSETTS

TDD #	05-10-0004	DRAWN BY	K. BRENNAN
DATE	11/09/06		
FILE NAME	R:\05100004\FIGURES\FIG_HATCH_REVIS3.DWG		
FIGURE 1A			

Appendix C

PA/SI Property Diagrams



Section 1 - Phase I PA/SI Diagrams

Section 2 - Phase II PA/SI Diagrams

Section 3 - Phase III PA/SI Diagrams

Section 4 - Phase IV PA/SI Diagrams

Section 1 - Phase I PA/SI Diagrams

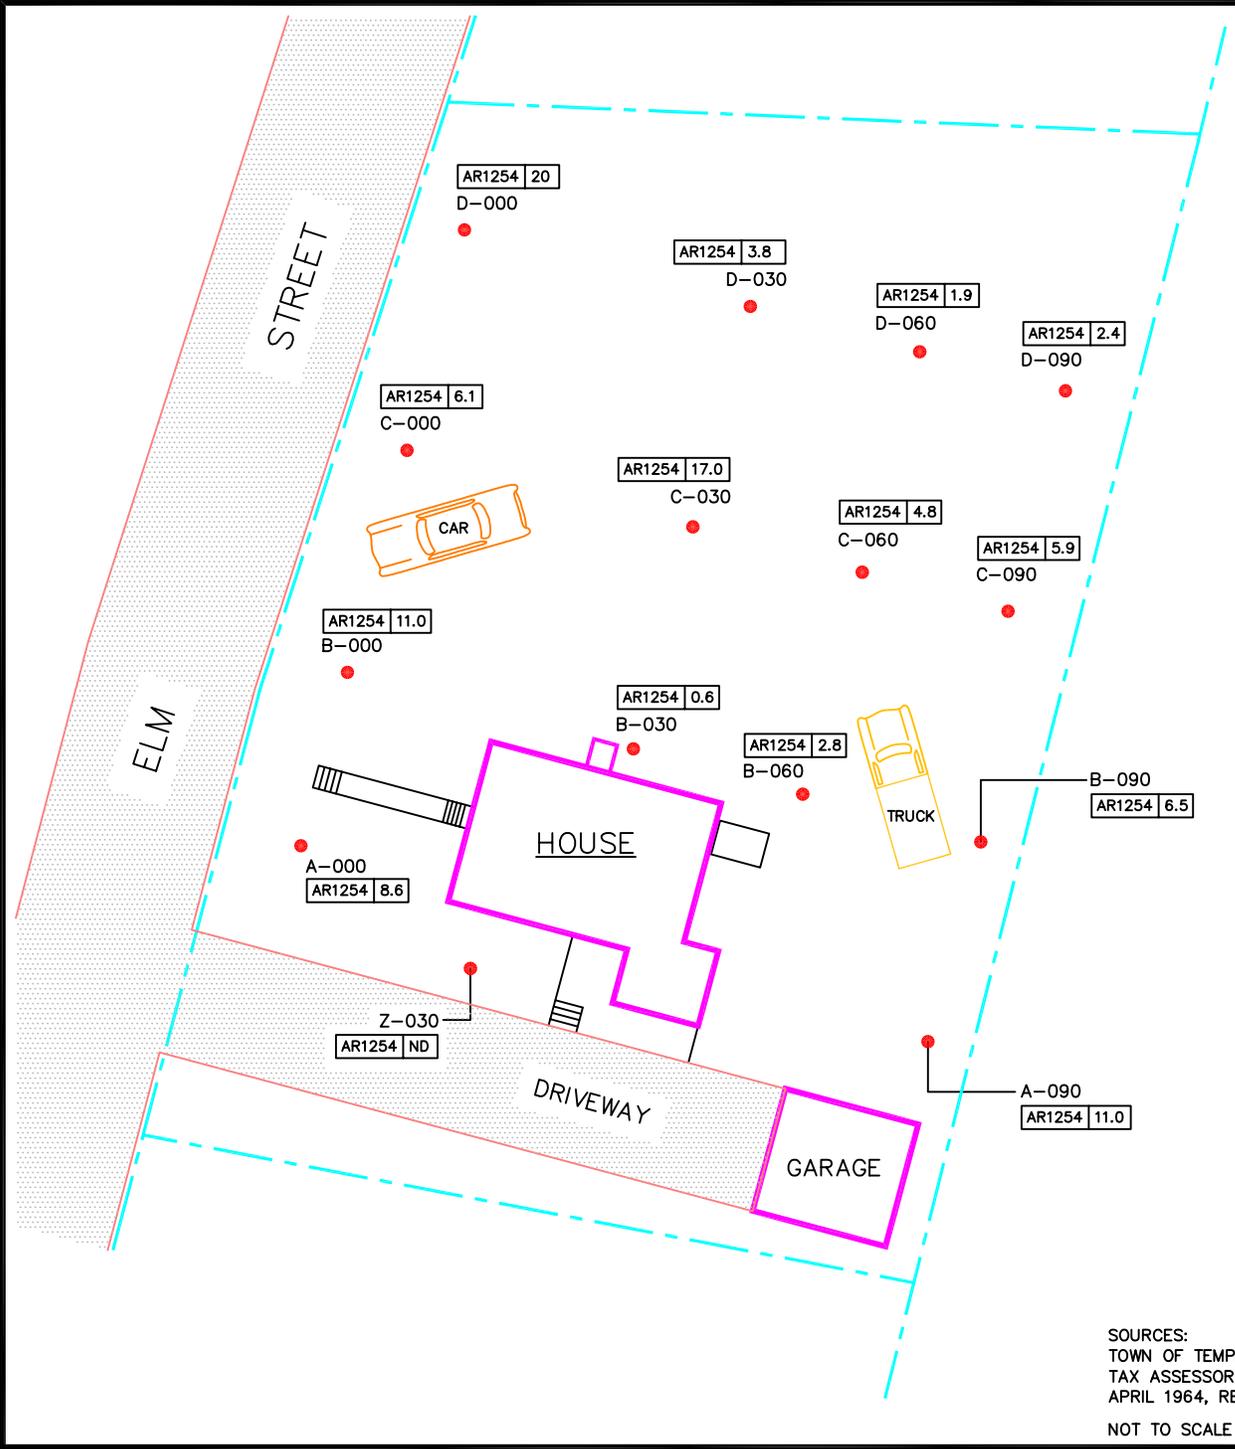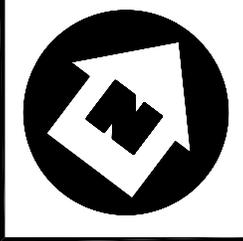

SOURCES:
 TOWN OF TEMPLETON, MASSACHUSETTS
 TAX ASSESSORS MAPS NOS. 6-4, AND 6.5
 APRIL 1964, REVISED JANUARY 2001
 NOT TO SCALE

LEGEND

- PAVED AREA
- SOIL SAMPLING LOCATION
- PROPERTY LINE
- DENOTES SOIL SAMPLING POINT IDENTIFICATION
- A-000** AROCLOR 1254 (PCB) RESULTS IN PARTS PER MILLION (PPM)
- AR1254 0.0**
- NOTES:
 ALL RESULTS ARE REPORTED IN MG/KG (PARTS PER MILLION)
 ND = NOT DETECTED
 J = RESULT IS ESTIMATED

SITE DIAGRAM



BALDWINVILLE RESIDENTIAL
 PROPERTIES
 R-003
 BALDWINVILLE, MASSACHUSETTS



REGION I SUPERFUND TECHNICAL ASSESSMENT AND RESPONSE TEAM

TDD # 05-07-0008	DRAWN BY: W. SHAW	DATE 12/7/04
---------------------	----------------------	-----------------

FILE NAME: R:\05070008\FIGURES\PROPERTY DIAGRAMS\R-003 PASI.DWG	FIGURE 2
---	----------

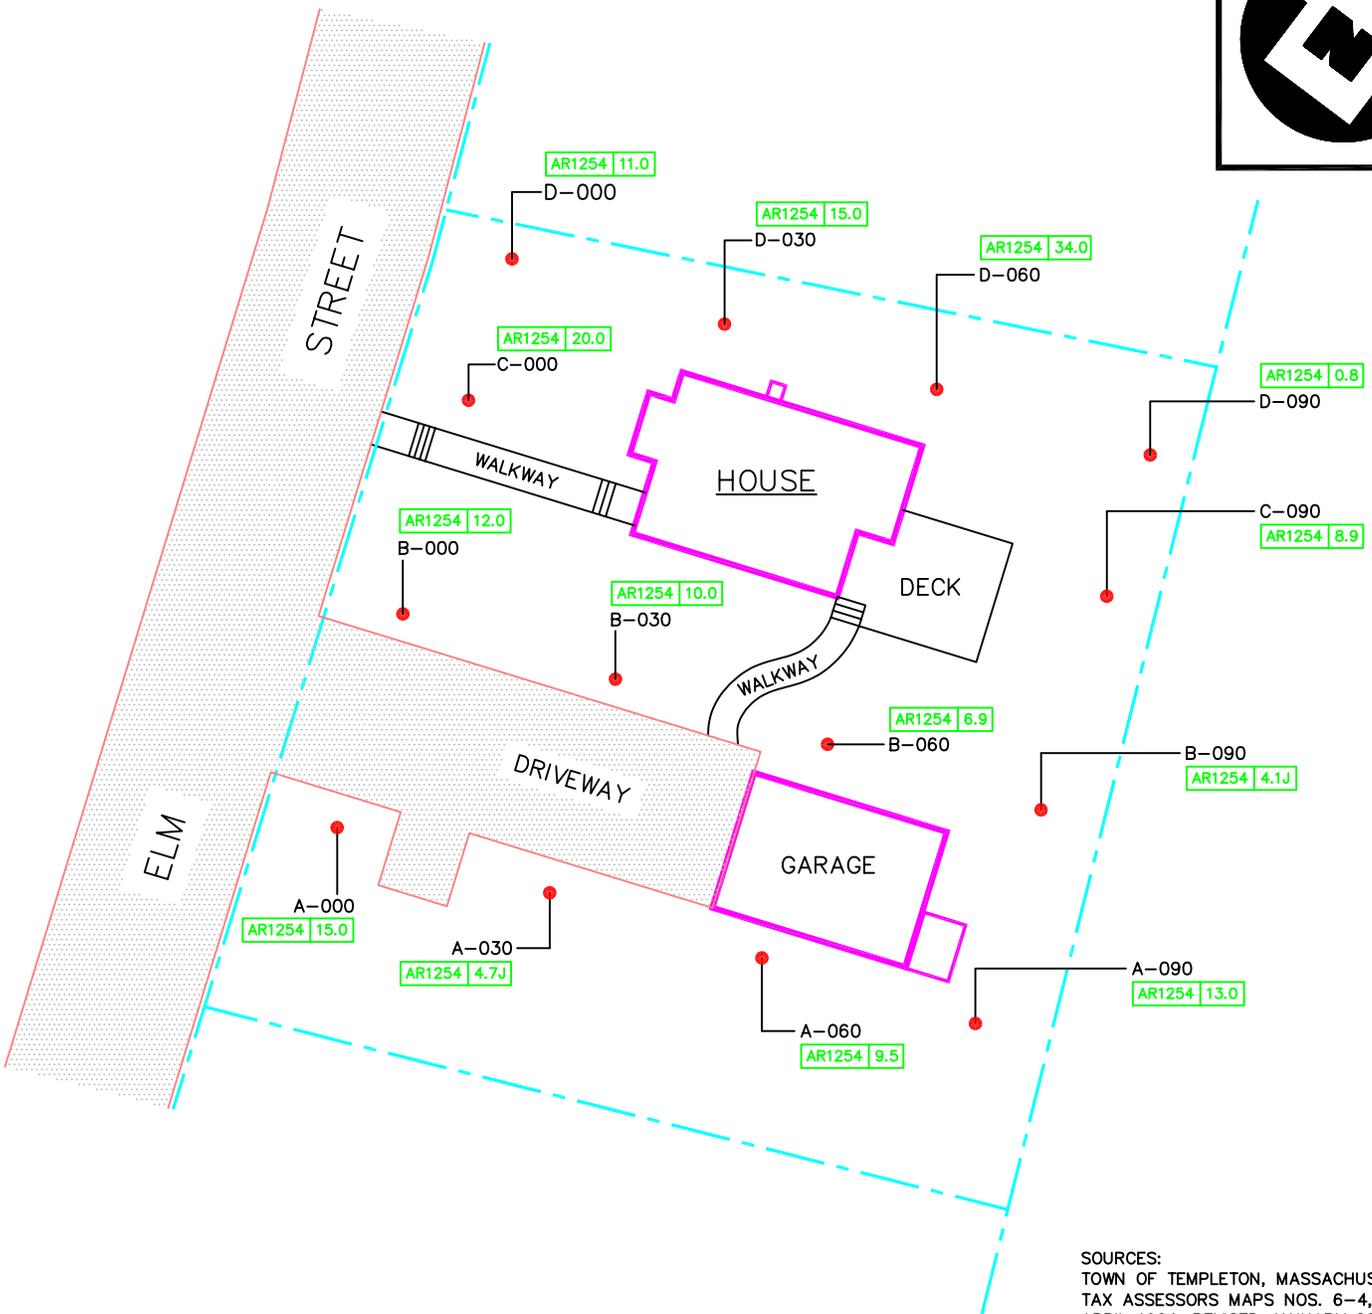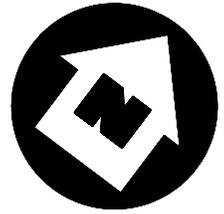

SOURCES:
TOWN OF TEMPLETON, MASSACHUSETTS
TAX ASSESSORS MAPS NOS. 6-4, AND 6.5
APRIL 1964, REVISED JANUARY 2001
NOT TO SCALE

LEGEND

- PAVED AREA
- SOIL SAMPLING LOCATION
- PROPERTY LINE
- DENOTES SOIL SAMPLING POINT IDENTIFICATION
- AROCLOR 1254 (PCB) RESULTS IN PARTS PER MILLION (PPM)

NOTES:
ALL RESULTS ARE REPORTED IN MG/KG (PARTS PER MILLION)
ND = NOT DETECTED
J = RESULT IS ESTIMATED

SITE DIAGRAM
BALDWINVILLE RESIDENTIAL
PROPERTIES
R-004 & R-005
BALDWINVILLE, MASSACHUSETTS



REGION I SUPERFUND TECHNICAL ASSESSMENT AND RESPONSE TEAM



TDD #
05-07-0008

DRAWN BY:
W. SHAW

DATE
2/15/05

FILE NAME:
R:\05070008\FIGURES\PROPERTY DIAGRAMS\R-004_005
PASI.DWG

FIGURE 2

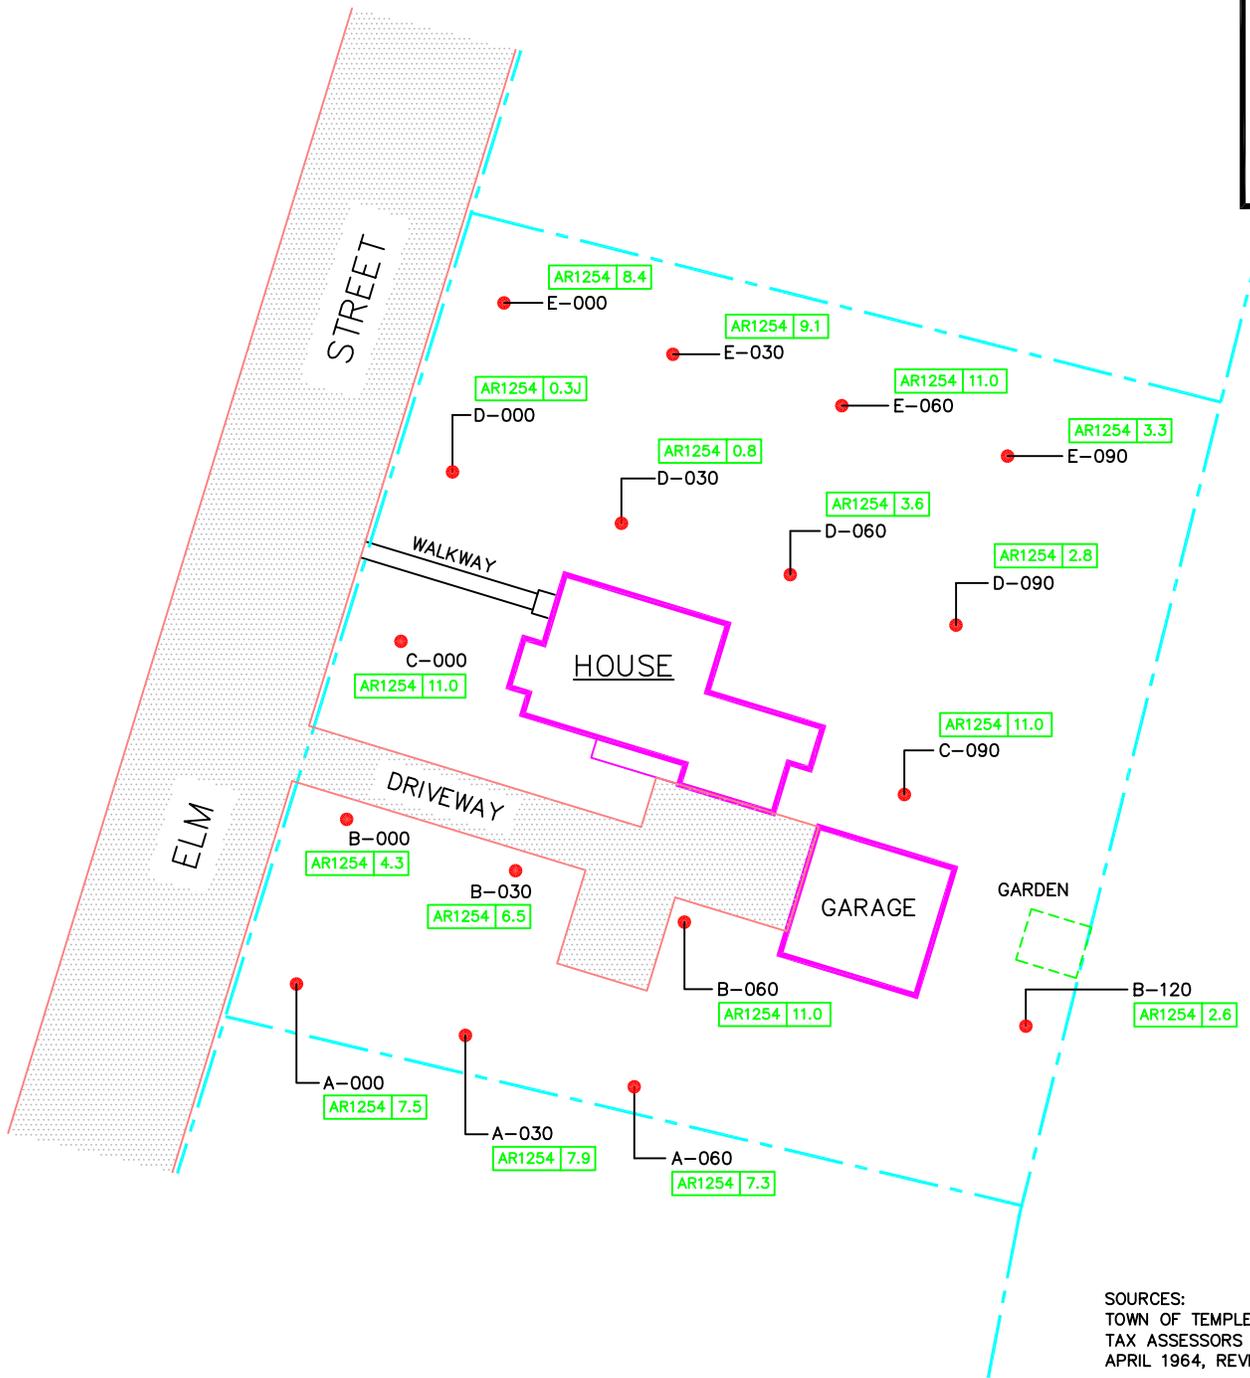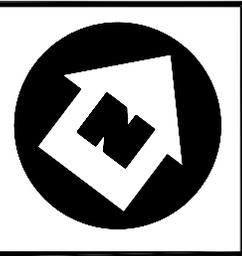

SOURCES:
 TOWN OF TEMPLETON, MASSACHUSETTS
 TAX ASSESSORS MAPS NOS. 6-4, AND 6.5
 APRIL 1964, REVISED JANUARY 2001
 NOT TO SCALE

LEGEND

- PAVED AREA
- SOIL SAMPLING LOCATION
- PROPERTY LINE
- DENOTES SOIL SAMPLING POINT IDENTIFICATION
- A-000 AROCLOR 1254 (PCB) RESULTS IN PARTS PER MILLION (PPM)
- AR1254 | 0.0

NOTES:
 ALL RESULTS ARE REPORTED IN MG/KG (PARTS PER MILLION)
 ND = NOT DETECTED
 J = RESULT IS ESTIMATED

SITE DIAGRAM

BALDWINVILLE RESIDENTIAL
 PROPERTIES
 R-006

BALDWINVILLE, MASSACHUSETTS



REGION I SUPERFUND TECHNICAL ASSESSMENT AND RESPONSE TEAM



TDD #
 05-07-0008

DRAWN BY:
 W. SHAW

DATE
 2/15/05

FILE NAME:
 R:\05070008\FIGURES\PROPERTY DIAGRAMS\R-006
 PASI.DWG

FIGURE 2

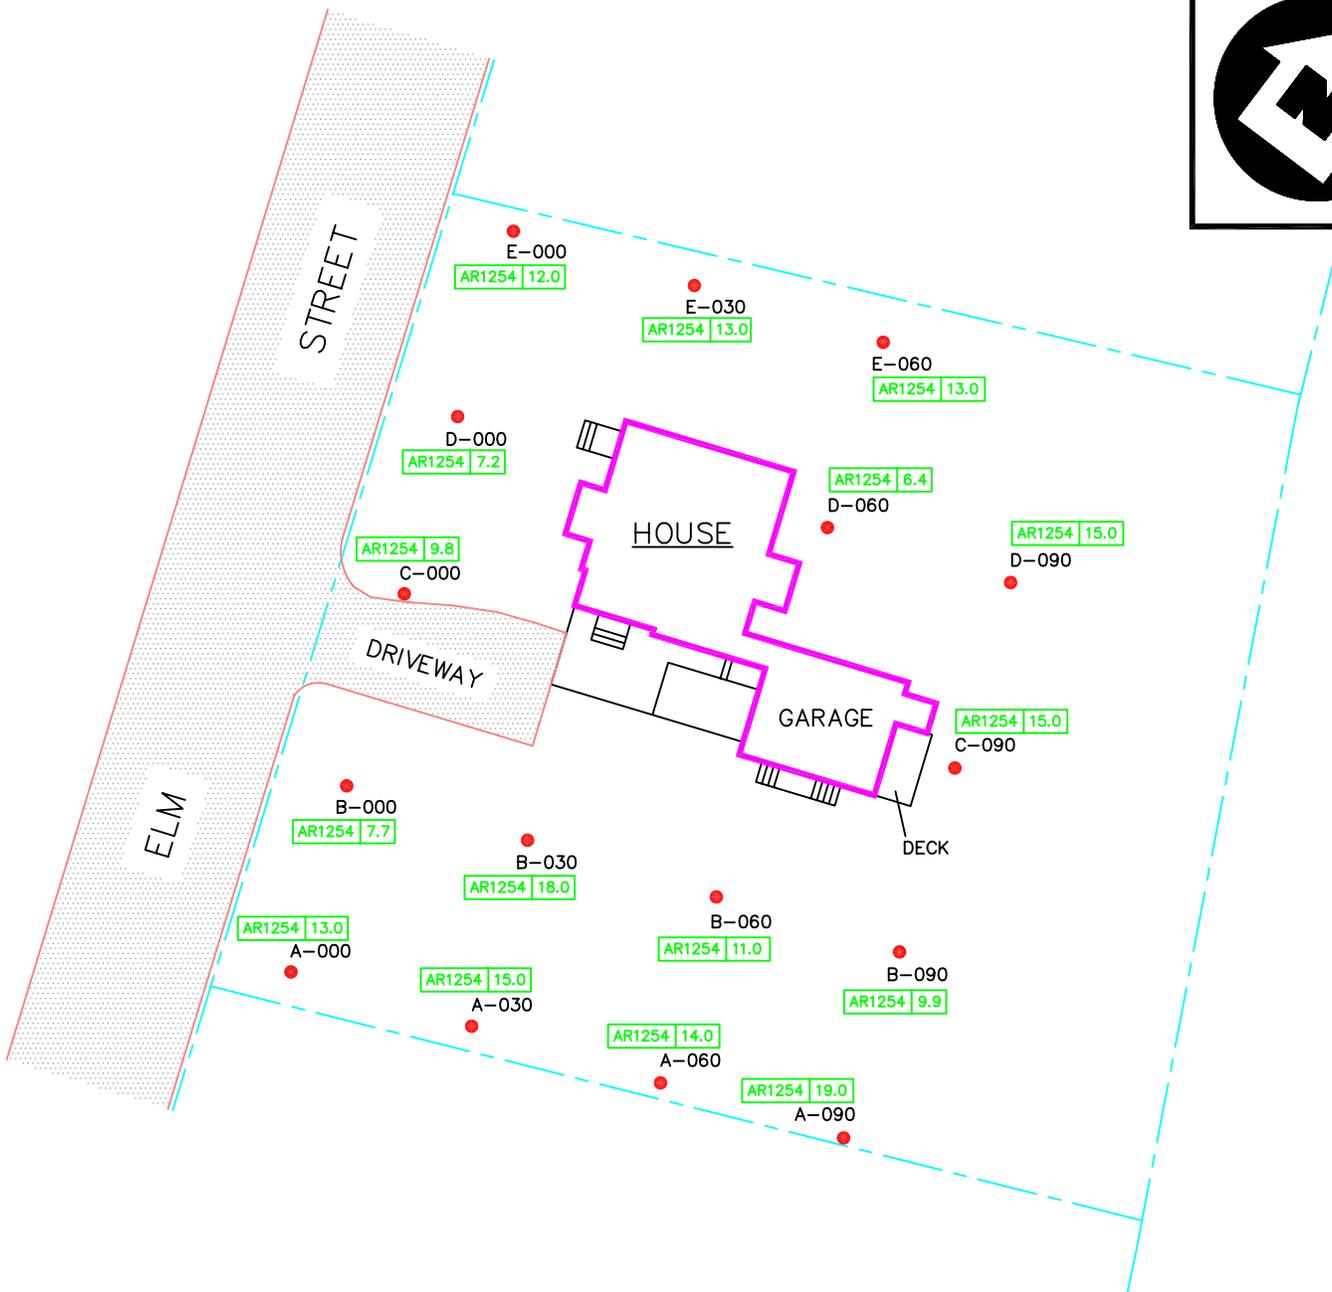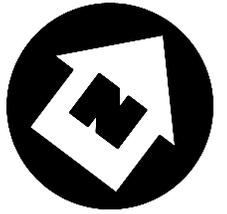

SOURCES:
 TOWN OF TEMPLETON, MASSACHUSETTS
 TAX ASSESSORS MAPS NOS. 6-4, AND 6.5
 APRIL 1964, REVISED JANUARY 2001
 NOT TO SCALE

LEGEND

- PAVED AREA
- PROPERTY LINE
- SOIL SAMPLING LOCATION
- DENOTES SOIL SAMPLING POINT IDENTIFICATION
- AROCLOR 1254 (PCB) RESULTS IN PARTS PER MILLION (PPM)

NOTES:
 ALL RESULTS ARE REPORTED IN MG/KG (PARTS PER MILLION)
 ND = NOT DETECTED
 J = RESULT IS ESTIMATED

SITE DIAGRAM

BALDWINVILLE RESIDENTIAL
 PROPERTIES
 R-007


BALDWINVILLE, MASSACHUSETTS



REGION I SUPERFUND TECHNICAL ASSESSMENT AND RESPONSE TEAM

TDD # 05-07-0008	DRAWN BY: W. SHAW	DATE 2/16/05
---------------------	----------------------	-----------------

FILE NAME: R:\05070008\FIGURES\PROPERTY DIAGRAMS\R-007 PASI.DWG	FIGURE 2
---	----------

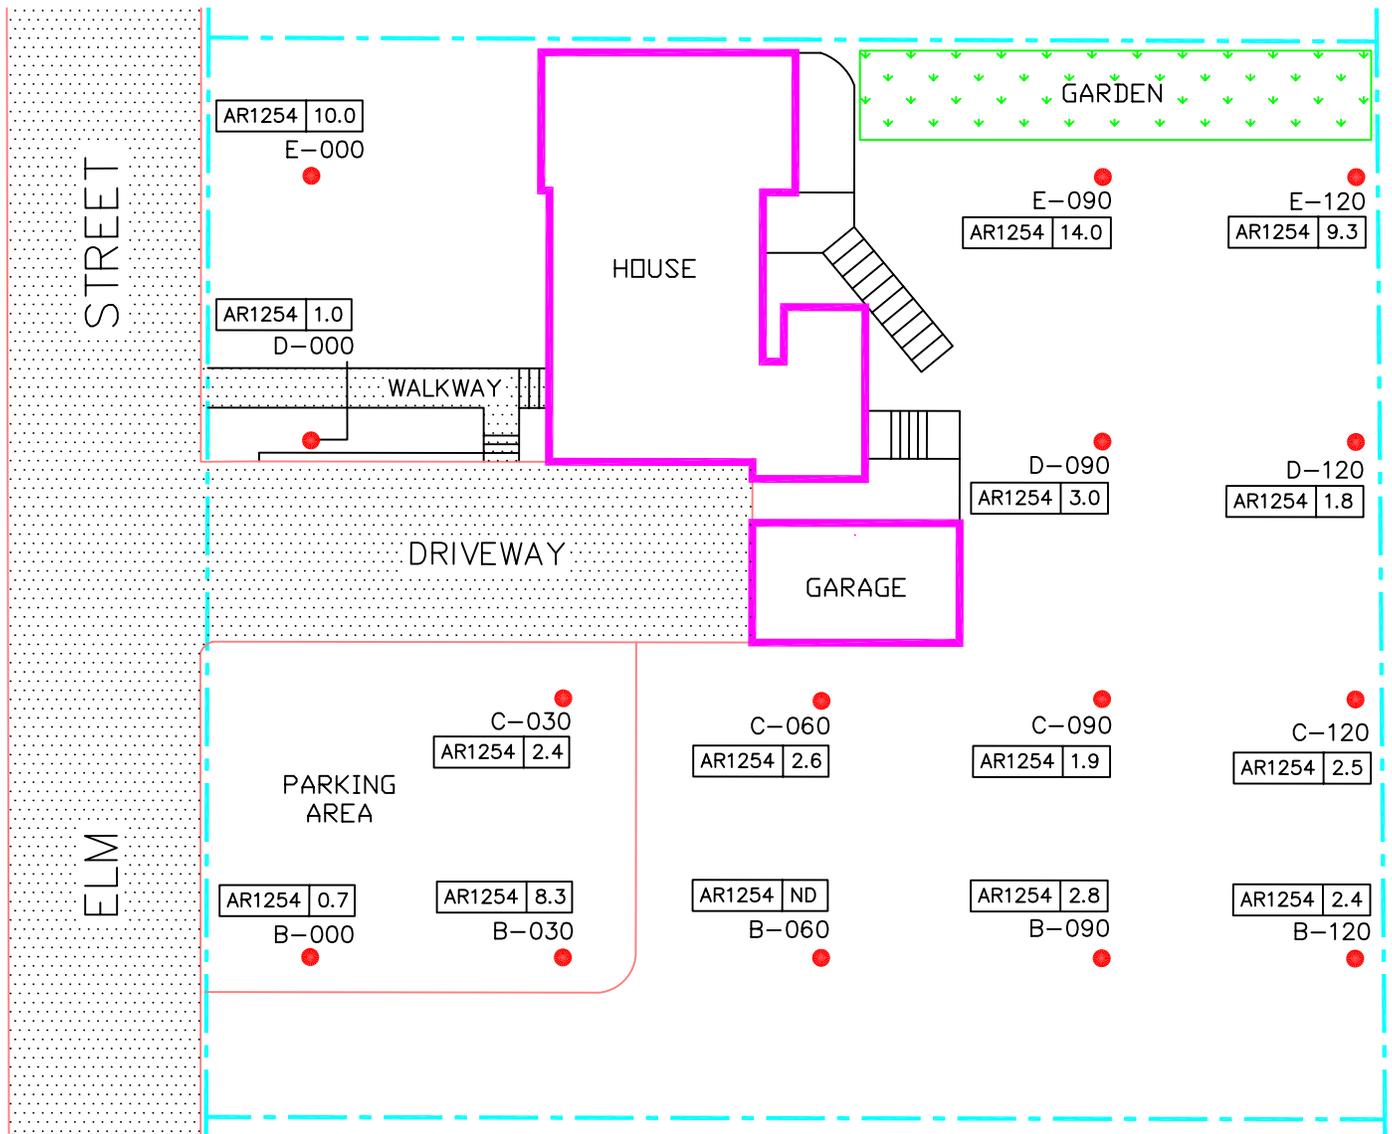

SOURCES:
TOWN OF TEMPLETON, MASSACHUSETTS
TAX ASSESSORS MAPS NOS. 6-4, AND 6.5
APRIL 1964, REVISED JANUARY 2001

LEGEND

NOT TO SCALE

PAVED AREA
 PROPERTY LINE

SOIL SAMPLING LOCATION

DENOTES SOIL SAMPLING POINT IDENTIFICATION
A-000 AROCLOR 1254 (PCB) RESULTS IN PARTS PER MILLION (PPM)
 AR1254 0.0

NOTES:
ALL RESULTS ARE REPORTED IN MG/KG (PARTS PER MILLION)
ND = NOT DETECTED

SITE DIAGRAM

BALDWINVILLE RESIDENTIAL PROPERTIES
R-008
BALDWINVILLE, MASSACHUSETTS



REGION I SUPERFUND TECHNICAL ASSESSMENT AND RESPONSE TEAM



TDD #
05-07-0008

DRAWN BY:
K. BRENNAN

DATE
2/08/07

FILE NAME:
R:\05070008\FIGURES\PROPERTY DIAGRAMS\R-008
PASI.DWG

FIGURE 2

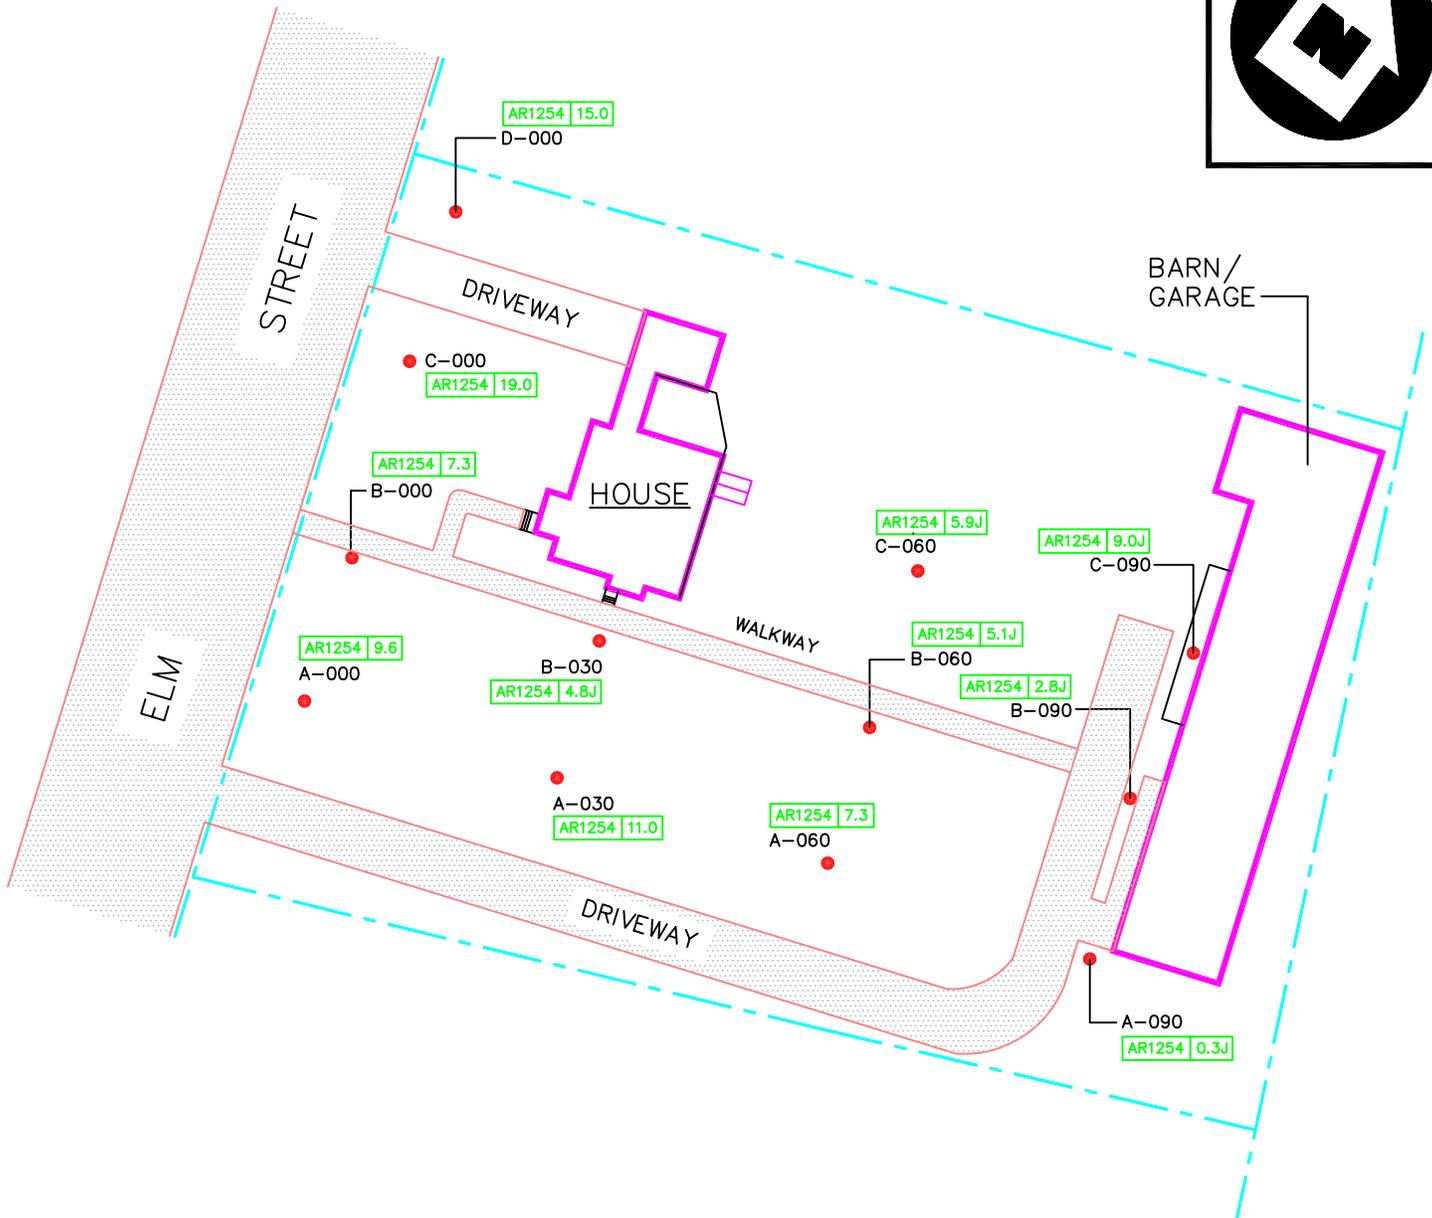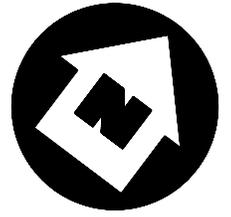

SOURCES:
 TOWN OF TEMPLETON, MASSACHUSETTS
 TAX ASSESSORS MAPS NOS. 6-4, AND 6.5
 APRIL 1964, REVISED JANUARY 2001
 NOT TO SCALE

LEGEND

- PAVED AREA
 - PROPERTY LINE
 - SOIL SAMPLING LOCATION
 - DENOTES SOIL SAMPLING POINT IDENTIFICATION
- A-000 AROCLOR 1254 (PCB) RESULTS IN PARTS PER MILLION (PPM)
 AR1254 | 0.0

NOTES:
 ALL RESULTS ARE REPORTED IN MG/KG (PARTS PER MILLION)
 ND = NOT DETECTED
 J = RESULT IS ESTIMATED

SITE DIAGRAM
 BALDWINVILLE RESIDENTIAL
 PROPERTIES
 R-009
 BALDWINVILLE, MASSACHUSETTS



REGION I SUPERFUND TECHNICAL ASSESSMENT AND RESPONSE TEAM



TDD #
 05-07-0008

DRAWN BY:
 W. SHAW

DATE
 2/16/05

FILE NAME:
 R:\05070008\FIGURES\PROPERTY DIAGRAMS\R-009
 PASI.DWG

FIGURE 2

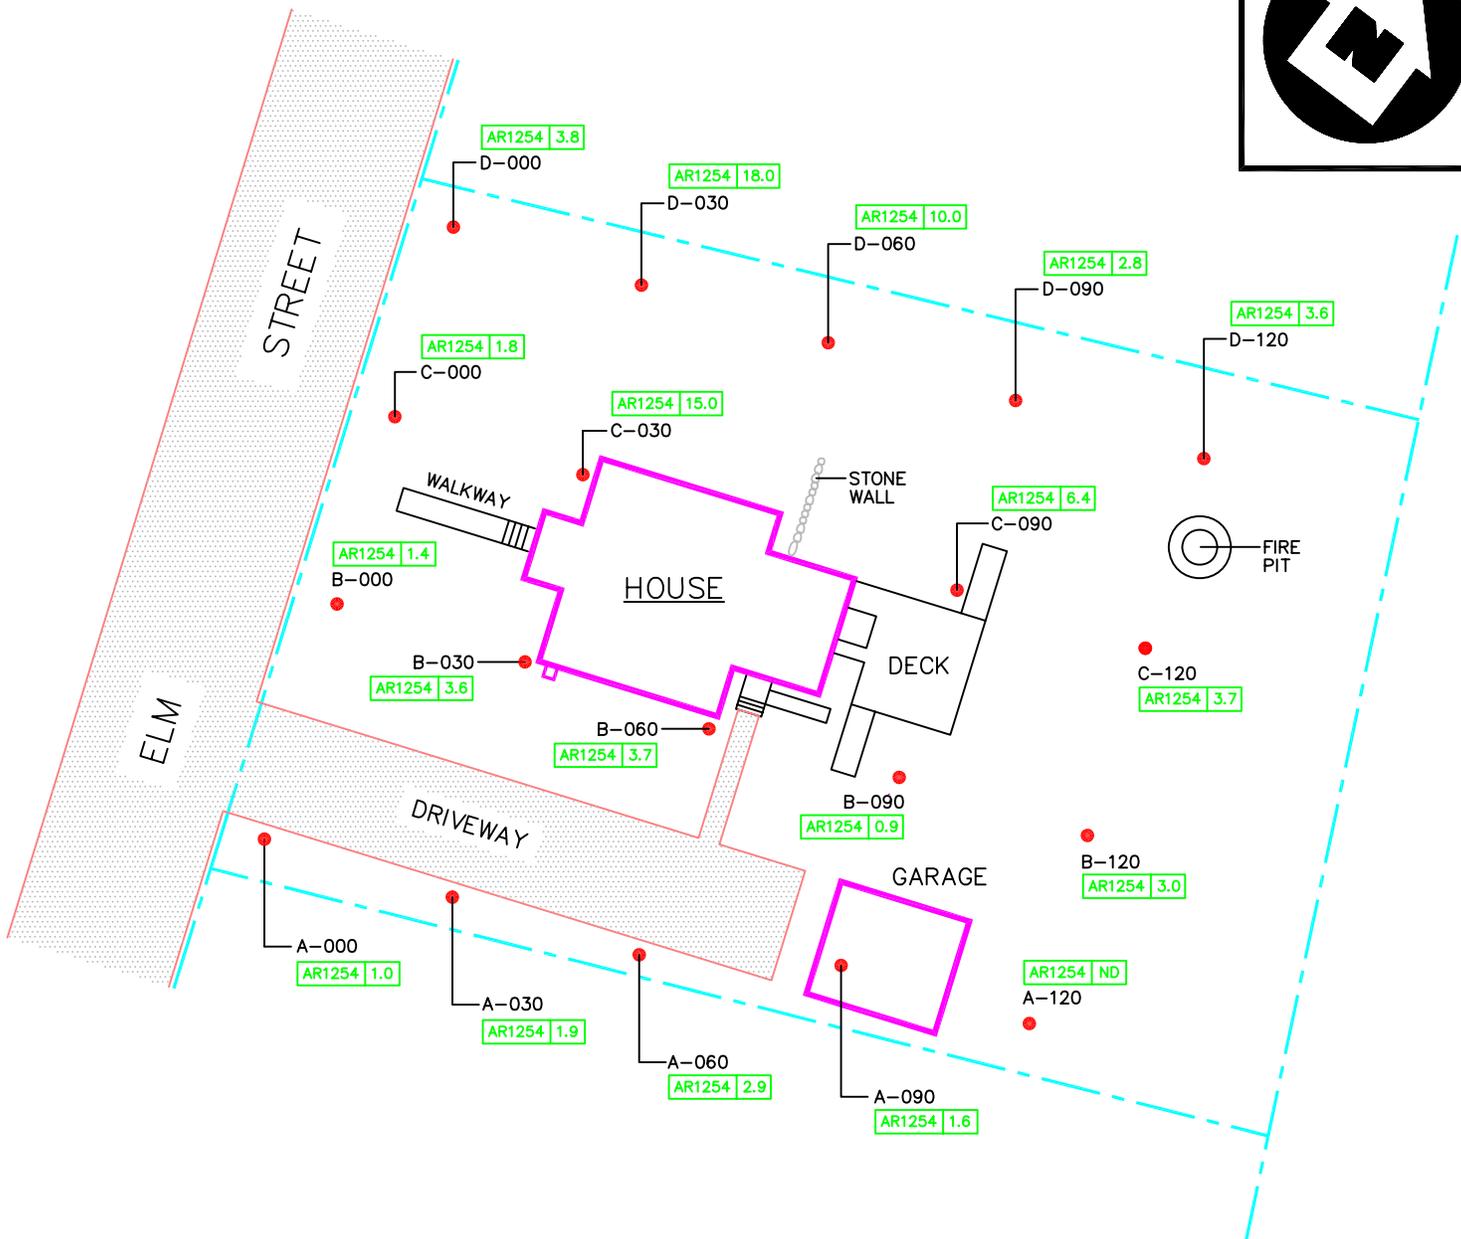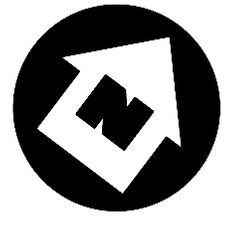

SOURCES:
TOWN OF TEMPLETON, MASSACHUSETTS
TAX ASSESSORS MAPS NOS. 6-4, AND 6.5
APRIL 1964, REVISED JANUARY 2001
NOT TO SCALE

LEGEND

- PAVED AREA
- PROPERTY LINE
- SOIL SAMPLING LOCATION
- DENOTES SOIL SAMPLING POINT IDENTIFICATION
- A-000
AR1254 | 0.0
- AROCLOR 1254 (PCB)
RESULTS IN PARTS
PER MILLION (PPM)

NOTES:
ALL RESULTS ARE REPORTED IN
MG/KG (PARTS PER MILLION)
ND = NOT DETECTED
J = RESULT IS ESTIMATED

SITE DIAGRAM

BALDWINVILLE RESIDENTIAL
PROPERTIES

R-010



BALDWINVILLE, MASSACHUSETTS



REGION I SUPERFUND TECHNICAL ASSESSMENT AND RESPONSE TEAM

TDD # 05-07-0008	DRAWN BY: W. SHAW	DATE 2/17/05
---------------------	----------------------	-----------------

FILE NAME: R:\05070008\FIGURES\PROPERTY DIAGRAMS\R-010 PASI.DWG	FIGURE 2
---	----------

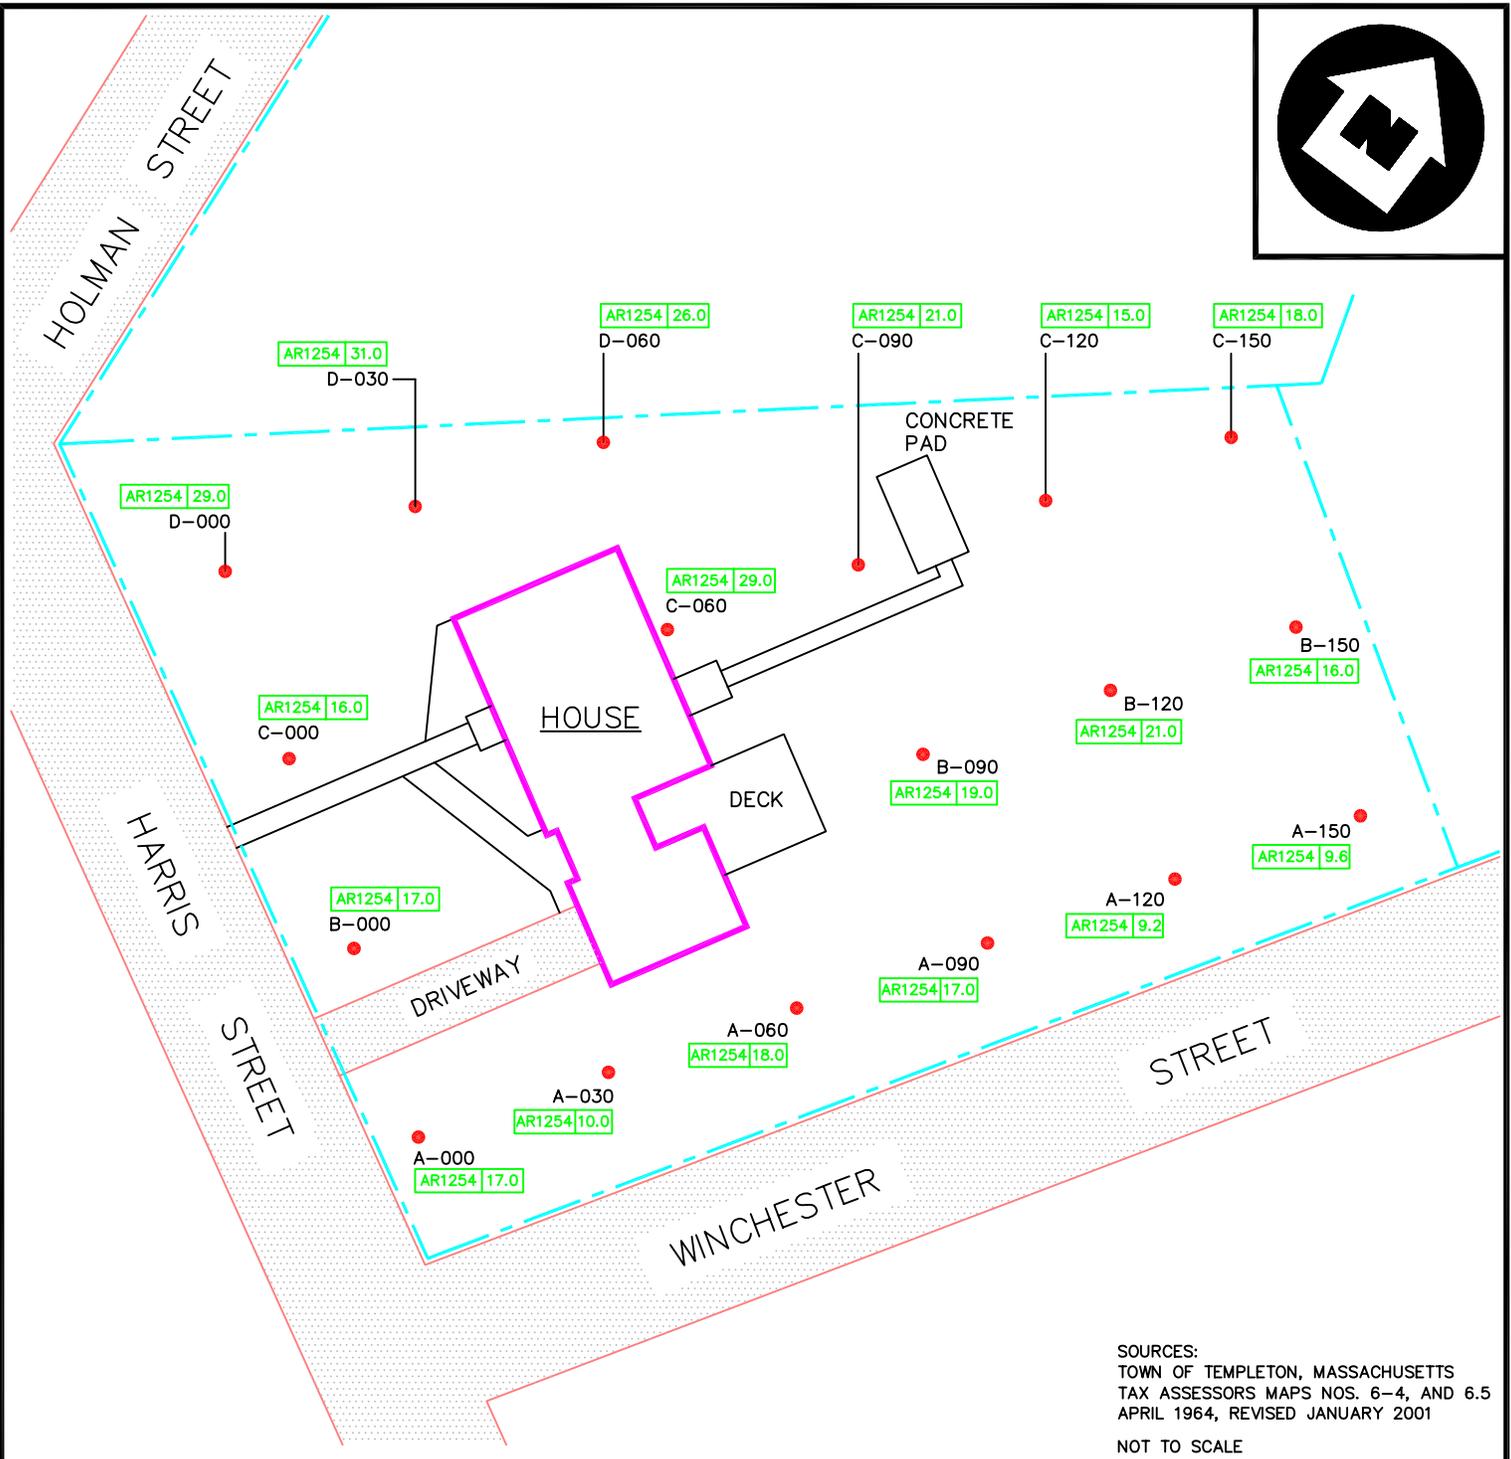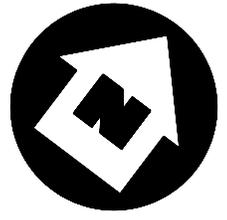

SOURCES:
 TOWN OF TEMPLETON, MASSACHUSETTS
 TAX ASSESSORS MAPS NOS. 6-4, AND 6.5
 APRIL 1964, REVISED JANUARY 2001
 NOT TO SCALE

LEGEND



- PAVED AREA
- PROPERTY LINE
- SOIL SAMPLING LOCATION
- DENOTES SOIL SAMPLING POINT IDENTIFICATION
- A-000
AR1254 | 0.0 AROCLOR 1254 (PCB) RESULTS IN PARTS PER MILLION (PPM)

NOTES:
 ALL RESULTS ARE REPORTED IN MG/KG (PARTS PER MILLION)
 ND = NOT DETECTED
 J = RESULT IS ESTIMATED

SITE DIAGRAM
 BALDWINVILLE RESIDENTIAL
 PROPERTIES
 R-011
 BALDWINVILLE, MASSACHUSETTS

REGION I SUPERFUND TECHNICAL ASSESSMENT AND RESPONSE TEAM

TDD # 05-07-0008	DRAWN BY: W. SHAW	DATE 12/8/04
FILE NAME: R:\05070008\FIGURES\PROPERTY DIAGRAMS\R-011 PASI.DWG		FIGURE 2

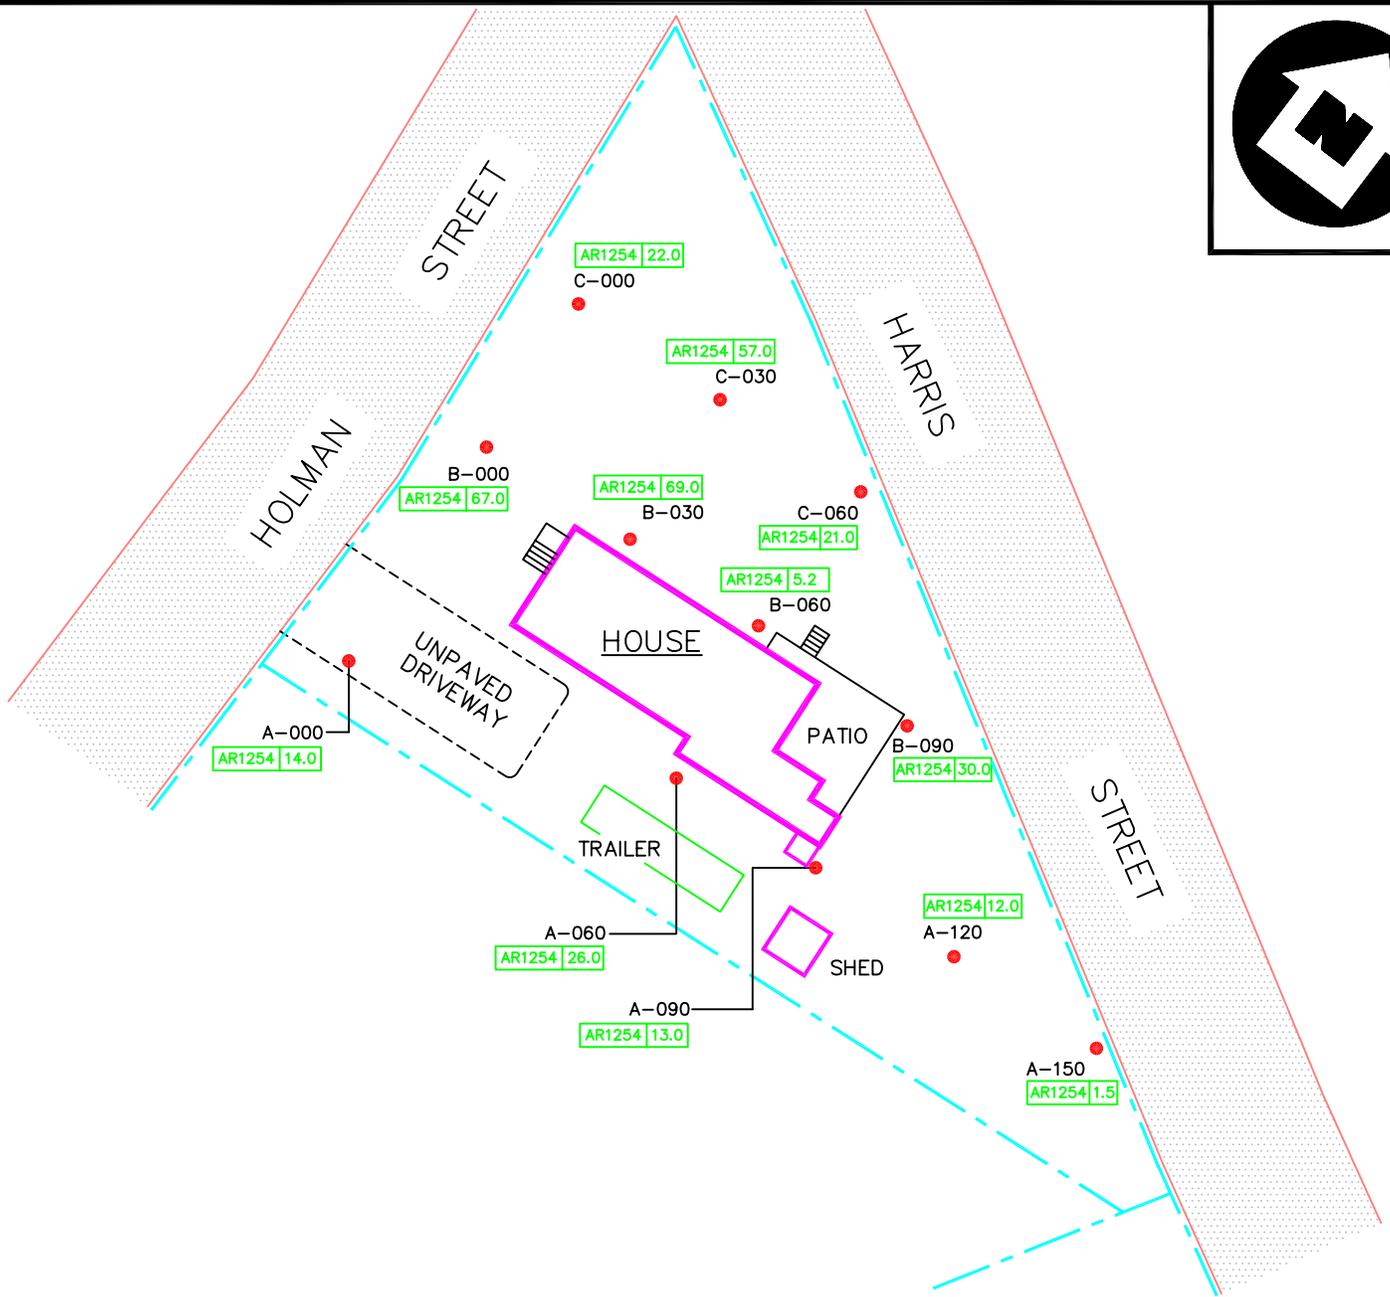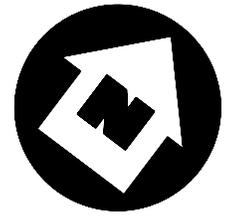

SOURCES:
TOWN OF TEMPLETON, MASSACHUSETTS
TAX ASSESSORS MAPS NOS. 6-4, AND 6.5
APRIL 1964, REVISED JANUARY 2001
NOT TO SCALE

LEGEND

- PAVED AREA
- SOIL SAMPLING LOCATION
- PROPERTY LINE
- DENOTES SOIL SAMPLING POINT IDENTIFICATION
- AROCLOR 1254 (PCB) RESULTS IN PARTS PER MILLION (PPM)

NOTES:
ALL RESULTS ARE REPORTED IN MG/KG (PARTS PER MILLION)
ND = NOT DETECTED
J = RESULT IS ESTIMATED

SITE DIAGRAM

BALDWINVILLE RESIDENTIAL
PROPERTIES
R-012

BALDWINVILLE, MASSACHUSETTS



REGION I SUPERFUND TECHNICAL ASSESSMENT AND RESPONSE TEAM



TDD #
05-07-0008

DRAWN BY:
W. SHAW

DATE
12/8/04

FILE NAME:
R:\05070008\FIGURES\PROPERTY DIAGRAMS\R-012
PASI.DWG

FIGURE 2

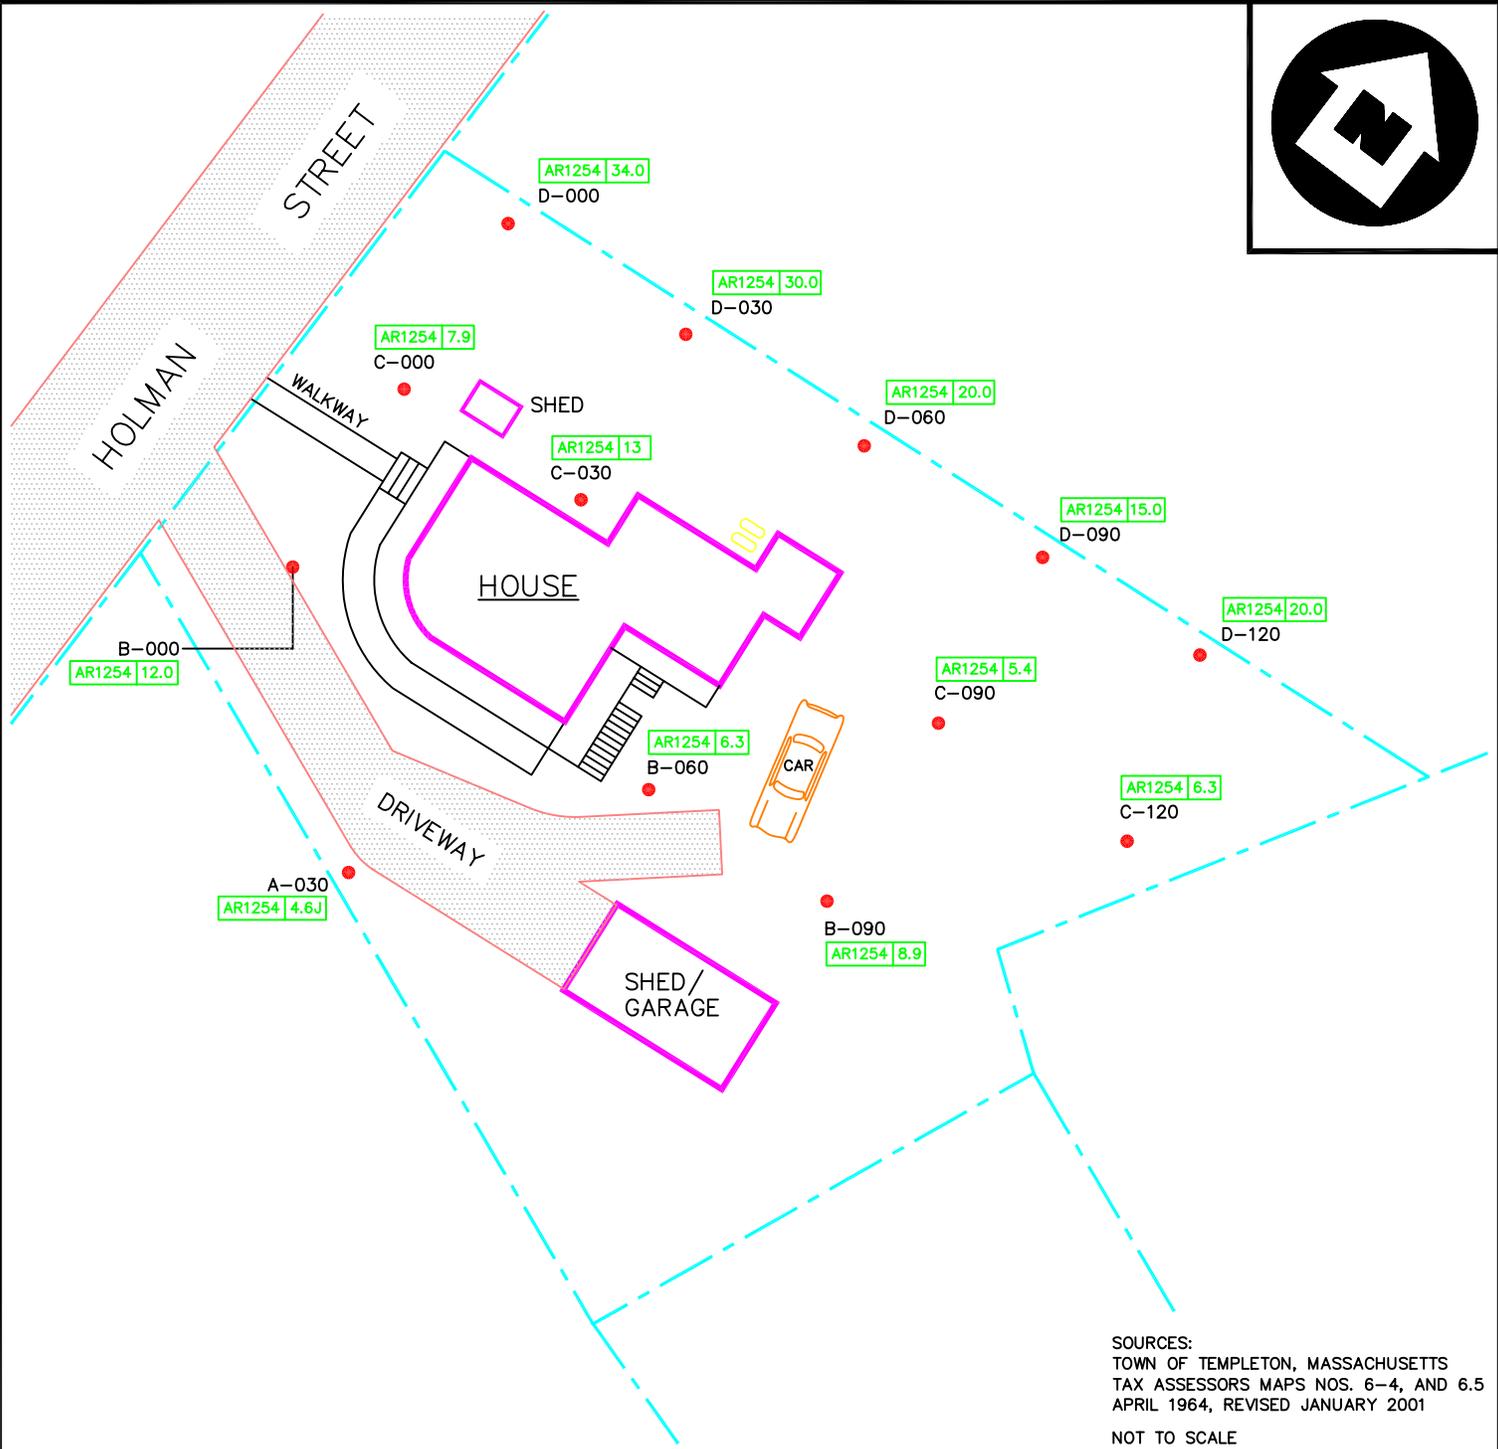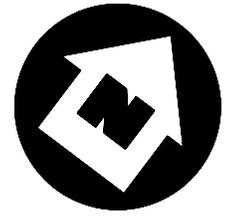

SOURCES:
TOWN OF TEMPLETON, MASSACHUSETTS
TAX ASSESSORS MAPS NOS. 6-4, AND 6.5
APRIL 1964, REVISED JANUARY 2001
NOT TO SCALE

LEGEND

- PAVED AREA
- PROPERTY LINE
- SOIL SAMPLING LOCATION
- DENOTES SOIL SAMPLING POINT IDENTIFICATION
- A-000 AROCLOR 1254 (PCB) RESULTS IN PARTS PER MILLION (PPM)
AR1254 | 0.0

NOTES:
ALL RESULTS ARE REPORTED IN MG/KG (PARTS PER MILLION)
ND = NOT DETECTED
J = RESULT IS ESTIMATED



SITE DIAGRAM

BALDWINVILLE RESIDENTIAL
PROPERTIES
R-013
BALDWINVILLE, MASSACHUSETTS



REGION I SUPERFUND TECHNICAL ASSESSMENT AND RESPONSE TEAM

TDD # 05-07-0008	DRAWN BY: W. SHAW	DATE 12/8/04
FILE NAME: R:\05070008\FIGURES\PROPERTY DIAGRAMS\R-013.DWG		FIGURE 2

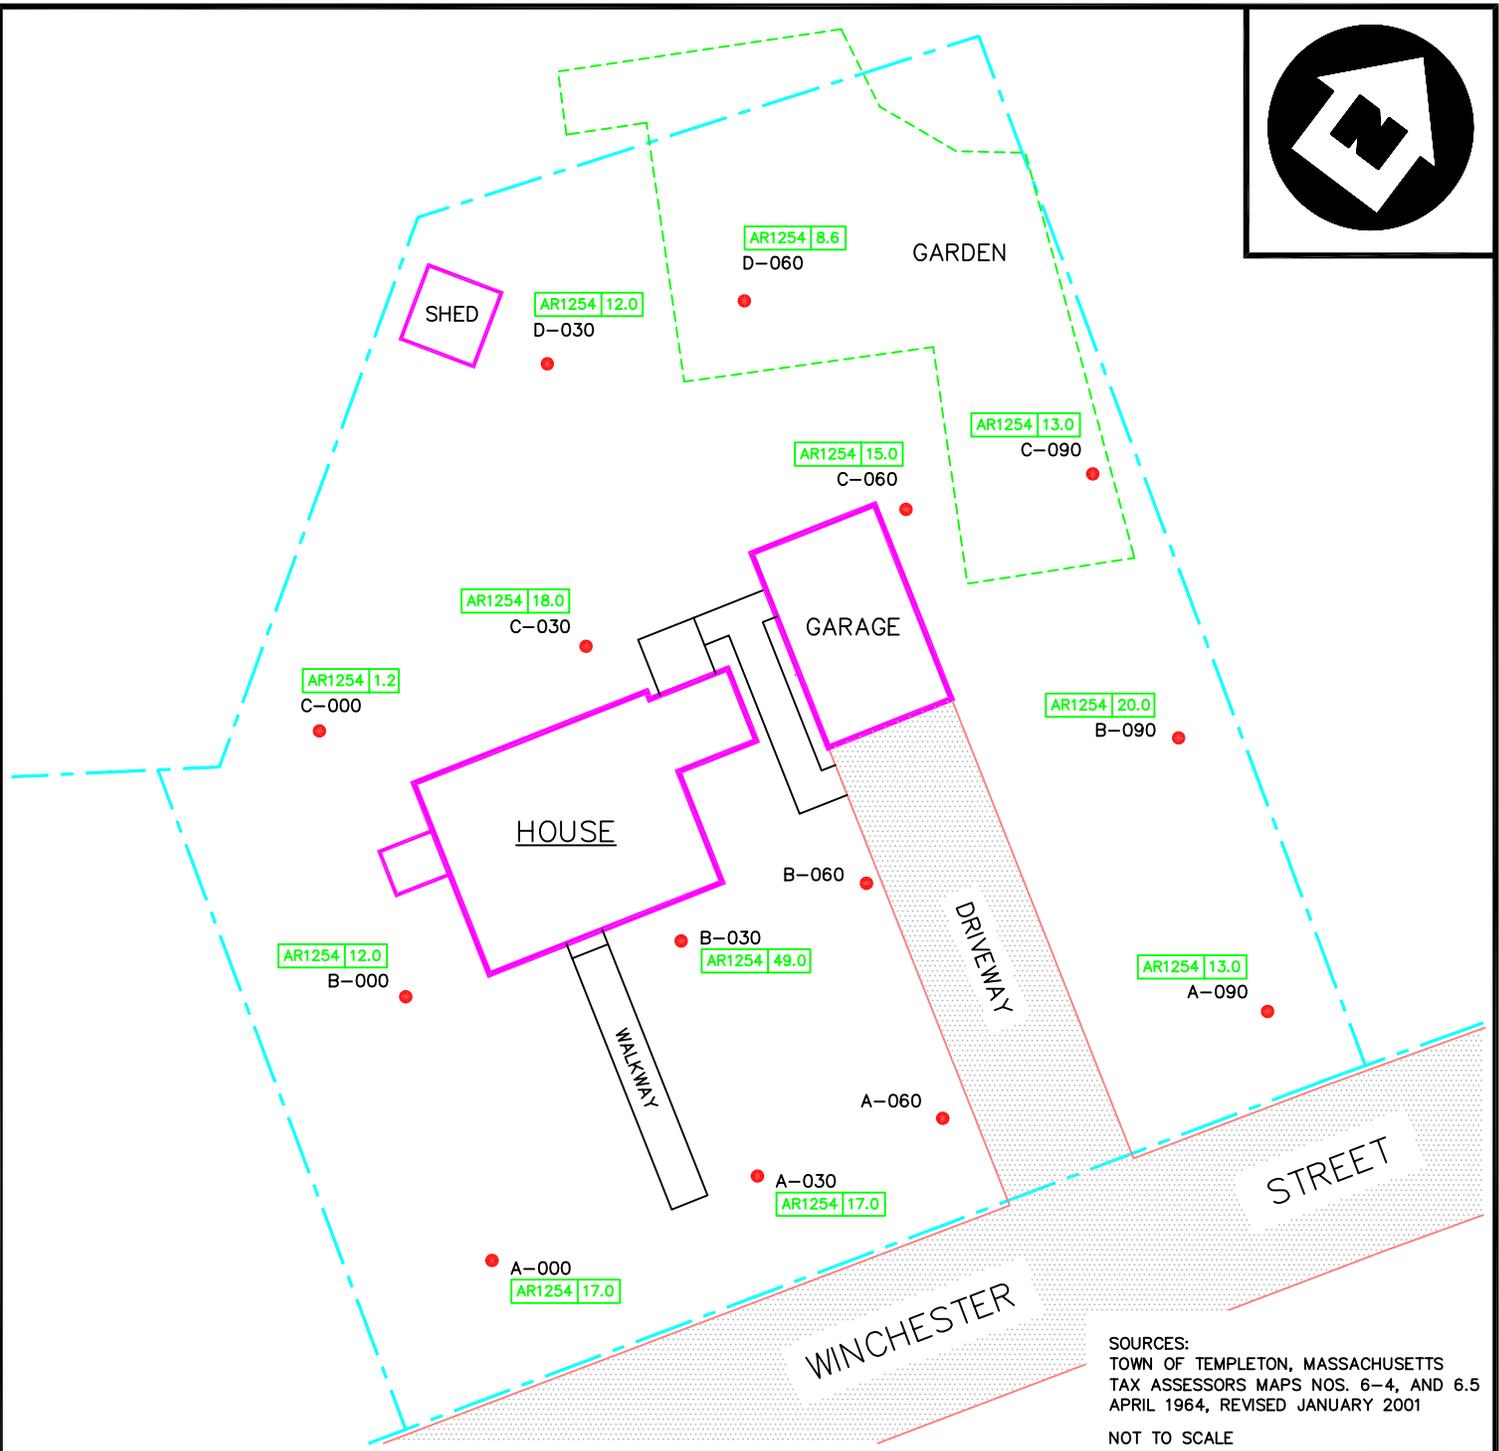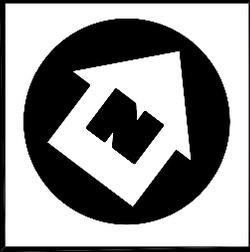

SOURCES:
TOWN OF TEMPLETON, MASSACHUSETTS
TAX ASSESSORS MAPS NOS. 6-4, AND 6.5
APRIL 1964, REVISED JANUARY 2001
NOT TO SCALE

LEGEND

- PAVED AREA
- PROPERTY LINE
- SOIL SAMPLING LOCATION
- DENOTES SOIL SAMPLING POINT IDENTIFICATION
- AROCLOR 1254 (PCB) RESULTS IN PARTS PER MILLION (PPM)

NOTES:
ALL RESULTS ARE REPORTED IN MG/KG (PARTS PER MILLION)
ND = NOT DETECTED
J = RESULT IS ESTIMATED

SITE DIAGRAM

BALDWINVILLE RESIDENTIAL
PROPERTIES
R-014

BALDWINVILLE, MASSACHUSETTS



REGION I SUPERFUND TECHNICAL ASSESSMENT AND RESPONSE TEAM



TDD #
05-07-0008

DRAWN BY:
W. SHAW

DATE
12/8/04

FILE NAME:
R:\05070008\FIGURES\PROPERTY DIAGRAMS\R-014
PASI.DWG

FIGURE 2

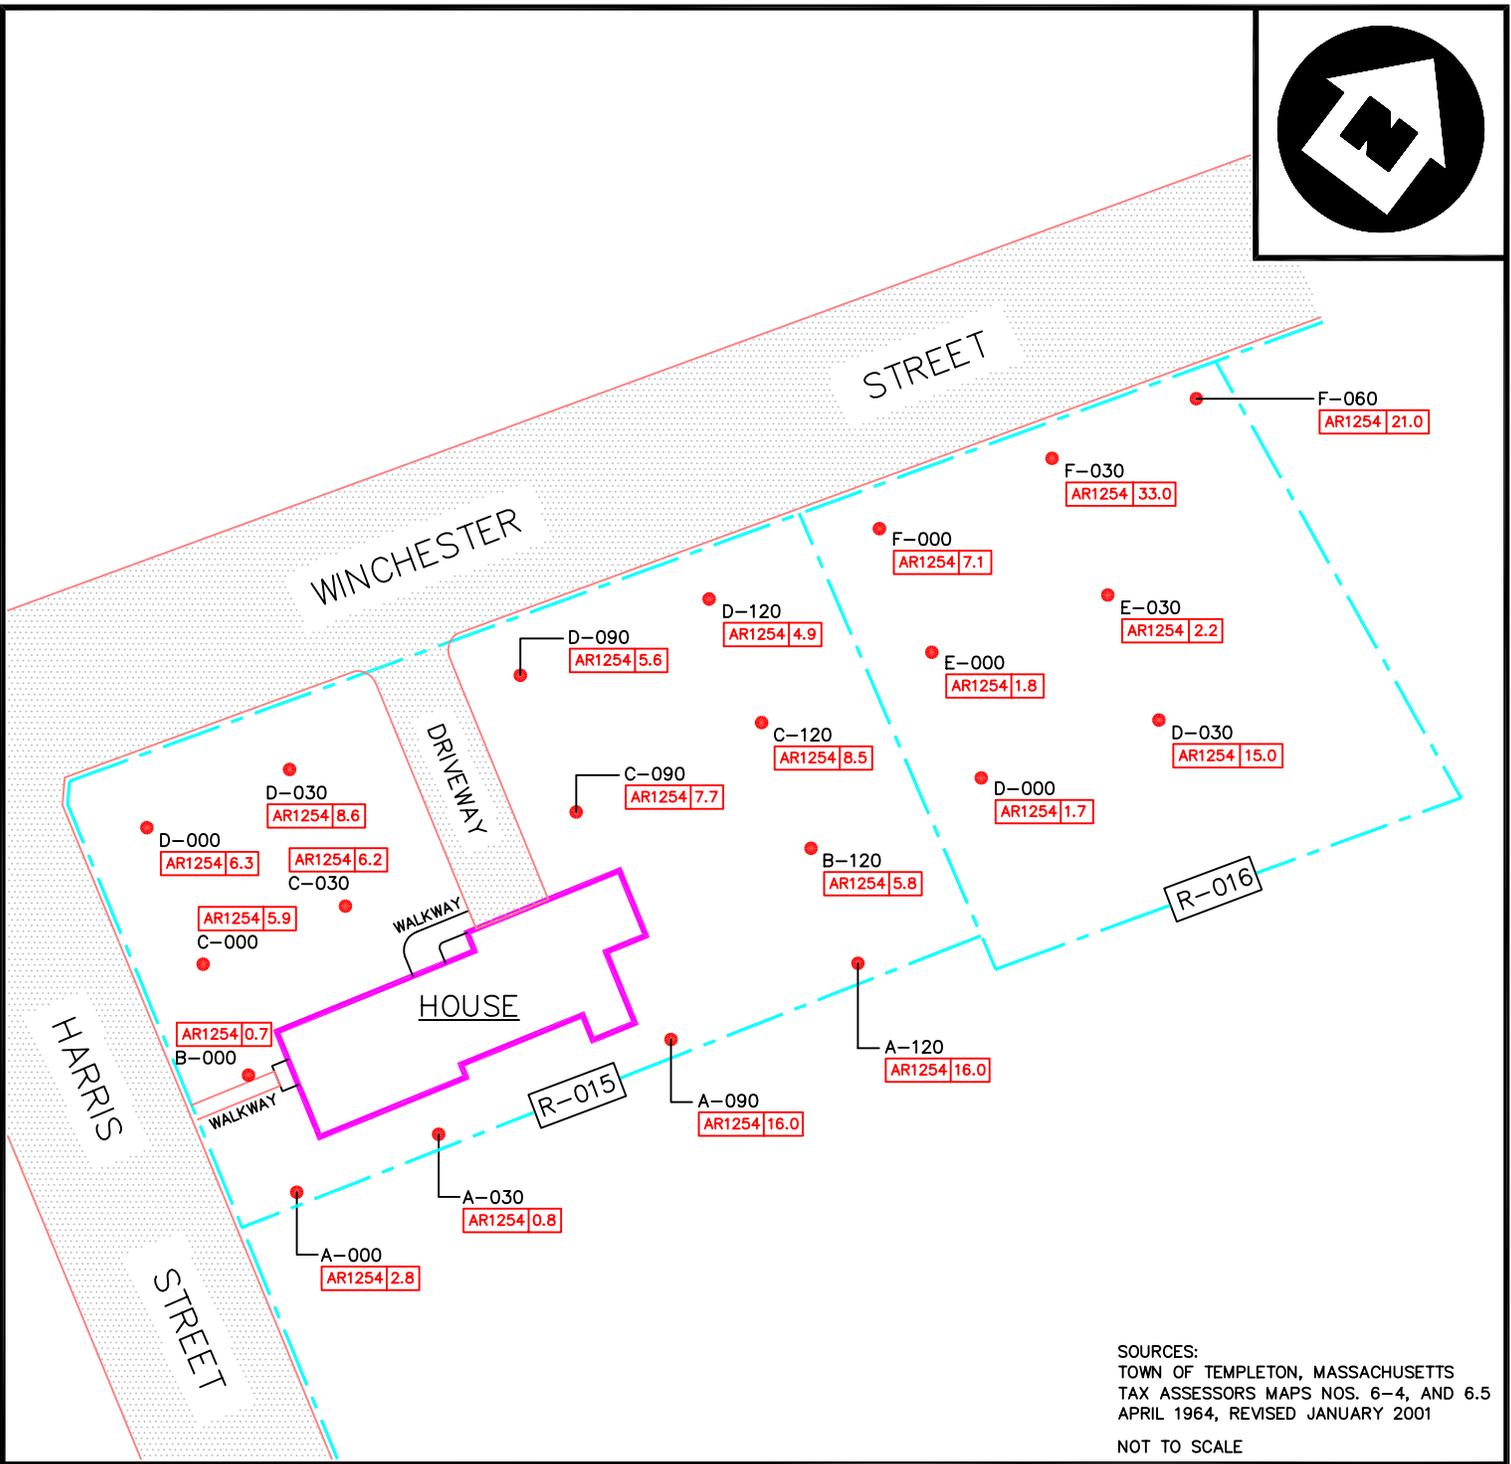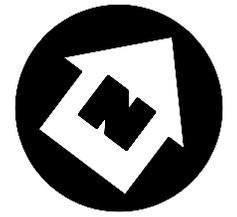

SOURCES:
 TOWN OF TEMPLETON, MASSACHUSETTS
 TAX ASSESSORS MAPS NOS. 6-4, AND 6.5
 APRIL 1964, REVISED JANUARY 2001
 NOT TO SCALE

LEGEND

- PAVED AREA
 - SOIL SAMPLING LOCATION
 - PROPERTY LINE
 - DENOTES SOIL SAMPLING POINT IDENTIFICATION
- A-000 AROCLOR 1254 (PCB) RESULTS IN PARTS PER MILLION (PPM)
 AR1254 | 0.0

NOTES:
 ALL RESULTS ARE REPORTED IN MG/KG (PARTS PER MILLION)
 ND = NOT DETECTED
 J = RESULT IS ESTIMATED

SITE DIAGRAM



BALDWINVILLE RESIDENTIAL
 PROPERTIES
 R-015 & R-016
 BALDWINVILLE, MASSACHUSETTS



REGION I SUPERFUND TECHNICAL ASSESSMENT AND RESPONSE TEAM

TDD # 05-07-0008	DRAWN BY: W. SHAW	DATE 12/8/04
---------------------	----------------------	-----------------

FILE NAME: R:\05070008\FIGURES\PROPERTY DIAGRAMS\R015_R016.DWG	FIGURE 2
---	----------

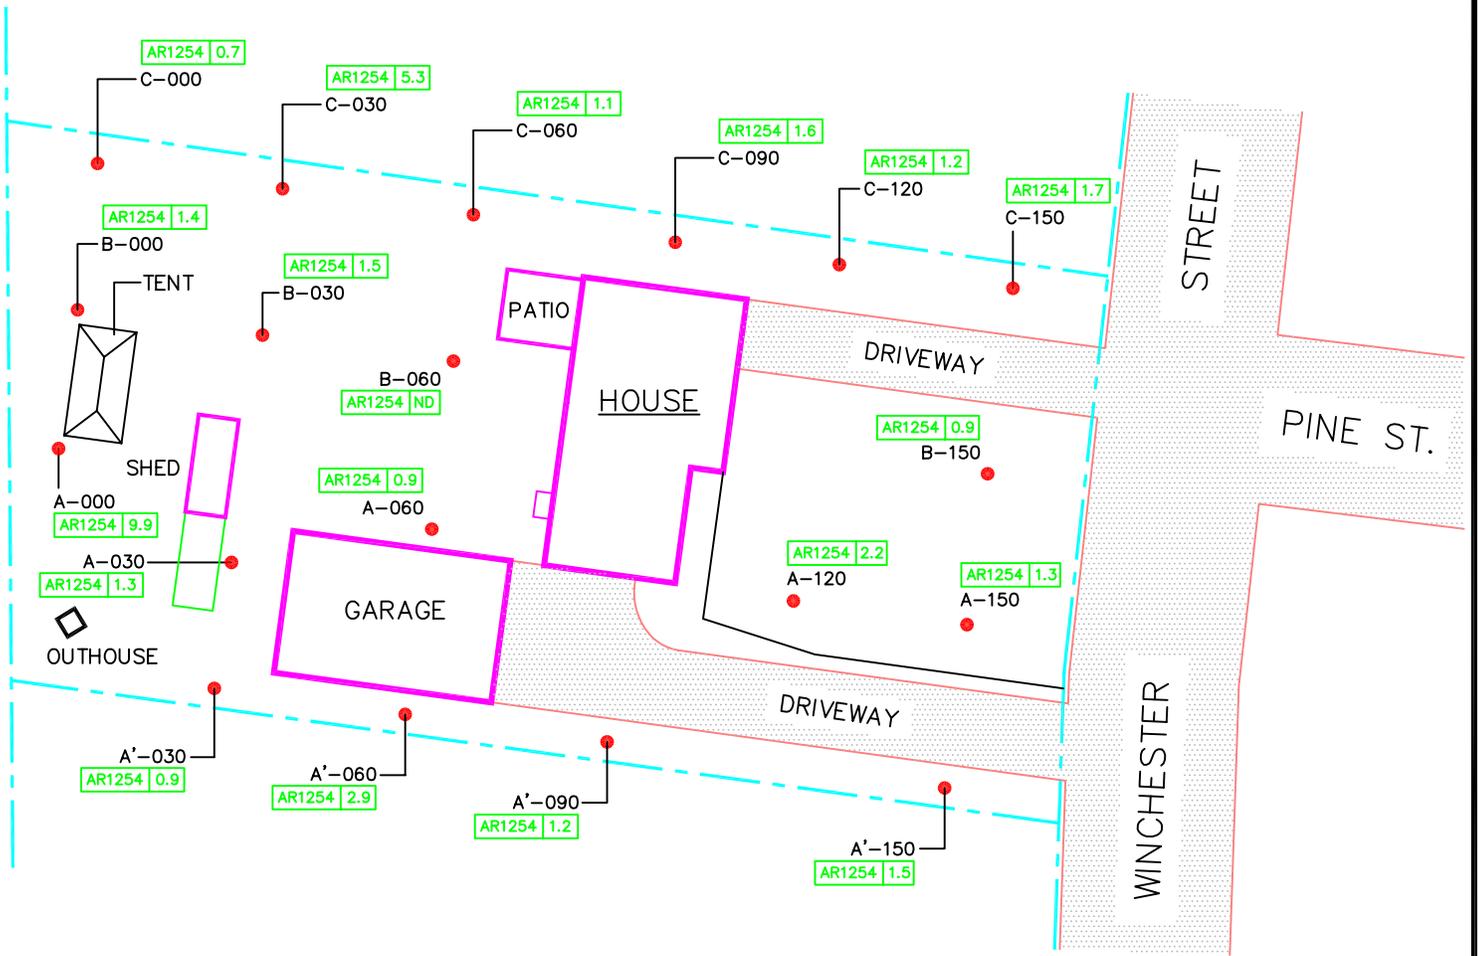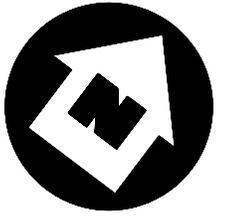

SOURCES:
 TOWN OF TEMPLETON, MASSACHUSETTS
 TAX ASSESSORS MAPS NOS. 6-4, AND 6.5
 APRIL 1964, REVISED JANUARY 2001
 NOT TO SCALE

LEGEND

- PAVED AREA
- PROPERTY LINE
- SOIL SAMPLING LOCATION
- DENOTES SOIL SAMPLING POINT IDENTIFICATION
- A-000 AROCLOR 1254 (PCB) RESULTS IN PARTS PER MILLION (PPM)

NOTES:
 ALL RESULTS ARE REPORTED IN MG/KG (PARTS PER MILLION)
 ND = NOT DETECTED
 J = RESULT IS ESTIMATED

SITE DIAGRAM

BALDWINVILLE RESIDENTIAL
 PROPERTIES
 R-019

BALDWINVILLE, MASSACHUSETTS



REGION I SUPERFUND TECHNICAL ASSESSMENT AND RESPONSE TEAM



TDD #
 05-07-0008

DRAWN BY:
 W. SHAW

DATE
 3/15/05

FILE NAME:
 R:\05070008\FIGURES\PROPERTY DIAGRAMS\R-019
 PASI.DWG

FIGURE 2

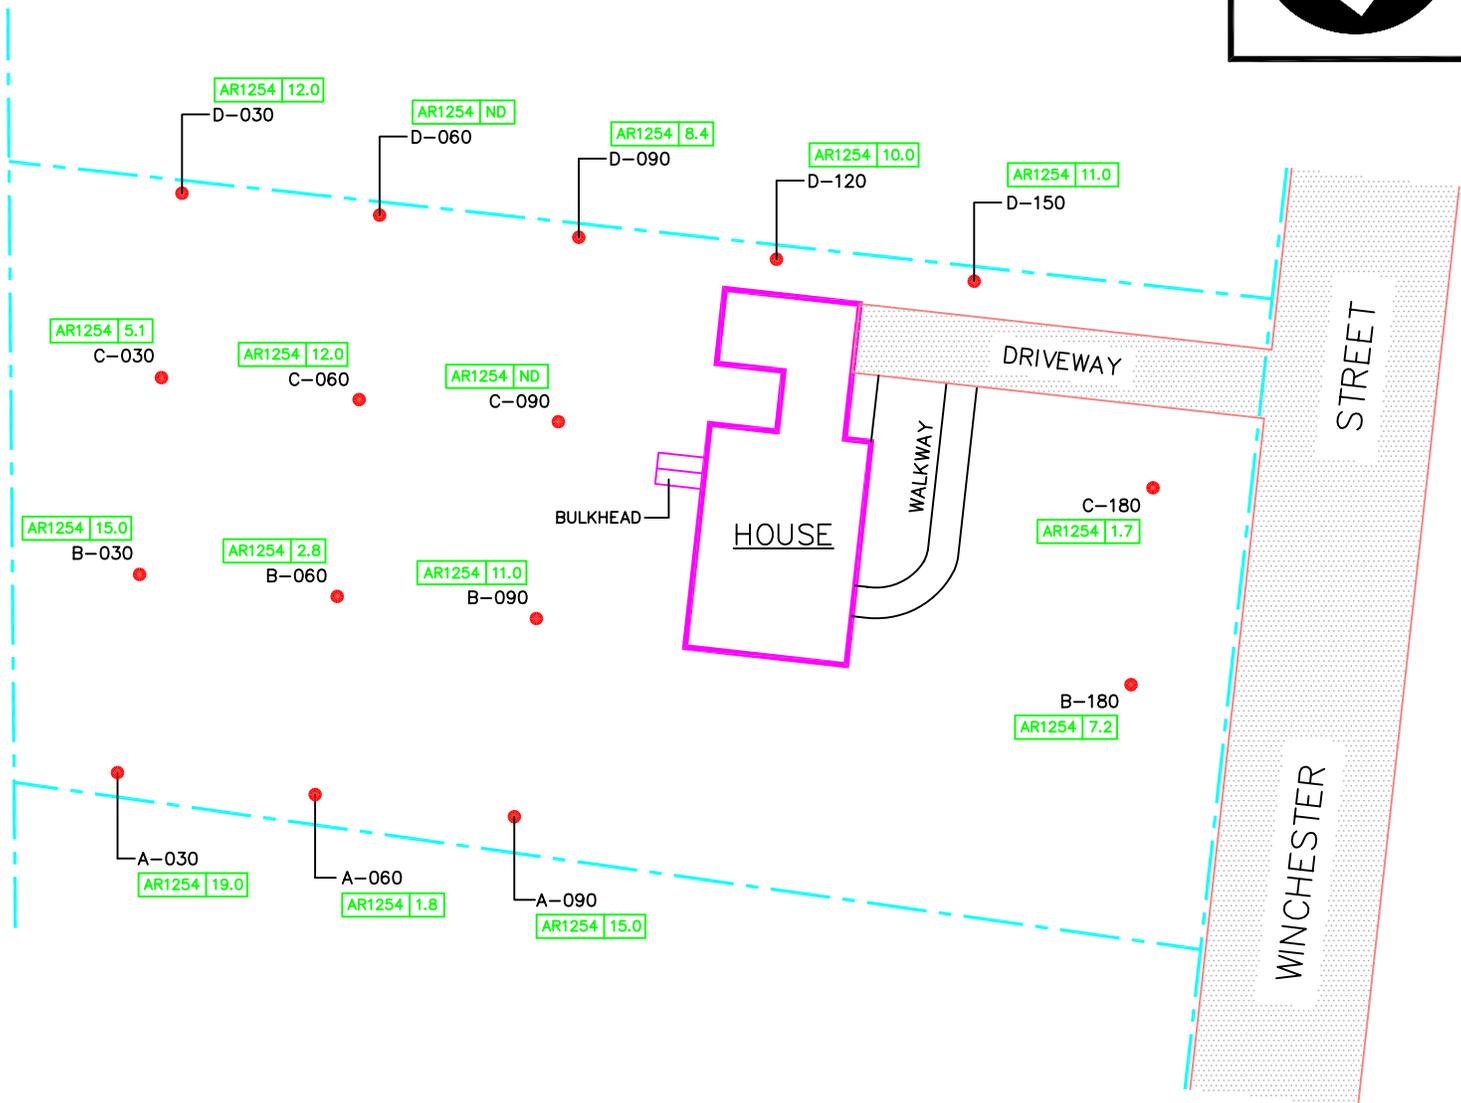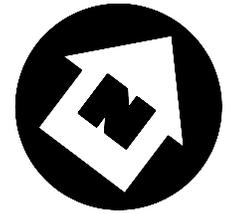

SOURCES:
 TOWN OF TEMPLETON, MASSACHUSETTS
 TAX ASSESSORS MAPS NOS. 6-4, AND 6.5
 APRIL 1964, REVISED JANUARY 2001
 NOT TO SCALE

LEGEND

- PAVED AREA
- PROPERTY LINE
- SOIL SAMPLING LOCATION
- DENOTES SOIL SAMPLING POINT IDENTIFICATION
- A-000 AROCLOR 1254 (PCB) RESULTS IN PARTS PER MILLION (PPM)
- AR1254 | 0.0

NOTES:
 ALL RESULTS ARE REPORTED IN MG/KG (PARTS PER MILLION)
 ND = NOT DETECTED
 J = RESULT IS ESTIMATED

SITE DIAGRAM

BALDWINVILLE RESIDENTIAL
 PROPERTIES
 R-020

BALDWINVILLE, MASSACHUSETTS



REGION I SUPERFUND TECHNICAL ASSESSMENT AND RESPONSE TEAM



TDD #
05-07-0008

DRAWN BY:
W. SHAW

DATE
3/15/05

FILE NAME:
R:\05070008\FIGURES\PROPERTY DIAGRAMS\R-020
PASI.DWG

FIGURE 2

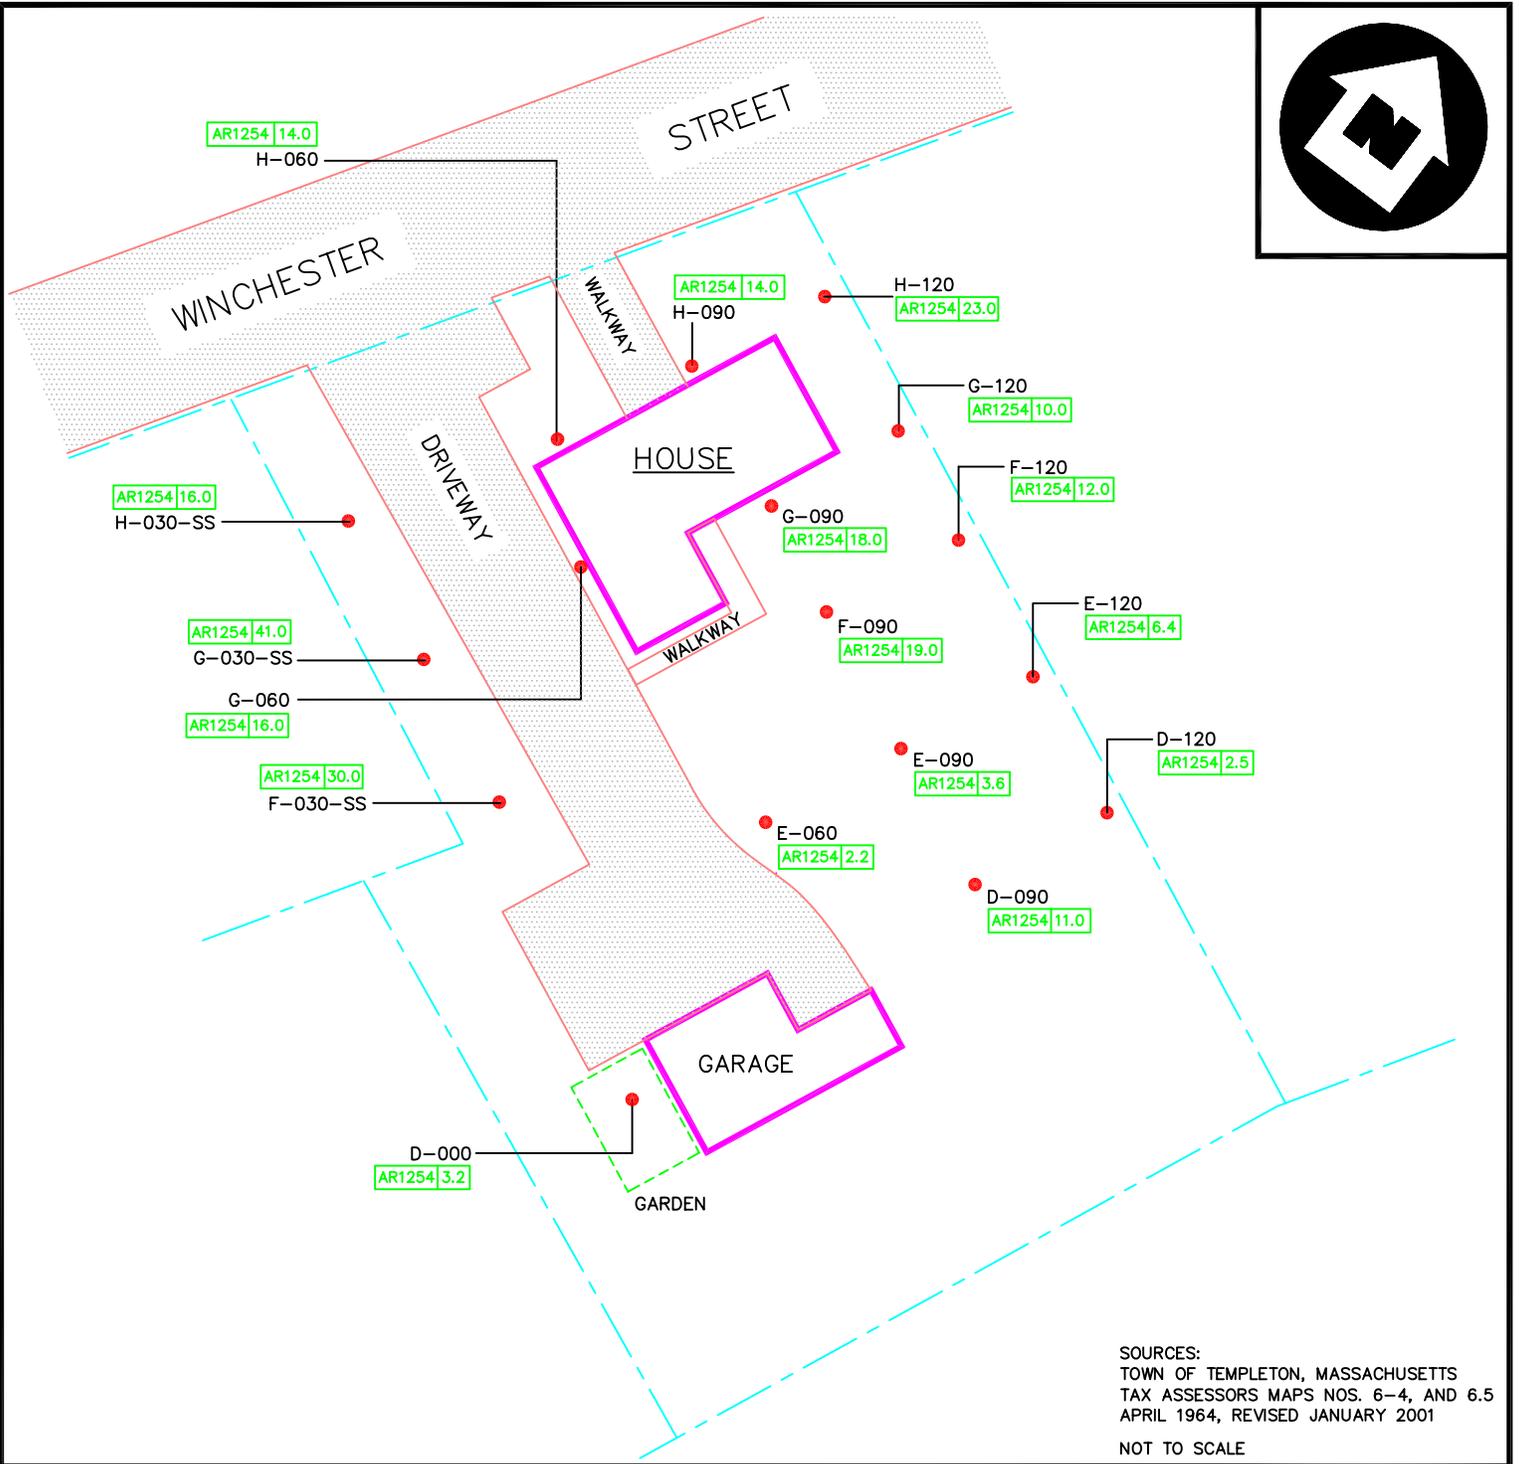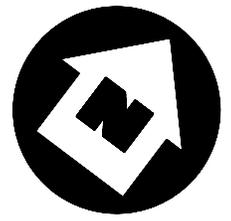

SOURCES:
 TOWN OF TEMPLETON, MASSACHUSETTS
 TAX ASSESSORS MAPS NOS. 6-4, AND 6.5
 APRIL 1964, REVISED JANUARY 2001
 NOT TO SCALE

LEGEND

PAVED AREA
 PROPERTY LINE

SOIL SAMPLING LOCATION

DENOTES SOIL SAMPLING POINT IDENTIFICATION
 A-000 AROCLOR 1254 (PCB) RESULTS IN PARTS PER MILLION (PPM)
 AR1254 | 0.0

NOTES:
 ALL RESULTS ARE REPORTED IN MG/KG (PARTS PER MILLION)
 ND = NOT DETECTED
 J = RESULT IS ESTIMATED

SITE DIAGRAM

BALDWINVILLE RESIDENTIAL
 PROPERTIES
 R-028

BALDWINVILLE, MASSACHUSETTS



REGION I SUPERFUND TECHNICAL ASSESSMENT AND RESPONSE TEAM



TDD #
05-07-0008

DRAWN BY:
W. SHAW

DATE
2/18/05

FILE NAME:
R:\05070008\FIGURES\PROPERTY DIAGRAMS\R-028
PASI.DWG

FIGURE 2

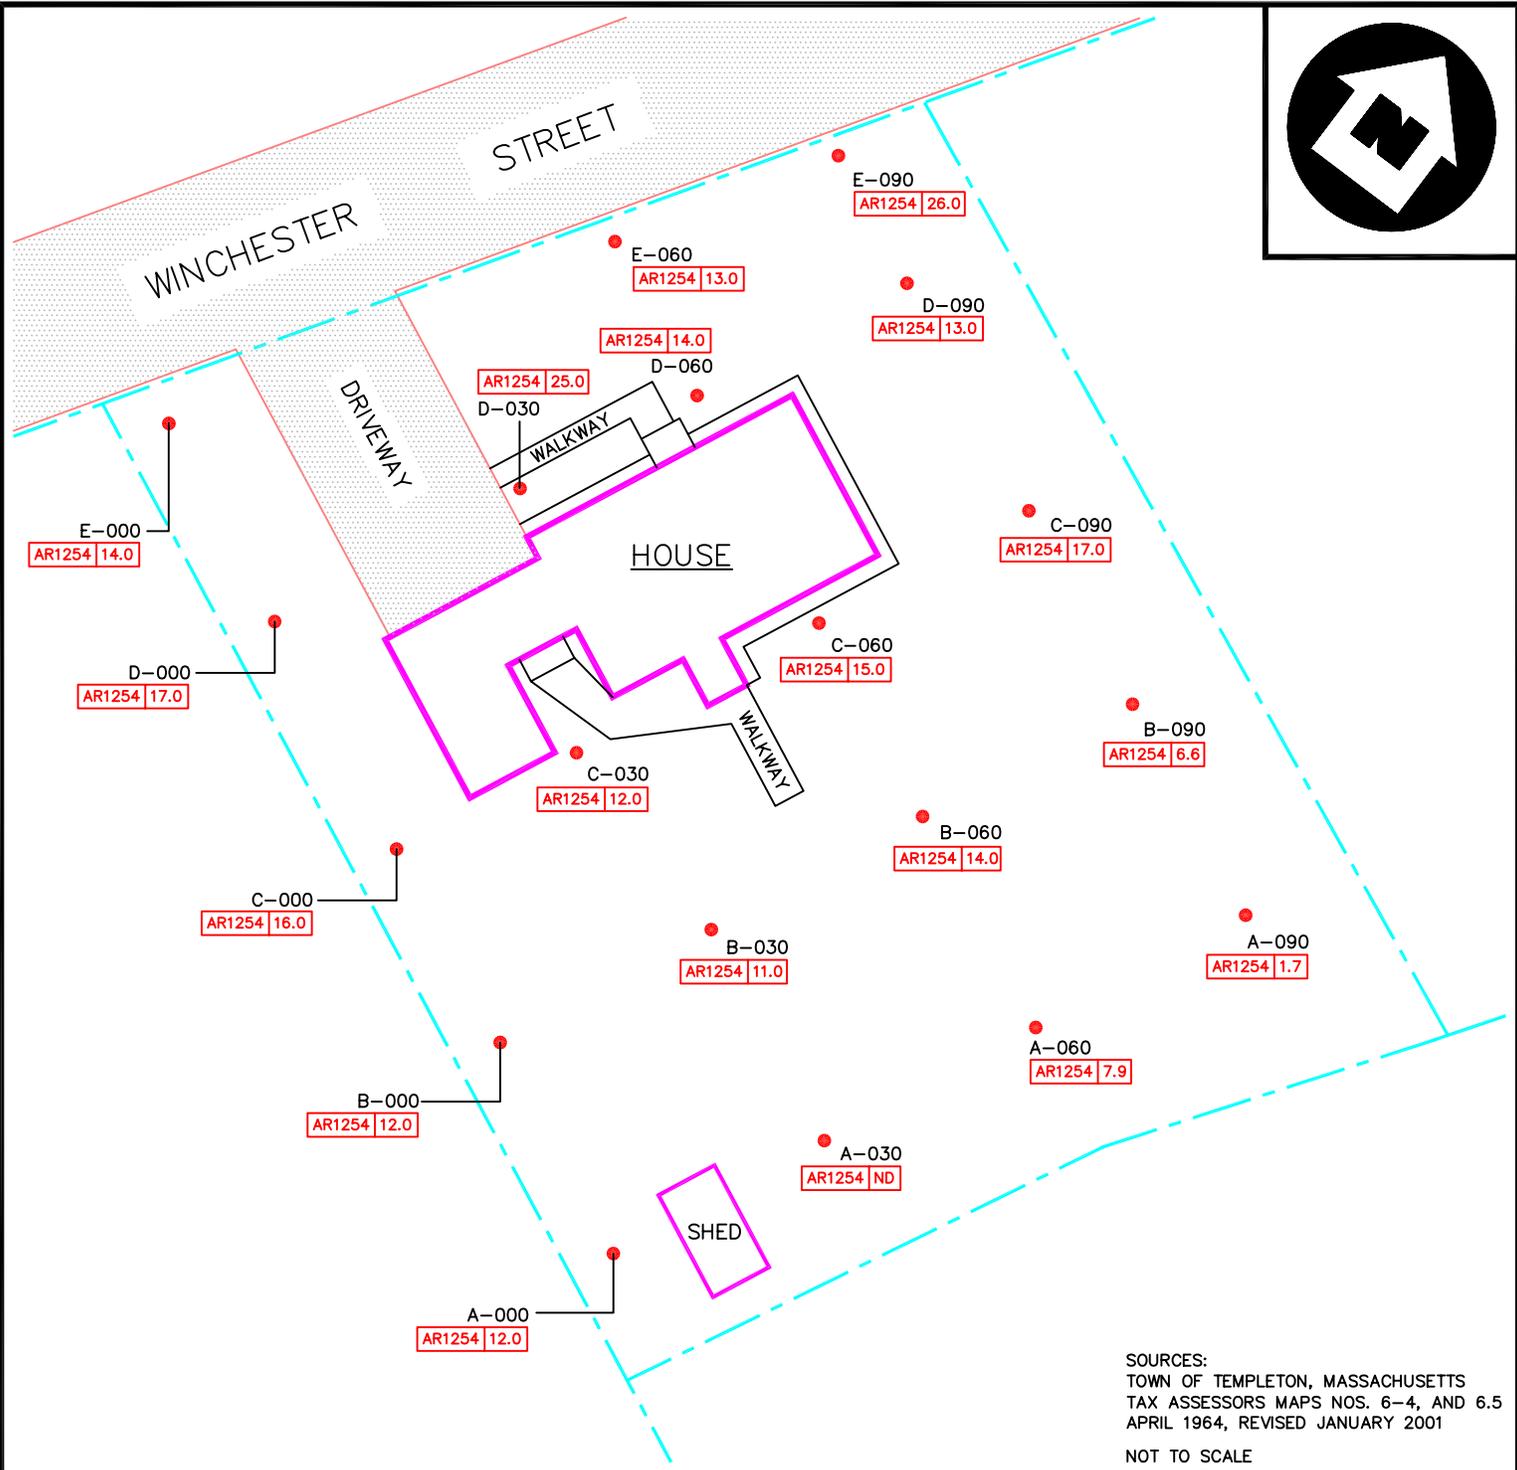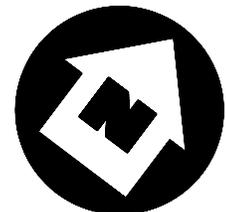

SOURCES:
 TOWN OF TEMPLETON, MASSACHUSETTS
 TAX ASSESSORS MAPS NOS. 6-4, AND 6.5
 APRIL 1964, REVISED JANUARY 2001
 NOT TO SCALE

LEGEND

PAVED AREA
 PROPERTY LINE

SOIL SAMPLING LOCATION

DENOTES SOIL SAMPLING POINT IDENTIFICATION
 A-000 AROCLOR 1254 (PCB) RESULTS IN PARTS PER MILLION (PPM)
 AR1254 0.0

NOTES:
 ALL RESULTS ARE REPORTED IN MG/KG (PARTS PER MILLION)
 ND = NOT DETECTED
 J = RESULT IS ESTIMATED

SITE DIAGRAM

BALDWINVILLE RESIDENTIAL
 PROPERTIES
 R-029

BALDWINVILLE, MASSACHUSETTS



REGION I SUPERFUND TECHNICAL ASSESSMENT AND RESPONSE TEAM



TDD #
 05-07-0008

DRAWN BY:
 W. SHAW

DATE
 12/8/04

FILE NAME:
 R:\05070008\FIGURES\PROPERTY DIAGRAMS\R-029
 PASI.DWG

FIGURE 2

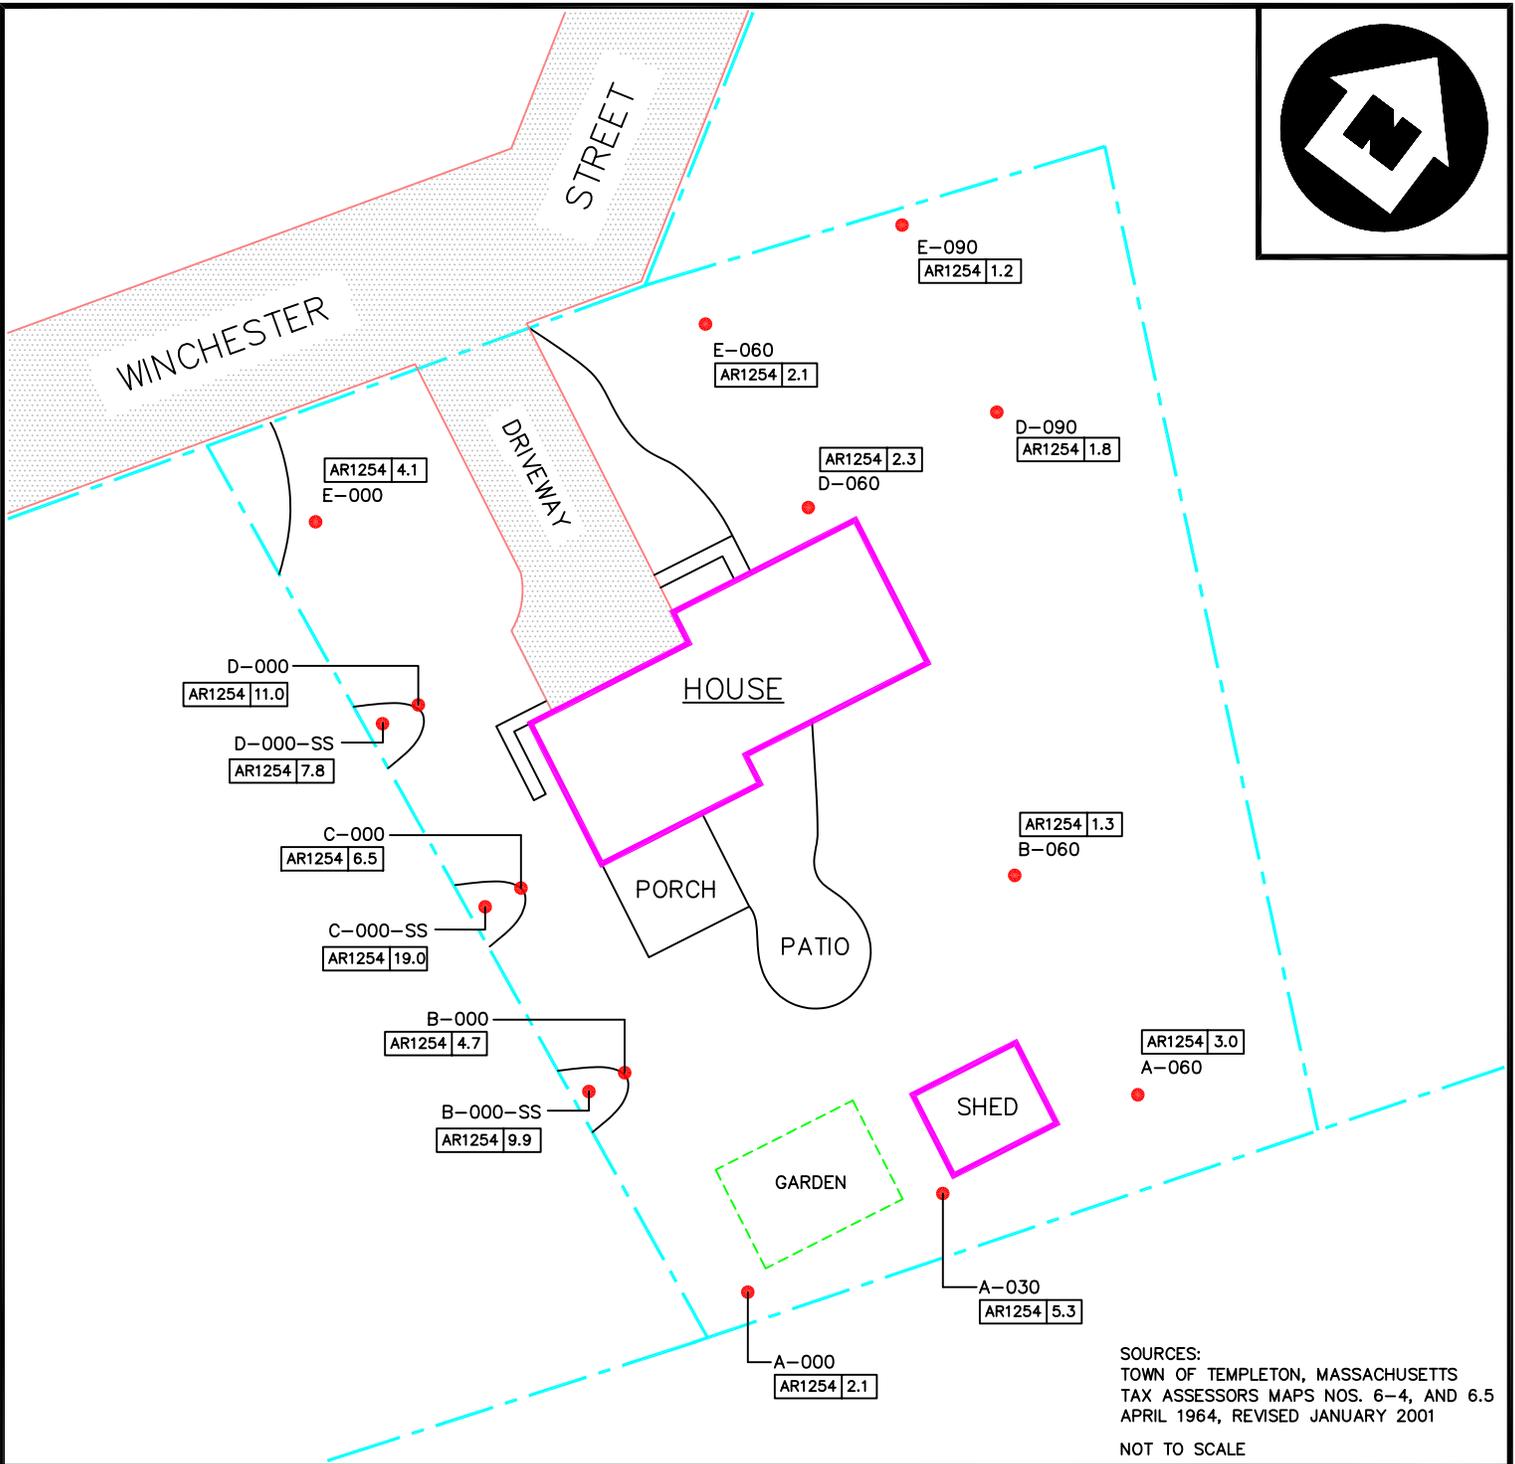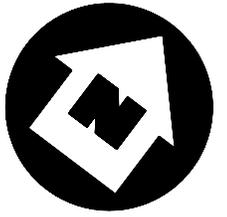

LEGEND

○ PAVED AREA
- - - PROPERTY LINE

● SOIL SAMPLING LOCATION

— DENOTES SOIL SAMPLING POINT IDENTIFICATION

A-000 AROCLOR 1254 (PCB) RESULTS IN PARTS PER MILLION (PPM)

AR1254 | 0.0

NOTES:
ALL RESULTS ARE REPORTED IN MG/KG (PARTS PER MILLION)
ND = NOT DETECTED
J = RESULT IS ESTIMATED

SITE DIAGRAM

BALDWINVILLE RESIDENTIAL PROPERTIES
R-030

BALDWINVILLE, MASSACHUSETTS



REGION I SUPERFUND TECHNICAL ASSESSMENT AND RESPONSE TEAM



TDD #
05-07-0008

DRAWN BY:
W. SHAW

DATE
2/18/05

FILE NAME:
R:\05070008\FIGURES\PROPERTY DIAGRAMS\R-030 PASI.DWG

FIGURE 2

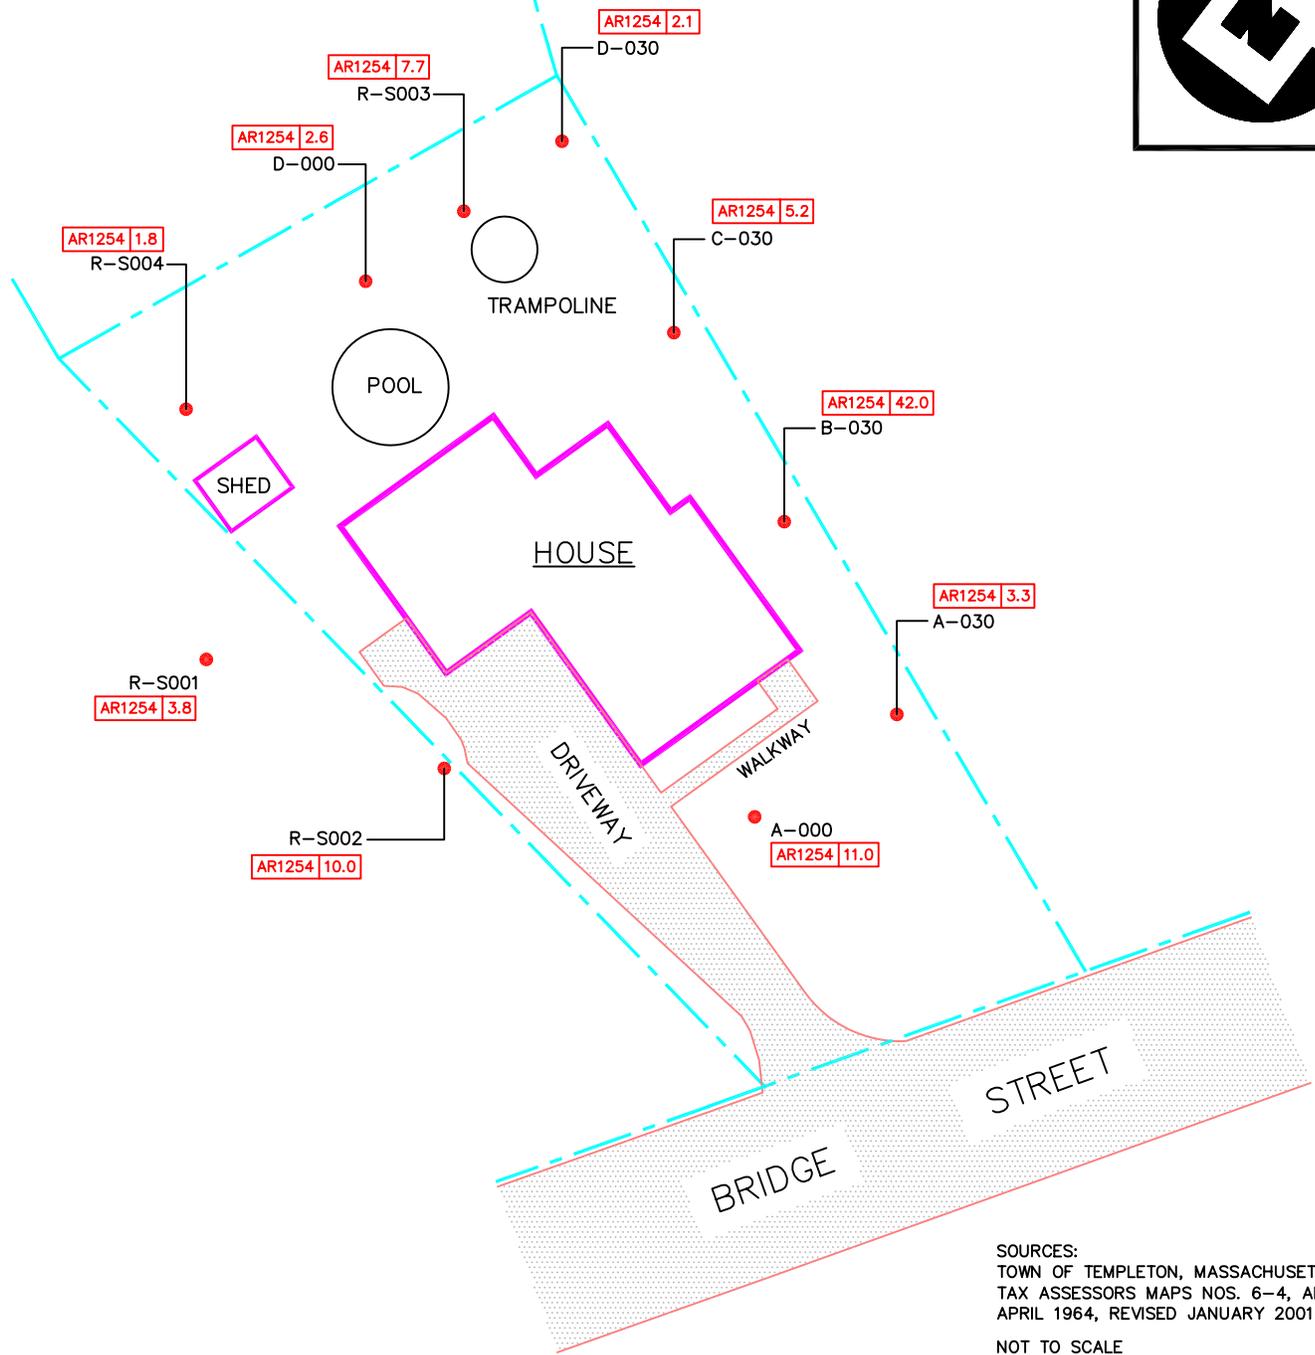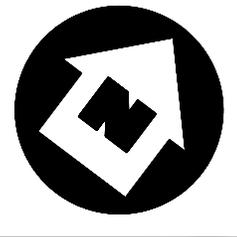

SOURCES:
TOWN OF TEMPLETON, MASSACHUSETTS
TAX ASSESSORS MAPS NOS. 6-4, AND 6.5
APRIL 1964, REVISED JANUARY 2001
NOT TO SCALE

LEGEND

PROPERTY LINE

SOIL SAMPLING LOCATION

DENOTES SOIL SAMPLING POINT IDENTIFICATION

A-000 AROCLOR 1254 (PCB) RESULTS IN PARTS PER MILLION (PPM)

AR1254 | 0.0

NOTES:
ALL RESULTS ARE REPORTED IN MG/KG (PARTS PER MILLION)
ND = NOT DETECTED
J = RESULT IS ESTIMATED

SITE DIAGRAM

BALDWINVILLE RESIDENTIAL
PROPERTIES
R-032

BALDWINVILLE, MASSACHUSETTS



REGION I SUPERFUND TECHNICAL ASSESSMENT AND RESPONSE TEAM



TDD #
05-07-0008

DRAWN BY:
W. SHAW

DATE
12/8/04

FILE NAME:
R:\05070008\FIGURES\PROPERTY DIAGRAMS\R-032
PASI.DWG

FIGURE 2

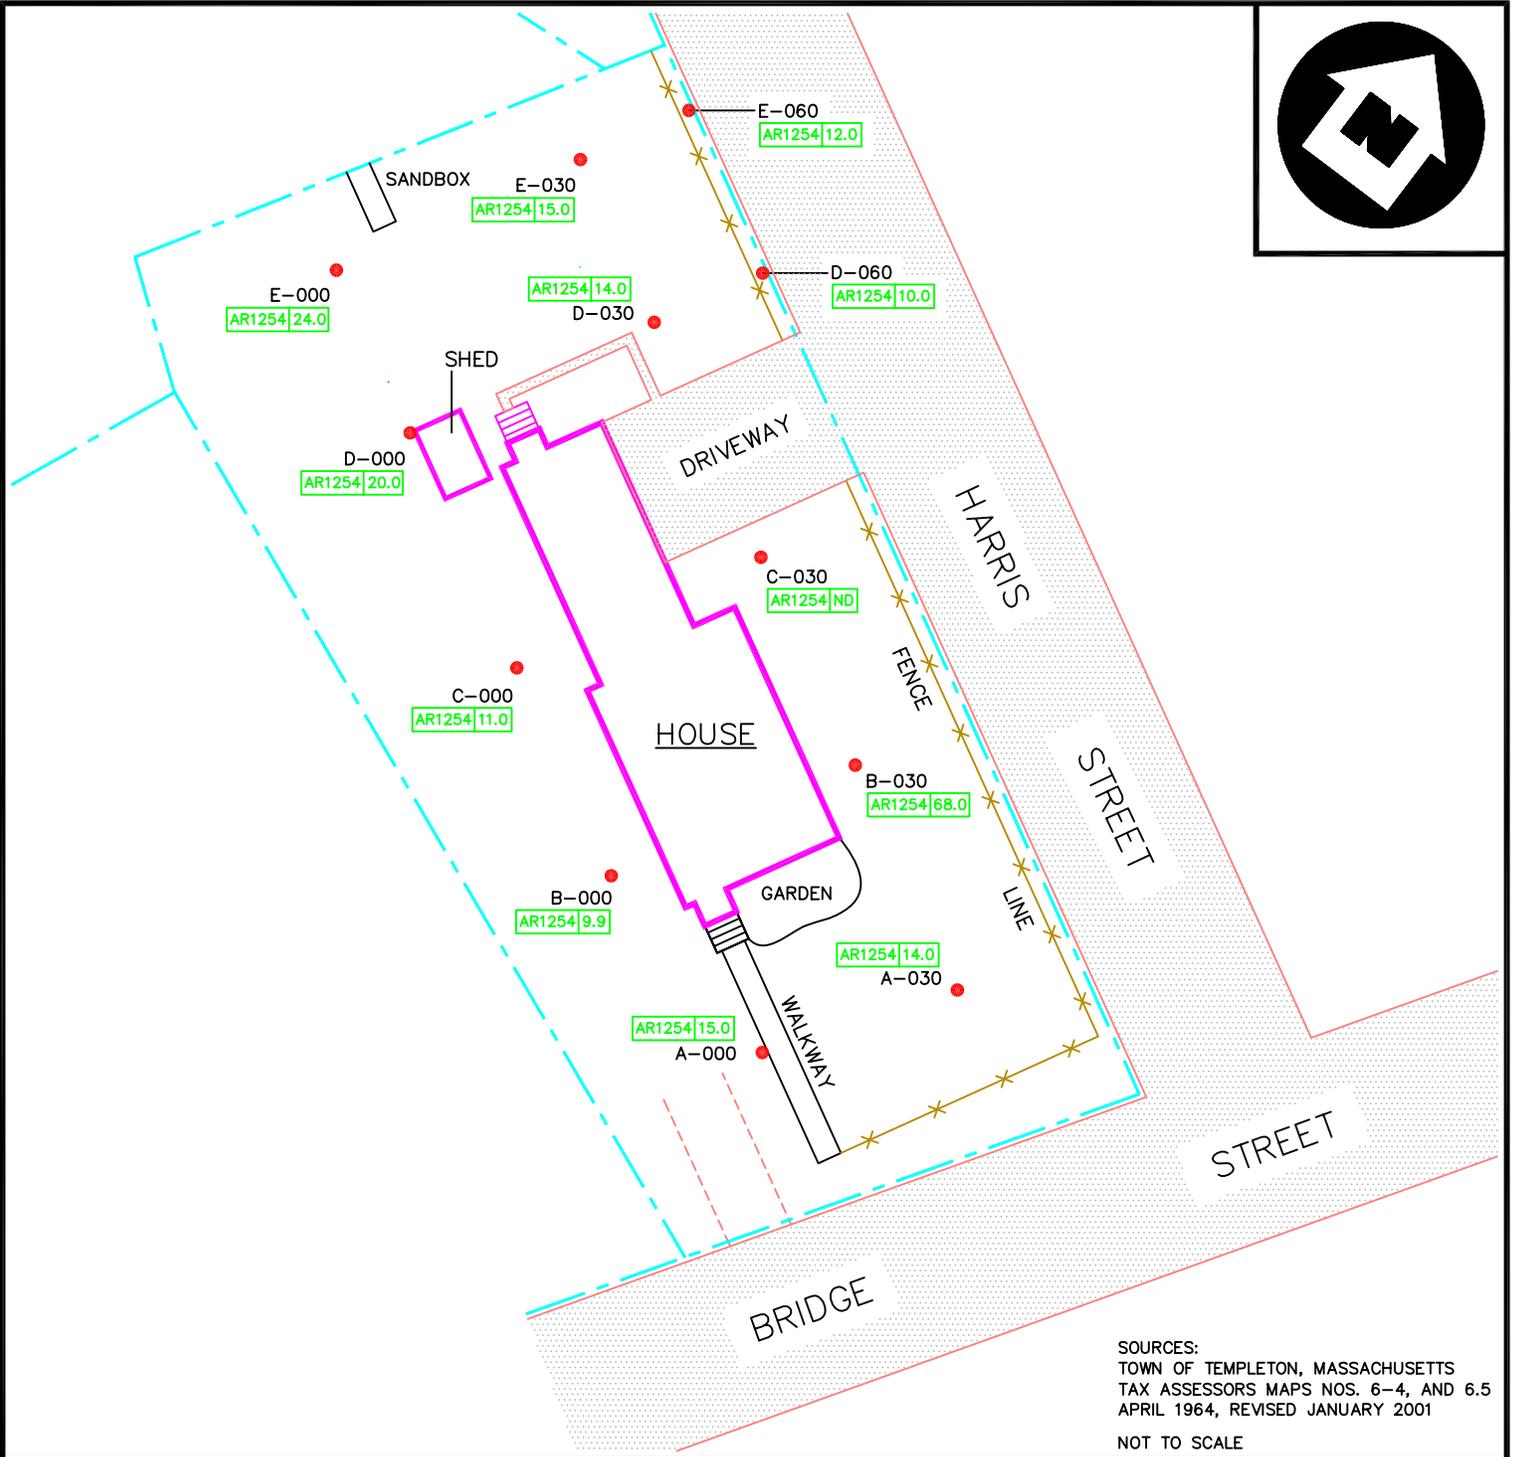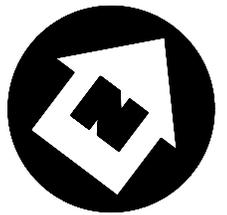

SOURCES:
 TOWN OF TEMPLETON, MASSACHUSETTS
 TAX ASSESSORS MAPS NOS. 6-4, AND 6.5
 APRIL 1964, REVISED JANUARY 2001
 NOT TO SCALE

LEGEND

- PAVED AREA
- PROPERTY LINE
- SOIL SAMPLING LOCATION
- DENOTES SOIL SAMPLING POINT IDENTIFICATION
- A-000 AROCLOR 1254 (PCB) RESULTS IN PARTS PER MILLION (PPM)
- AR1254 | 0.0

NOTES:
 ALL RESULTS ARE REPORTED IN MG/KG (PARTS PER MILLION)
 ND = NOT DETECTED
 J = RESULT IS ESTIMATED

SITE DIAGRAM



BALDWINVILLE RESIDENTIAL
 PROPERTIES
 R-033

BALDWINVILLE, MASSACHUSETTS



REGION I SUPERFUND TECHNICAL ASSESSMENT AND RESPONSE TEAM

TDD # 05-07-0008	DRAWN BY: W. SHAW	DATE 12/8/04
FILE NAME: R:\05070008\FIGURES\PROPERTY DIAGRAMS\R-033 PASI.DWG		FIGURE 2

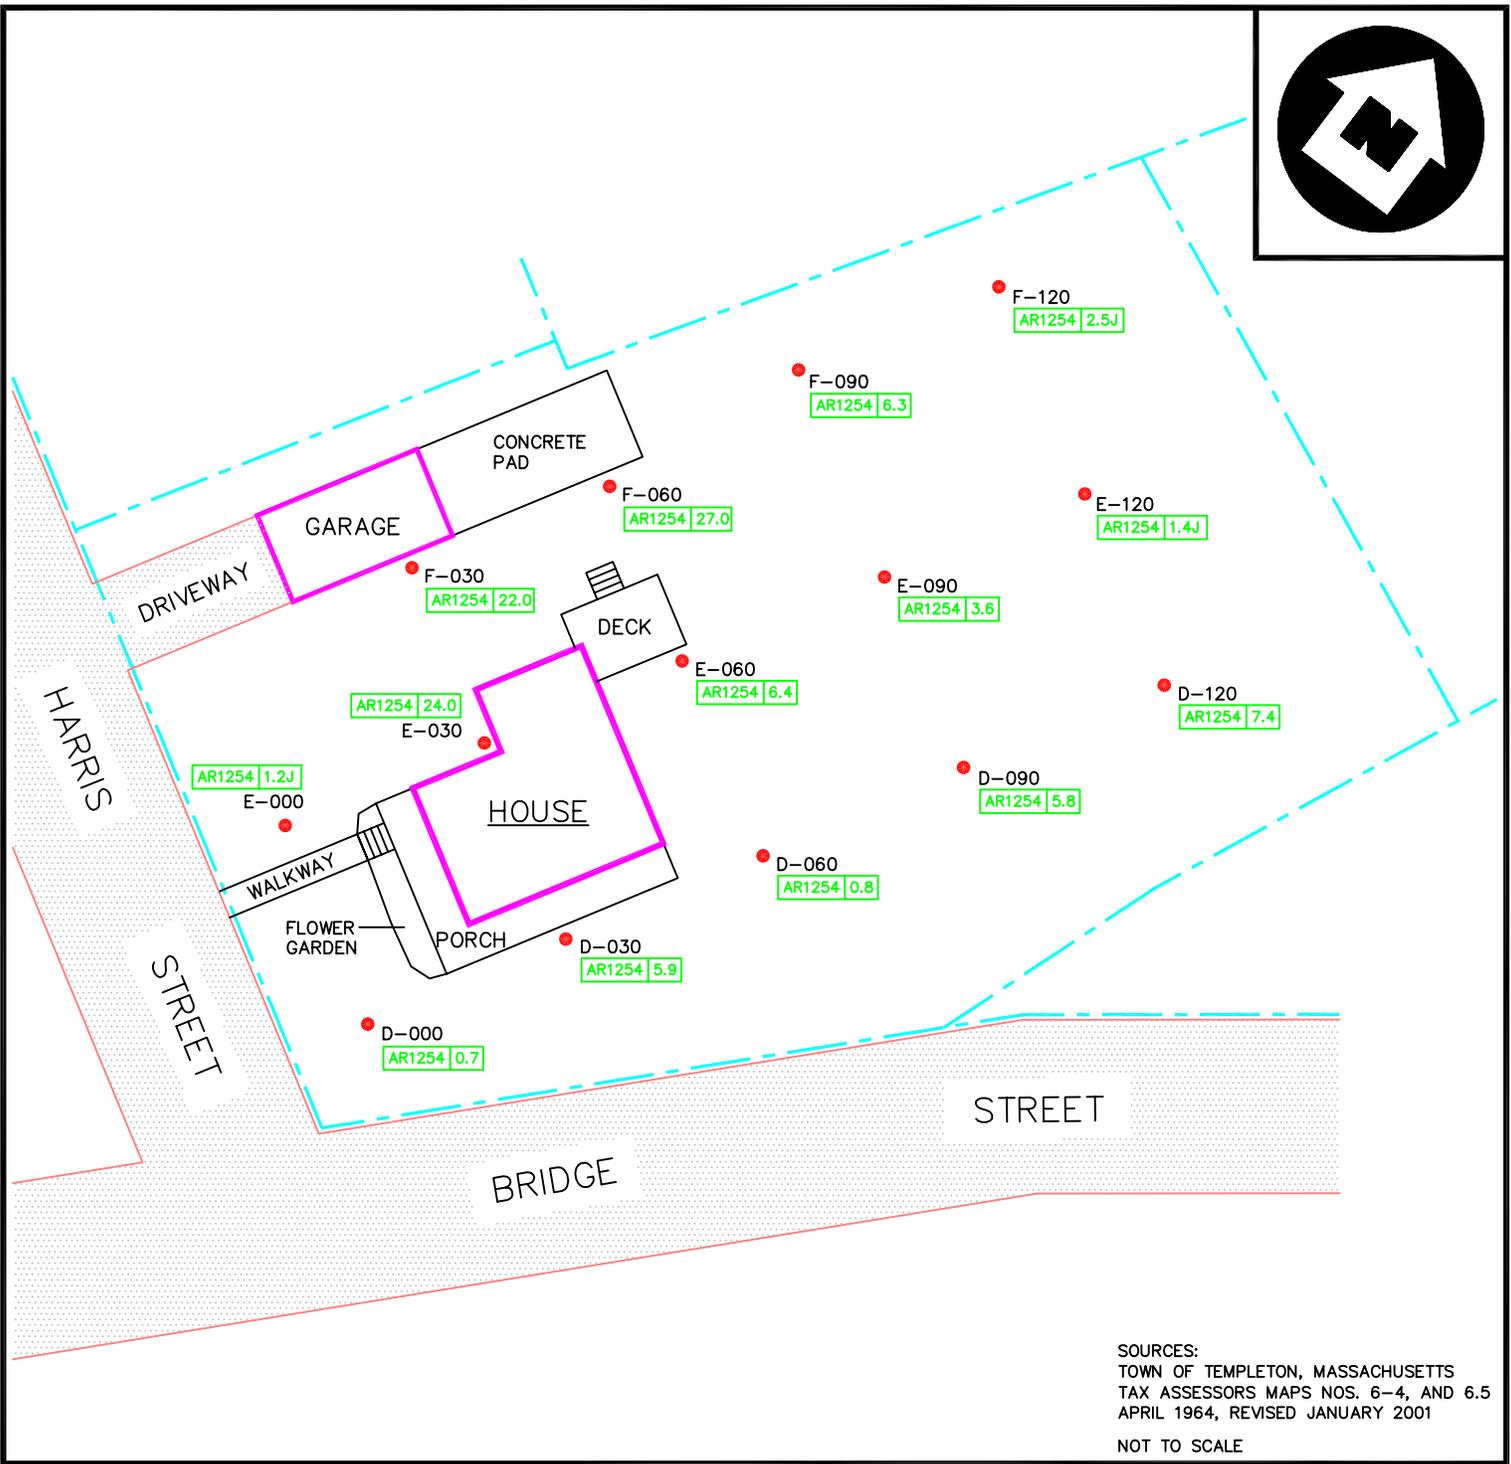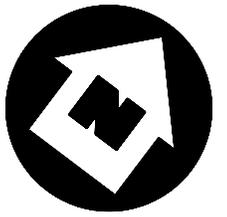

SOURCES:
 TOWN OF TEMPLETON, MASSACHUSETTS
 TAX ASSESSORS MAPS NOS. 6-4, AND 6.5
 APRIL 1964, REVISED JANUARY 2001
 NOT TO SCALE

LEGEND

- PAVED AREA
- PROPERTY LINE
- SOIL SAMPLING LOCATION
- DENOTES SOIL SAMPLING POINT IDENTIFICATION
- A-000 AROCLOR 1254 (PCB) RESULTS IN PARTS PER MILLION (PPM)
- AR1254 | 0.0

NOTES:
 ALL RESULTS ARE REPORTED IN MG/KG (PARTS PER MILLION)
 ND = NOT DETECTED
 J = RESULT IS ESTIMATED

SITE DIAGRAM



BALDWINVILLE RESIDENTIAL
 PROPERTIES
 R-034
 BALDWINVILLE, MASSACHUSETTS



REGION I SUPERFUND TECHNICAL ASSESSMENT AND RESPONSE TEAM

TDD # 05-07-0008	DRAWN BY: W. SHAW	DATE 12/8/04
---------------------	----------------------	-----------------

FILE NAME: R:\05070008\FIGURES\PROPERTY DIAGRAMS\R-034 PASI.DWG	FIGURE 2
---	----------

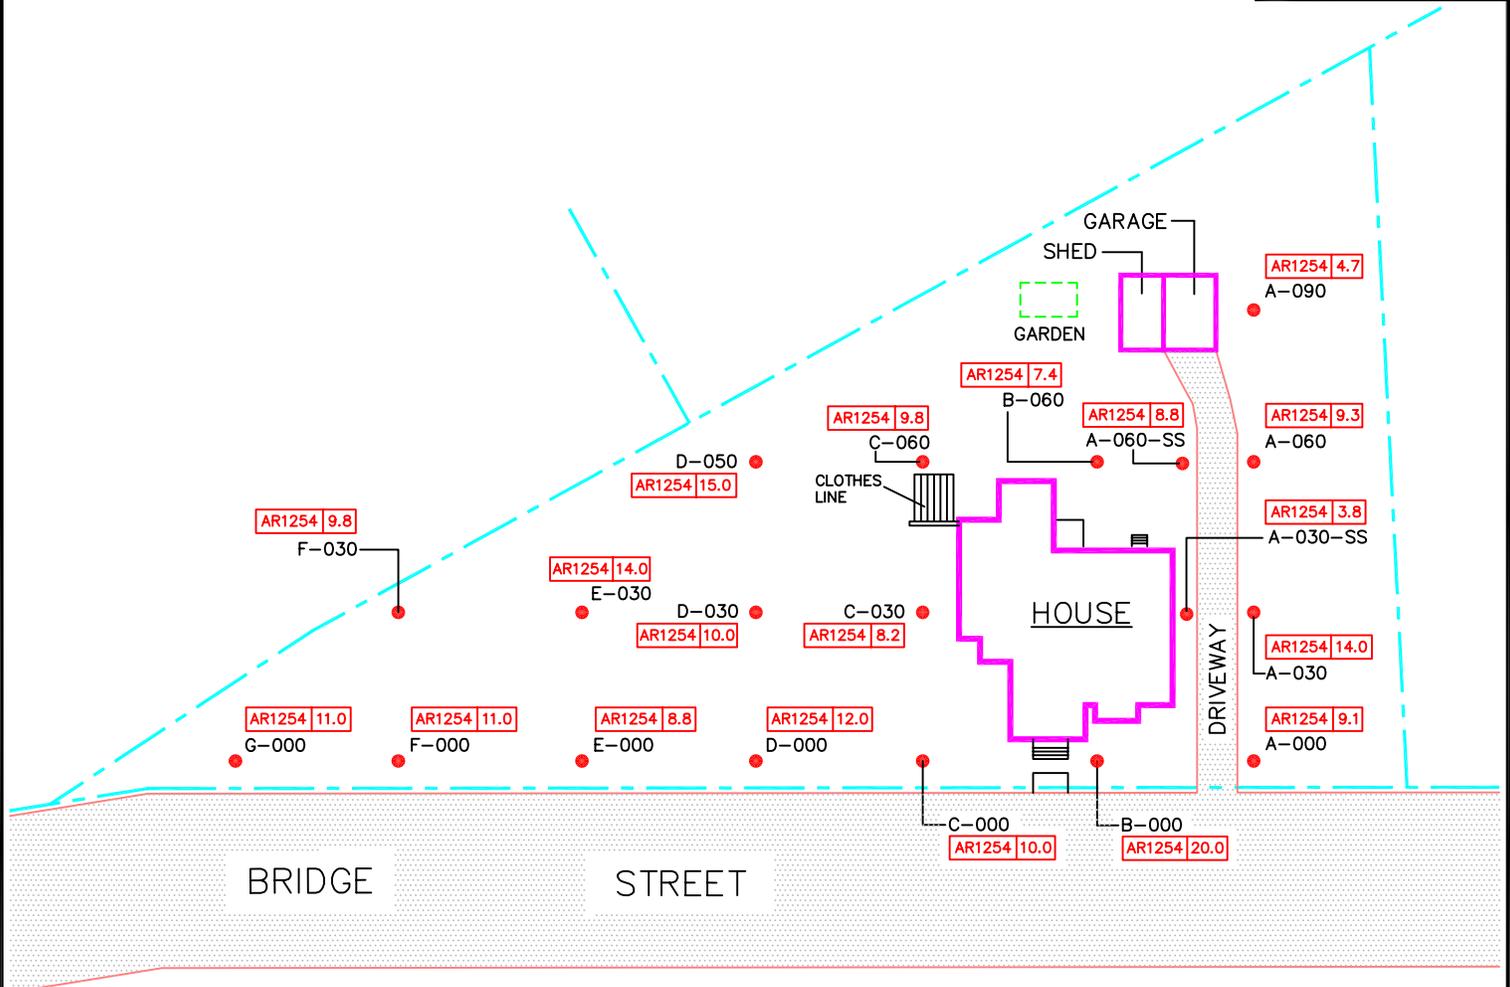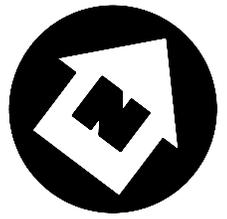

SOURCES:
 TOWN OF TEMPLETON, MASSACHUSETTS
 TAX ASSESSORS MAPS NOS. 6-4, AND 6.5
 APRIL 1964, REVISED JANUARY 2001
 NOT TO SCALE

LEGEND

- PAVED AREA
 - PROPERTY LINE
 - SOIL SAMPLING LOCATION
 - DENOTES SOIL SAMPLING POINT IDENTIFICATION
- A-000 AROCLOR 1254 (PCB) RESULTS IN PARTS PER MILLION (PPM)
 AR1254 | 0.0

NOTES:
 ALL RESULTS ARE REPORTED IN MG/KG (PARTS PER MILLION)
 ND = NOT DETECTED
 J = RESULT IS ESTIMATED

SITE DIAGRAM



BALDWINVILLE RESIDENTIAL
 PROPERTIES
 R-035

BALDWINVILLE, MASSACHUSETTS



REGION I SUPERFUND TECHNICAL ASSESSMENT AND RESPONSE TEAM

TDD # 05-07-0008	DRAWN BY: W. SHAW	DATE 12/8/04
FILE NAME: R:\05070008\FIGURES\PROPERTY DIAGRAMS\R-035 PASI.DWG		FIGURE 2

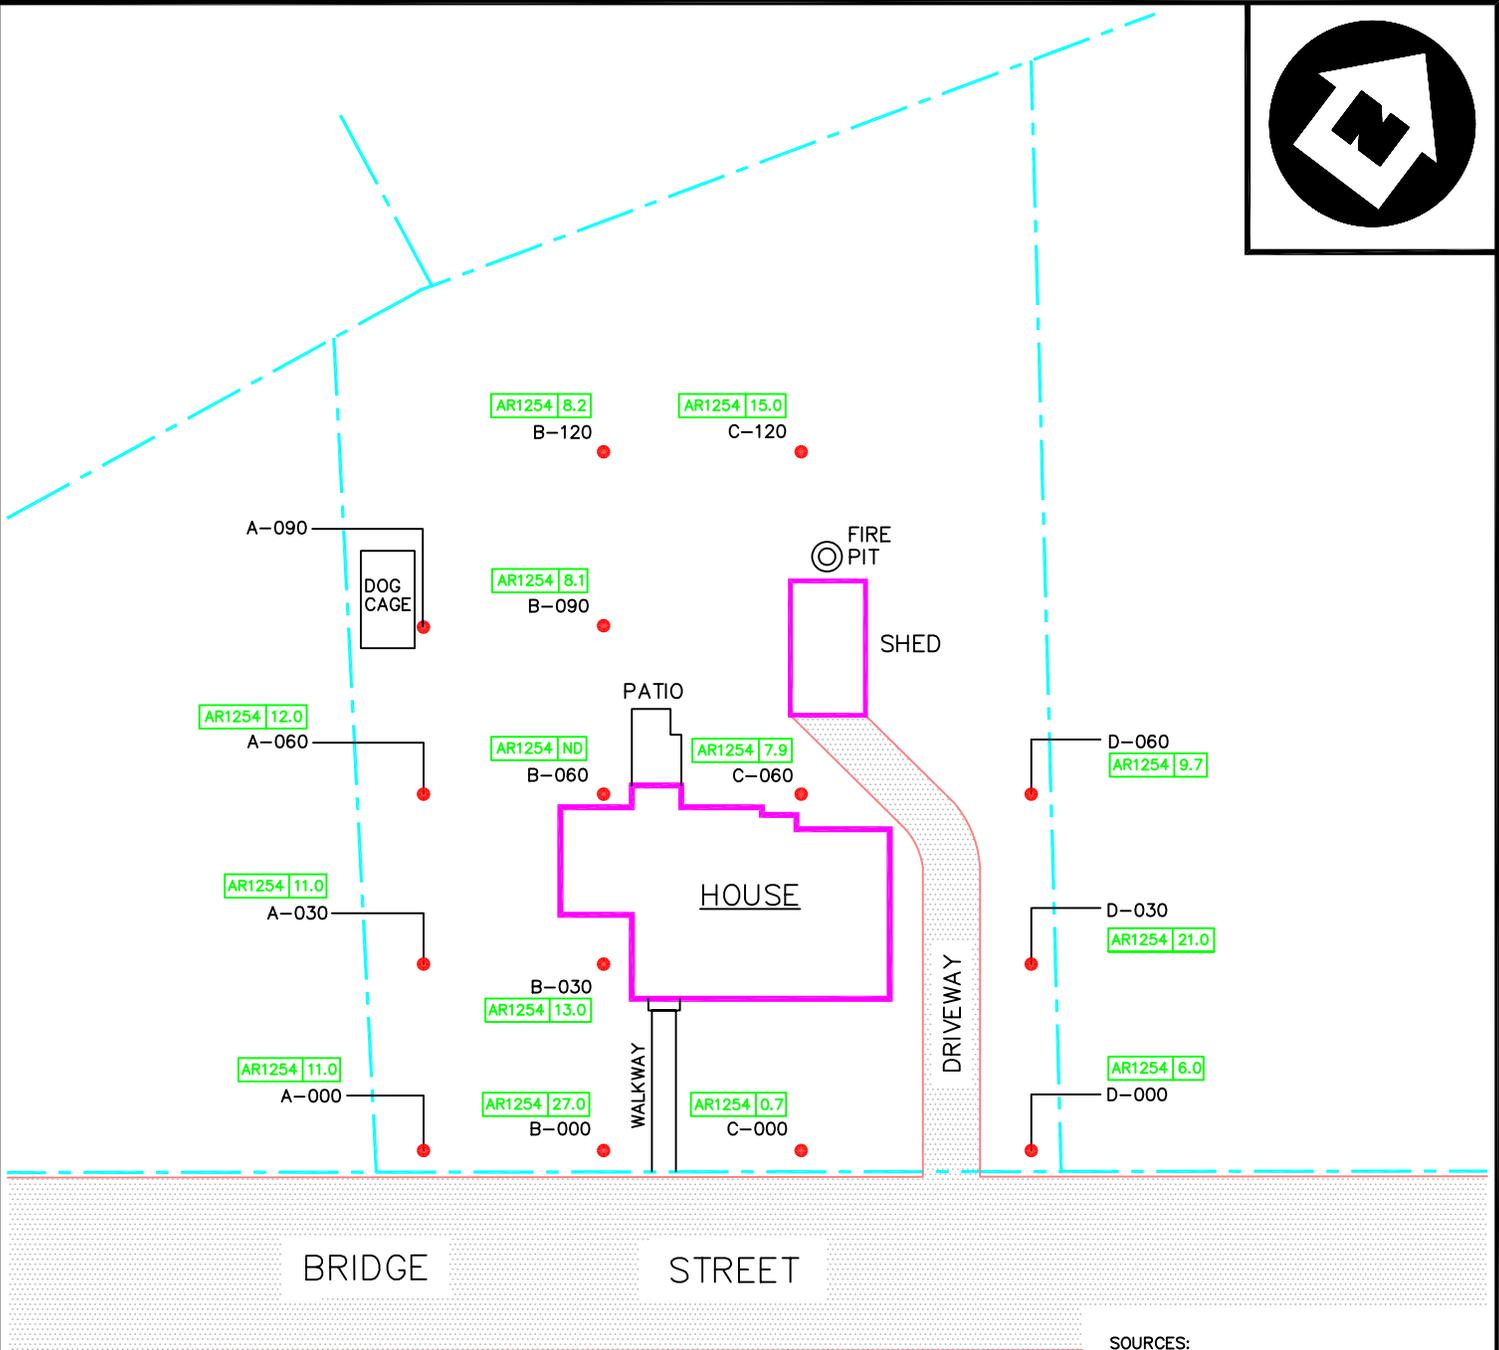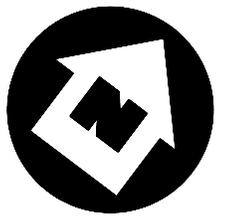

SOURCES:
TOWN OF TEMPLETON, MASSACHUSETTS
TAX ASSESSORS MAPS NOS. 6-4, AND 6.5
APRIL 1964, REVISED JANUARY 2001
NOT TO SCALE

LEGEND

- PAVED AREA
 - PROPERTY LINE
 - SOIL SAMPLING LOCATION
 - DENOTES SOIL SAMPLING POINT IDENTIFICATION
- A-000 AROCLOR 1254 (PCB) RESULTS IN PARTS PER MILLION (PPM)
AR1254 | 0.0

NOTES:
ALL RESULTS ARE REPORTED IN MG/KG (PARTS PER MILLION)
ND = NOT DETECTED
J = RESULT IS ESTIMATED

SITE DIAGRAM

BALDWINVILLE RESIDENTIAL
PROPERTIES
R-036

BALDWINVILLE, MASSACHUSETTS



REGION I SUPERFUND TECHNICAL ASSESSMENT AND RESPONSE TEAM



TDD #
05-07-0008

DRAWN BY:
W. SHAW

DATE
12/8/04

FILE NAME:
R:\05070008\FIGURES\PROPERTY DIAGRAMS\R-036
PASI.DWG

FIGURE 2

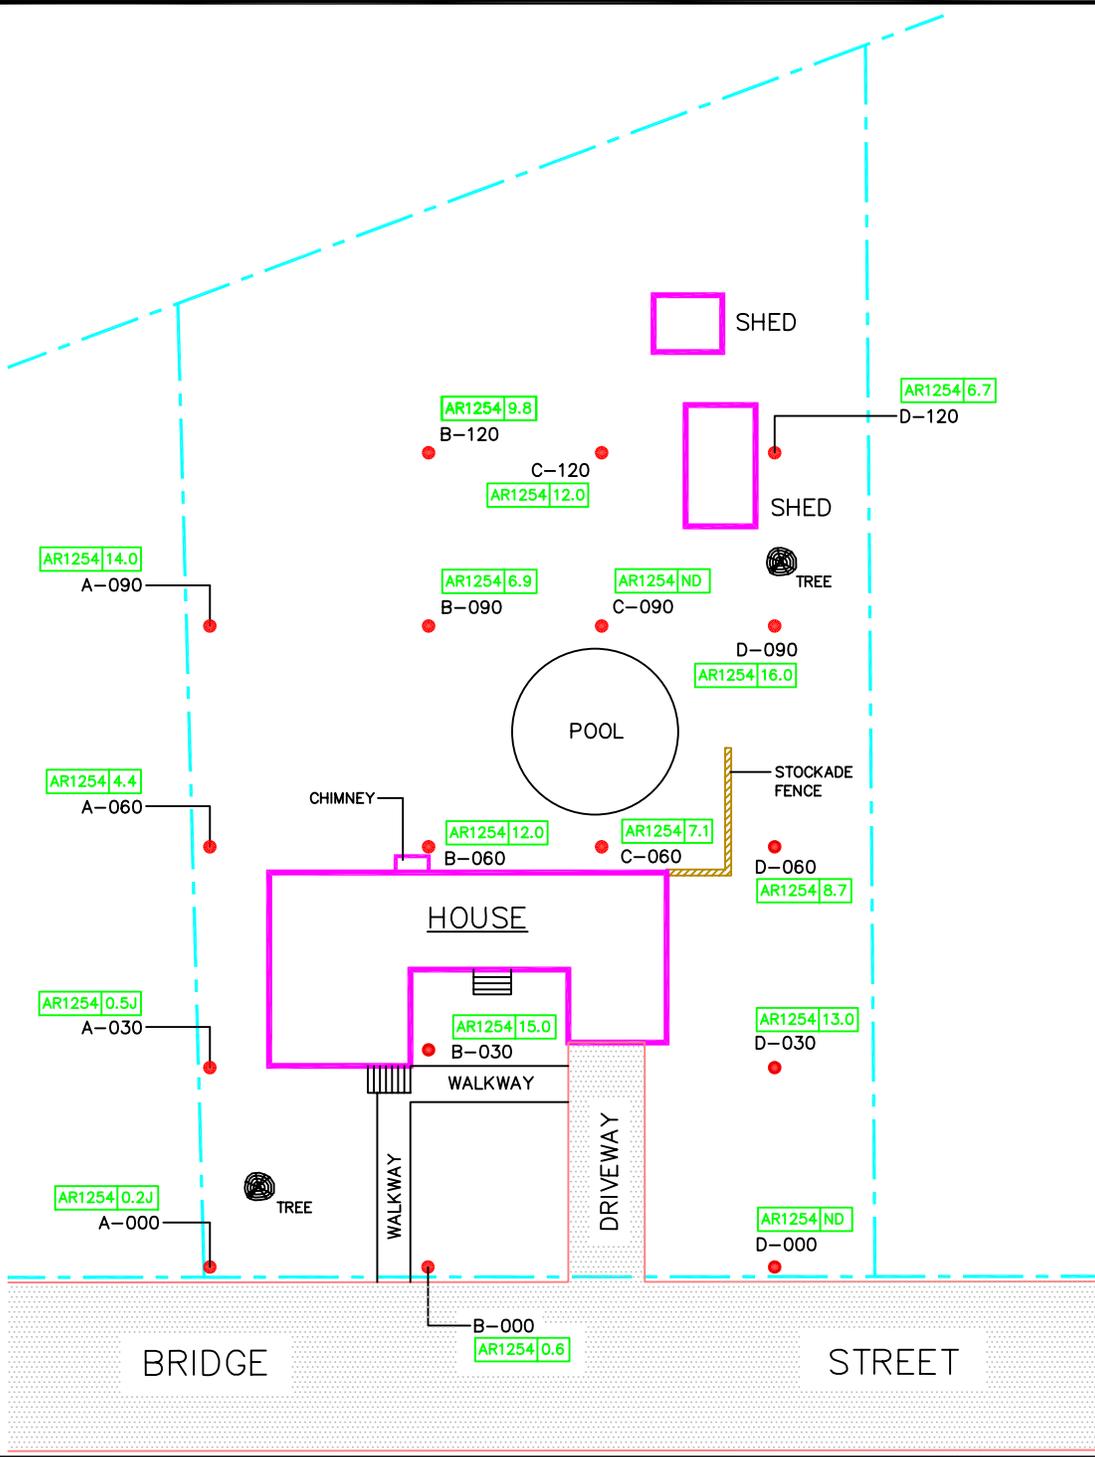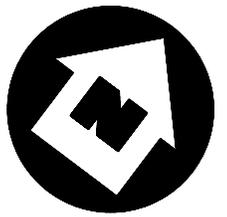

SOURCES:
TOWN OF TEMPLETON, MASSACHUSETTS
TAX ASSESSORS MAPS NOS. 6-4, AND 6.5
APRIL 1964, REVISED JANUARY 2001
NOT TO SCALE

LEGEND

- PAVED AREA
- SOIL SAMPLING LOCATION
- PROPERTY LINE
- DENOTES SOIL SAMPLING POINT IDENTIFICATION
- AROCLOR 1254 (PCB) RESULTS IN PARTS PER MILLION (PPM)

NOTES:
ALL RESULTS ARE REPORTED IN MG/KG (PARTS PER MILLION)
ND = NOT DETECTED
J = RESULT IS ESTIMATED

SITE DIAGRAM



BALDWINVILLE RESIDENTIAL
PROPERTIES
R-037

BALDWINVILLE, MASSACHUSETTS



REGION I SUPERFUND TECHNICAL ASSESSMENT AND RESPONSE TEAM

TDD # 05-07-0008	DRAWN BY: W. SHAW	DATE 12/8/04
FILE NAME: R:\05070008\FIGURES\PROPERTY DIAGRAMS\R-037 PASI.DWG		FIGURE 2

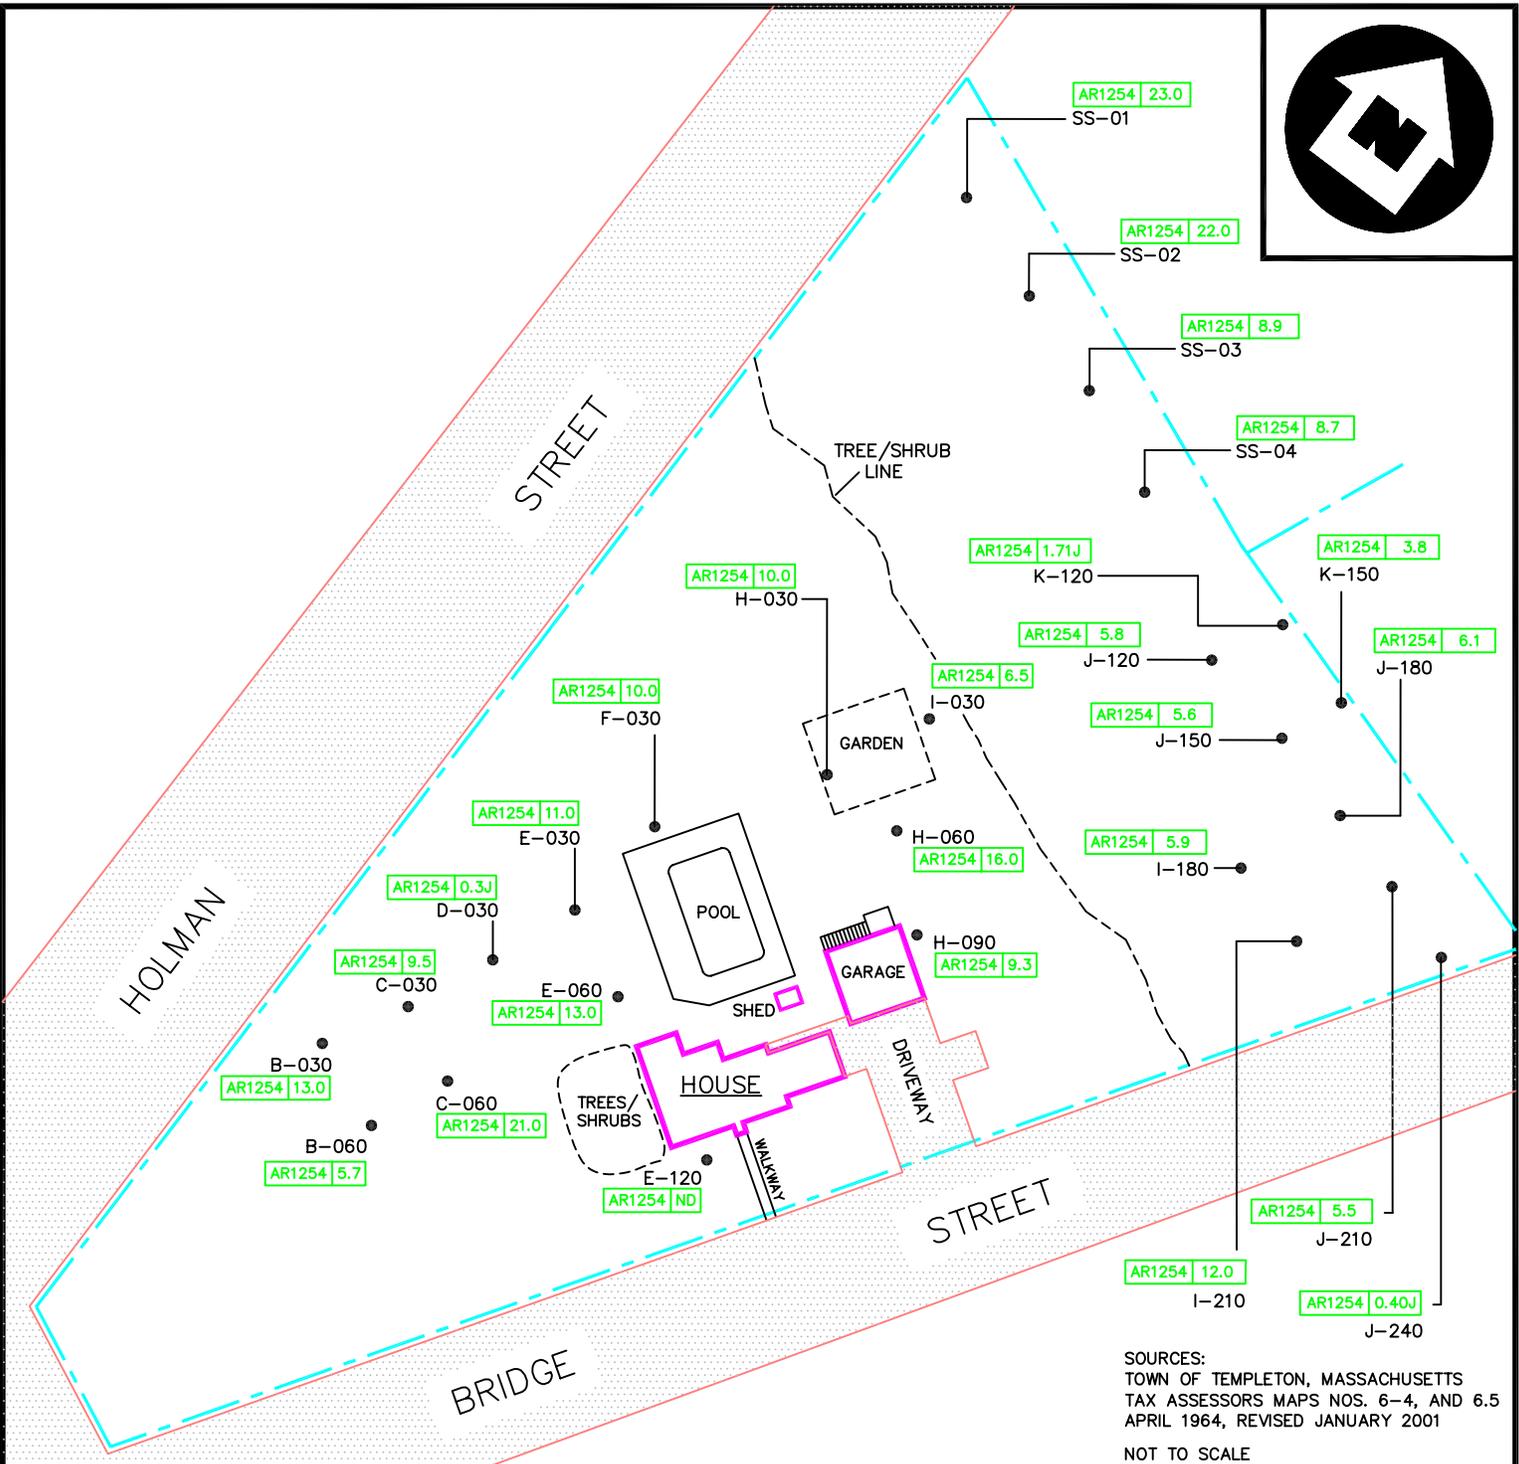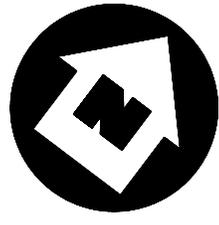

SOURCES:
 TOWN OF TEMPLETON, MASSACHUSETTS
 TAX ASSESSORS MAPS NOS. 6-4, AND 6.5
 APRIL 1964, REVISED JANUARY 2001
 NOT TO SCALE

LEGEND

- PAVED AREA
- SOIL SAMPLING LOCATION
- PROPERTY LINE
- DENOTES SOIL SAMPLING POINT IDENTIFICATION
- | | |
|--------------|---|
| A-000 | AROCLOR 1254 (PCB) RESULTS IN PARTS PER MILLION (PPM) |
| AR1254 0.0 | |

NOTES:
 ALL RESULTS ARE REPORTED IN MG/KG (PARTS PER MILLION)
 ND = NOT DETECTED
 J = RESULT IS ESTIMATED

SITE DIAGRAM



BALDWINVILLE RESIDENTIAL
 PROPERTIES
 R-039

BALDWINVILLE, MASSACHUSETTS



REGION I SUPERFUND TECHNICAL ASSESSMENT AND RESPONSE TEAM

TDD # 05-07-0008	DRAWN BY: W. SHAW	DATE 12/8/04
FILE NAME: R:\05070008\FIGURES\PROPERTY DIAGRAMS\R-039 PASI.DWG		FIGURE 2

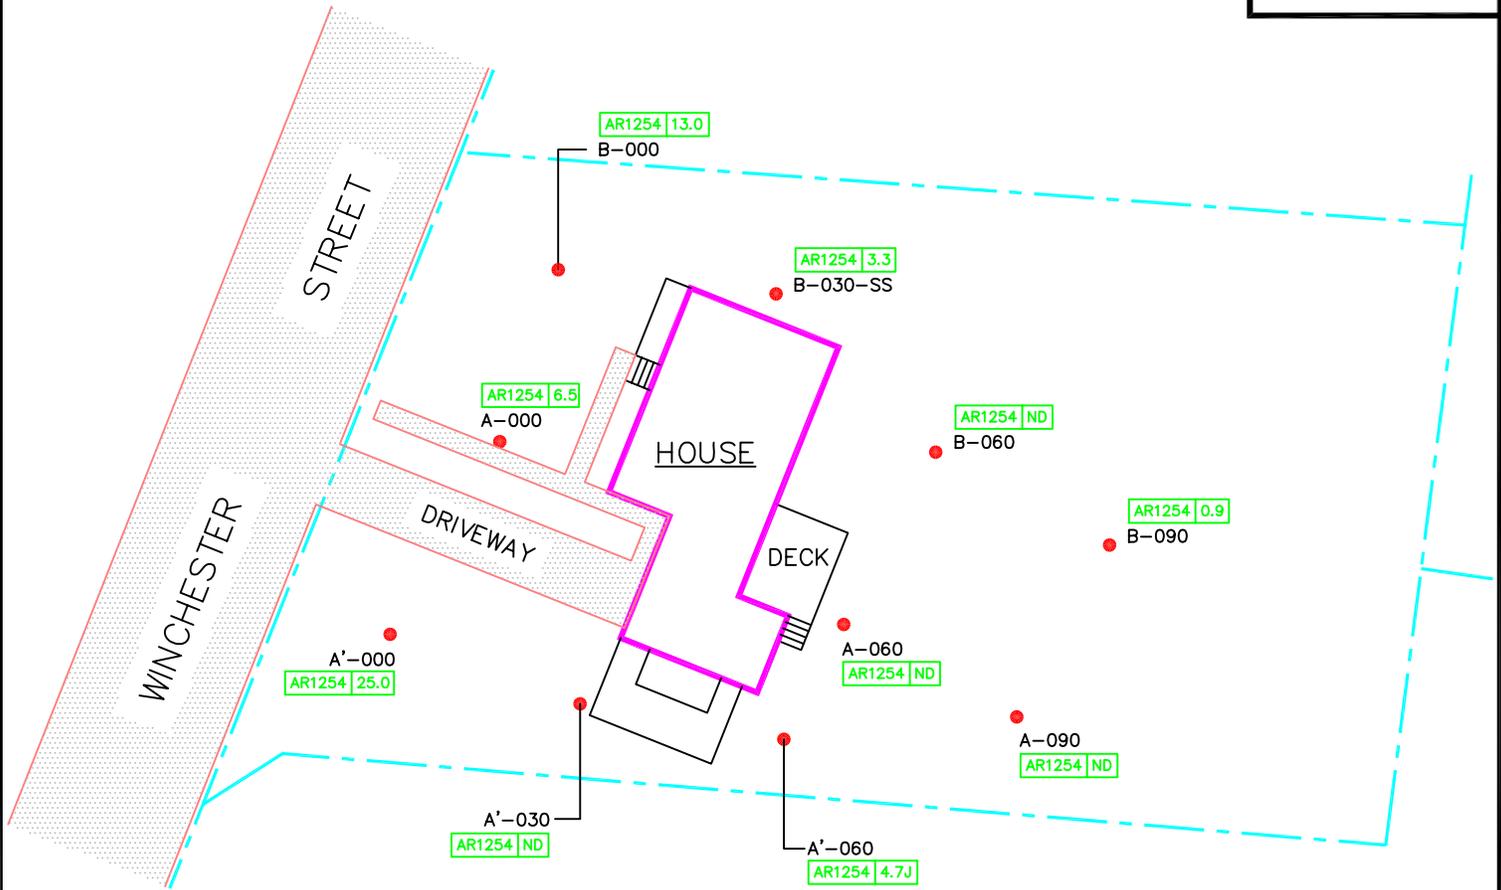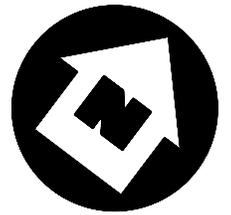

SOURCES:
 TOWN OF TEMPLETON, MASSACHUSETTS
 TAX ASSESSORS MAPS NOS. 6-4, AND 6.5
 APRIL 1964, REVISED JANUARY 2001
 NOT TO SCALE

LEGEND

- PAVED AREA
- PROPERTY LINE
- SOIL SAMPLING LOCATION

DENOTES SOIL SAMPLING POINT IDENTIFICATION

A-000 AROCLOR 1254 (PCB) RESULTS IN PARTS PER MILLION (PPM)

AR1254 | 0.0

NOTES:
 ALL RESULTS ARE REPORTED IN MG/KG (PARTS PER MILLION)
 ND = NOT DETECTED
 J = RESULT IS ESTIMATED

SITE DIAGRAM

BALDWINVILLE RESIDENTIAL
 PROPERTIES
 R-041

BALDWINVILLE, MASSACHUSETTS



REGION I SUPERFUND TECHNICAL ASSESSMENT AND RESPONSE TEAM



TDD #
 05-07-0008

DRAWN BY:
 W. SHAW

DATE
 3/15/05

FILE NAME:
 R:\05070008\FIGURES\PROPERTY DIAGRAMS\R-041
 PASI.DWG

FIGURE 2

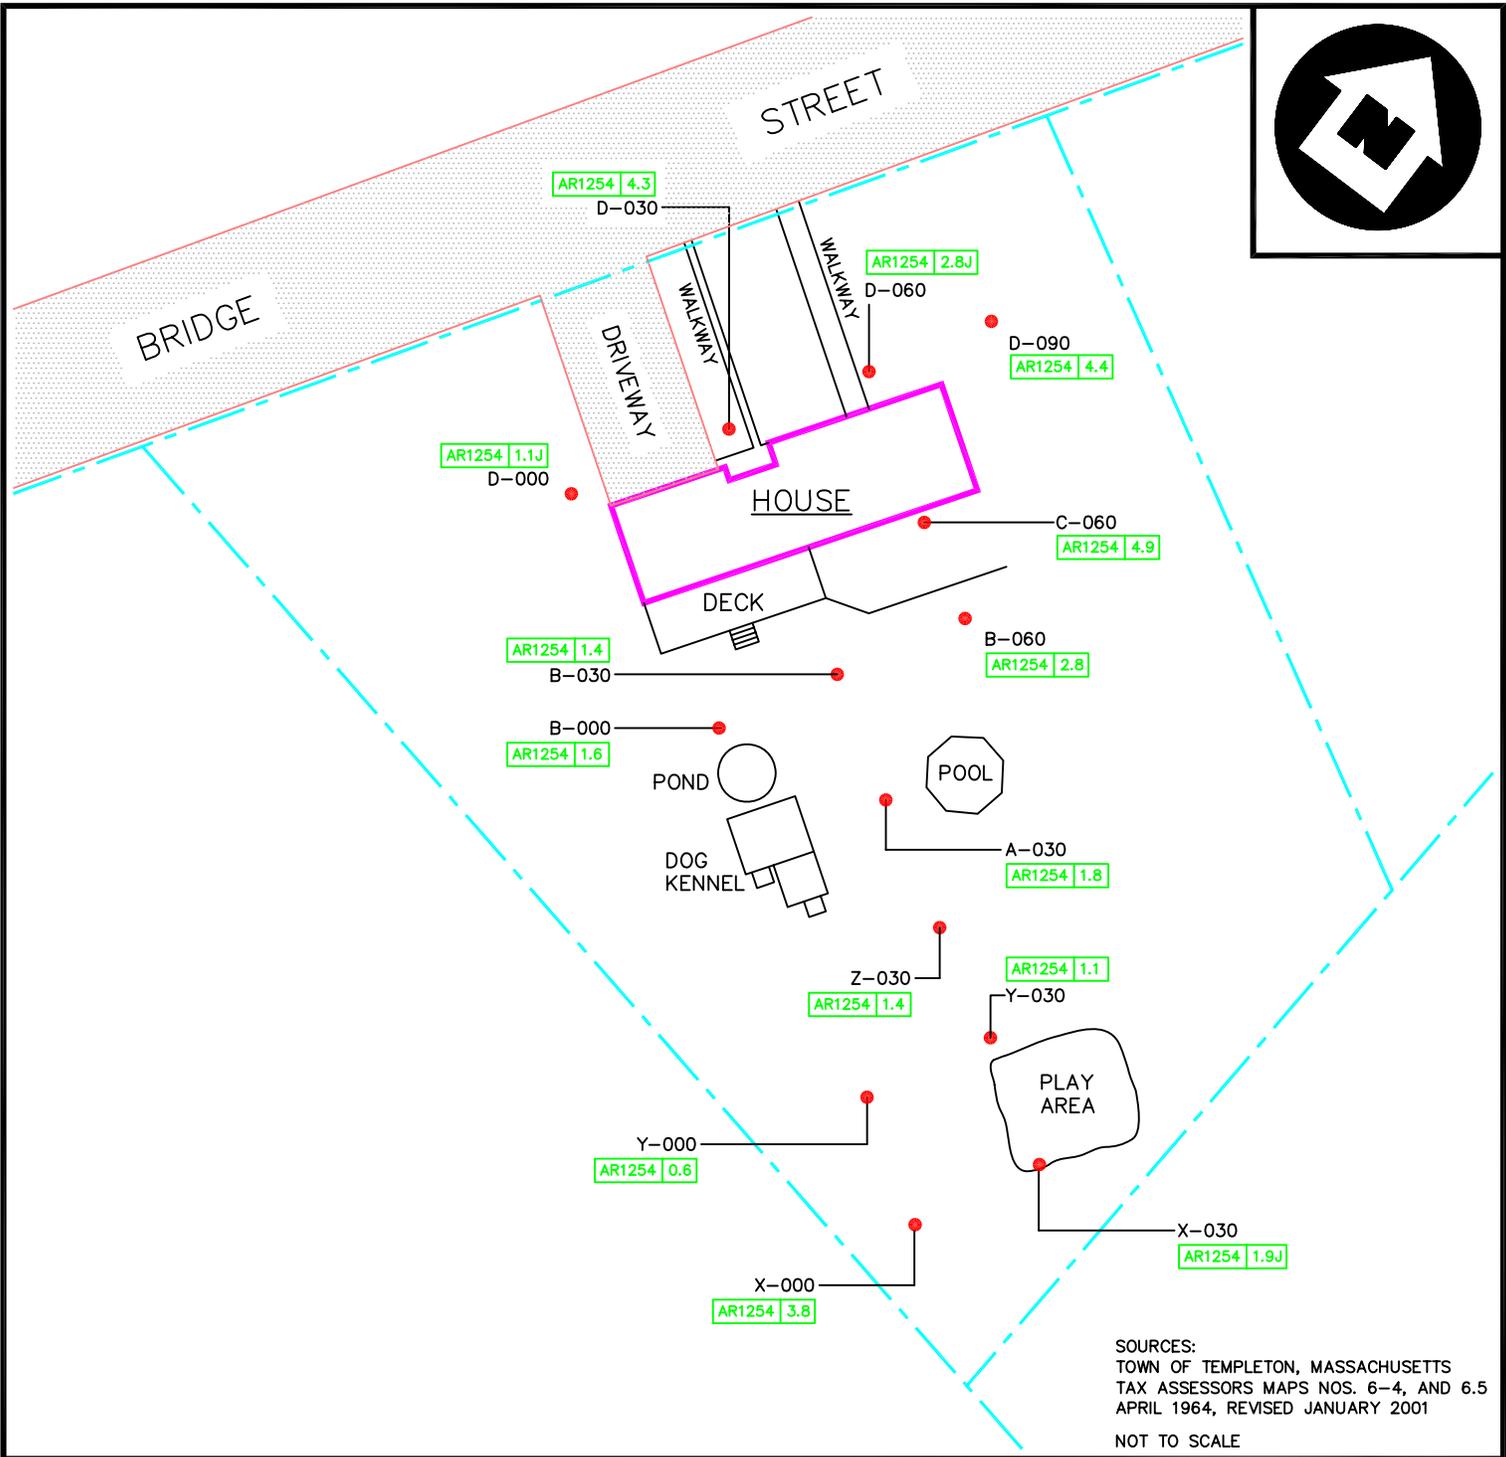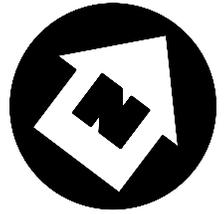

SOURCES:
 TOWN OF TEMPLETON, MASSACHUSETTS
 TAX ASSESSORS MAPS NOS. 6-4, AND 6.5
 APRIL 1964, REVISED JANUARY 2001
 NOT TO SCALE

LEGEND

- PAVED AREA
- SOIL SAMPLING LOCATION
- PROPERTY LINE
- DENOTES SOIL SAMPLING POINT IDENTIFICATION
- A-000 AROCLOR 1254 (PCB) RESULTS IN PARTS PER MILLION (PPM)
- AR1254 | 0.0
- NOTES:
 ALL RESULTS ARE REPORTED IN MG/KG (PARTS PER MILLION)
 ND = NOT DETECTED
 J = RESULT IS ESTIMATED

PROPERTY DIAGRAM

BALDWINVILLE RESIDENTIAL
 PROPERTIES
 R-043



BALDWINVILLE, MASSACHUSETTS



REGION I SUPERFUND TECHNICAL ASSESSMENT AND RESPONSE TEAM

TDD # 05-07-0008	DRAWN BY: W. SHAW	DATE 12/8/04
---------------------	----------------------	-----------------

FILE NAME: R:\05070008\FIGURES\PROPERTY DIAGRAMS\R-043 PASI.DWG	FIGURE 2
---	----------

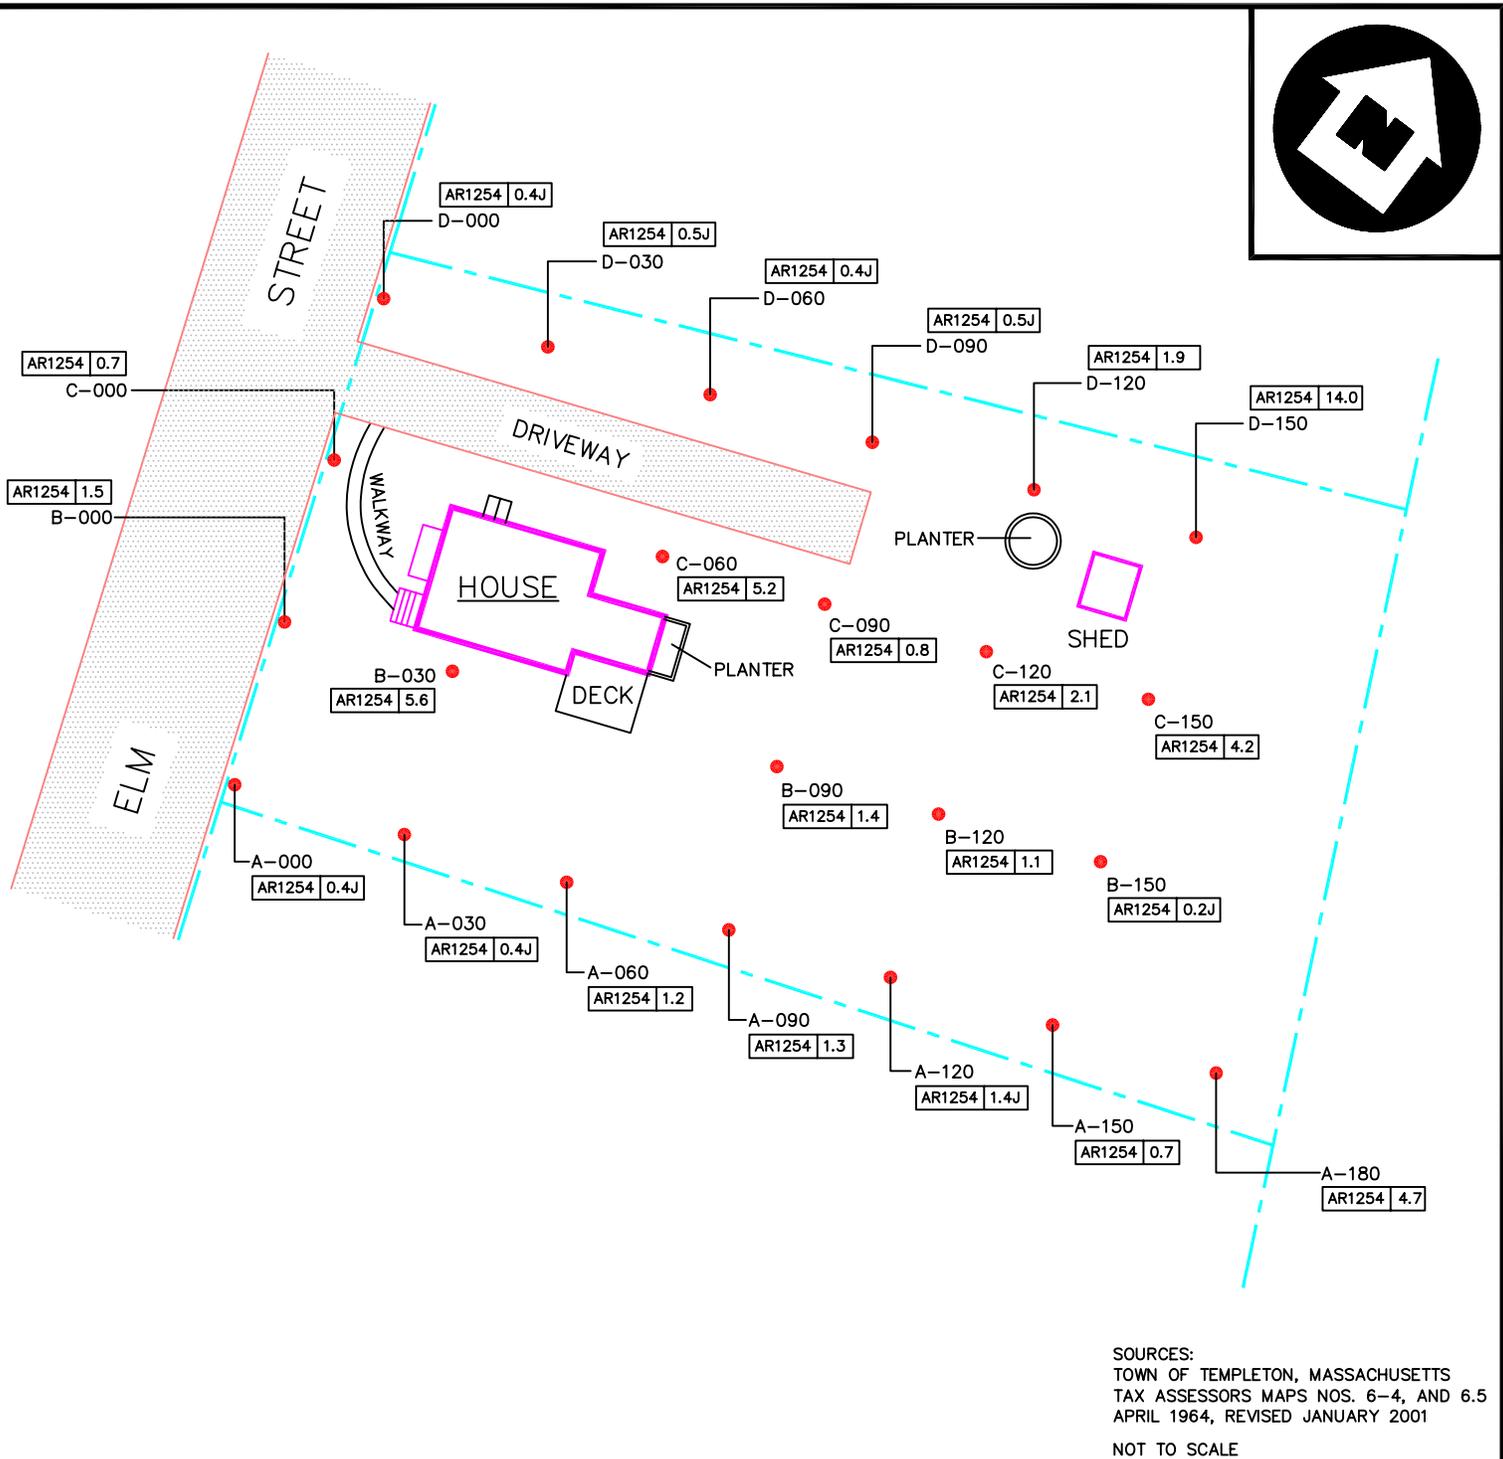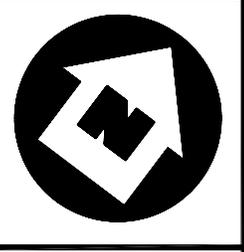

LEGEND

- PAVED AREA
- PROPERTY LINE
- SOIL SAMPLING LOCATION

DENOTES SOIL SAMPLING POINT IDENTIFICATION
 A-000 AROCLOR 1254 (PCB) RESULTS IN PARTS PER MILLION (PPM)
 AR1254 0.0

NOTES:
 ALL RESULTS ARE REPORTED IN MG/KG (PARTS PER MILLION)
 ND = NOT DETECTED
 J = RESULT IS ESTIMATED

SITE DIAGRAM

BALDWINVILLE RESIDENTIAL
 PROPERTIES
 R-047

BALDWINVILLE, MASSACHUSETTS




REGION I SUPERFUND TECHNICAL ASSESSMENT AND RESPONSE TEAM

TDD # 05-07-0008	DRAWN BY: W. SHAW	DATE 2/17/05
FILE NAME: R:\05070008\FIGURES\PROPERTY DIAGRAMS\R-047 PASI.DWG		FIGURE 2

Section 2 - Phase II PA/SI Diagrams

REPORTED RESULTS ARE FOR AROCLOR
 1254 AND ARE REPORTED IN MG/KG.
 MG/KG = PARTS PER MILLION (PPM).
 J = VALUE IS ESTIMATED.

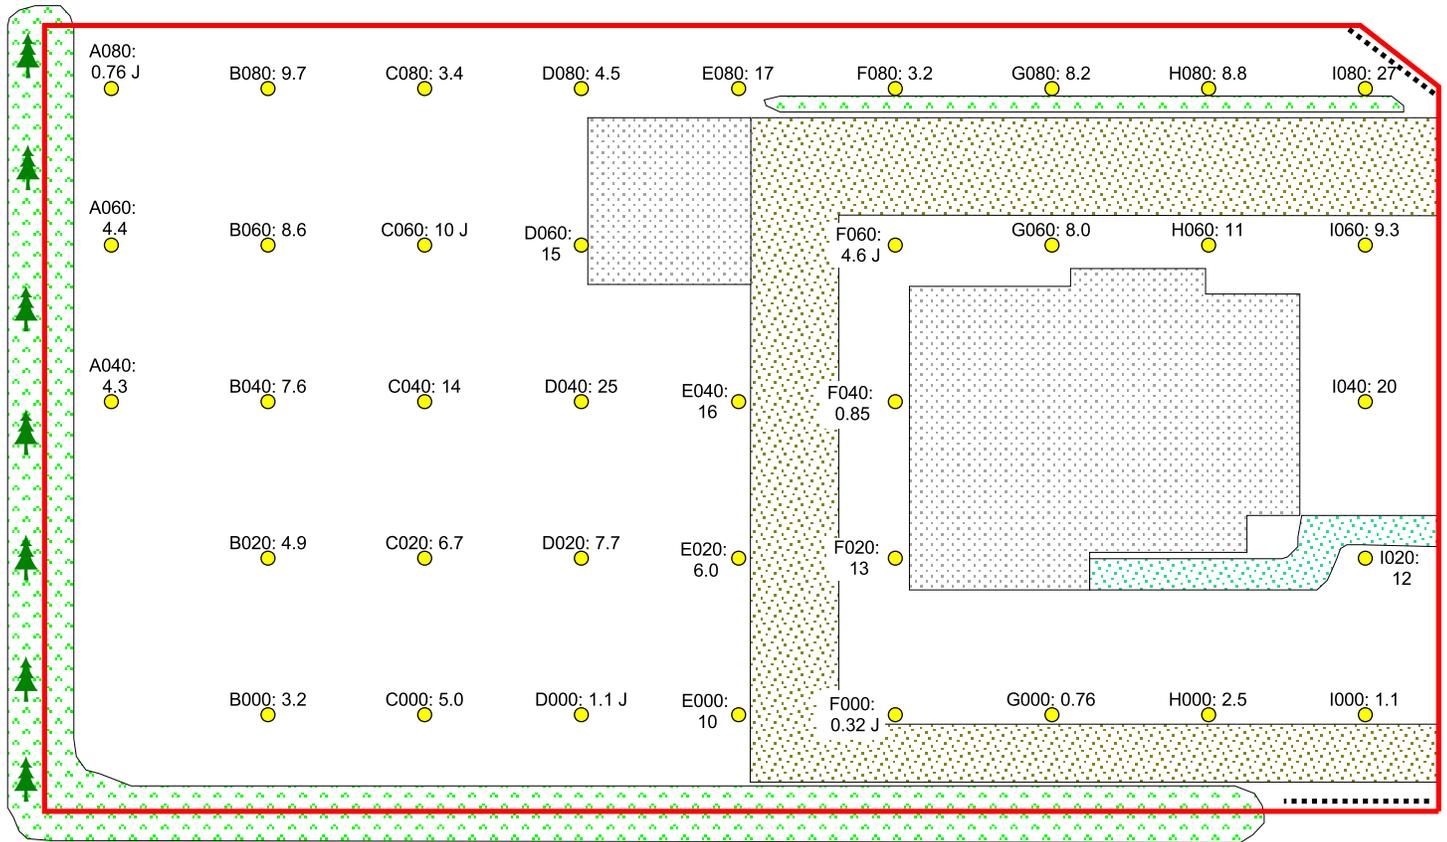

SAMPLE LOCATION

- R060
- TREE
- FENCE
- PROPERTY BOUNDARY
- BUILDING
- GRAVEL AREA
- WALKWAY
- BUSHES



NOT TO SCALE

SITE DIAGRAM

BALDWINVILLE RESIDENTIAL PROPERTIES
 R-060
 BALDWINVILLE, MASSACHUSETTS




REGION I SUPERFUND TECHNICAL ASSESSMENT AND RESPONSE TEAM

TDD NUMBER: 05-07-0008	CREATED BY: D. MUZRALL	CREATED ON: 12/30/2004
---------------------------	---------------------------	---------------------------

FILE LOCATION:
 E:\ARC_APRs\START2\
 Baldwinville_Residential_Grids2004.apr

FIGURE 2

REPORTED RESULTS ARE FOR AROCLOR 1254 AND ARE REPORTED IN MG/KG.
 MG/KG = PARTS PER MILLION (PPM).
 U = VALUE IS NON-DETECTED.
 J = VALUE IS ESTIMATED.

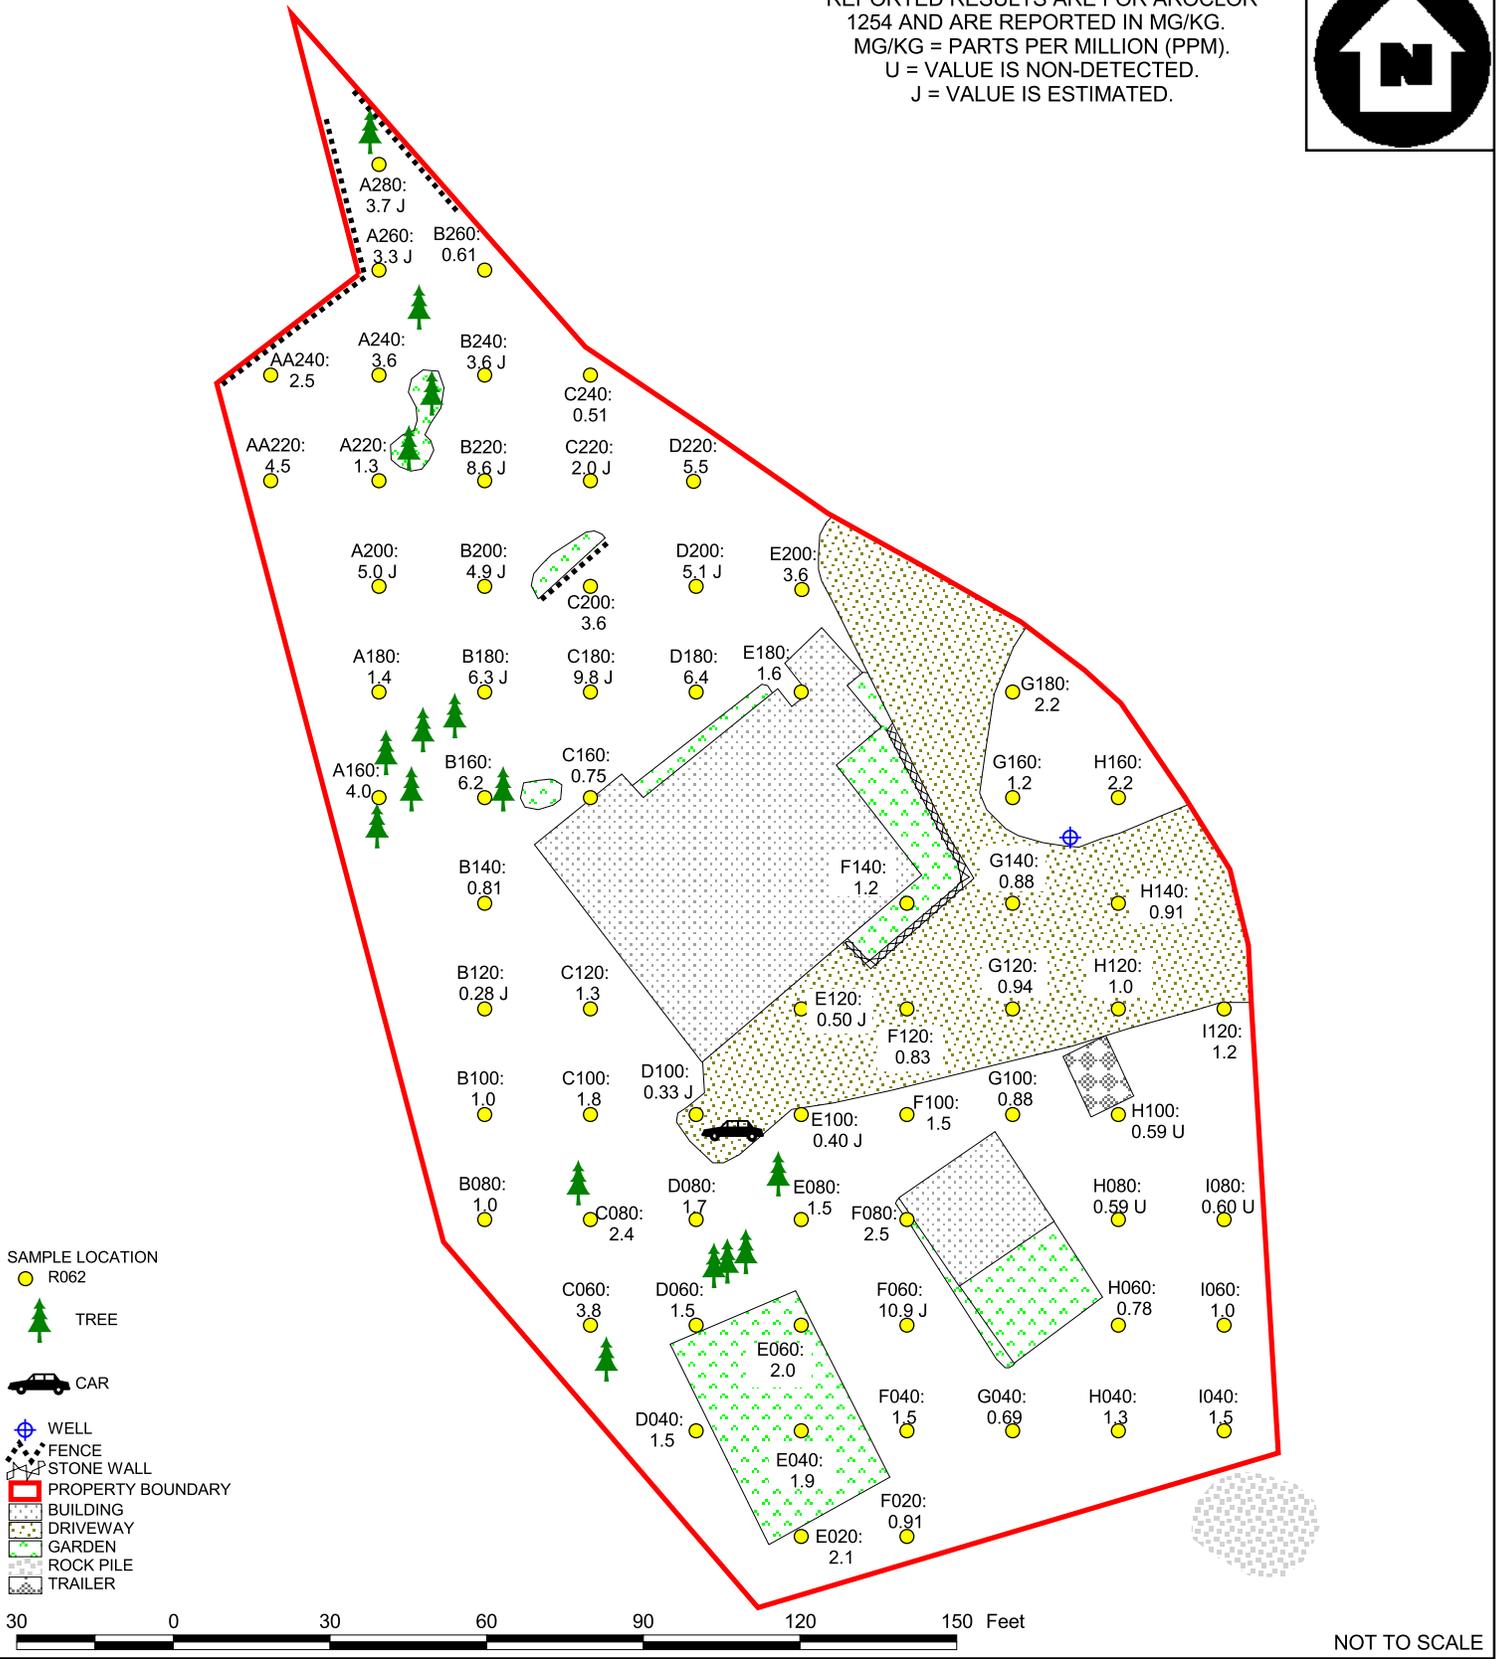

SITE DIAGRAM


BALDWINVILLE RESIDENTIAL PROPERTIES
 R-062
 BALDWINVILLE, MASSACHUSETTS



REGION I SUPERFUND TECHNICAL ASSESSMENT AND RESPONSE TEAM

TDD NUMBER: 05-07-0008	CREATED BY: D. MUZRALL	CREATED ON: 12/29/2004
FILE LOCATION: E:\ARC_APRs\START2\ Baldwinville_Residential_Grids2004.apr		FIGURE 2

REPORTED RESULTS ARE FOR AROCLOR
 1254 AND ARE REPORTED IN MG/KG.
 MG/KG = PARTS PER MILLION (PPM).
 J = VALUE IS ESTIMATED.

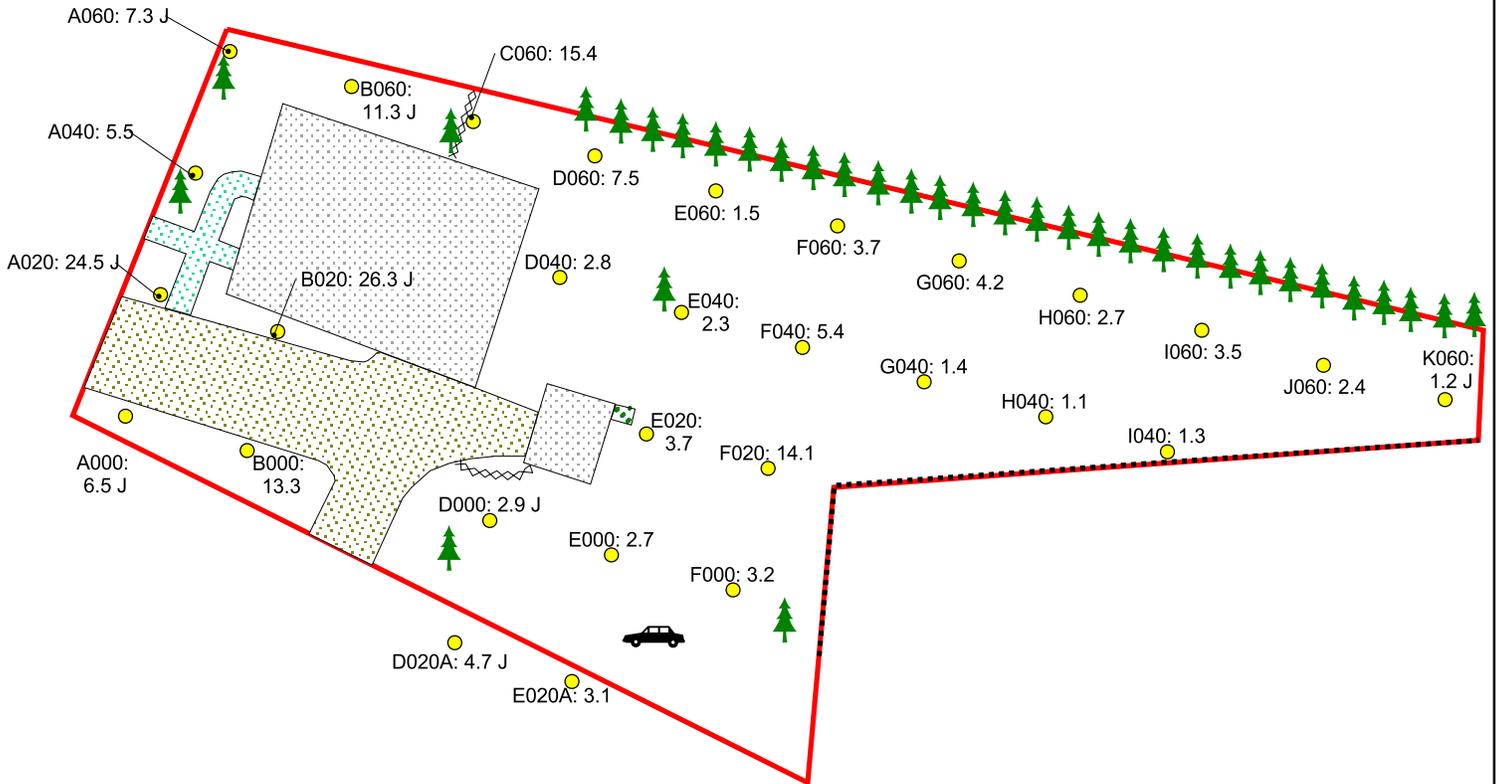

- SAMPLE LOCATION R063
- CAR
- TREE
- STONE WALL
- FENCE
- BUILDING
- COMPOST PILE
- WALKWAY
- PAVED AREA
- PROPERTY BOUNDARY



NOT TO SCALE

SITE DIAGRAM


BALDWINVILLE RESIDENTIAL PROPERTIES
 R-063
 BALDWINVILLE, MASSACHUSETTS



REGION I SUPERFUND TECHNICAL ASSESSMENT AND RESPONSE TEAM

TDD NUMBER: 05-07-0008	CREATED BY: D. MUZRALL	CREATED ON: 10/26/2004
FILE LOCATION: E:\ARC_APRs\START2\ Baldwinville_Residential_Grids2004.apr		FIGURE 2

REPORTED RESULTS ARE FOR AROCLOR
 1254 AND ARE REPORTED IN MG/KG.
 MG/KG = PARTS PER MILLION (PPM).
 J = VALUE IS ESTIMATED.

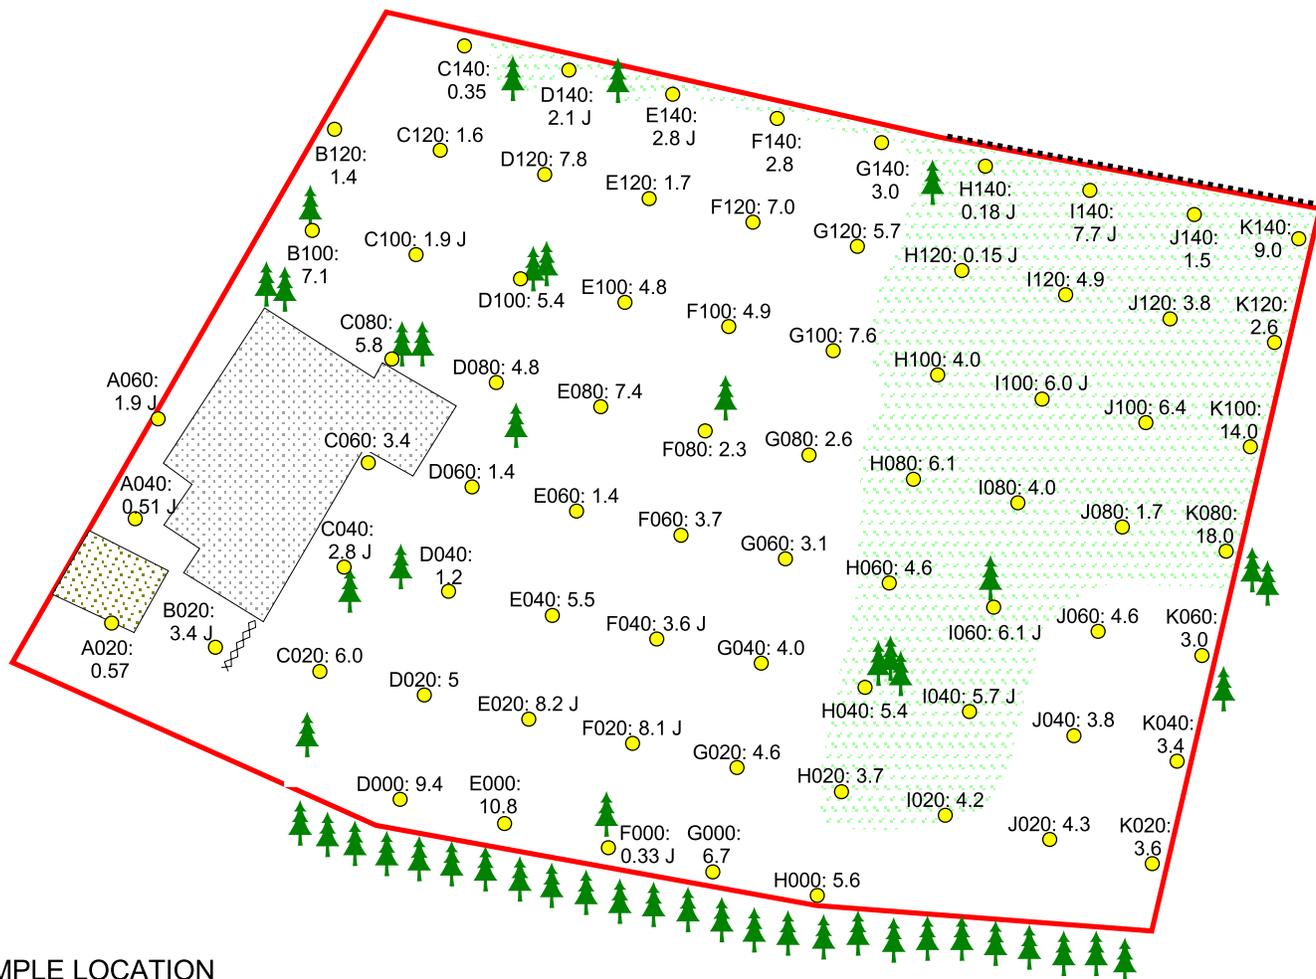

SAMPLE LOCATION

- R064
- TREE
- STONEWALL FENCE
- BUILDING
- PAVED AREA
- PROPERTY BOUNDARY
- OVERGROWN AREA



NOT TO SCALE

SITE DIAGRAM


**BALDWINVILLE RESIDENTIAL PROPERTIES
 R-064
 BALDWINVILLE, MASSACHUSETTS**




REGION I SUPERFUND TECHNICAL ASSESSMENT AND RESPONSE TEAM

TDD NUMBER: 05-07-0008	CREATED BY: D. MUZRALL	CREATED ON: 10/27/2004
FILE LOCATION: E:\ARC_APRs\START2\ Baldwinville_Residential_Grids2004.apr		FIGURE 2

REPORTED RESULTS ARE FOR AROCLOR
 1254 AND ARE REPORTED IN MG/KG.
 MG/KG = PARTS PER MILLION (PPM).
 J = VALUE IS ESTIMATED.

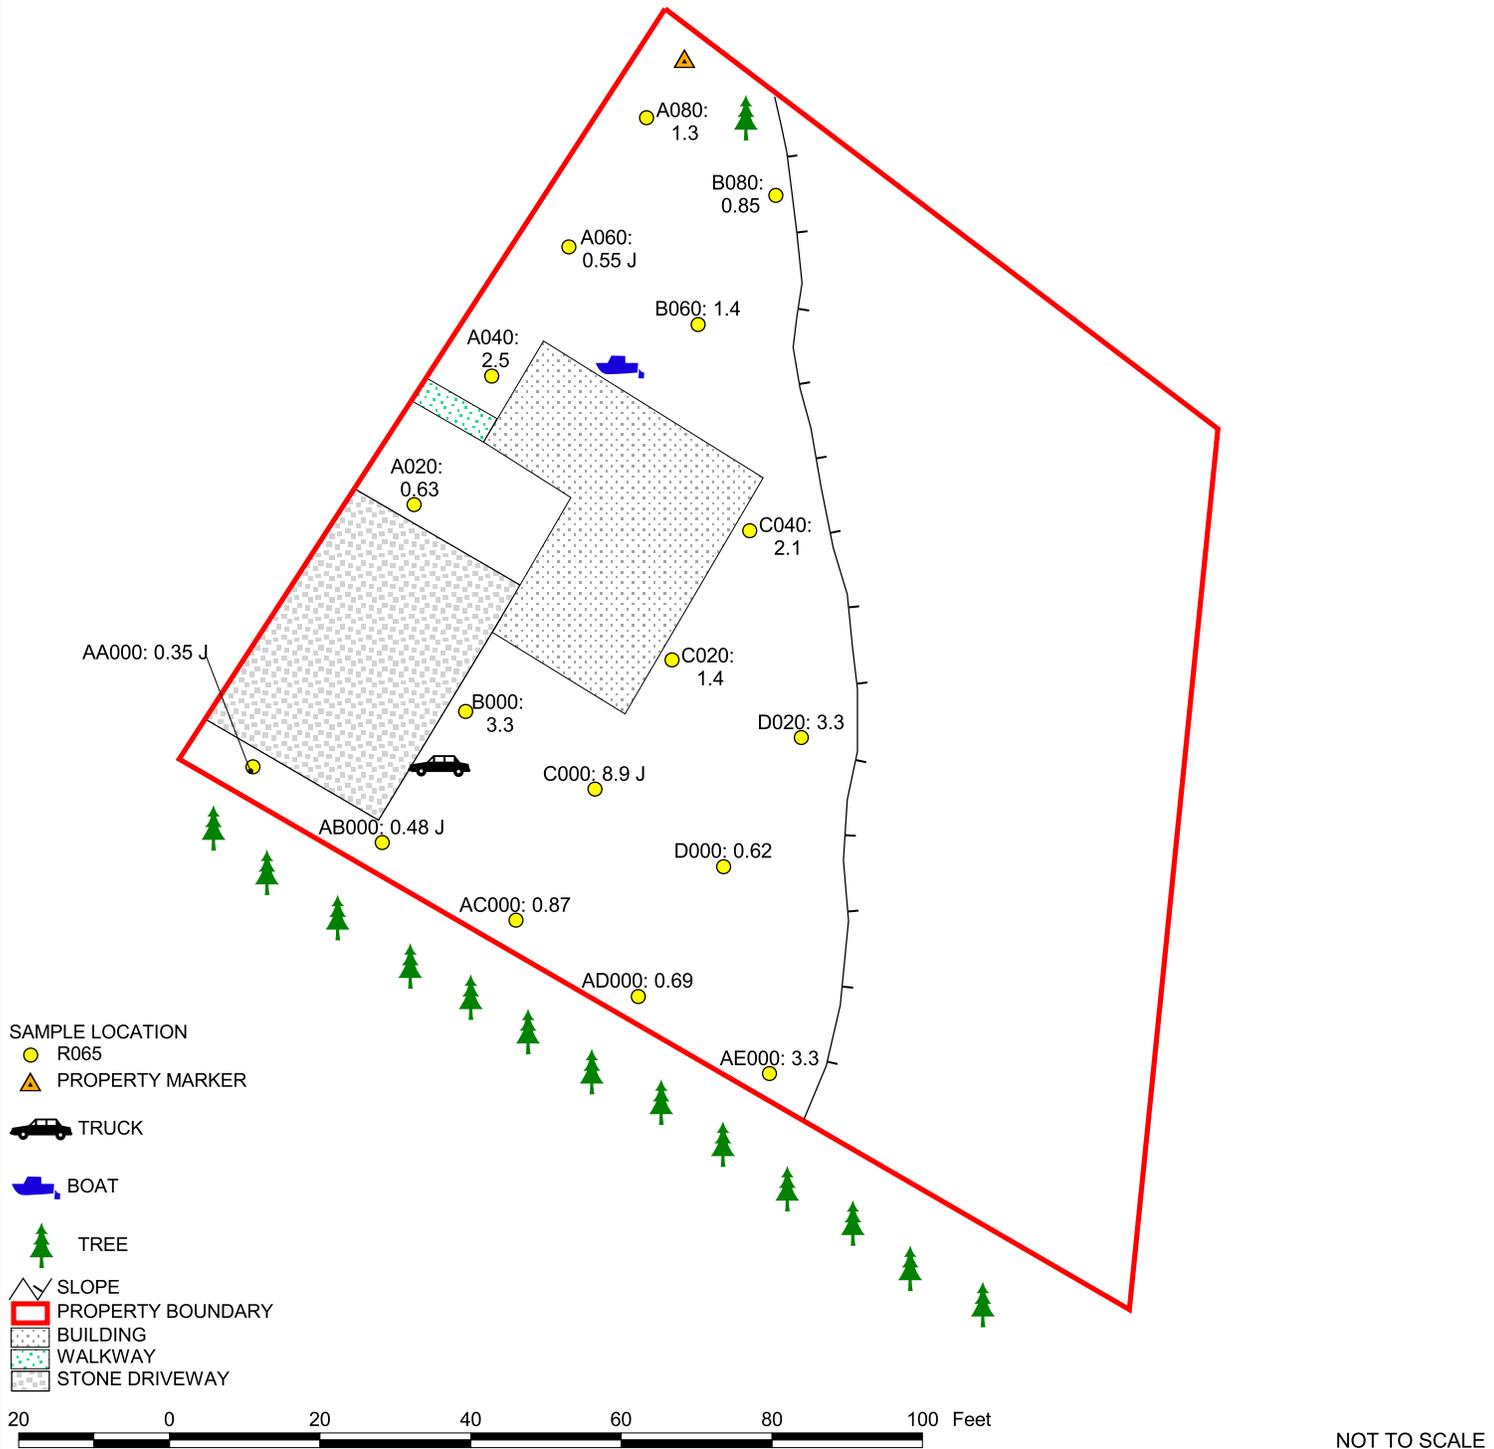

- SAMPLE LOCATION
- R065
 - ▲ PROPERTY MARKER
 - 🚚 TRUCK
 - 🚤 BOAT
 - 🌲 TREE
 - ⚡ SLOPE
 - ▭ PROPERTY BOUNDARY
 - ▭ BUILDING
 - ▭ WALKWAY
 - ▭ STONE DRIVEWAY

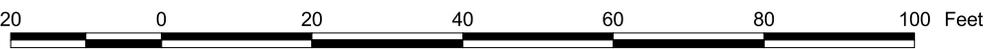

NOT TO SCALE

SITE DIAGRAM


BALDWINVILLE RESIDENTIAL PROPERTIES
 R-065
 BALDWINVILLE, MASSACHUSETTS



REGION I SUPERFUND TECHNICAL ASSESSMENT AND RESPONSE TEAM

TDD NUMBER: 05-07-0008	CREATED BY: D. MUZRALL	CREATED ON: 12/30/2004
FILE LOCATION: E:\ARC_APRs\START2\ Baldwinville_Residential_Grids2004.apr		FIGURE 2

REPORTED RESULTS ARE FOR AROCLOR
 1254 AND ARE REPORTED IN MG/KG.
 MG/KG = PARTS PER MILLION (PPM).
 J = VALUE IS ESTIMATED.

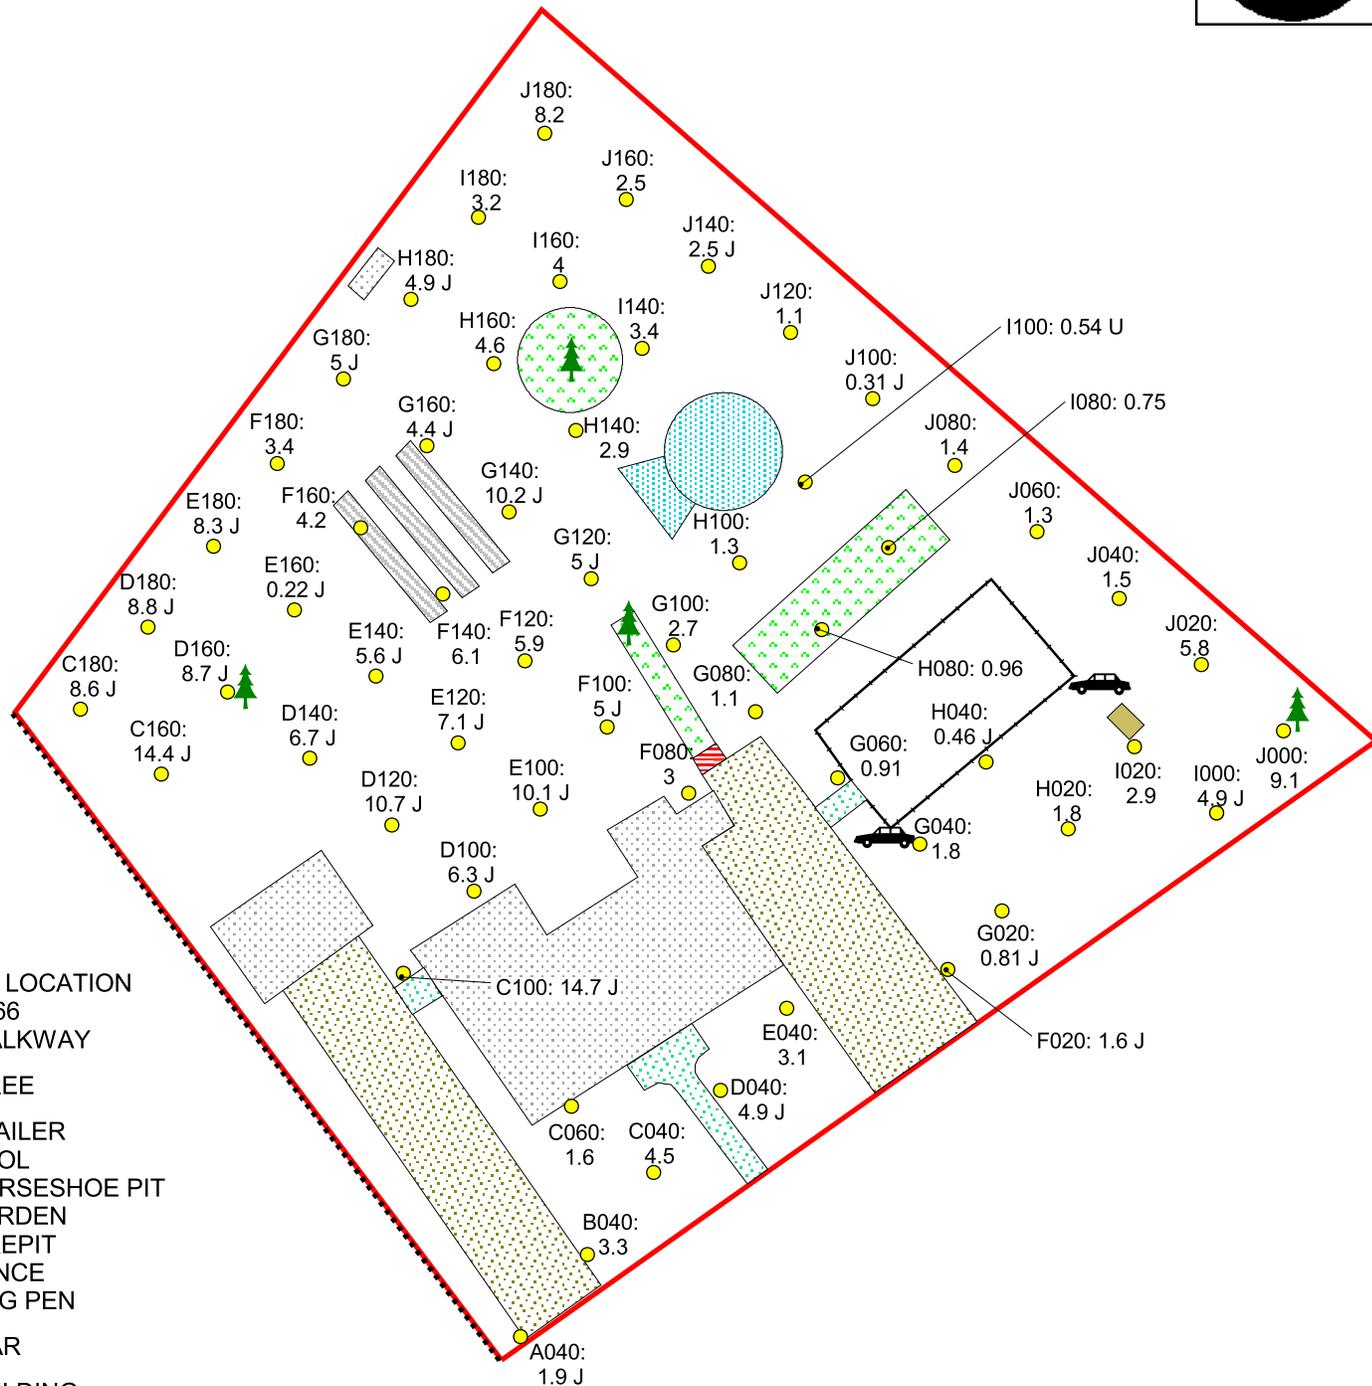

- SAMPLE LOCATION**
- R066
 - WALKWAY
 - TREE
 - TRAILER
 - POOL
 - HORSESHOE PIT
 - GARDEN
 - FIREPIT
 - FENCE
 - DOG PEN
 - CAR
 - BUILDING
 - PAVED AREA
 - PROPERTY BOUNDARY

20 0 20 40 60 80 100 Feet

NOT TO SCALE

SITE DIAGRAM

**BALDWINVILLE RESIDENTIAL PROPERTIES
 R-066
 BALDWINVILLE, MASSACHUSETTS**



REGION I SUPERFUND TECHNICAL ASSESSMENT AND RESPONSE TEAM

TDD NUMBER: 05-07-0008	CREATED BY: D. MUZRALL	CREATED ON: 10/26/2004
FILE LOCATION: E:\ARC_APRs\START2\ Baldwinville_Residential_Grids2004.apr		FIGURE 2

REPORTED RESULTS ARE FOR AROCLOR
 1254 AND ARE REPORTED IN MG/KG.
 MG/KG = PARTS PER MILLION (PPM).
 J = VALUE IS ESTIMATED.



SITE DIAGRAM


BALDWINVILLE RESIDENTIAL PROPERTIES
 R-067
 BALDWINVILLE, MASSACHUSETTS



REGION I SUPERFUND TECHNICAL ASSESSMENT AND RESPONSE TEAM

TDD NUMBER: 05-07-0008	CREATED BY: D. MUZRALL	CREATED ON: 10/26/2004
FILE LOCATION: E:\ARC_APRs\START2\ Baldwinville_Residential_Grids2004.apr		FIGURE 2

REPORTED RESULTS ARE FOR AROCLOR
 1254 AND ARE REPORTED IN MG/KG.
 MG/KG = PARTS PER MILLION (PPM).
 U = VALUE ISNON-DETECTED.
 J = VALUE IS ESTIMATED.

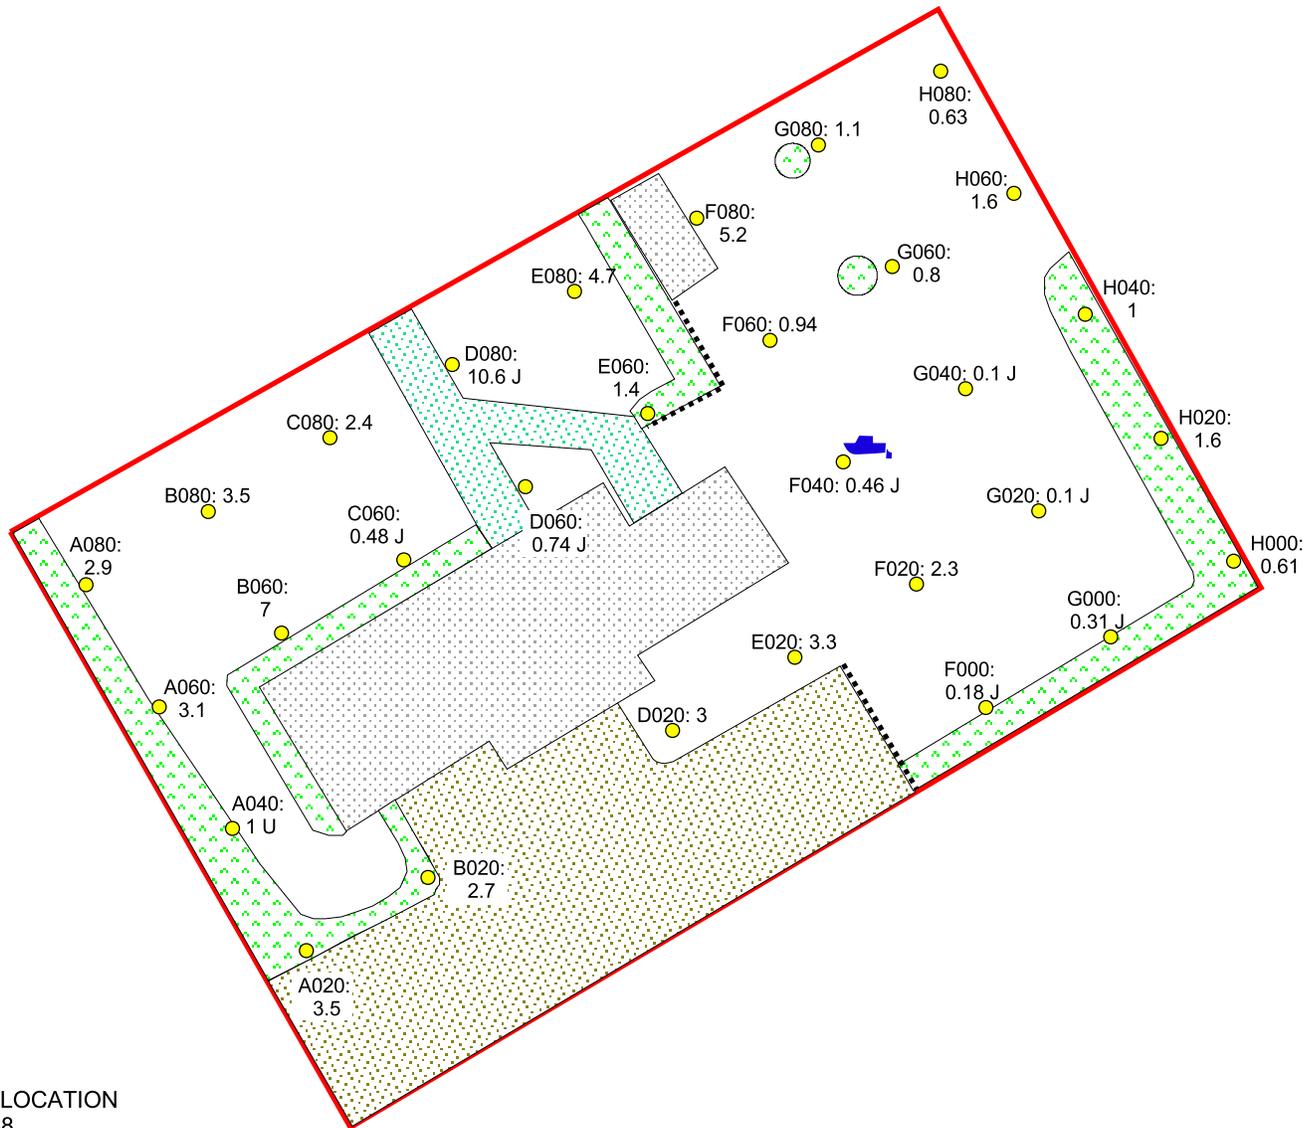

- SAMPLE LOCATION
- R068
 - JET SKI
 - FENCE
 - GARDEN
 - BUILDING
 - WALKWAY
 - PAVED AREA
 - PROPERTY BOUNDARY



NOT TO SCALE

SITE DIAGRAM


BALDWINVILLE RESIDENTIAL PROPERTIES
 R-068
 BALDWINVILLE, MASSACHUSETTS



REGION I SUPERFUND TECHNICAL ASSESSMENT AND RESPONSE TEAM

TDD NUMBER: 05-07-0008	CREATED BY: D. MUZRALL	CREATED ON: 10/26/2004
FILE LOCATION: E:\ARC_APRs\START2\ Baldwinville_Residential_Grids2004.apr		FIGURE 2

REPORTED RESULTS ARE FOR AROCLOR
 1254 AND ARE REPORTED IN MG/KG.
 MG/KG = PARTS PER MILLION (PPM).
 J = VALUE IS ESTIMATED.

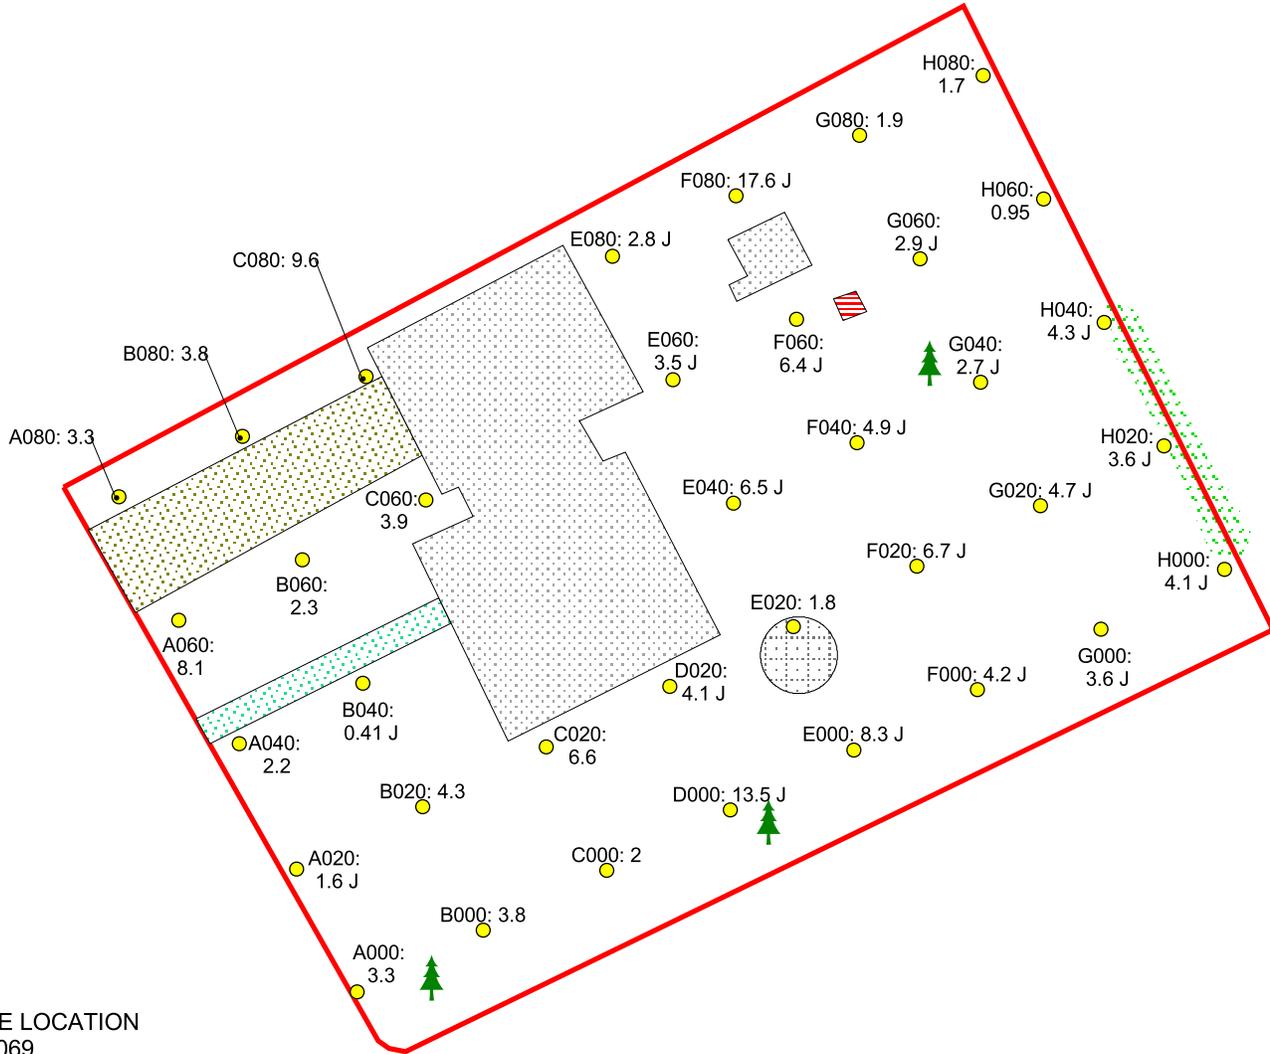

SAMPLE LOCATION

● R069

🌲 TREE

▨ TRAMPOLINE

▨ FIRE PIT

▨ BUILDING

▨ PAVED AREA

▨ WALKWAY

▨ PROPERTY BOUNDARY

▨ OVERGROWN

20 0 20 40 60 80 100 Feet

NOT TO SCALE

SITE DIAGRAM

BALDWINVILLE RESIDENTIAL PROPERTIES
 R-069
 BALDWINVILLE, MASSACHUSETTS




REGION I SUPERFUND TECHNICAL ASSESSMENT AND RESPONSE TEAM

TDD NUMBER: 05-07-0008	CREATED BY: D. MUZRALL	CREATED ON: 10/26/2004
---------------------------	---------------------------	---------------------------

FILE LOCATION:
 E:\ARC_APRs\START2\
 Baldwinville_Residential_Grids2004.apr

FIGURE 2

REPORTED RESULTS ARE FOR AROCLOR
 1254 AND ARE REPORTED IN MG/KG.
 MG/KG = PARTS PER MILLION (PPM).
 J = VALUE IS ESTIMATED.

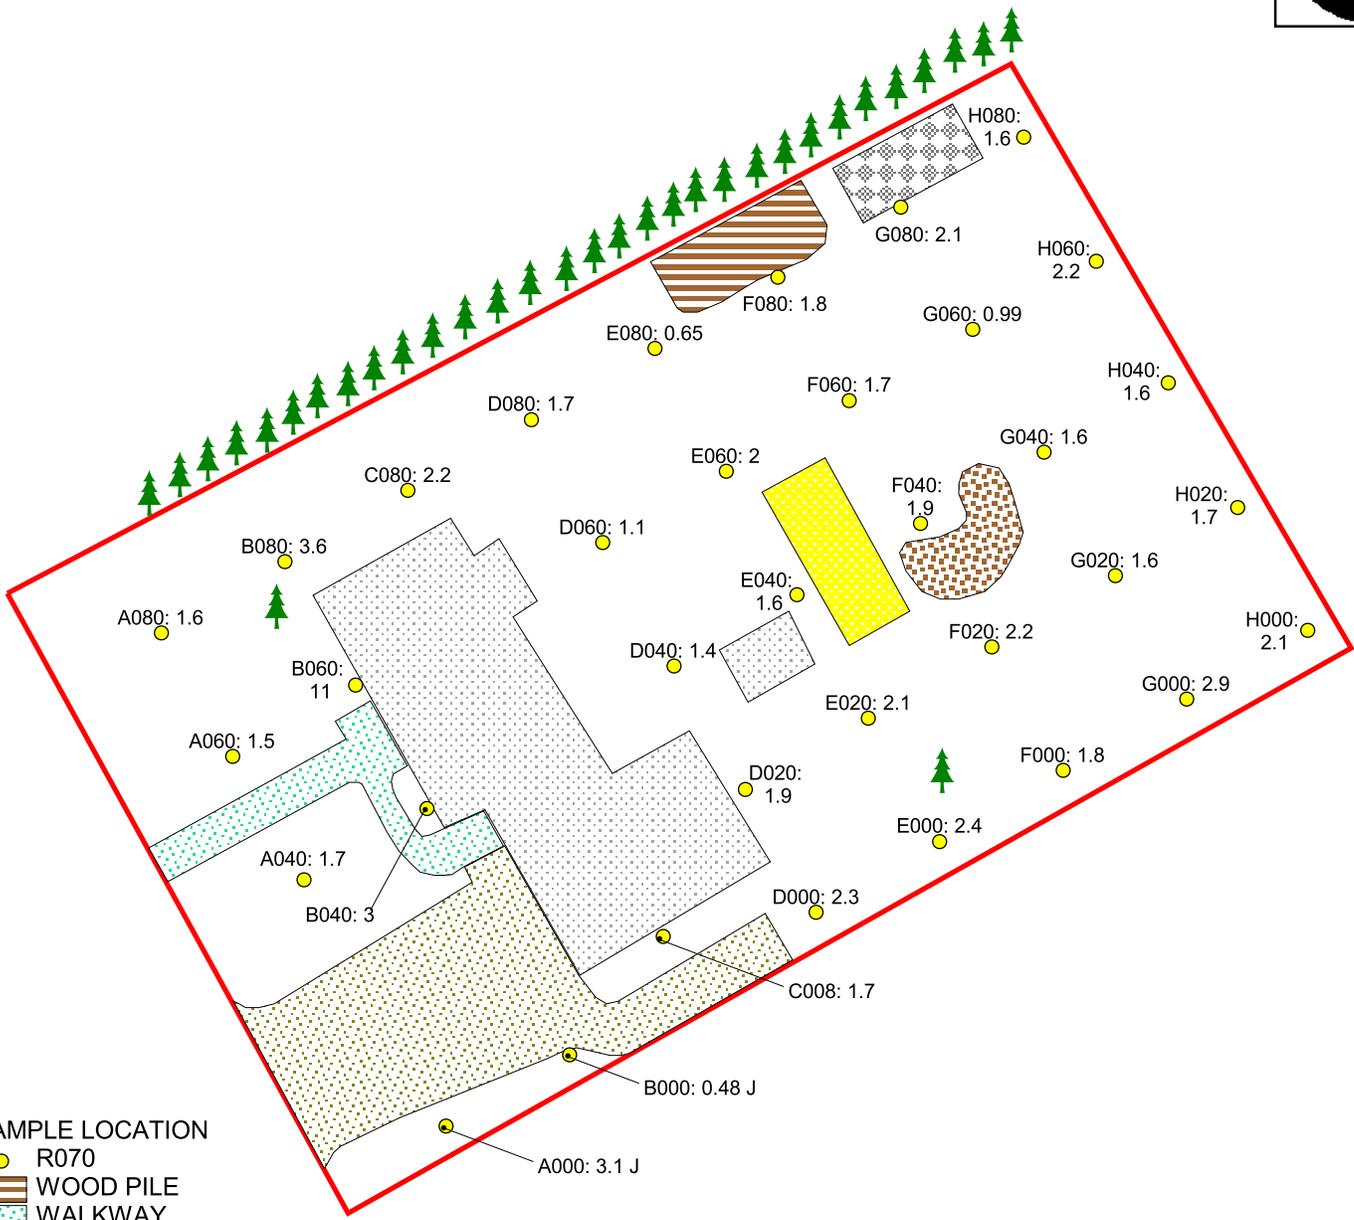

SAMPLE LOCATION

- R070
- WOOD PILE
- WALKWAY
- WAGON
- TREE
- PAVED AREA
- MOUNDED AREA
- BUILDING
- BACKHOE
- PROPERTY BOUNDARY



NOT TO SCALE

SITE DIAGRAM


**BALDWINVILLE RESIDENTIAL PROPERTIES
 R-070
 BALDWINVILLE, MASSACHUSETTS**



REGION I SUPERFUND TECHNICAL ASSESSMENT AND RESPONSE TEAM

TDD NUMBER: 05-07-0008	CREATED BY: D. MUZRALL	CREATED ON: 10/26/2004
FILE LOCATION: E:\ARC_APRs\START2\ Baldwinville_Residential_Grids2004.apr		FIGURE 2

REPORTED RESULTS ARE FOR AROCLOR
 1254 AND ARE REPORTED IN MG/KG.
 MG/KG = PARTS PER MILLION (PPM).
 U = VALUE IS NON-DETECTED.
 J = VALUE IS ESTIMATED.

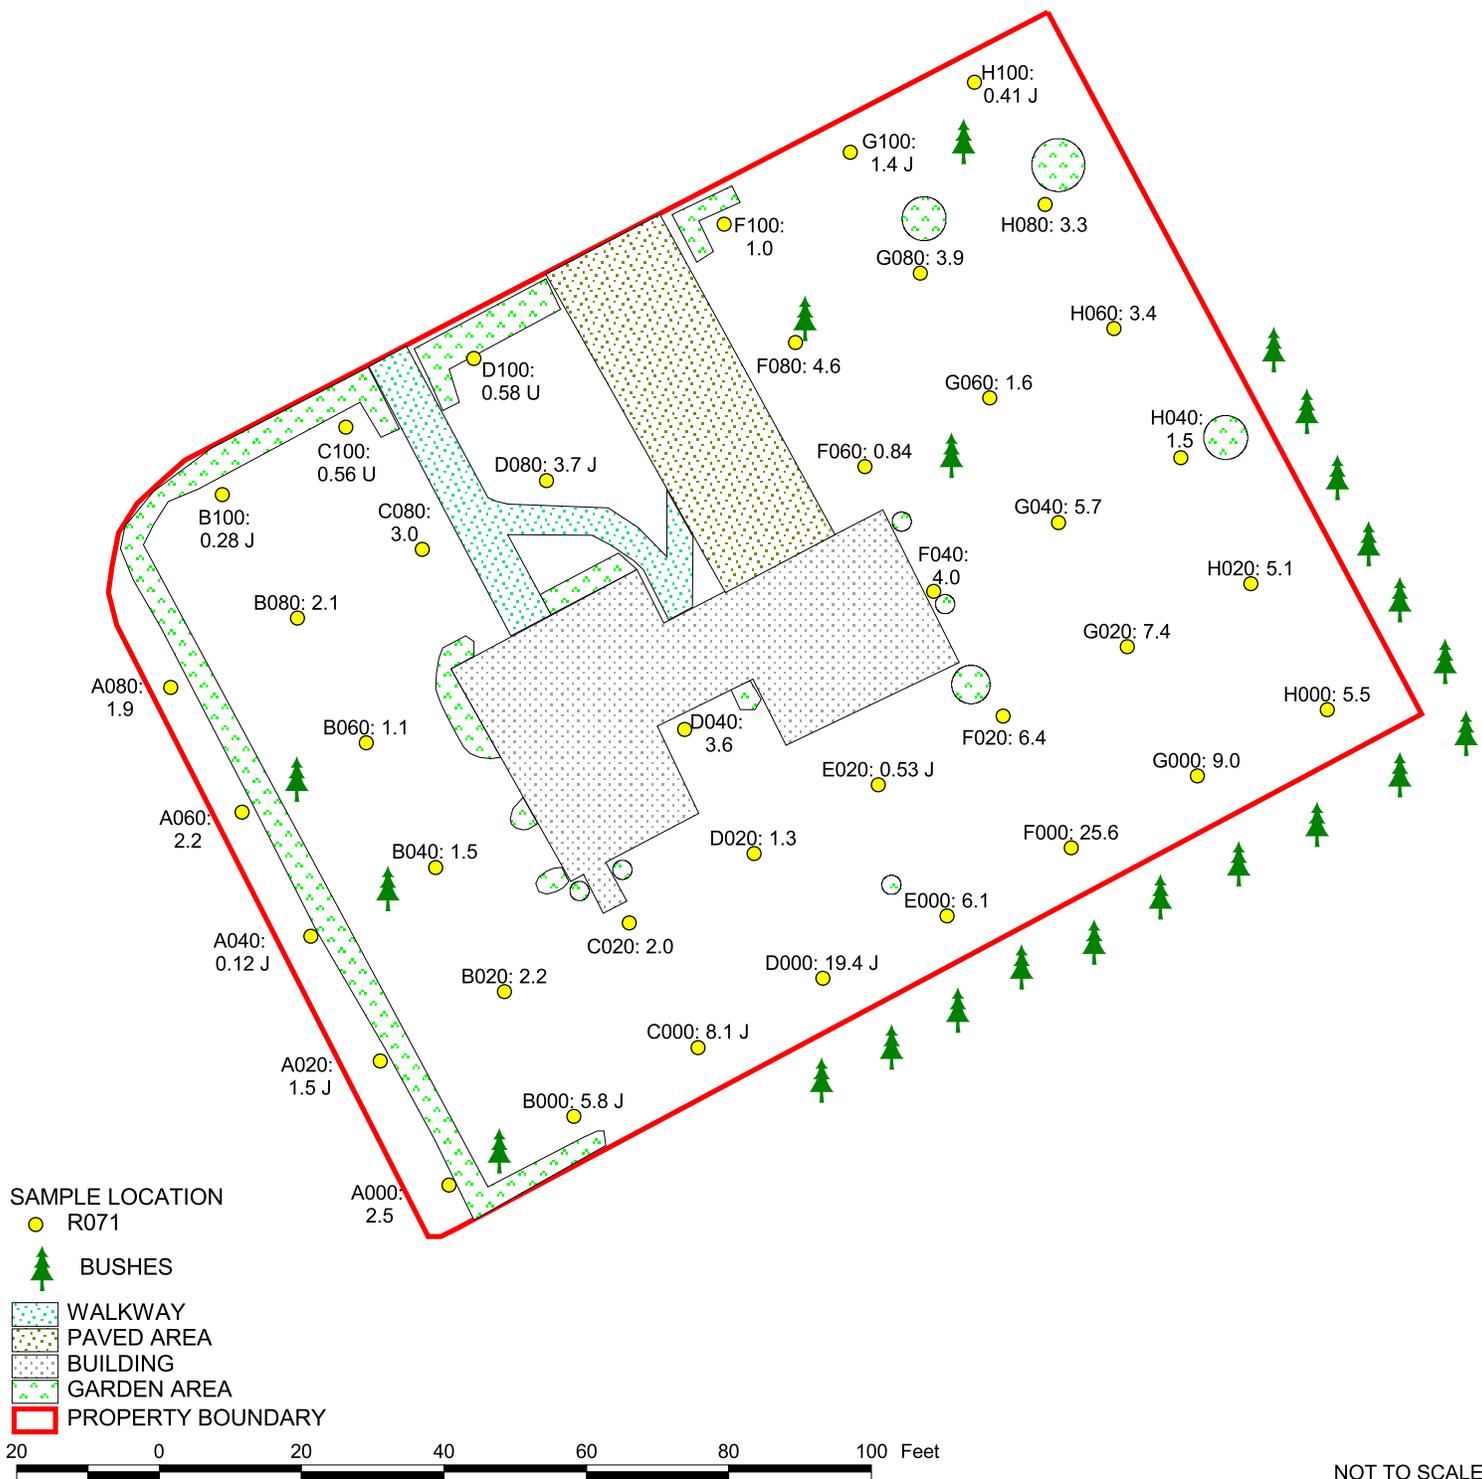

SITE DIAGRAM


BALDWINVILLE RESIDENTIAL PROPERTIES
 R-071
 BALDWINVILLE, MASSACHUSETTS



REGION I SUPERFUND TECHNICAL ASSESSMENT AND RESPONSE TEAM

TDD NUMBER: 05-07-0008	CREATED BY: D. MUZRALL	CREATED ON: 10/26/2004
FILE LOCATION: E:\ARC_APRs\START2\ Baldwinville_Residential_Grids2004.apr		FIGURE 2

REPORTED RESULTS ARE FOR AROCLOR
 1254 AND ARE REPORTED IN MG/KG.
 MG/KG = PARTS PER MILLION (PPM).
 J = VALUE IS ESTIMATED.

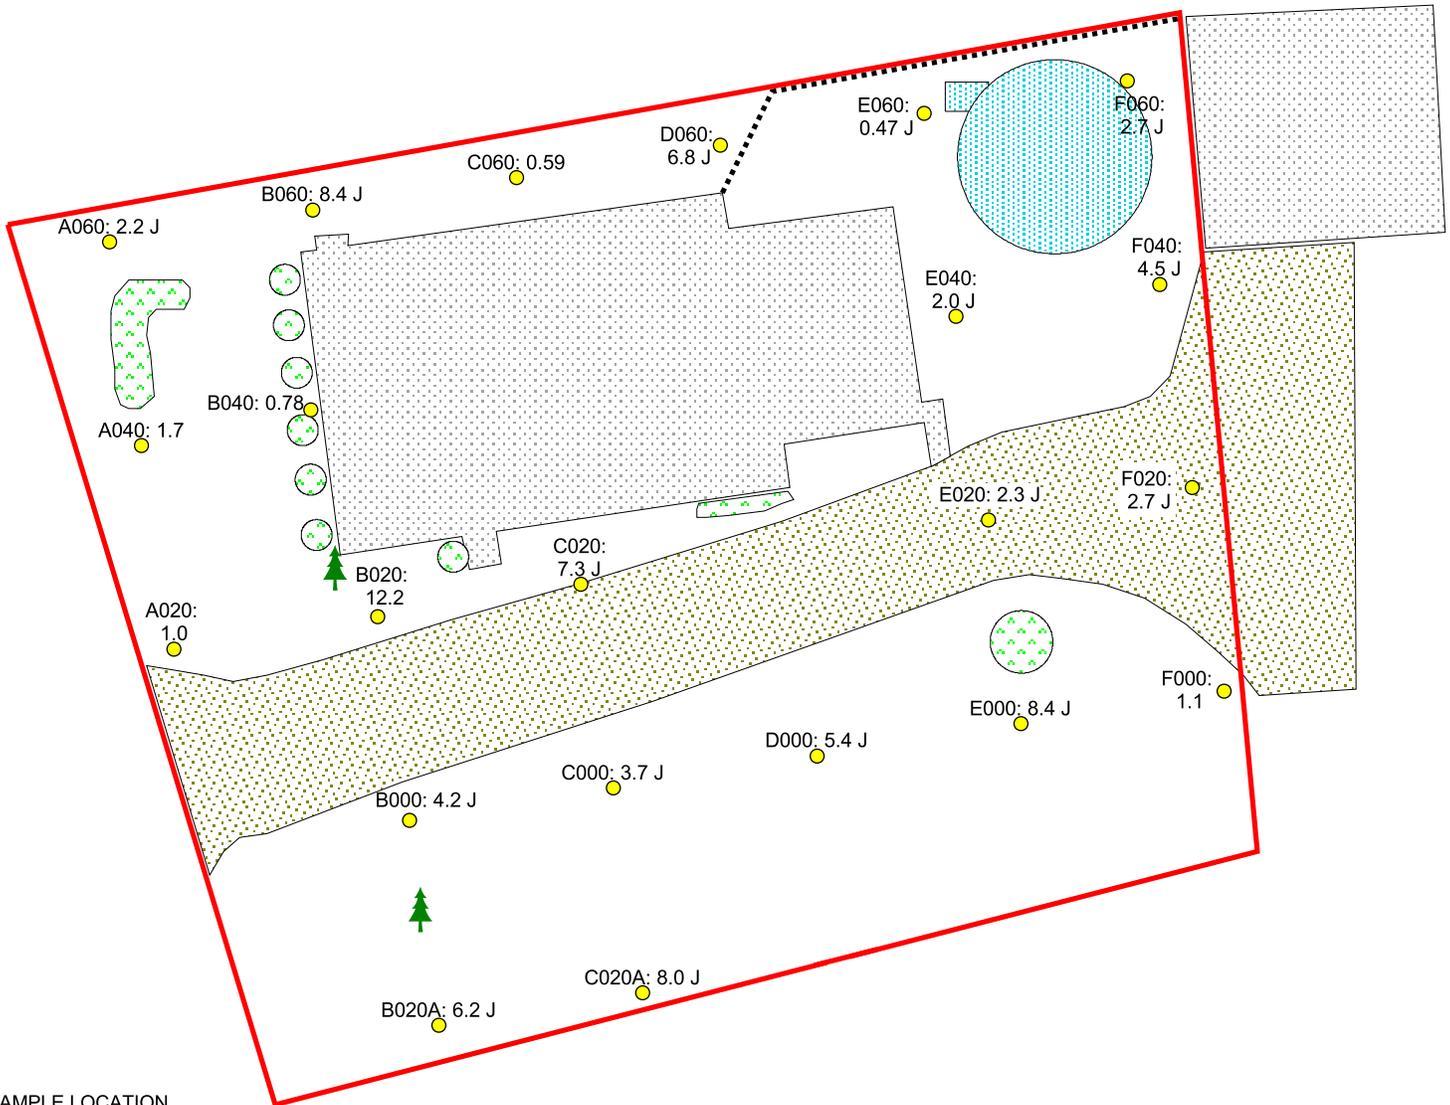

- SAMPLE LOCATION
- R073
 - TREE
 - GARDEN AREA
 - FENCE
 - BUILDING
 - POOL
 - PROPERTY BOUNDARY
 - GRAVEL AREA



NOT TO SCALE

SITE DIAGRAM


BALDWINVILLE RESIDENTIAL PROPERTIES
 R-073
 BALDWINVILLE, MASSACHUSETTS



REGION I SUPERFUND TECHNICAL ASSESSMENT AND RESPONSE TEAM

TDD NUMBER: 05-07-0008	CREATED BY: D. MUZRALL	CREATED ON: 12/21/2004
FILE LOCATION: E:\ARC_APRs\START2\ Baldwinville_Residential_Grids2004.apr		FIGURE 2

REPORTED RESULTS ARE FOR AROCLOR
 1254 AND ARE REPORTED IN MG/KG.
 MG/KG = PARTS PER MILLION (PPM).
 U = VALUE IS NON-DETECTED.
 J = VALUE IS ESTIMATED.

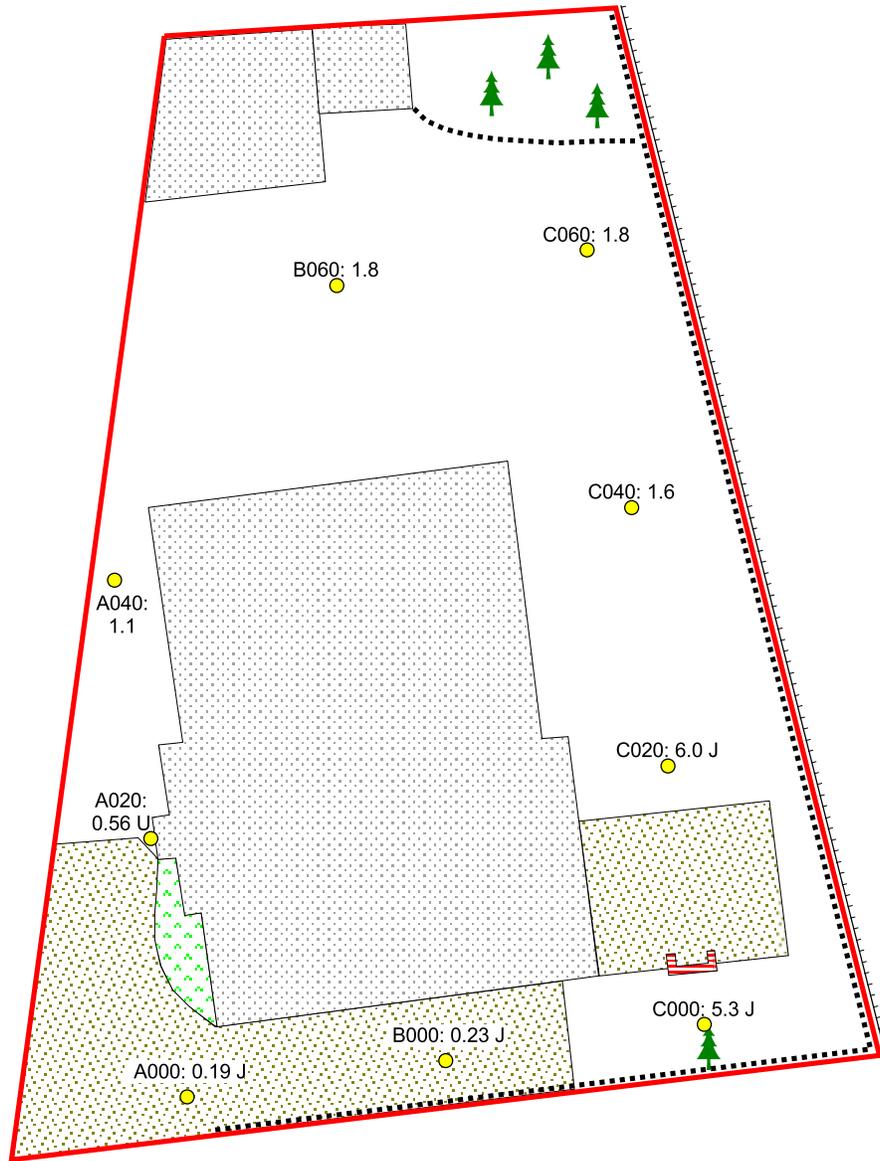

- SAMPLE LOCATION R076
- TREE
- SLOPE FENCE
- PROPERTY BOUNDARY
- BUILDING
- FIRE PIT
- GRAVEL AREA
- FLOWER BED



NOT TO SCALE

SITE DIAGRAM


BALDWINVILLE RESIDENTIAL PROPERTIES
 R-076
 BALDWINVILLE, MASSACHUSETTS



REGION I SUPERFUND TECHNICAL ASSESSMENT AND RESPONSE TEAM

TDD NUMBER: 05-07-0008	CREATED BY: D. MUZRALL	CREATED ON: 12/23/2004
FILE LOCATION: E:\ARC_APRs\START2\ Baldwinville_Residential_Grids2004.apr		FIGURE 2

REPORTED RESULTS ARE FOR AROCLOR
 1254 AND ARE REPORTED IN MG/KG.
 MG/KG = PARTS PER MILLION (PPM).
 J = VALUE IS ESTIMATED.

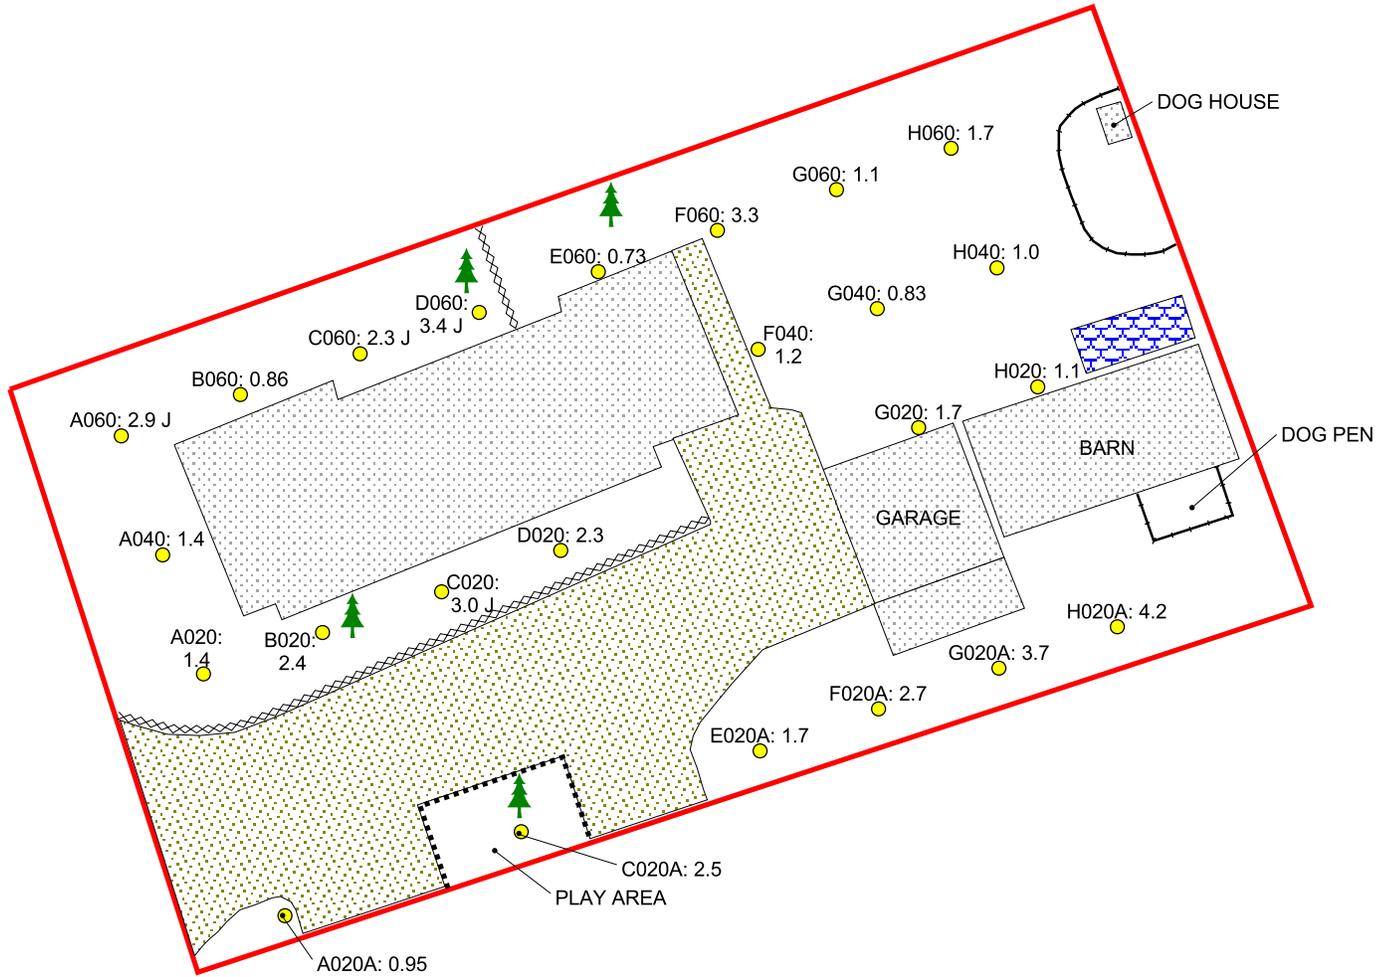

- SAMPLE LOCATION R077
- TREE
- RETAINING WALL
- FENCE
- DOG PEN
- PAVED AREA
- BUILDING
- RV
- PROPERTY BOUNDARY



NOT TO SCALE

SITE DIAGRAM

BALDWINVILLE RESIDENTIAL PROPERTIES
 R-077
 BALDWINVILLE, MASSACHUSETTS




REGION I SUPERFUND TECHNICAL ASSESSMENT AND RESPONSE TEAM

TDD NUMBER: 05-07-0008	CREATED BY: D. MUZRALL	CREATED ON: 12/28/2004
---------------------------	---------------------------	---------------------------

FILE LOCATION:
 E:\ARC_APRs\START2\
 Baldwinville_Residential_Grids2004.apr

FIGURE 2

REPORTED RESULTS ARE FOR AROCLOR
 1254 AND ARE REPORTED IN MG/KG.
 MG/KG = PARTS PER MILLION (PPM).
 J = VALUE IS ESTIMATED.

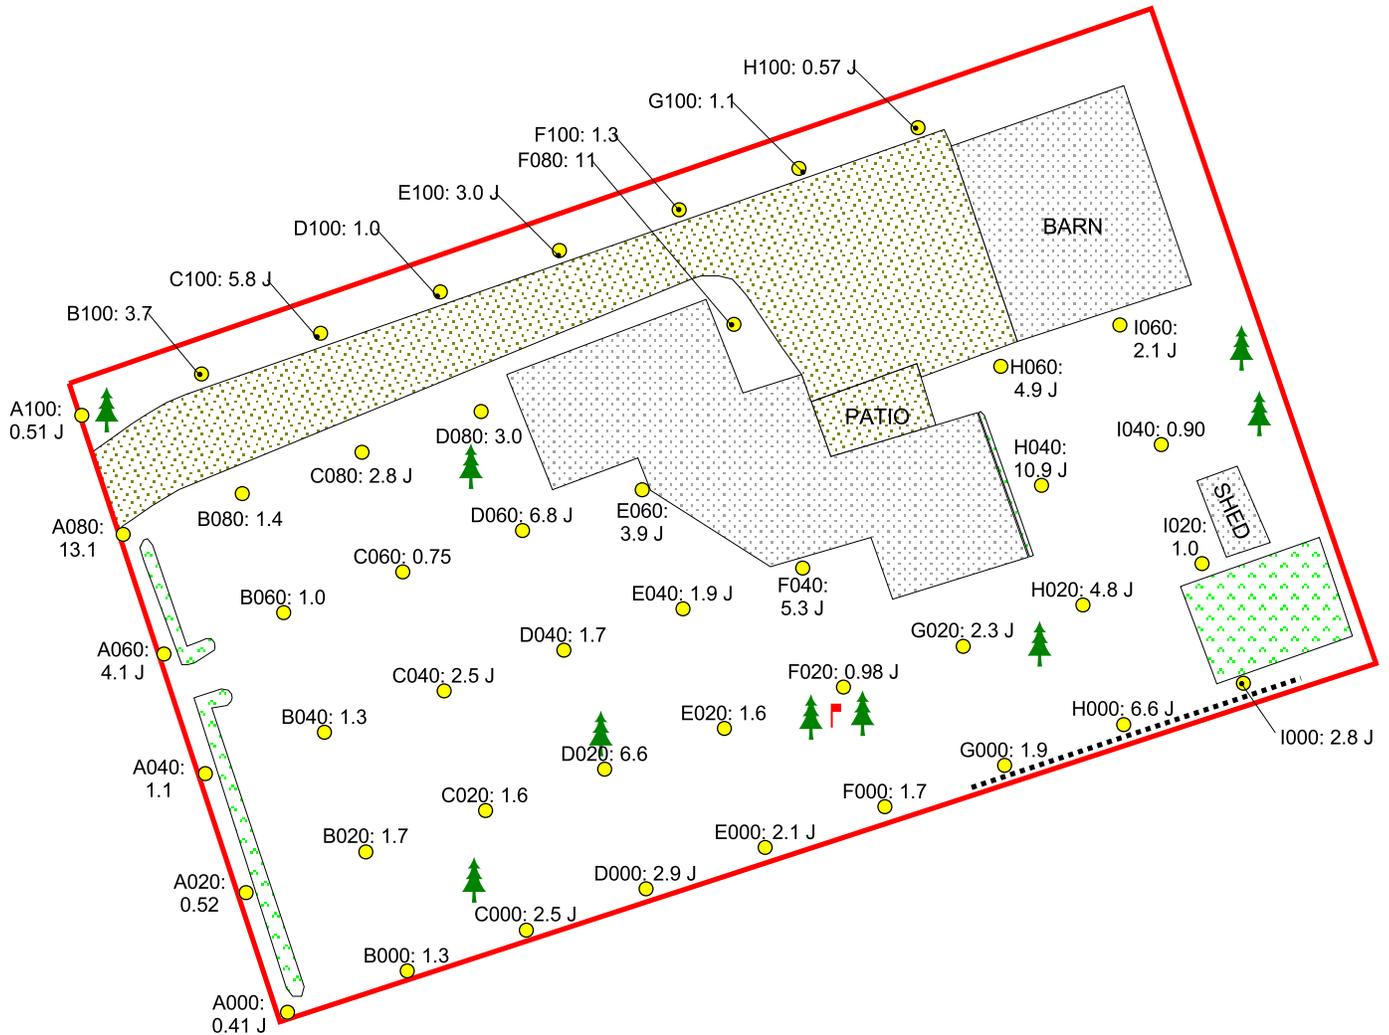

- SAMPLE LOCATION
- R078
 - TREE
 - FLAG POLE
 - FENCE
 - PROPERTY BOUNDARY
 - BUSHES
 - GARDEN
 - BUILDING
 - PAVED AREA



NOT TO SCALE

SITE DIAGRAM


BALDWINVILLE RESIDENTIAL PROPERTIES
 R-078
 BALDWINVILLE, MASSACHUSETTS



REGION I SUPERFUND TECHNICAL ASSESSMENT AND RESPONSE TEAM

TDD NUMBER: 05-07-0008	CREATED BY: D. MUZRALL	CREATED ON: 12/28/2004
FILE LOCATION: E:\ARC_APRs\START2\ Baldwinville_Residential_Grids2004.apr		FIGURE 2

REPORTED RESULTS ARE FOR AROCLOR
 1254 AND ARE REPORTED IN MG/KG.
 MG/KG = PARTS PER MILLION (PPM).
 J = VALUE IS ESTIMATED.

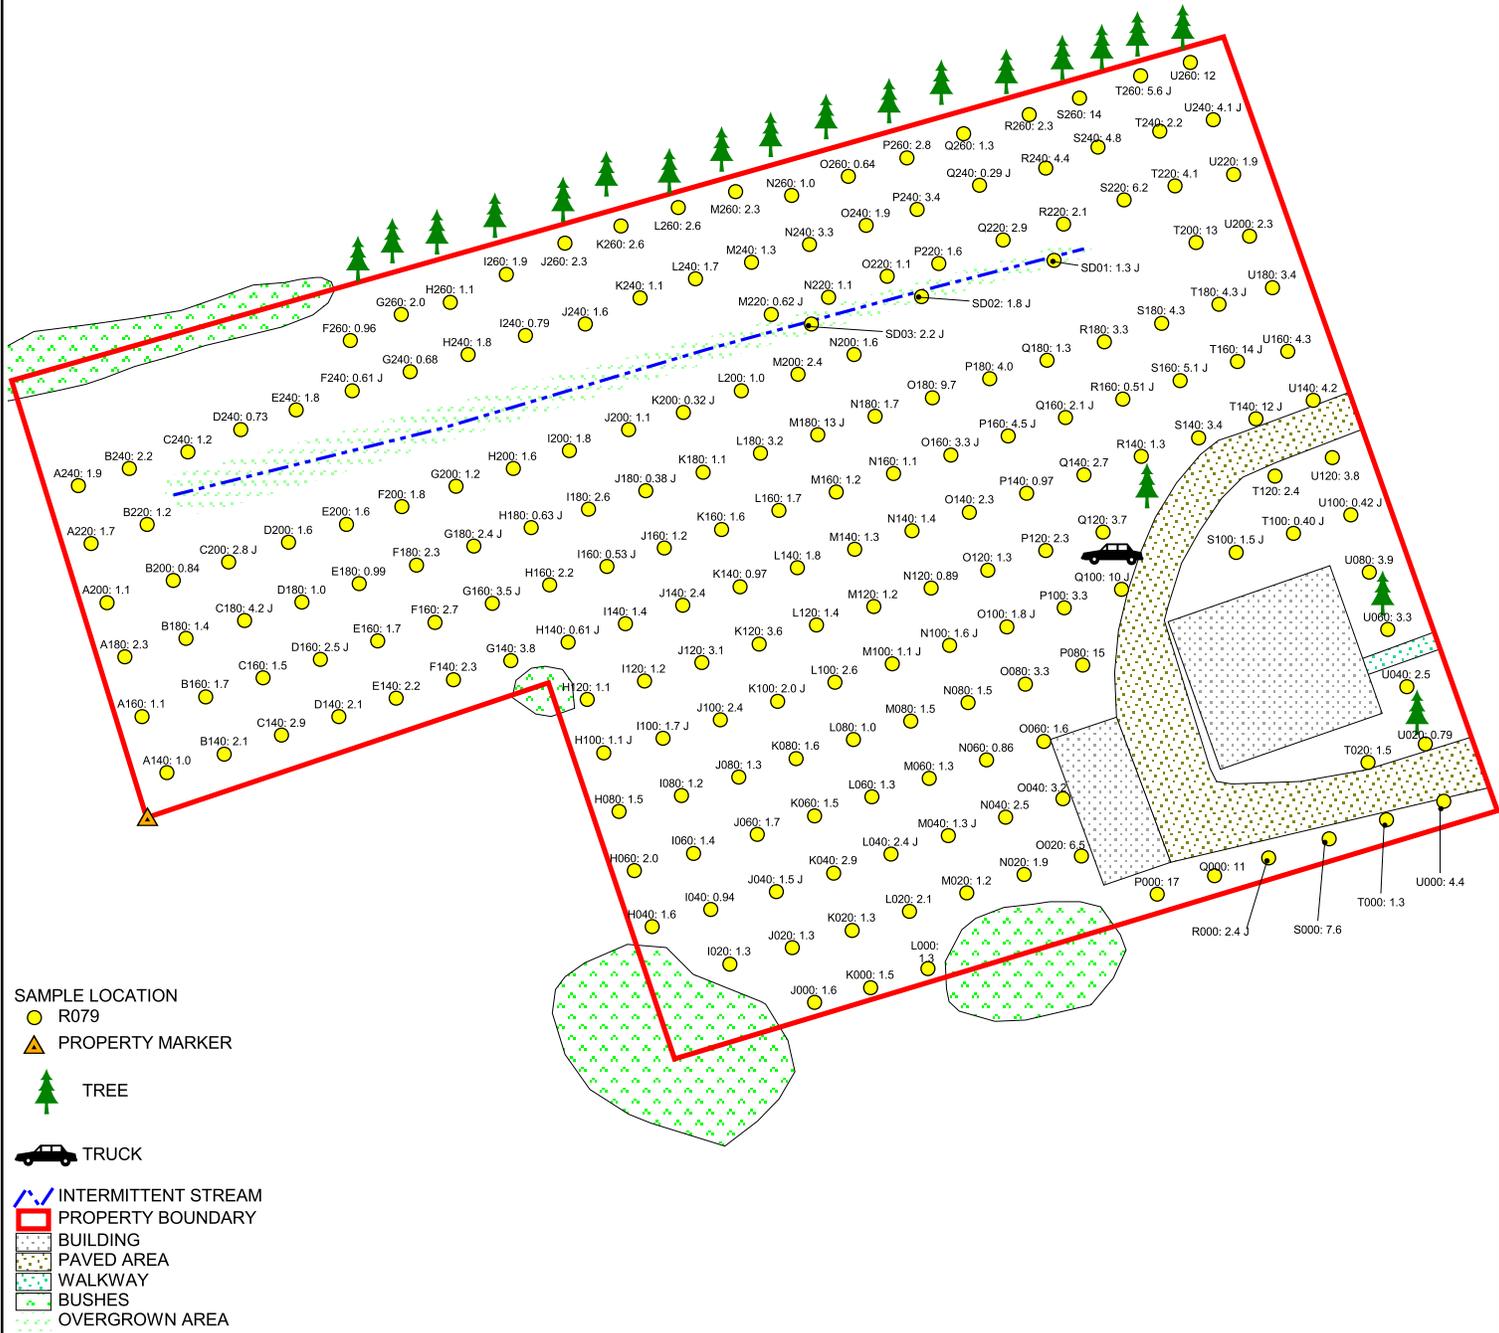

- SAMPLE LOCATION
- R079
- PROPERTY MARKER
- TREE
- TRUCK
- INTERMITTENT STREAM
- PROPERTY BOUNDARY
- BUILDING
- PAVED AREA
- WALKWAY
- BUSHES
- OVERGROWN AREA

40 0 40 80 120 160 200 Feet

NOT TO SCALE

SITE DIAGRAM


BALDWINVILLE RESIDENTIAL PROPERTIES
 R-079
 BALDWINVILLE, MASSACHUSETTS



REGION I SUPERFUND TECHNICAL ASSESSMENT AND RESPONSE TEAM

TDD NUMBER: 05-07-0008	CREATED BY: D. MUZRALL	CREATED ON: 12/30/2004
FILE LOCATION: E:\ARC_APRs\START2\ Baldwinville_Residential_Grids2004.apr		FIGURE 2

REPORTED RESULTS ARE FOR AROCLOR
 1254 AND ARE REPORTED IN MG/KG.
 MG/KG = PARTS PER MILLION (PPM).
 J = VALUE IS ESTIMATED.
 NOT TO SCALE

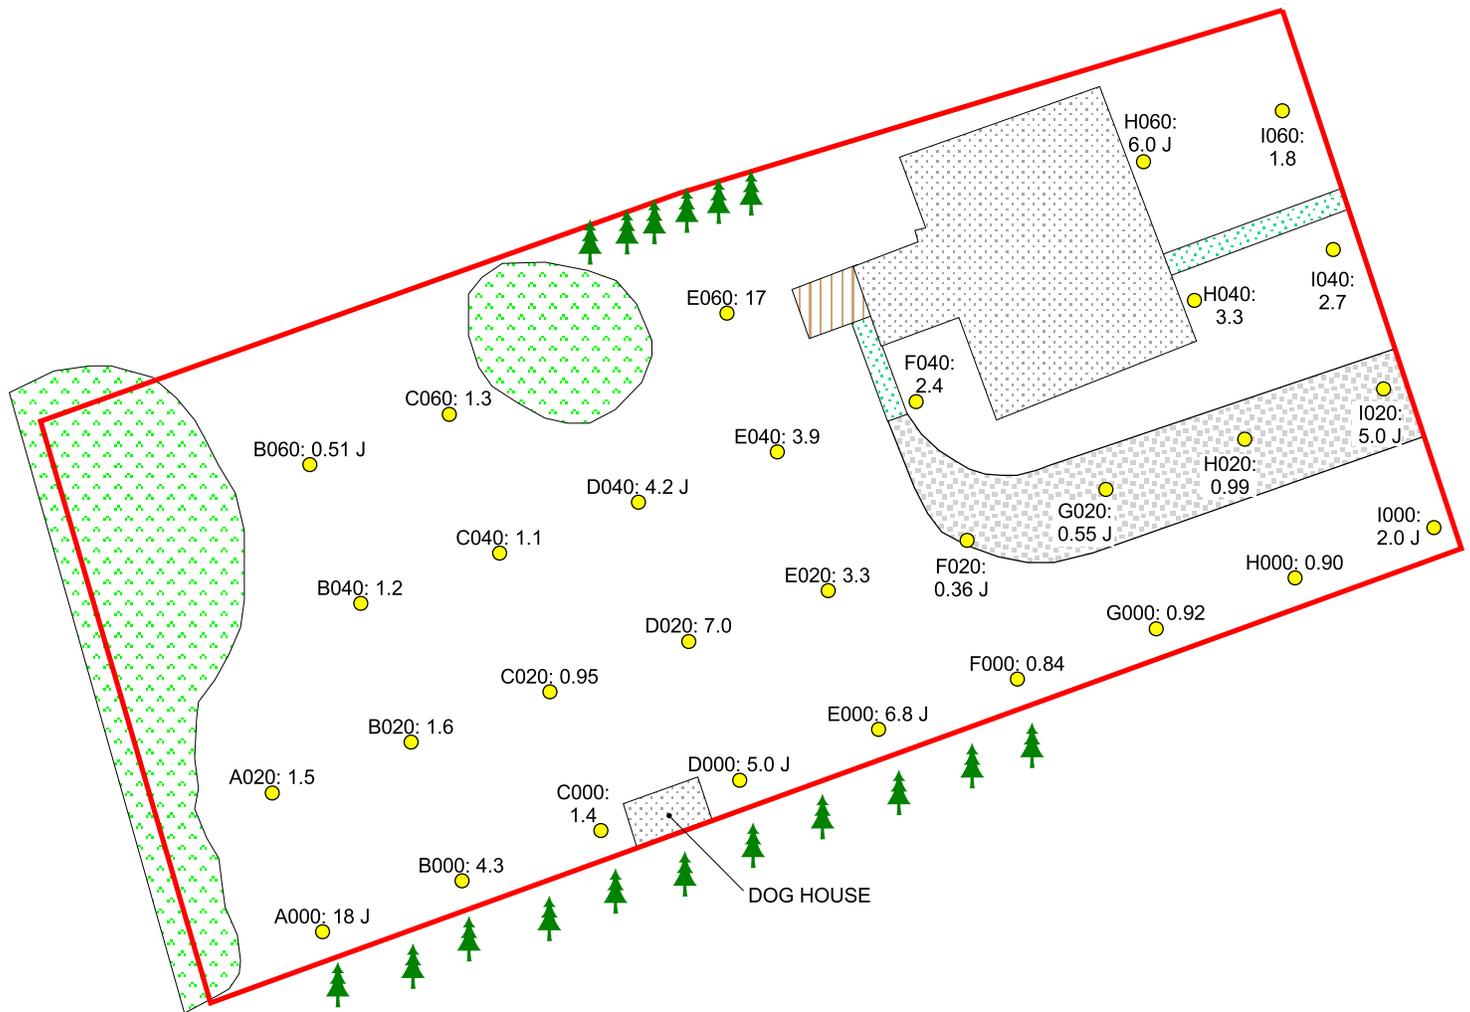

- SAMPLE LOCATION
- R080
 - ▲ TREE
 - PROPERTY BOUNDARY
 - BUILDING
 - PORCH
 - BUSHES
 - WALKWAY
 - GRAVEL DRIVEWAY



SITE DIAGRAM


BALDWINVILLE RESIDENTIAL PROPERTIES
 R-080
 BALDWINVILLE, MASSACHUSETTS



REGION I SUPERFUND TECHNICAL ASSESSMENT AND RESPONSE TEAM

TDD NUMBER: 05-07-0008	CREATED BY: D. MUZRALL	CREATED ON: 12/29/2004
FILE LOCATION: E:\ARC_APRs\START2\ Baldwinville_Residential_Grids2004.apr		FIGURE 2

REPORTED RESULTS ARE FOR AROCLOR
 1254 AND ARE REPORTED IN MG/KG.
 MG/KG = PARTS PER MILLION (PPM).
 J = VALUE IS ESTIMATED.

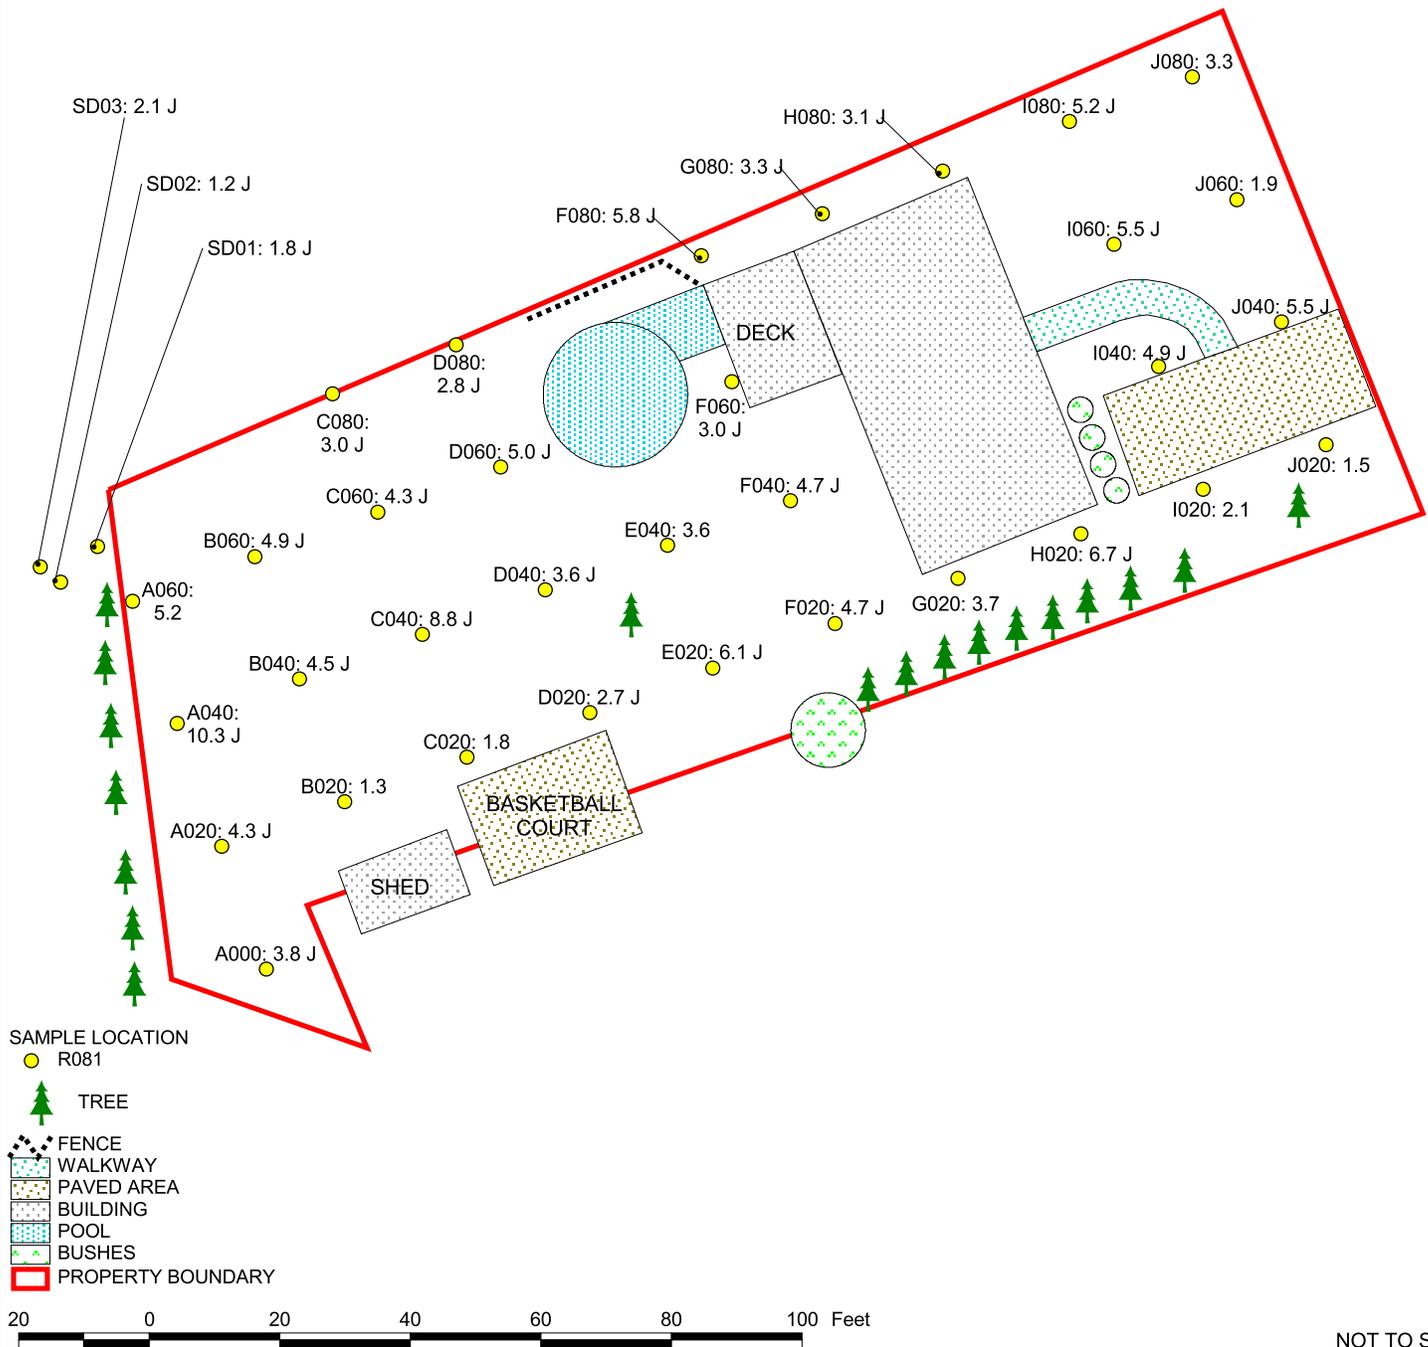

SITE DIAGRAM


BALDWINVILLE RESIDENTIAL PROPERTIES
 R-081
 BALDWINVILLE, MASSACHUSETTS



REGION I SUPERFUND TECHNICAL ASSESSMENT AND RESPONSE TEAM

TDD NUMBER: 05-07-0008	CREATED BY: D. MUZRALL	CREATED ON: 12/28/2004
FILE LOCATION: E:\ARC_APRs\START2\ Baldwinville_Residential_Grids2004.apr		FIGURE 2

REPORTED RESULTS ARE FOR AROCLOR
 1254 AND ARE REPORTED IN MG/KG.
 MG/KG = PARTS PER MILLION (PPM).
 U = VALUE IS NON-DETECTED.
 J = VALUE IS ESTIMATED.

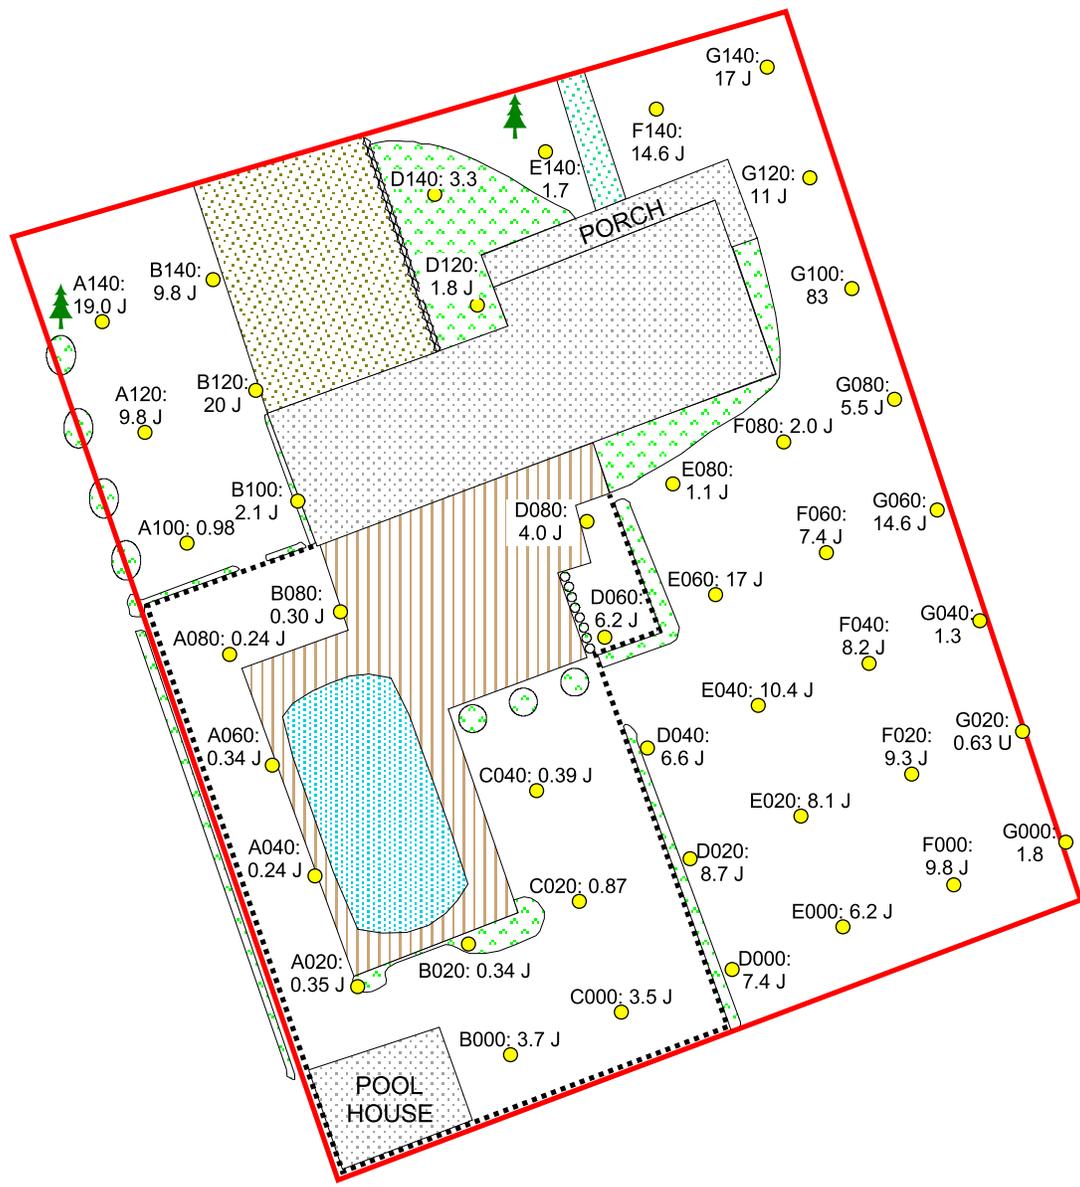

- SAMPLE LOCATION R082
- 🌲 TREE
- ⚡ FENCE
- ▭ PROPERTY BOUNDARY
- ▭ RETAINING WALL
- ▭ PAVED AREA
- ▭ WALKWAY
- ▭ BUILDING
- ▭ GARDEN
- ▭ POOL
- ▭ DECK



NOT TO SCALE

SITE DIAGRAM


BALDWINVILLE RESIDENTIAL PROPERTIES
 R-082
 BALDWINVILLE, MASSACHUSETTS



REGION I SUPERFUND TECHNICAL ASSESSMENT AND RESPONSE TEAM

TDD NUMBER: 05-07-0008	CREATED BY: D. MUZRALL	CREATED ON: 12/29/2004
FILE LOCATION: E:\ARC_APRs\START2\ Baldwinville_Residential_Grids2004.apr		FIGURE 2

REPORTED RESULTS ARE FOR AROCLOR
 1254 AND ARE REPORTED IN MG/KG.
 MG/KG = PARTS PER MILLION (PPM).
 U = VALUE IS NON-DETECTED.
 J = VALUE IS ESTIMATED.

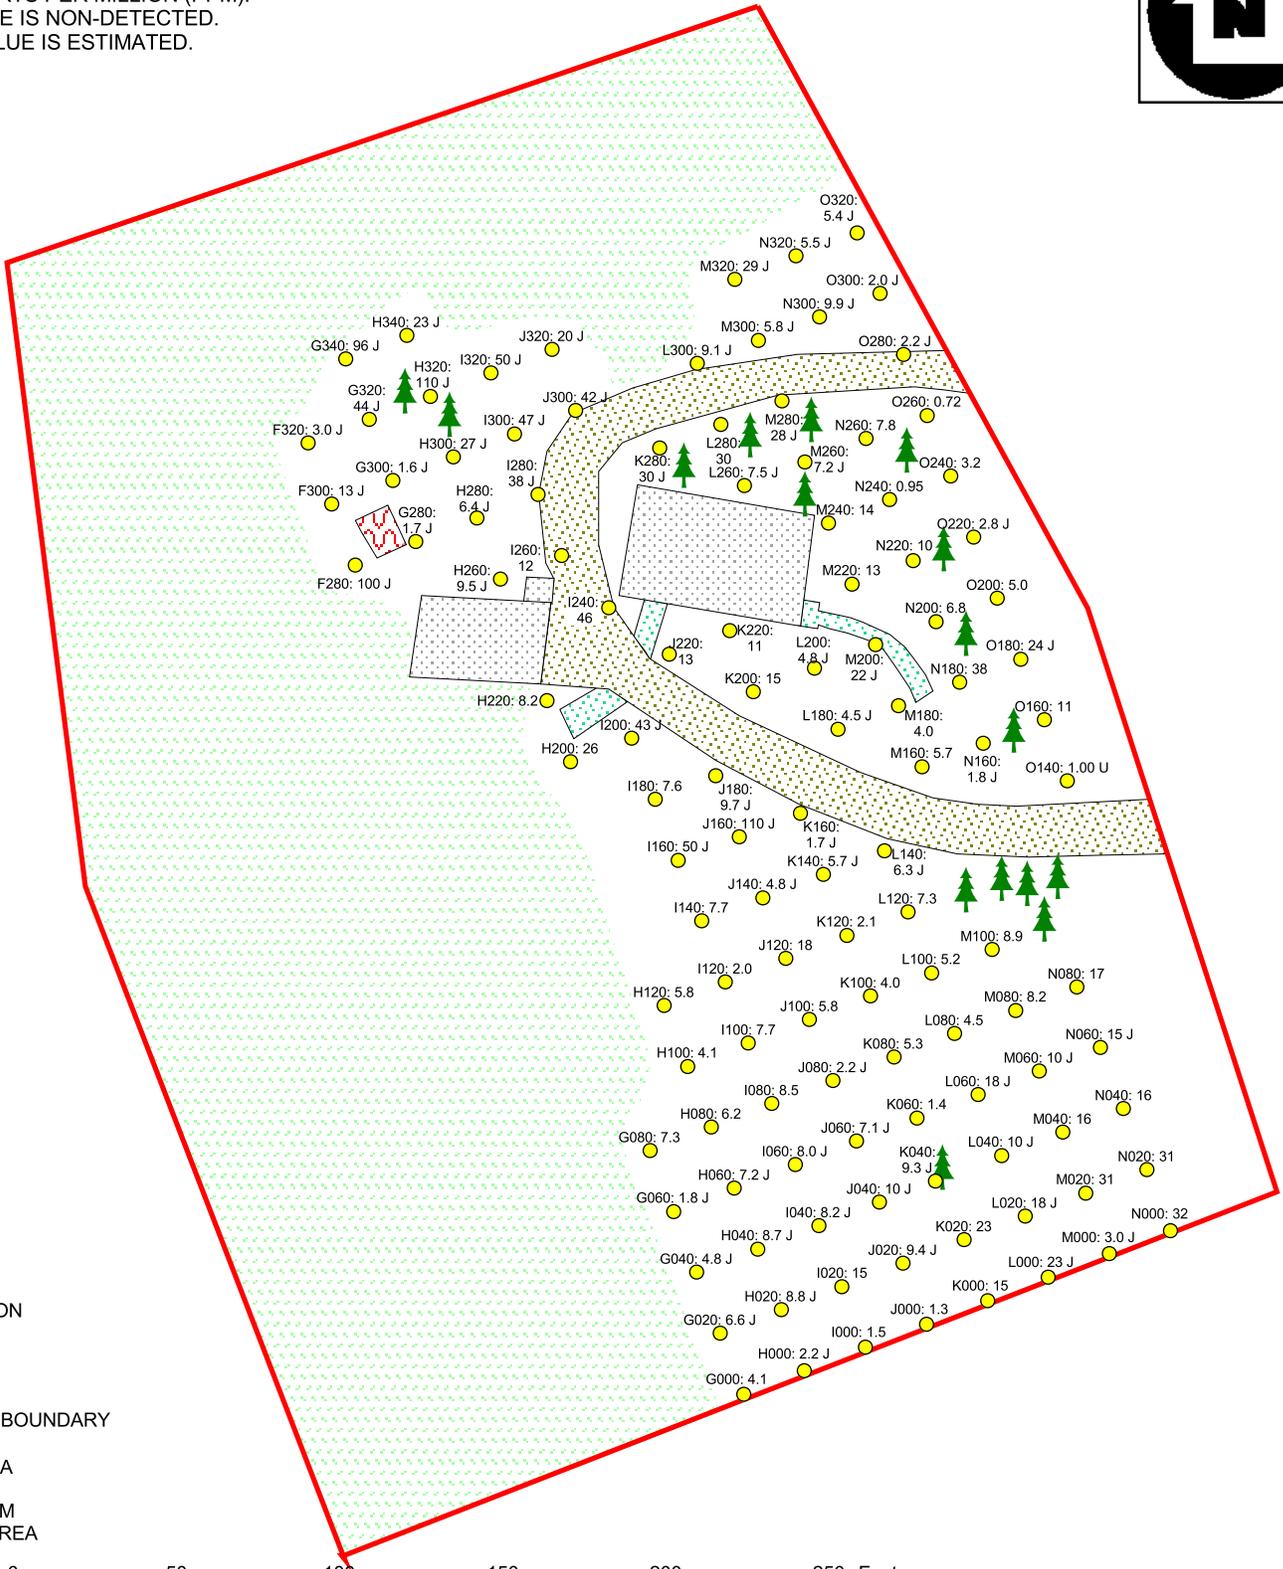

- SAMPLE LOCATION
- R083
- 🌲 TREE
- ▭ PROPERTY BOUNDARY
- ▭ BUILDING
- ▭ PAVED AREA
- ▭ WALKWAY
- ▭ JUNGLE GYM
- ▭ WOODED AREA



NOT TO SCALE

SITE DIAGRAM


BALDWINVILLE RESIDENTIAL PROPERTIES
 R-083A
 BALDWINVILLE, MASSACHUSETTS



REGION I SUPERFUND TECHNICAL ASSESSMENT AND RESPONSE TEAM

TDD NUMBER: 05-07-0008	CREATED BY: D. MUZRALL	CREATED ON: 12/30/2004
FILE LOCATION: E:\ARC_APRs\START2\ Baldwinville_Residential_Grids2004.apr		FIGURE 2

REPORTED RESULTS ARE FOR AROCLOR
1254 AND ARE REPORTED IN MG/KG.
MG/KG = PARTS PER MILLION (PPM).

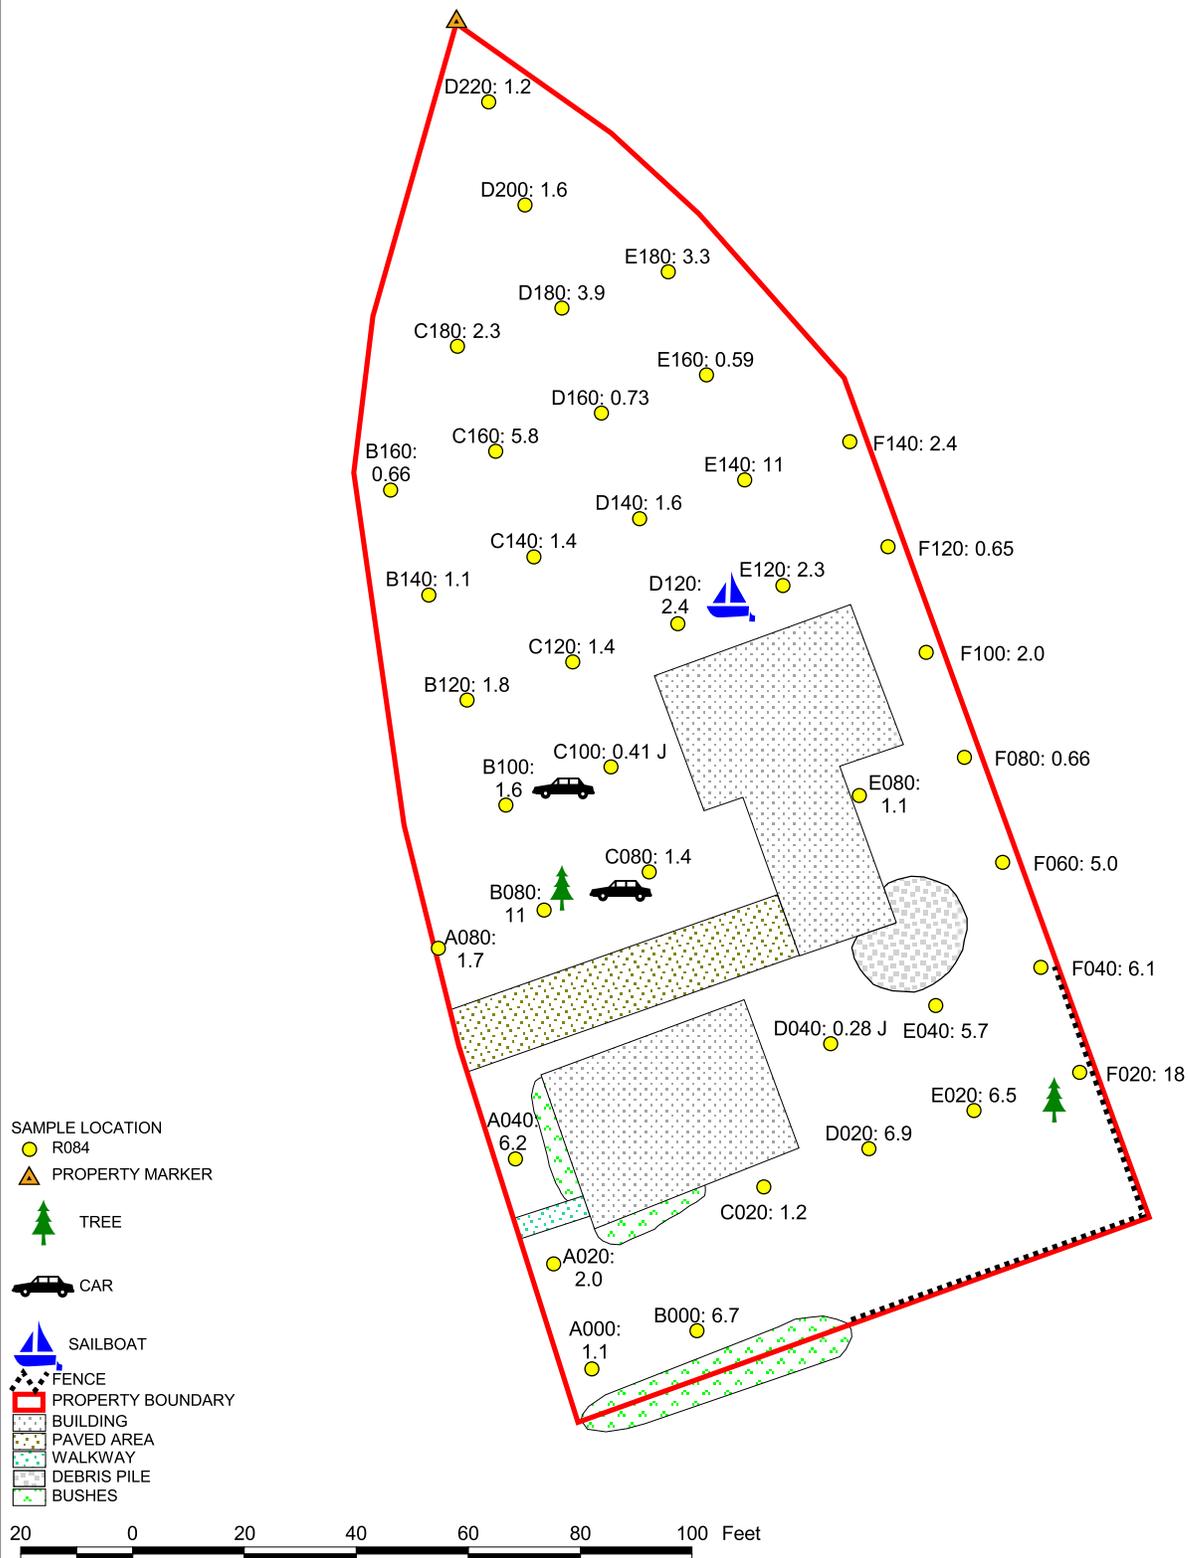

SITE DIAGRAM

BALDWINVILLE RESIDENTIAL PROPERTIES
R-084
BALDWINVILLE, MASSACHUSETTS



REGION I SUPERFUND TECHNICAL ASSESSMENT AND RESPONSE TEAM


TDD NUMBER: 05-07-0008	CREATED BY: D. MUZRALL	CREATED ON: 12/29/2004
---------------------------	---------------------------	---------------------------

FILE LOCATION:
E:\ARC_APRs\START2\
Baldwinville_Residential_Grids2004.apr

FIGURE 2

NOT TO SCALE

REPORTED RESULTS ARE FOR AROCLOR
 1254 AND ARE REPORTED IN MG/KG.
 MG/KG = PARTS PER MILLION (PPM).
 J = VALUE IS ESTIMATED.

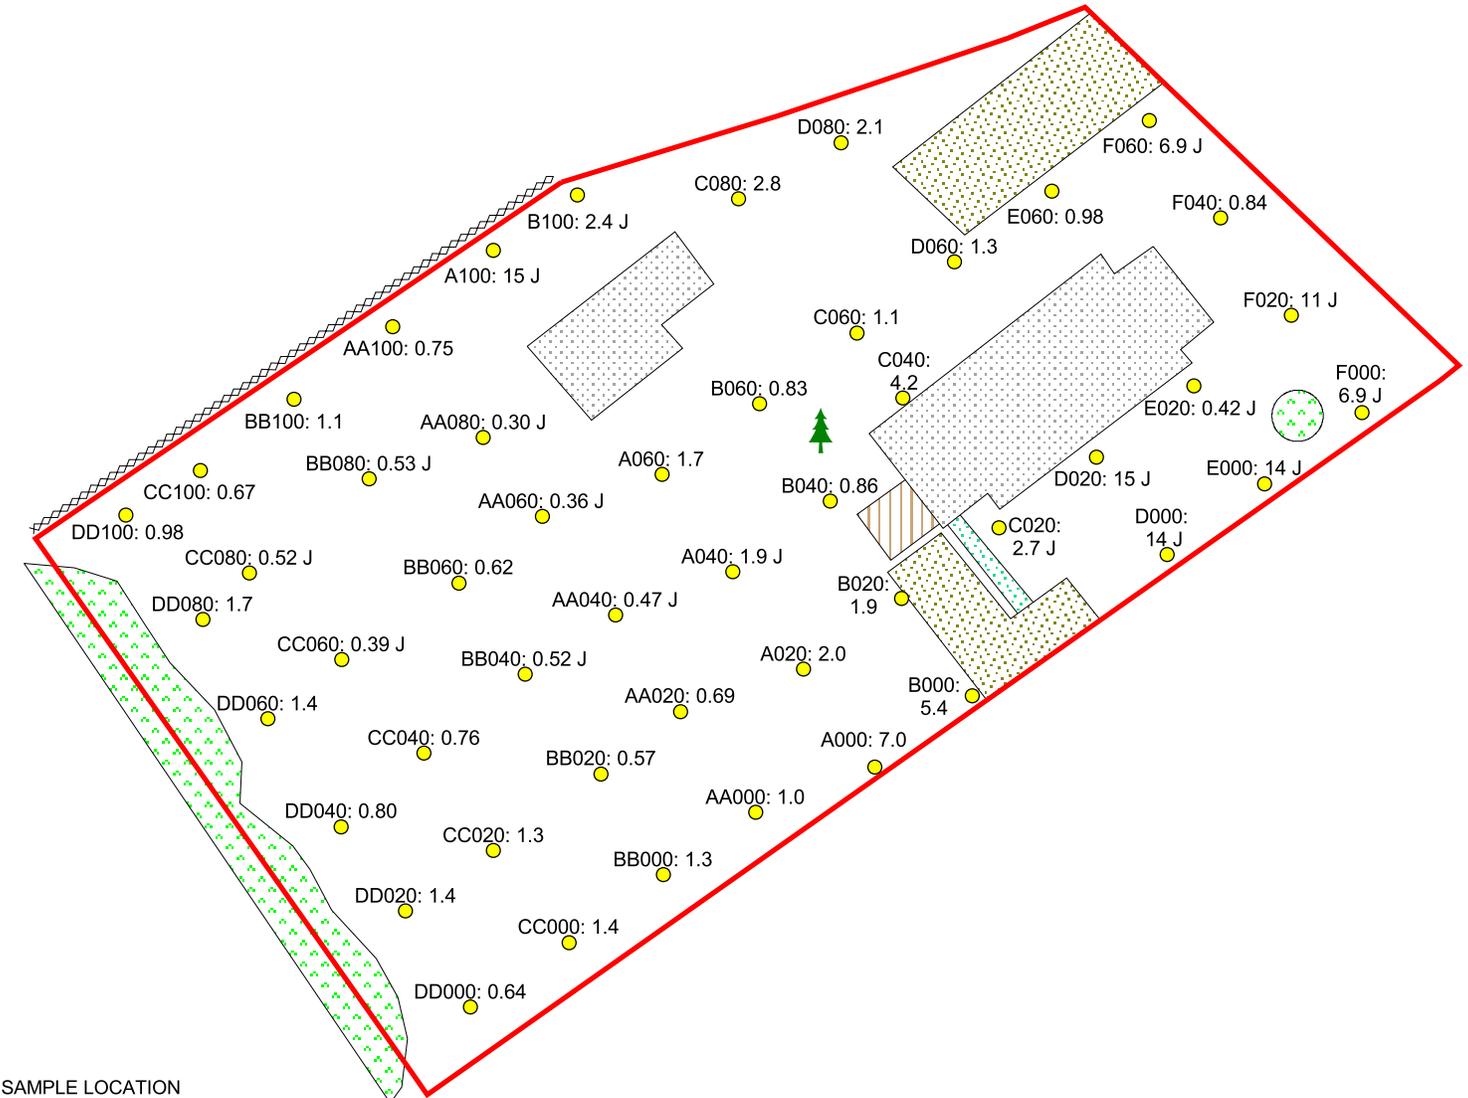

- SAMPLE LOCATION R085
- TREE
- RETAINING WALL
- PROPERTY BOUNDARY
- BUILDING
- DECK
- PAVED AREA
- WALKWAY
- BUSHES



NOT TO SCALE

SITE DIAGRAM

BALDWINVILLE RESIDENTIAL PROPERTIES
 R-085
 BALDWINVILLE, MASSACHUSETTS





REGION I SUPERFUND TECHNICAL ASSESSMENT AND RESPONSE TEAM

TDD NUMBER: 05-07-0008	CREATED BY: D. MUZRALL	CREATED ON: 12/29/2004
FILE LOCATION: E:\ARC_APRs\START2\ Baldwinville_Residential_Grids2004.apr		FIGURE 2


Section 3 - Phase III PA/SI Diagrams

Reported results are for AROCLOR 1254
 and are reported in mg/kg.
 mg/kg = parts per million (PPM).

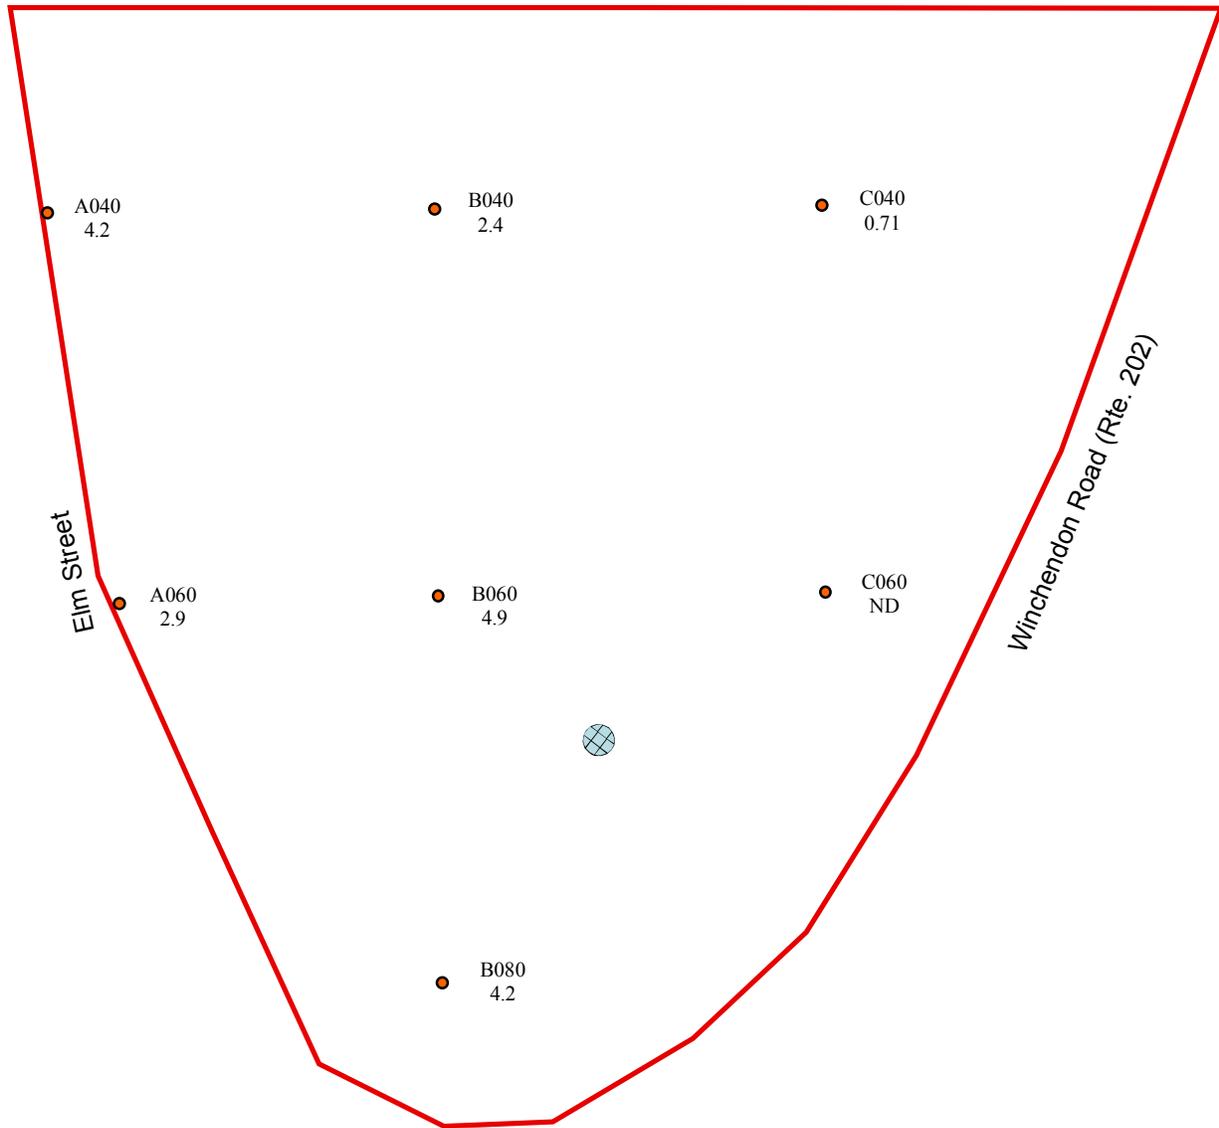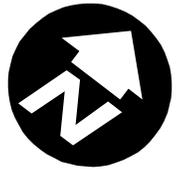

Not To Scale

Legend

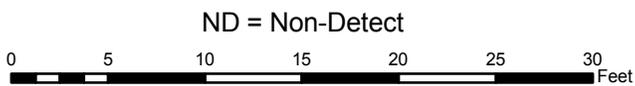

ND = Non-Detect

- Sample Location
- ⊗ Catch Basin
- Property Boundary

SITE DIAGRAM

BALDWINVILLE RESIDENTIAL PROPERTIES
 R-090
 BALDWINVILLE, MASSACHUSETTS




REGION I SUPERFUND TECHNICAL ASSESSMENT AND RESPONSE TEAM

TDD NUMBER: 05-10-0004	CREATED BY: D. MUZRALL	CREATED ON: 3/8/2006
FILE LOCATION: E:\MA_GIS\BRP_Phase3\MXD\I090.MXD		FIGURE 2

Reported results are for AROCLOR 1254
and are reported in mg/kg.
mg/kg = parts per million (PPM).



Walnut Street

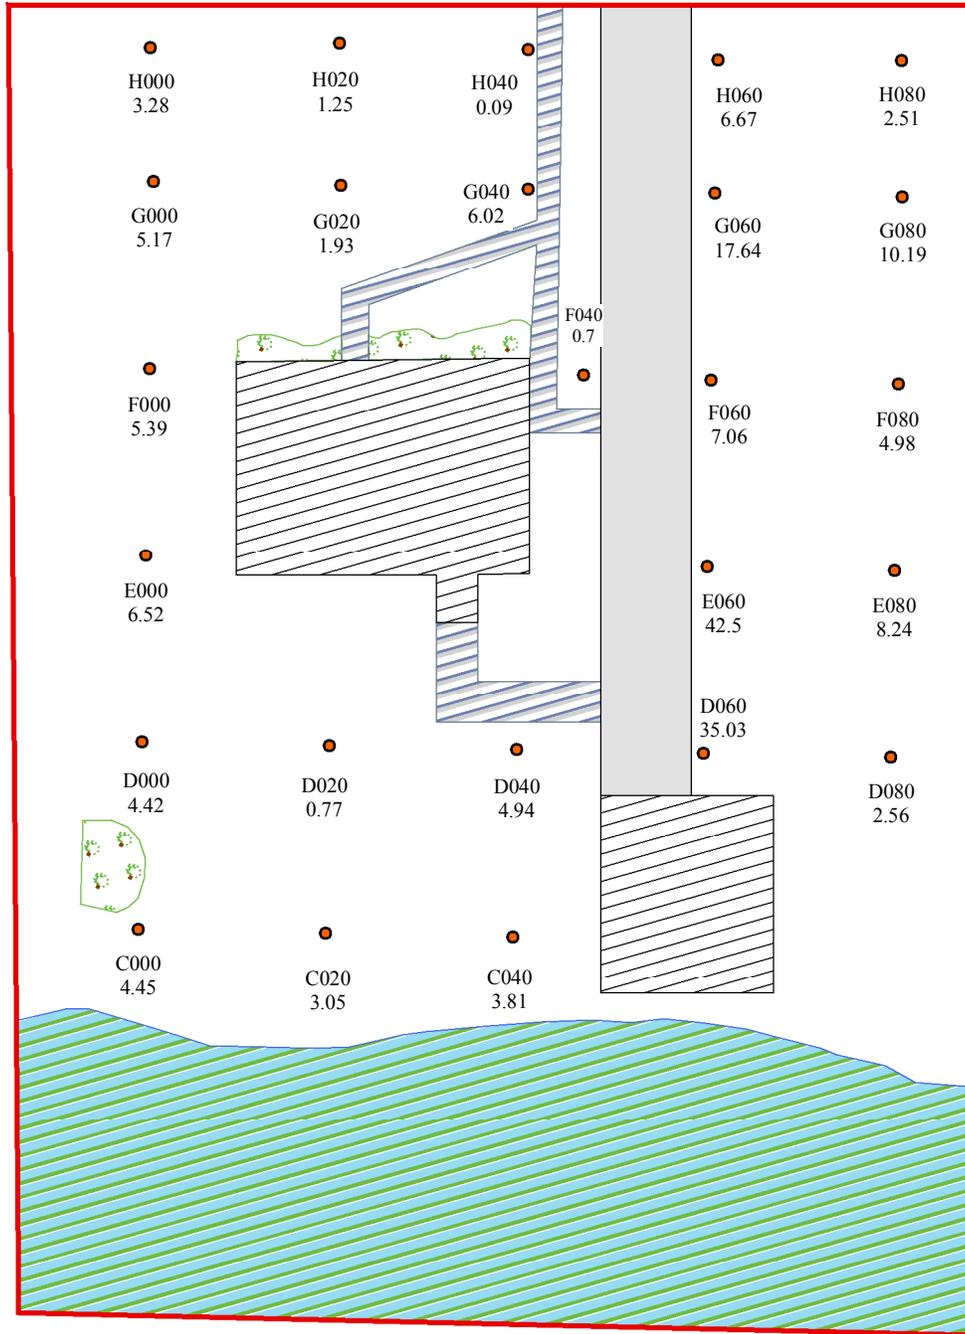


Not To Scale

Legend

- Sample Location
- ▨ Building
- ▨ Wetlands
- ▭ Property Boundary
- 🌿 Garden
- ▨ Paved Walkway
- ▭ Paved Driveway

ND = Non-Detect

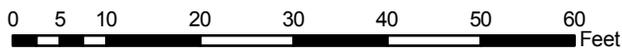

SITE DIAGRAM



BALDWINVILLE RESIDENTIAL PROPERTIES
R-091
BALDWINVILLE, MASSACHUSETTS



REGION I SUPERFUND TECHNICAL ASSESSMENT AND RESPONSE TEAM

TDD NUMBER: 05-10-0004	CREATED BY: D. MUZRALL	CREATED ON: 3/8/2006
FILE LOCATION: E:\MA_GIS\BRP_Phase3\MXD\IR091.MXD		FIGURE 2

Reported results are for AROCLOR 1254
and are reported in mg/kg.
mg/kg = parts per million (PPM).

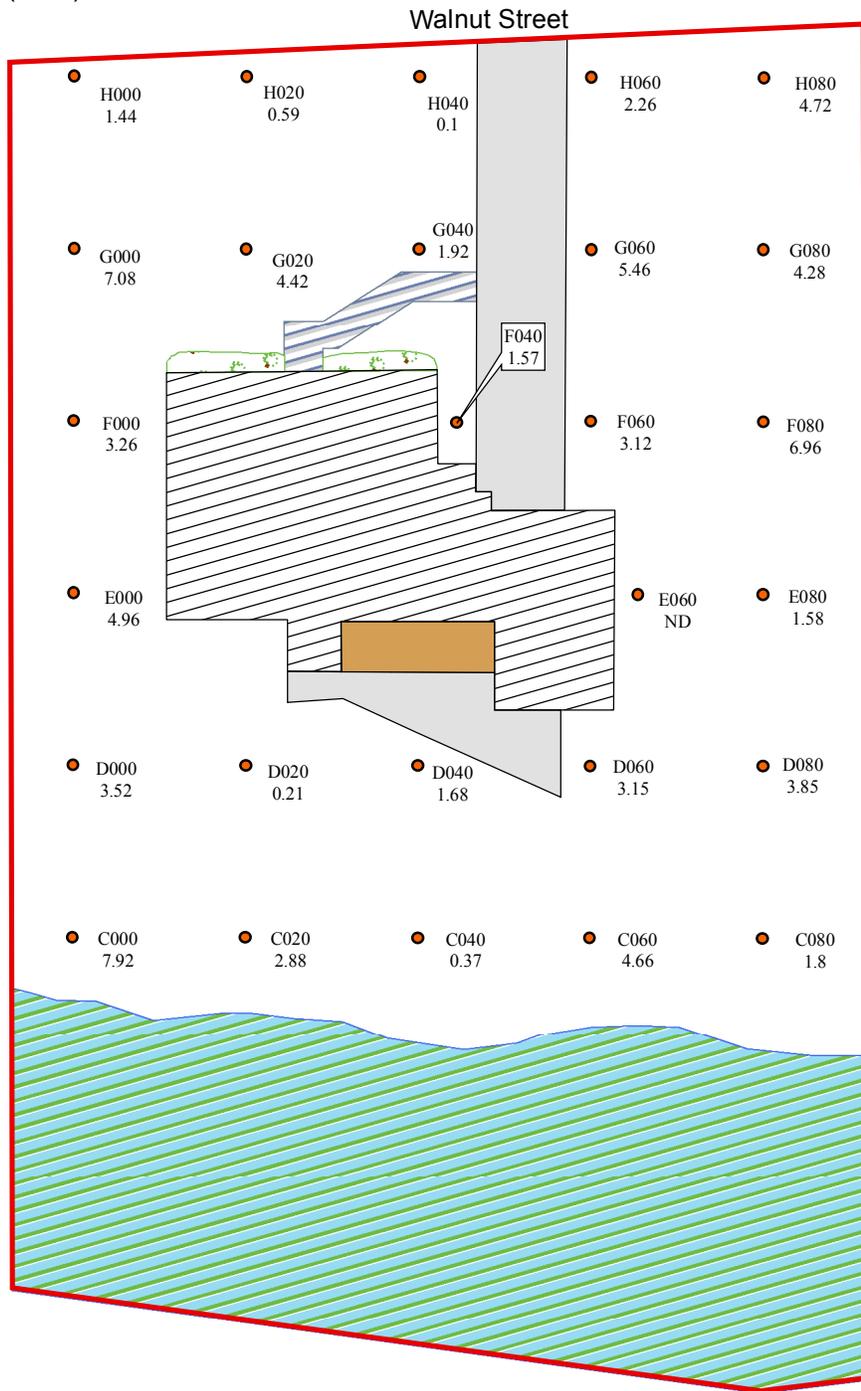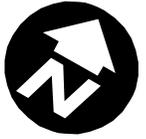

Not To Scale

Legend



- Sample Location
- ▨ Building
- 🌿 Garden
- ▭ Property Boundary
- 🪵 Wood Deck
- 🛤️ Paved Walkway
- 🛤️ Paved Driveway
- 🌊 Wetlands

SITE DIAGRAM



BALDWINVILLE RESIDENTIAL PROPERTIES
R-092
BALDWINVILLE, MASSACHUSETTS



REGION I SUPERFUND TECHNICAL ASSESSMENT AND RESPONSE TEAM

TDD NUMBER: 05-10-0004	CREATED BY: D. MUZRALL	CREATED ON: 3/8/2006
FILE LOCATION: E:\MA_GIS\BRP_Phase3\MXDs\R092.MXD		FIGURE 2

Reported results are for AROCLOR 1254
and are reported in mg/kg.
mg/kg = parts per million (PPM).

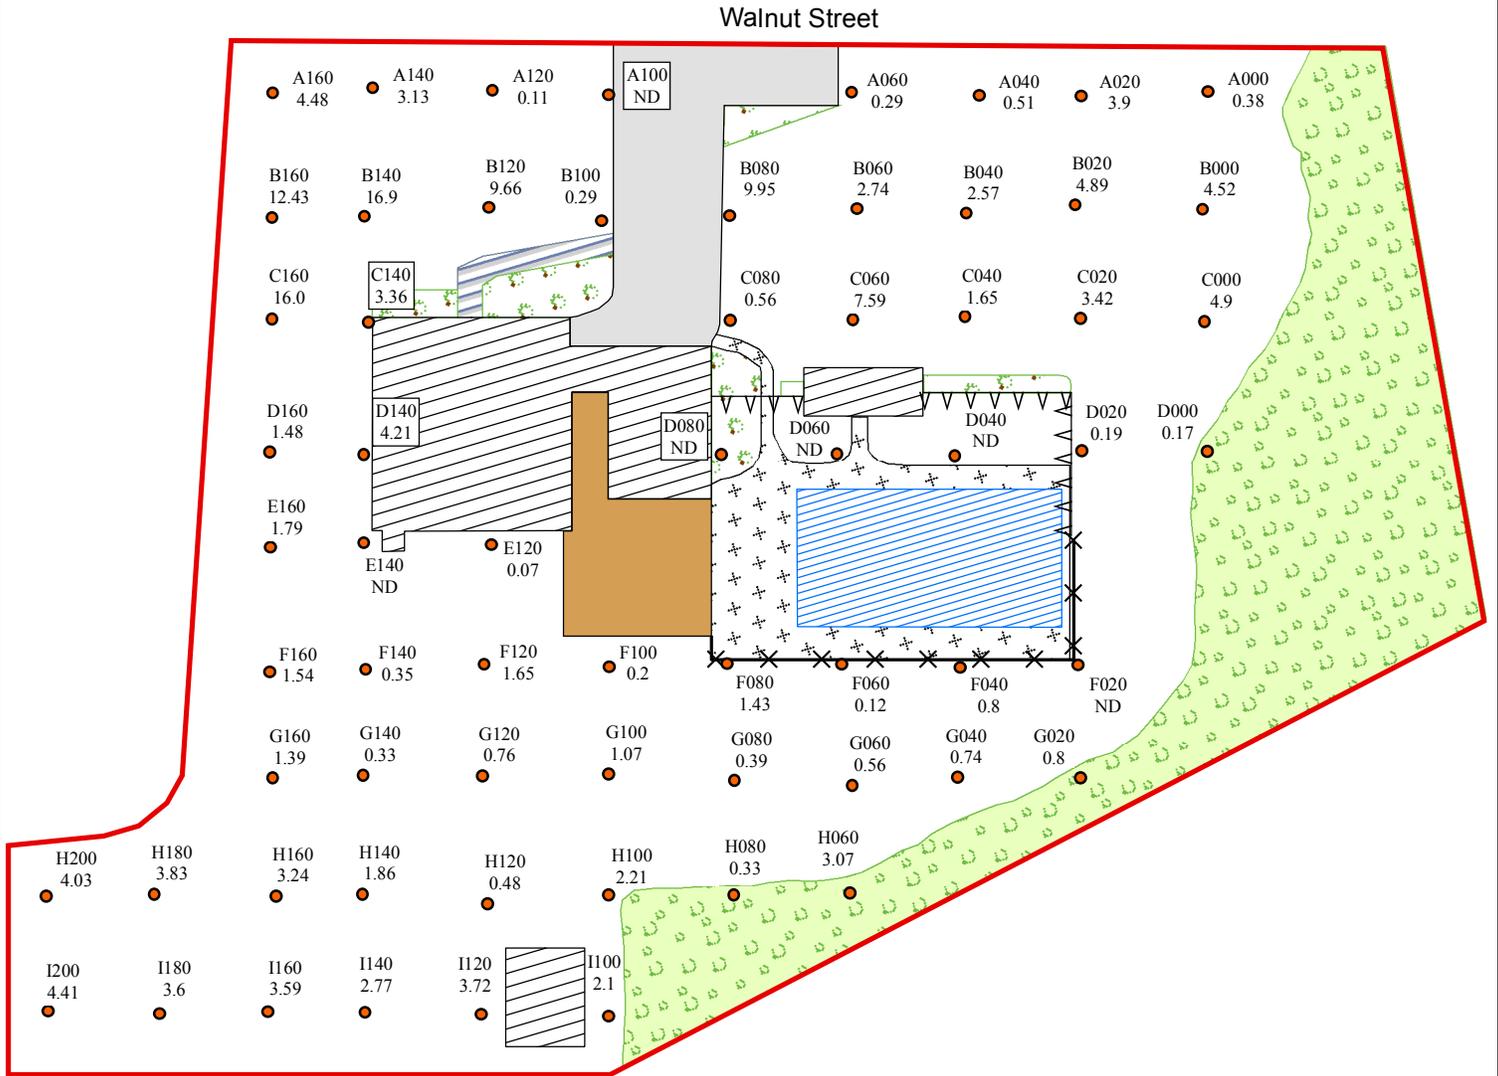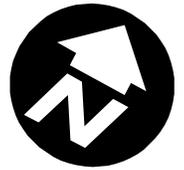

Not To Scale

Legend

ND = Non-Detect

● Sample Location	🌳 Garden	🌲 Wooded Area
▭ Property Boundary	🏊 Pool	🛤 Paved Walkway
▨ Building	⊠ Concrete Patio	⚡ Chain-link Fence
▭ Paved Driveway	🪵 Wood Deck	⚠ Stockade Fence

SITE DIAGRAM

BALDWINVILLE RESIDENTIAL PROPERTIES
R-093
BALDWINVILLE, MASSACHUSETTS




REGION I SUPERFUND TECHNICAL ASSESSMENT AND RESPONSE TEAM

TDD NUMBER: 05-10-0004	CREATED BY: D. MUZRALL	CREATED ON: 3/8/2006
---------------------------	---------------------------	-------------------------

FILE LOCATION: E:\MA_GIS\BRP_Phase3\MXD\IR093.MXD	FIGURE 2
--	----------

Reported results are for AROCLOR 1254
 and are reported in mg/kg.
 mg/kg = parts per million (PPM).

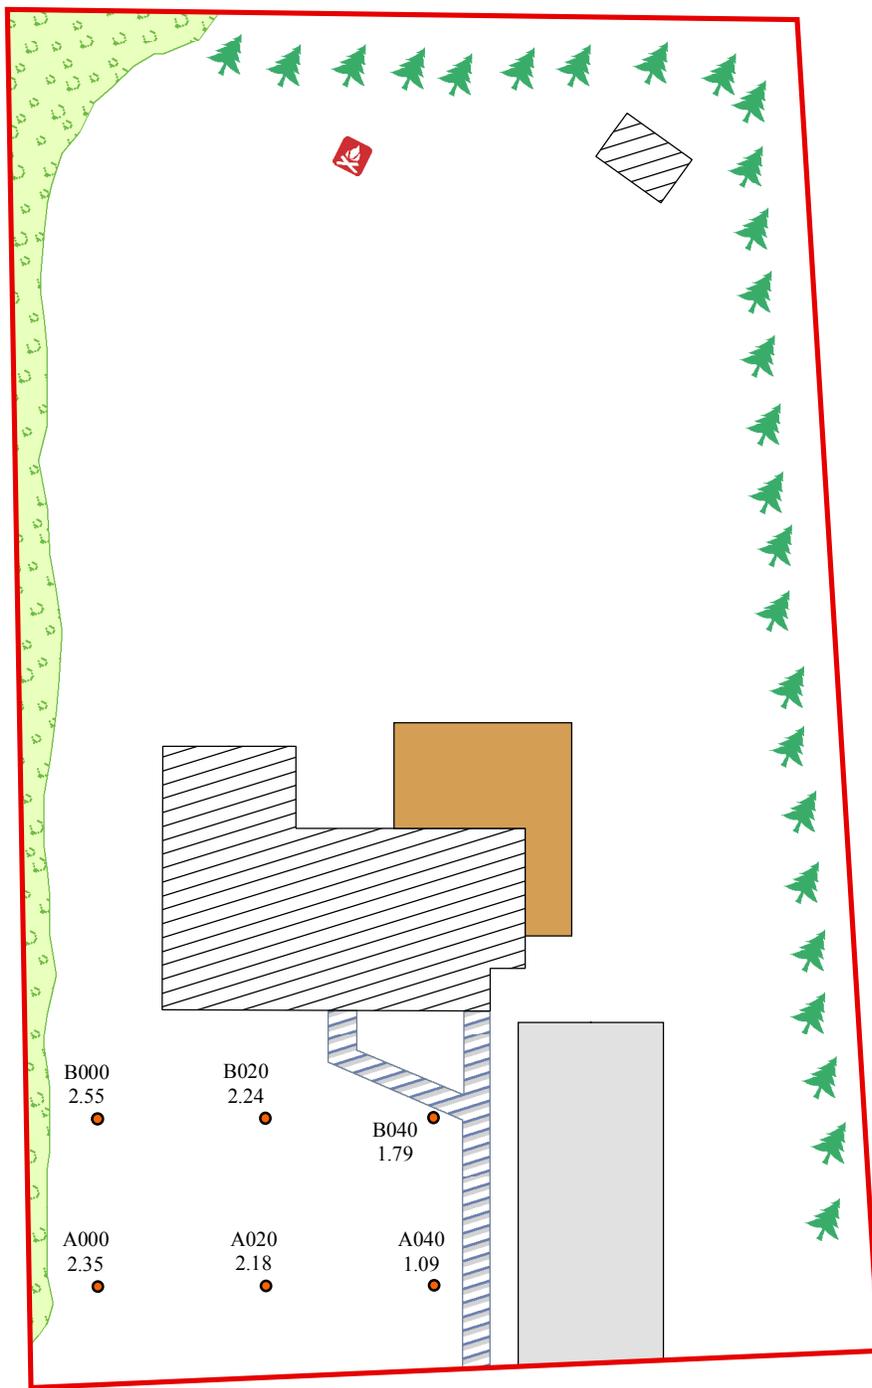

Beech Street

Not To Scale

Legend

- Sample Location
- Wood Deck
- Wooded Area
- Property Boundary
- Paved Driveway
- Paved Walkway
- Building
- Tree
- Fire Pit



SITE DIAGRAM


BALDWINVILLE RESIDENTIAL PROPERTIES
 R-102
 BALDWINVILLE, MASSACHUSETTS



REGION I SUPERFUND TECHNICAL ASSESSMENT AND RESPONSE TEAM

TDD NUMBER: 05-10-0004	CREATED BY: D. MUZRALL	CREATED ON: 3/8/2006
FILE LOCATION: E:\MA_GIS\BRP_Phase3\MXDs\R102.MXD		FIGURE 2

Reported results are for AROCLOR 1254
and are reported in mg/kg.
mg/kg = parts per million (PPM).

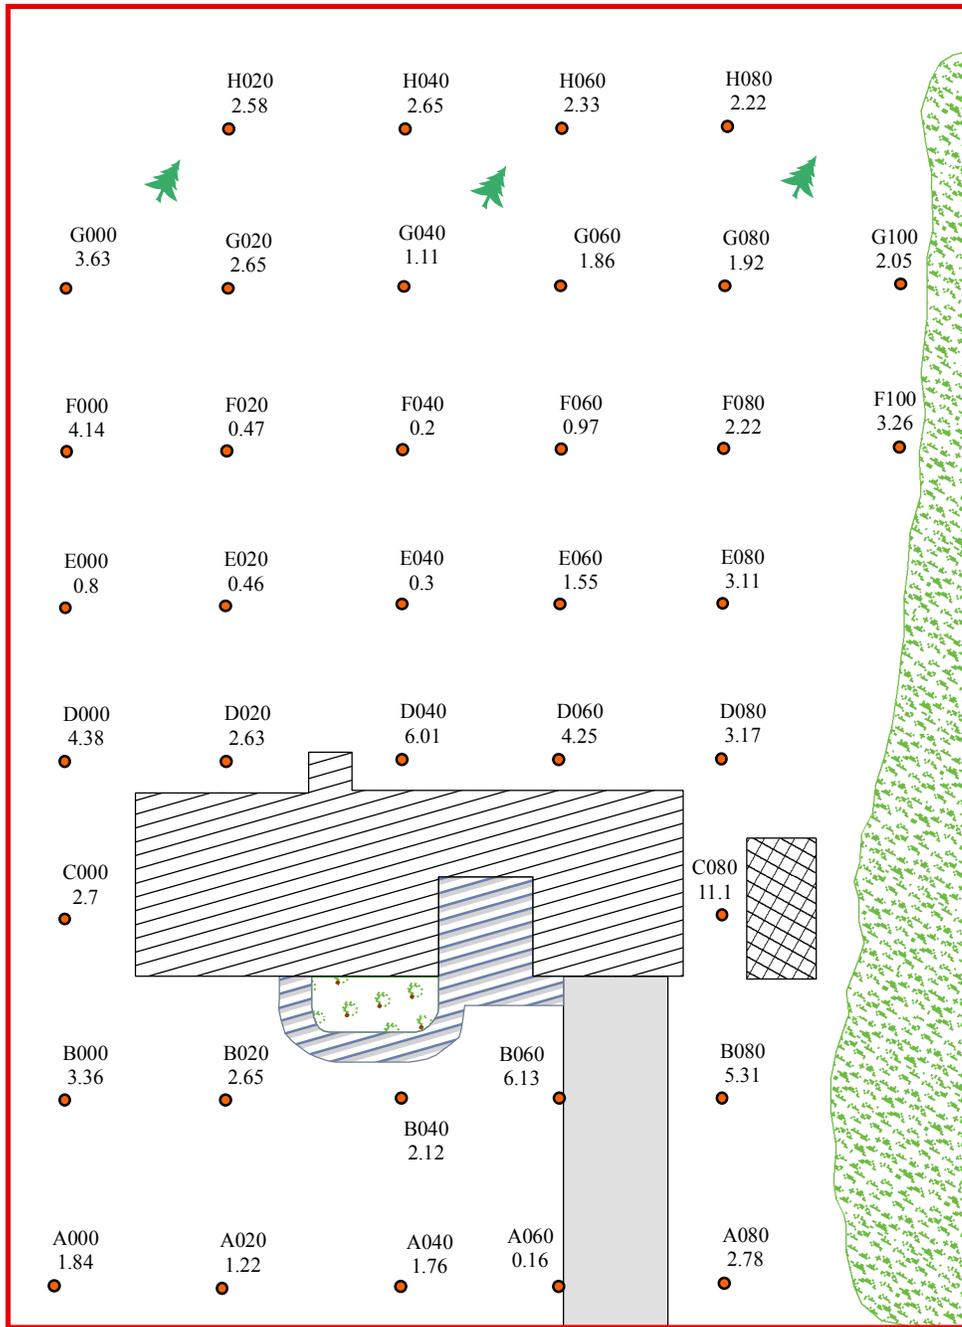

Beech Street

Not To Scale

Legend

- Sample Location
- ▭ Property Boundary
- ▨ Building
- ▨ Garden
- 🌲 Trees
- ▨ Paved Walkway
- ▨ Trailer
- ▨ Paved Driveway
- ▨ Bushes



SITE DIAGRAM



BALDWINVILLE RESIDENTIAL PROPERTIES
R-103
BALDWINVILLE, MASSACHUSETTS



REGION I SUPERFUND TECHNICAL ASSESSMENT AND RESPONSE TEAM

TDD NUMBER: 05-10-0004	CREATED BY: D. MUZRALL	CREATED ON: 3/8/2006
FILE LOCATION: E:\MA_GIS\BRP_Phase3\MXDs\IR103.MXD		FIGURE 2

Reported results are for AROCLOR 1254 and are reported in mg/kg. mg/kg = parts per million (PPM).

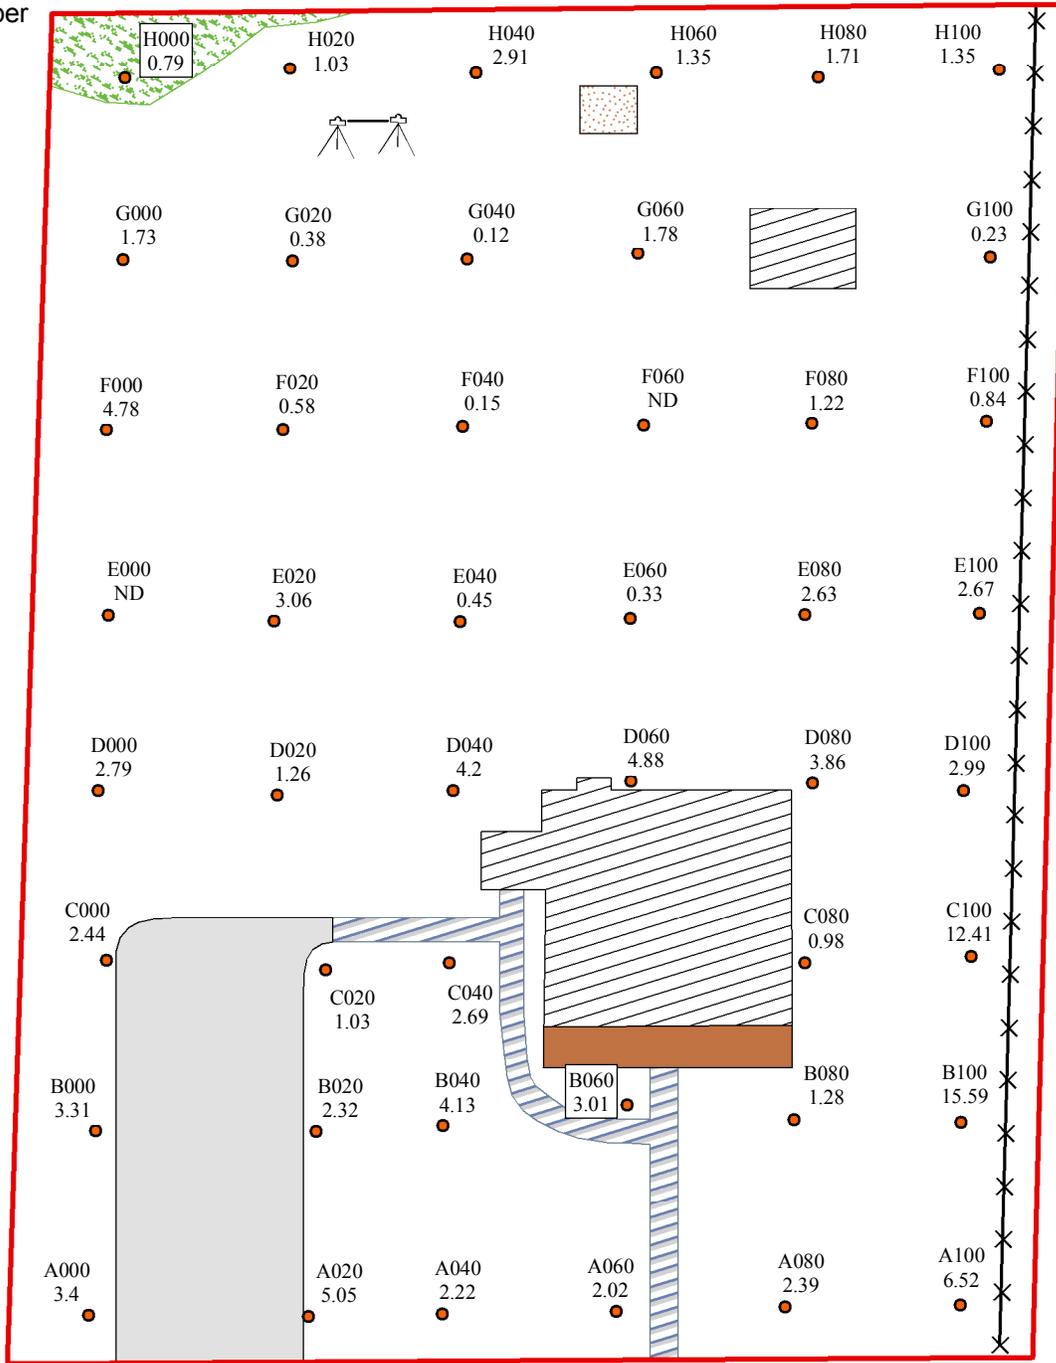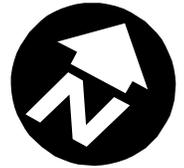


Pine Street

Not to Scale

Legend

- Sample Location
- Property Boundary
- Paved Driveway
- Paved Walkway
- Porch
- Sand Box
- Chain-link Fence
- Bushes
- Swing Set
- Building

ND = Non-Detect

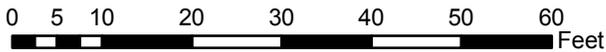

SITE DIAGRAM

BALDWINVILLE RESIDENTIAL PROPERTIES
R-108
BALDWINVILLE, MASSACHUSETTS





REGION I SUPERFUND TECHNICAL ASSESSMENT AND RESPONSE TEAM

TDD NUMBER: 05-10-0004	CREATED BY: D. MUZRALL	CREATED ON: 3/8/2006
---------------------------	---------------------------	-------------------------

FILE LOCATION: E:\MA_GIS\BRP_Phase3\MXDs\I108.MXD	FIGURE 2
--	----------


Reported results are for AROCLOR 1254
and are reported in mg/kg.
mg/kg = parts per million (PPM).

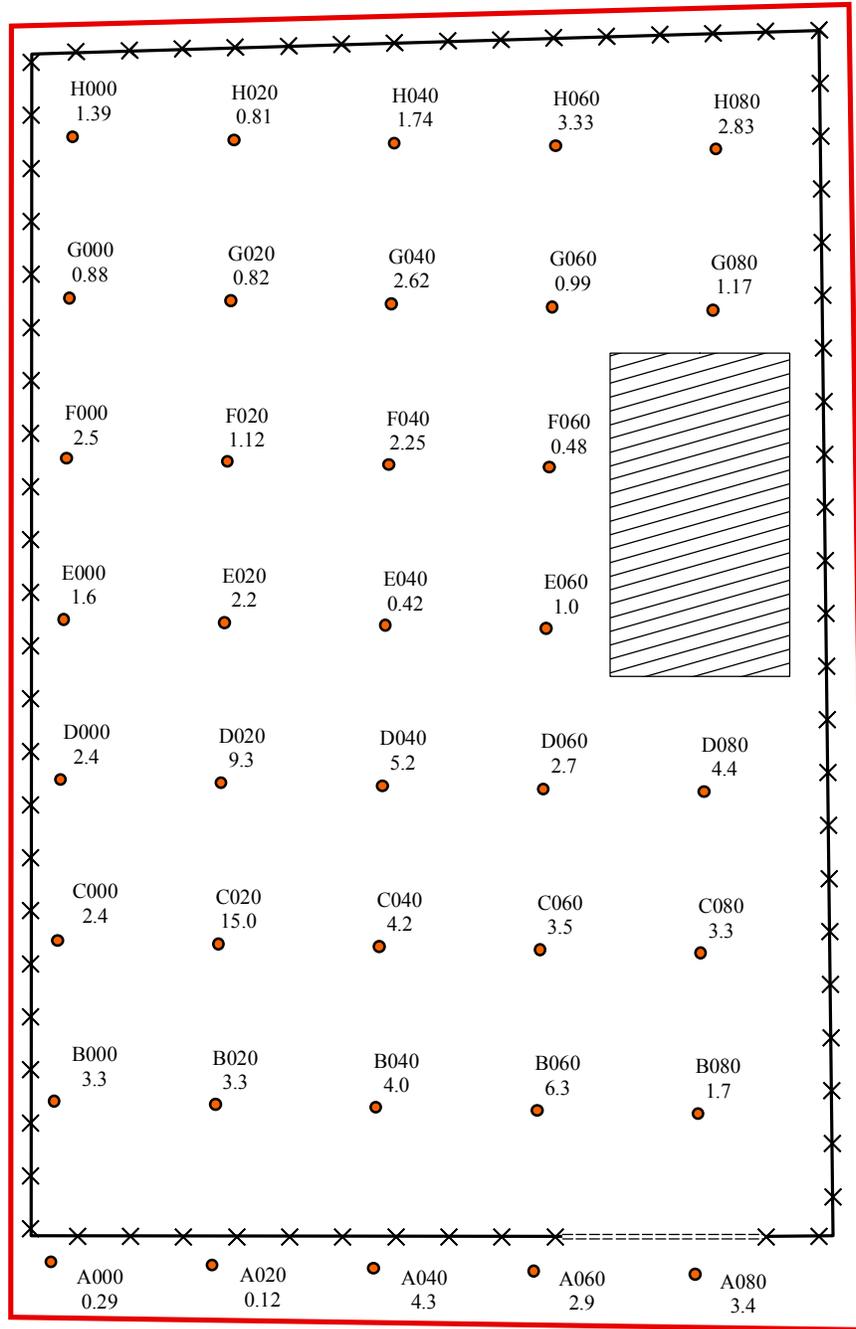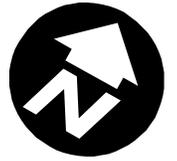

Pine Street

Not to Scale

Legend

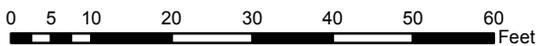

- Sample Location
- ▨ Temporary Garage
- Fence Gate
- ▭ Property Boundary
- ×-× Chain-link Fence

SITE DIAGRAM

BALDWINVILLE RESIDENTIAL PROPERTIES
R-109
BALDWINVILLE, MASSACHUSETTS





REGION I SUPERFUND TECHNICAL ASSESSMENT AND RESPONSE TEAM

TDD NUMBER: 05-10-0004	CREATED BY: D. MUZRALL	CREATED ON: 3/8/2006
---------------------------	---------------------------	-------------------------

FILE LOCATION: E:\MA_GIS\BRP_Phase3\MXD\IR109.MXD	FIGURE 2
--	----------

Reported results are for AROCLOR 1254
and are reported in mg/kg.
mg/kg = parts per million (PPM).

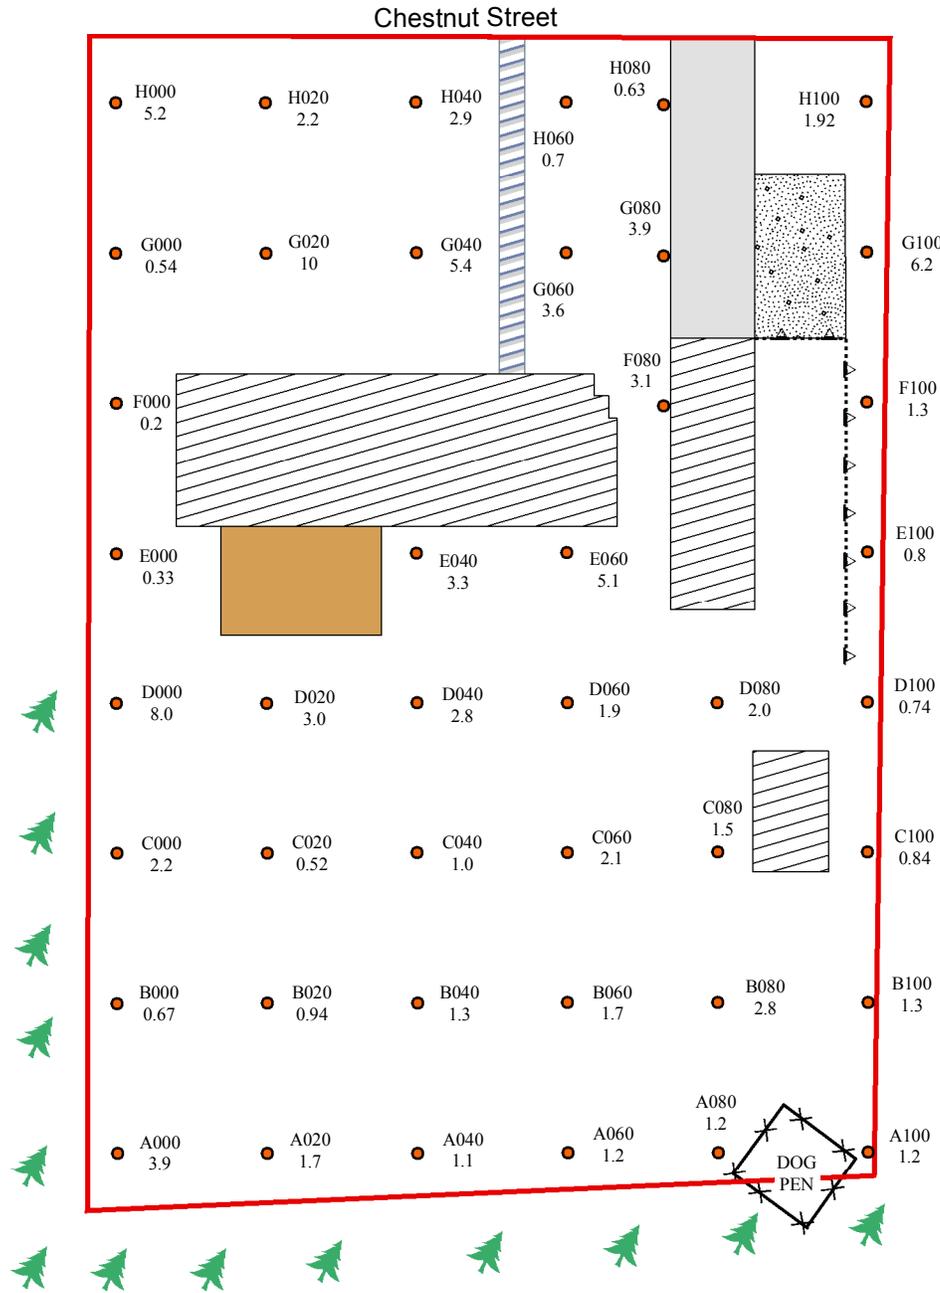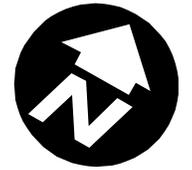

Not To Scale

Legend

ND = Non-Detect

	Sample Location		Building		Gravel Driveway
	Property Boundary		Wood Deck		Paved Driveway
	Paved Walkway		Trees		Chain-link Fence
					Picket Fence

SITE DIAGRAM


BALDWINVILLE RESIDENTIAL PROPERTIES
R-111
BALDWINVILLE, MASSACHUSETTS



REGION I SUPERFUND TECHNICAL ASSESSMENT AND RESPONSE TEAM

TDD NUMBER: 05-10-0004	CREATED BY: D. MUZRALL	CREATED ON: 8/10/2006
FILE LOCATION: E:\MA_GIS\BRP_Phase3\MXD\IR111.MXD		FIGURE 2

Reported results are for AROCLOR 1254
 and are reported in mg/kg.
 mg/kg = parts per million (PPM).

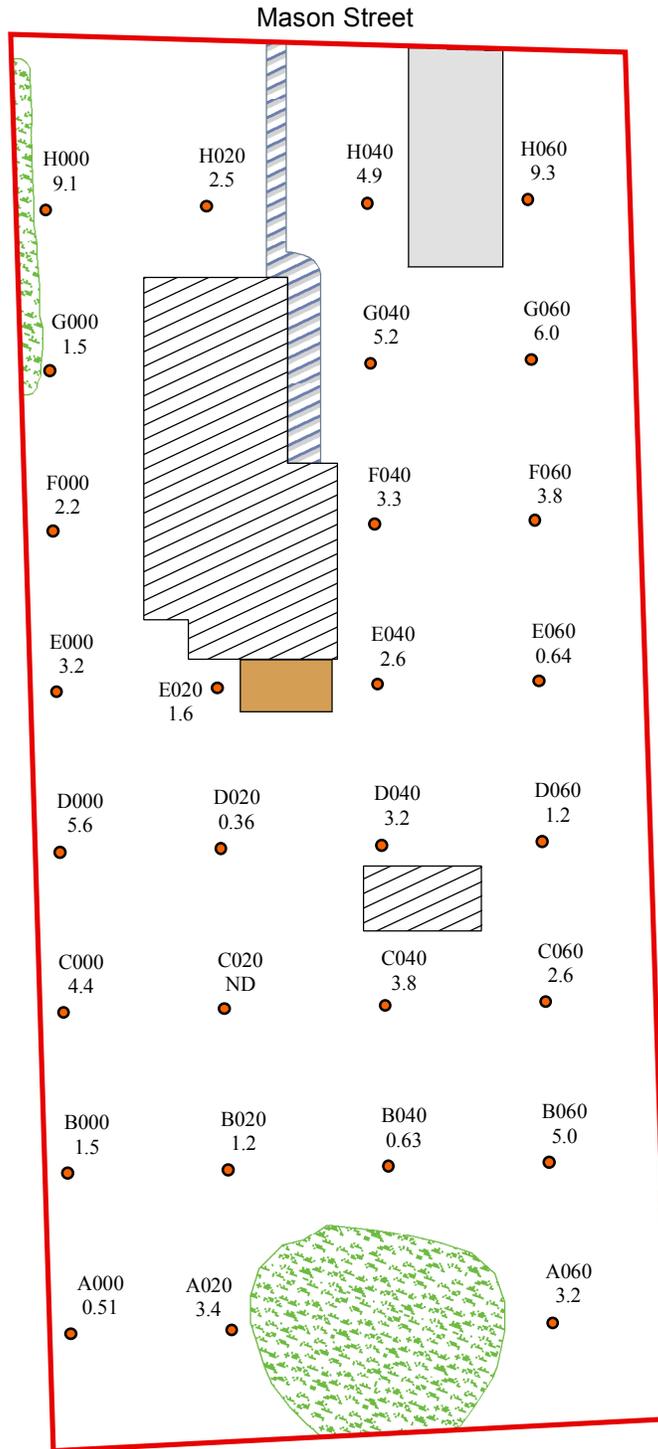

Not To Scale

Legend

ND = Not Detected

Sample Location
 Property Boundary
 Building
 Paved Driveway

Wood Deck
 Bushes
 Paved Walkway

SITE DIAGRAM

BALDWINVILLE RESIDENTIAL PROPERTIES
 R-119
 BALDWINVILLE, MASSACHUSETTS




REGION I SUPERFUND TECHNICAL ASSESSMENT AND RESPONSE TEAM

TDD NUMBER: 05-10-0004	CREATED BY: D. MUZRALL	CREATED ON: 3/8/2006
FILE LOCATION: E:\MA_GIS\BRP_Phase3\MXD\IR119.MXD		FIGURE 2


Reported results are for AROCLOR 1254
and are reported in mg/kg.
mg/kg = parts per million (PPM).

Mason Street

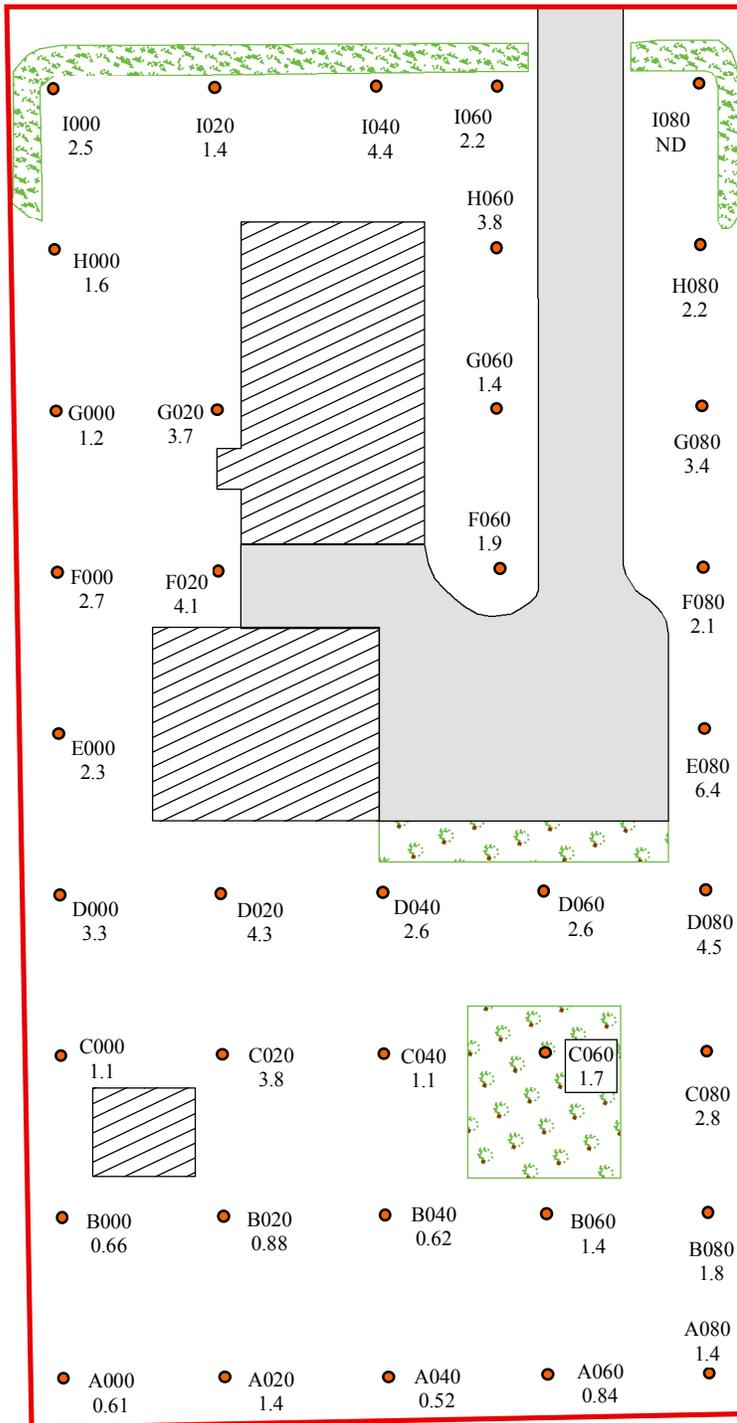

Not To Scale

Legend

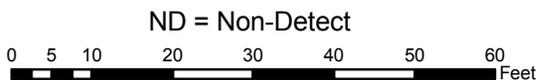

ND = Non-Detect

- Sample Location
- ▭ Property Boundary
- ▨ Building
- ▭ Paved Driveway
- ▨ Garden
- ▨ Bushes

SITE DIAGRAM

BALDWINVILLE RESIDENTIAL PROPERTIES
R-120
BALDWINVILLE, MASSACHUSETTS



REGION I SUPERFUND TECHNICAL ASSESSMENT AND RESPONSE TEAM

TDD NUMBER:
05-10-0004

CREATED BY:
D. MUZRALL


CREATED ON:
3/8/2006

FILE LOCATION:
E:\MA_GIS\BRP_Phase3\MXD\IR120.MXD

FIGURE 2


Reported results are for AROCLOR 1254
and are reported in mg/kg.
mg/kg = parts per million (PPM).

Mason Street

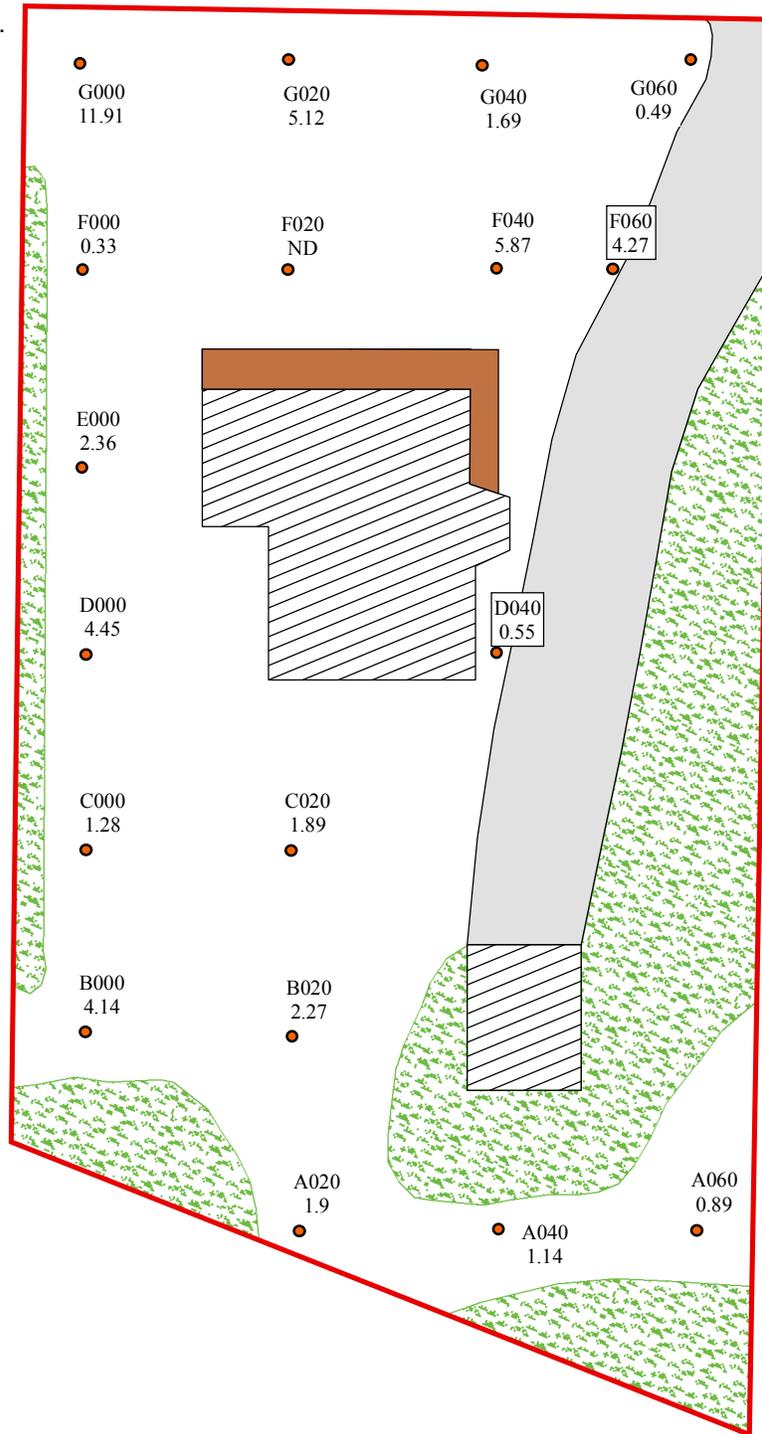

Not To Scale

Legend

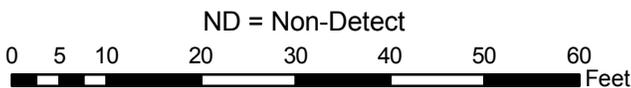

ND = Non-Detect

- Sample Location
- Porch
- Paved Driveway
- Property Boundary
- ▨ Building
- Bushes

SITE DIAGRAM

BALDWINVILLE RESIDENTIAL PROPERTIES
R-121
BALDWINVILLE, MASSACHUSETTS




REGION I SUPERFUND TECHNICAL ASSESSMENT AND RESPONSE TEAM

TDD NUMBER: 05-10-0004	CREATED BY: D. MUZRALL	CREATED ON: 3/8/2006
---------------------------	---------------------------	-------------------------

FILE LOCATION: E:\MA_GIS\BRP_Phase3\MXD\IR121.MXD	FIGURE 2
--	----------

Section 4 - Phase IV PA/SI Diagrams

Reported results are for AROCLOR 1254
 and are reported in mg/kg.
 mg/kg = parts per million (PPM).

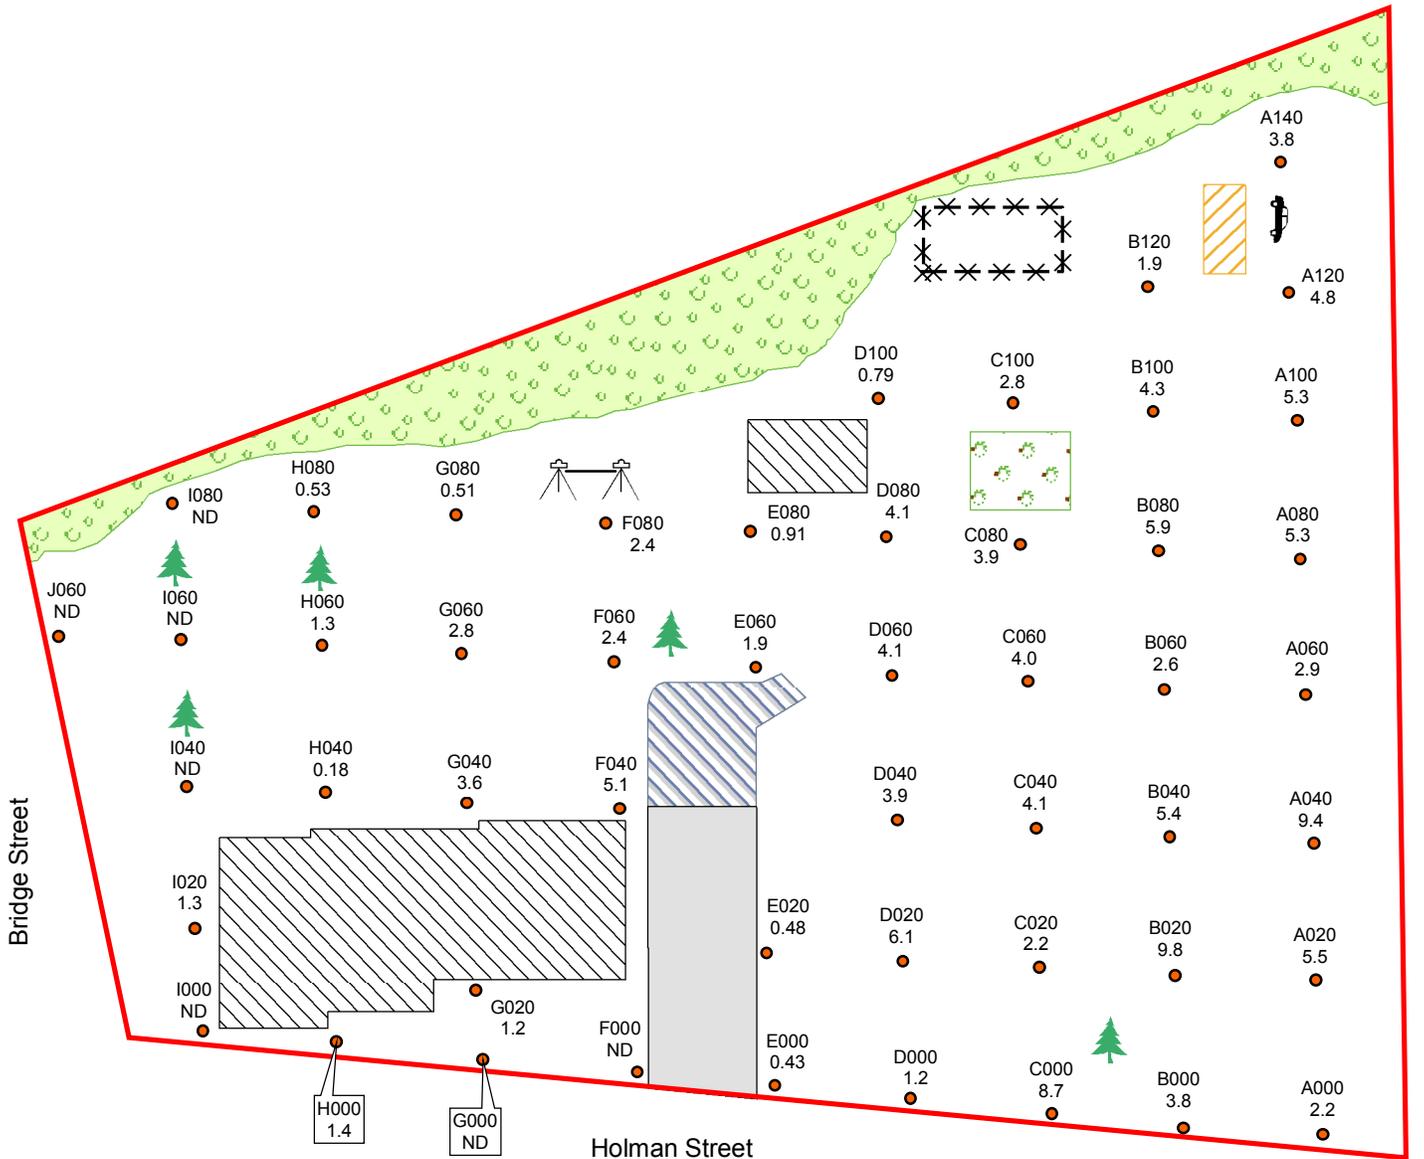

Not To Scale

Legend

- Sample Location
- ▭ Paved Driveway
- ▭ Concrete Patio
- ▭ Buildings
- ▭ Garden
- ▭ Wooded Area
- ⊛ Swing Set
- ⊛ Dog Pen
- ⊛ Vehicle
- ▭ Trailer
- 🌲 Trees

ND = Non-Detect



SITE DIAGRAM


BALDWINVILLE RESIDENTIAL PROPERTIES
 R-061
 BALDWINVILLE, MASSACHUSETTS



REGION I SUPERFUND TECHNICAL ASSESSMENT AND RESPONSE TEAM

TDD NUMBER: 05-10-0004	CREATED BY: B. MAHANY	CREATED ON: 10/20/2006
FILE LOCATION: E:\MA_GIS\BRP_Phase4\MXD\R061.MXD		FIGURE 2

Reported results are for AROCLOR 1254
and are reported in mg/kg.
mg/kg = parts per million (PPM).

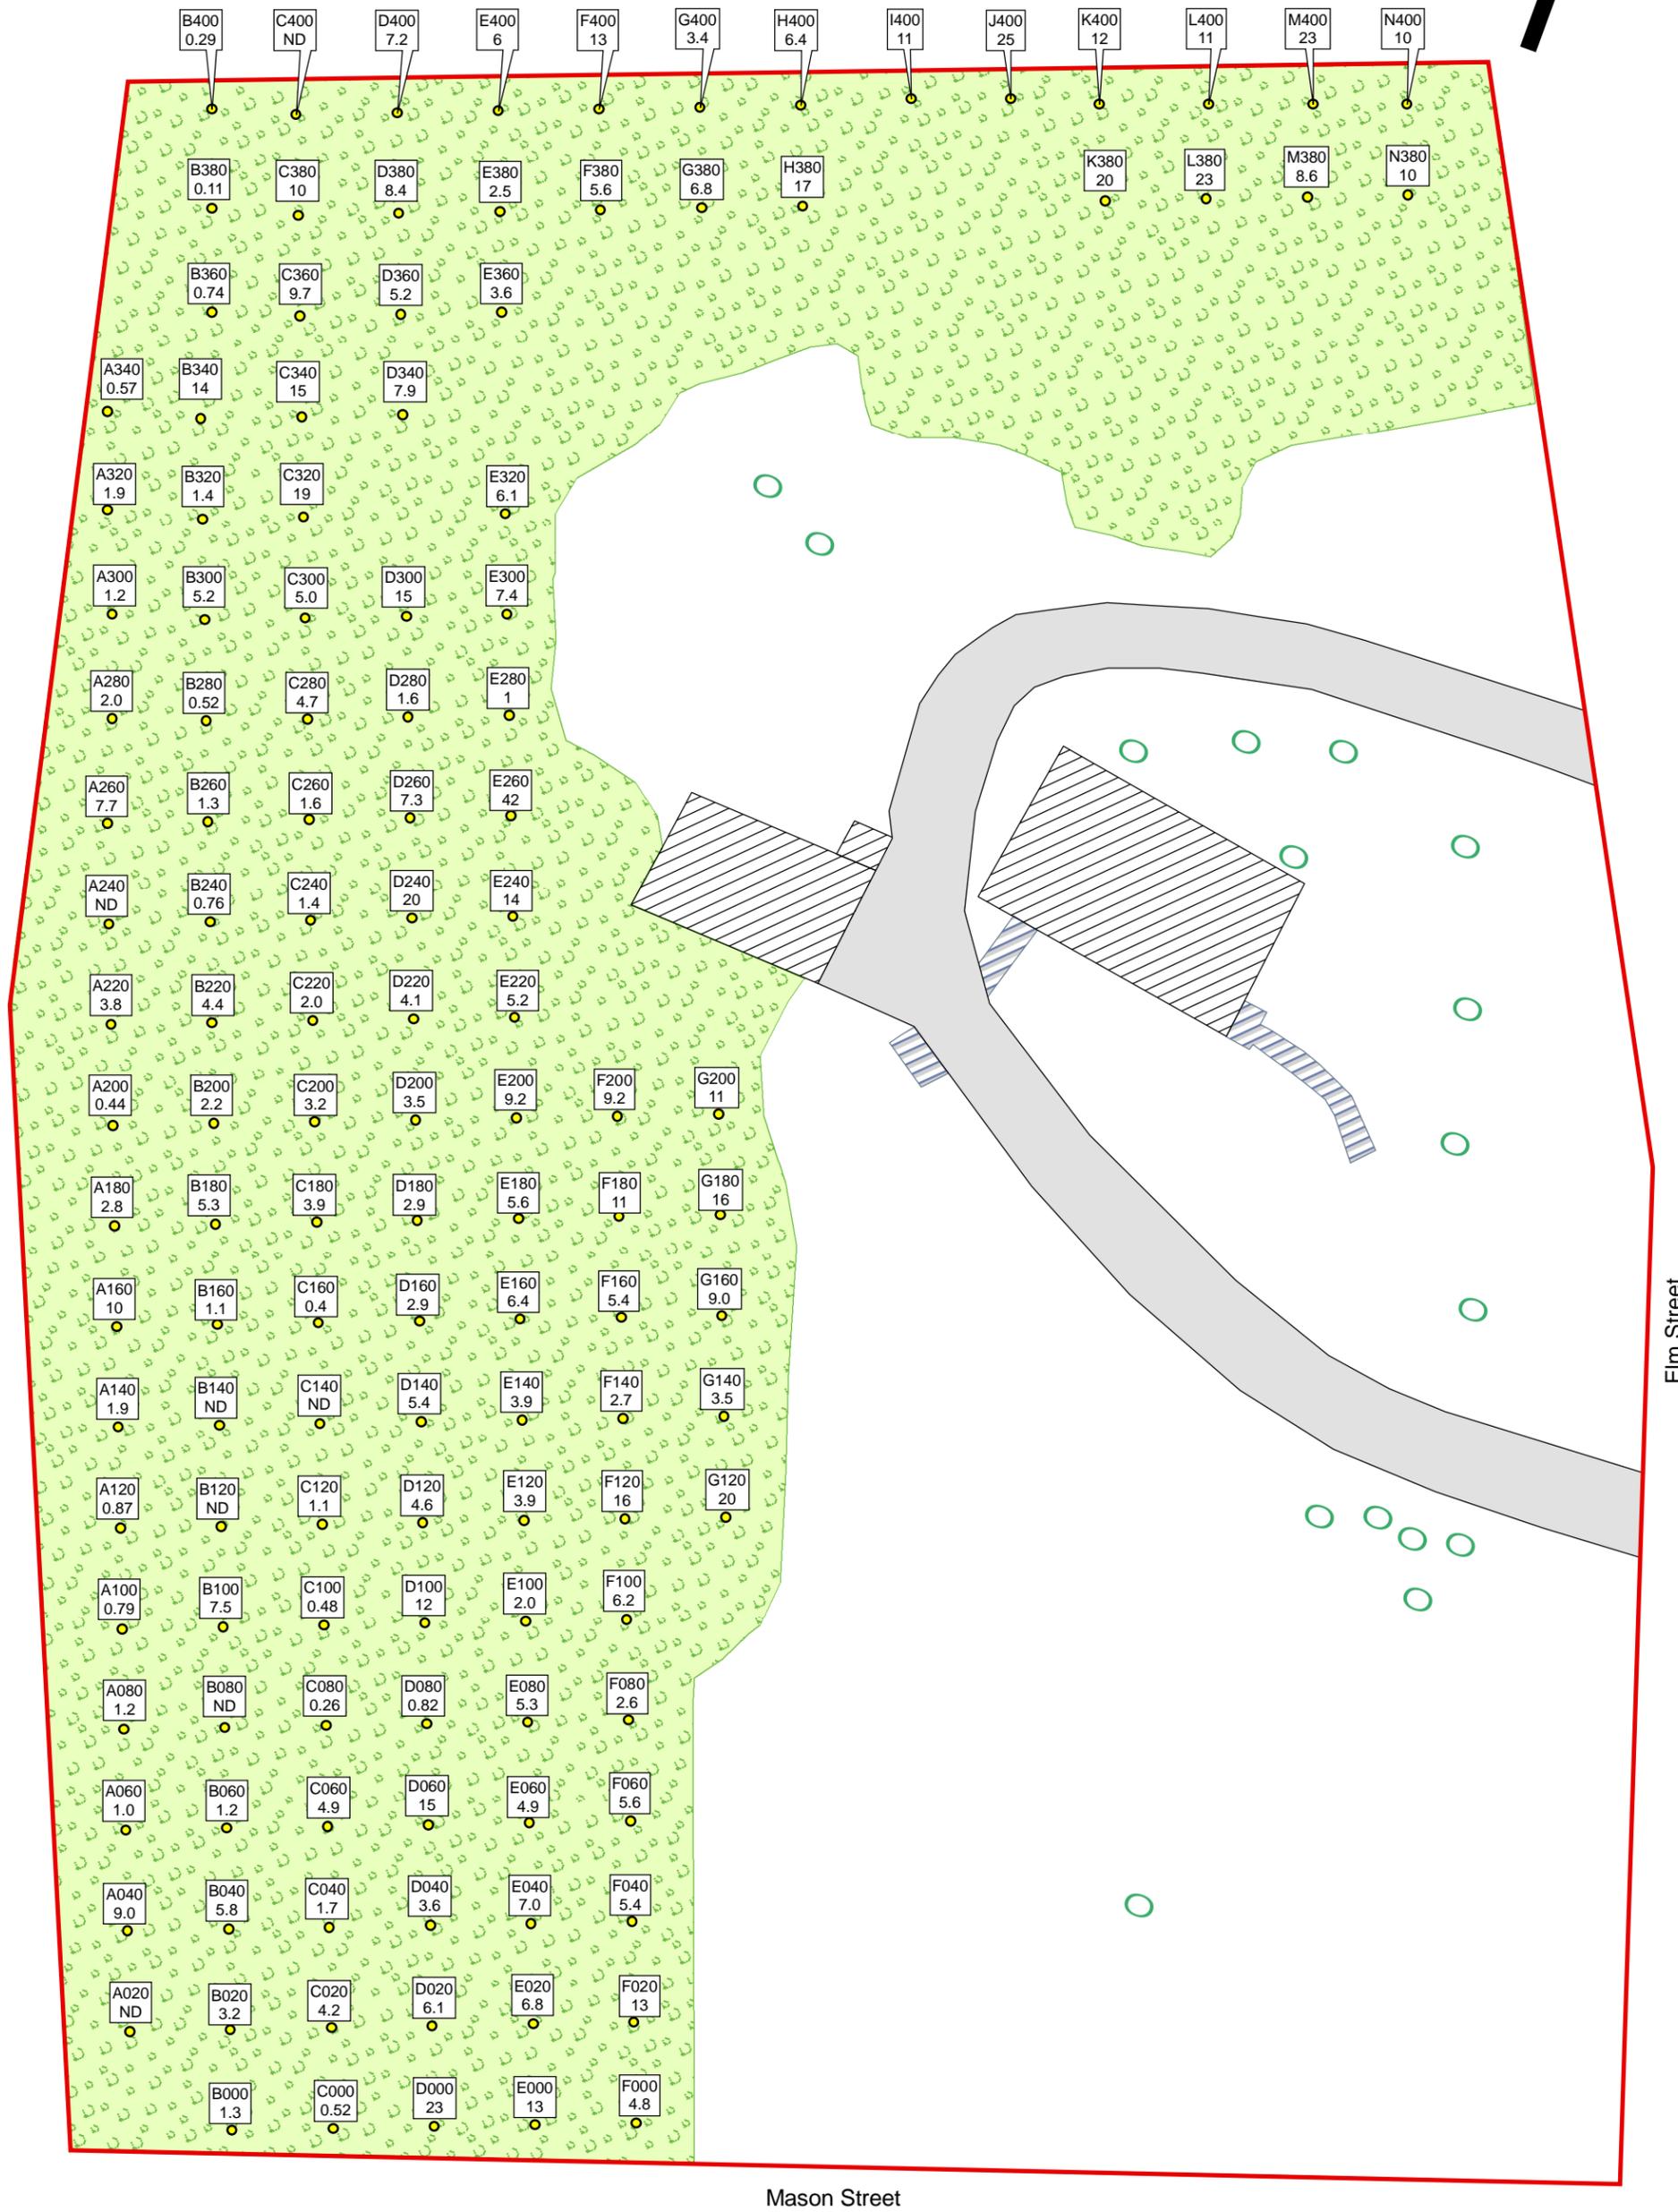

Mason Street

Elm Street

Not To Scale

SITE DIAGRAM

BALDWINVILLE RESIDENTIAL PROPERTIES
R-083B
BALDWINVILLE, MASSACHUSETTS

Legend

- Sample Location
- ▭ Property Boundary
- Tree
- ND = Non-Detect
- ▭ Paved Driveway
- ▨ Paved Walkway
- ▨ Building
- ▨ Wooded Area




REGION I SUPERFUND TECHNICAL ASSESSMENT AND RESPONSE TEAM

TDD NUMBER: 05-10-0004	CREATED BY: B. MAHANY	CREATED ON: 9/27/2006
FILE LOCATION: E:\MA_GIS\BRP_Phase4\MXD\R083.MXD		FIGURE 2

Reported results are for AROCLOR 1254
and are reported in mg/kg.
mg/kg = parts per million (PPM).

Mason Street

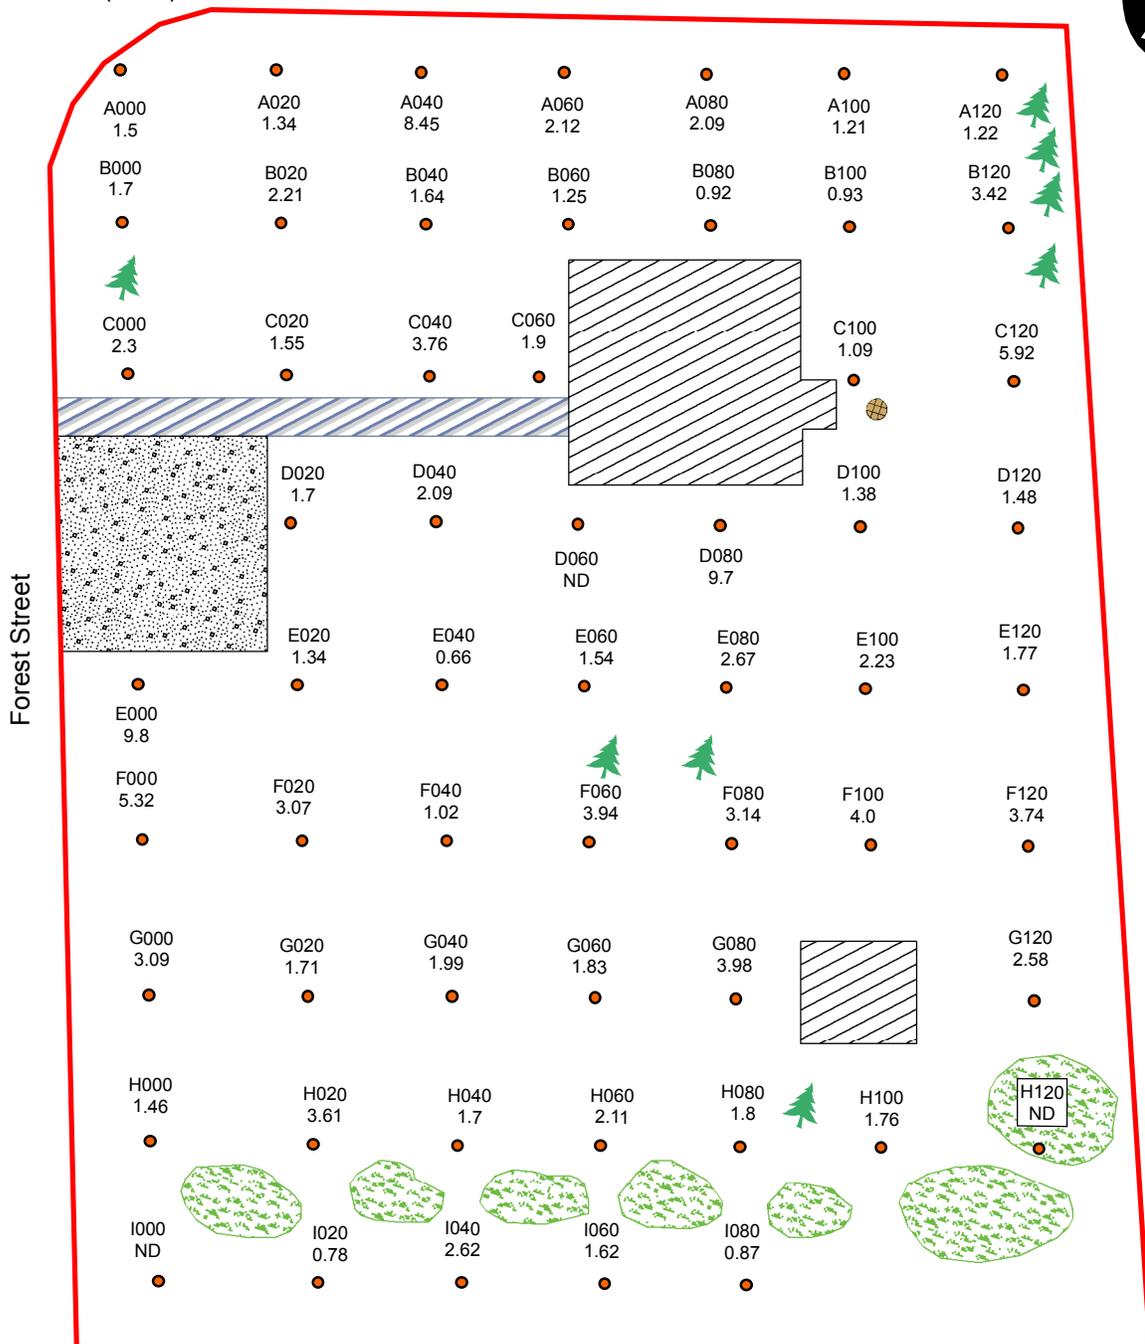


Not To Scale

Legend

- Sample Location
- Property Boundary
- 🌳 Trees
- Bushes
- Gravel Driveway
- Paved Walkway
- 🌐 Well/Septic Cover
- Building

ND = Non-Detect

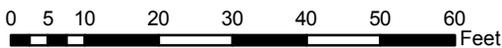

SITE DIAGRAM

BALDWINVILLE RESIDENTIAL PROPERTIES
R-122
BALDWINVILLE, MASSACHUSETTS




REGION I SUPERFUND TECHNICAL ASSESSMENT AND RESPONSE TEAM

TDD NUMBER: 05-10-0004	CREATED BY: B. MAHANY	CREATED ON: 5/26/2006
---------------------------	--------------------------	--------------------------

FILE LOCATION: E:\MA_GIS\BRP_Phase4\MXD\I122.MXD	FIGURE 2
---	----------

Reported results are for AROCLOR 1254
and are reported in mg/kg.
mg/kg = parts per million (PPM).

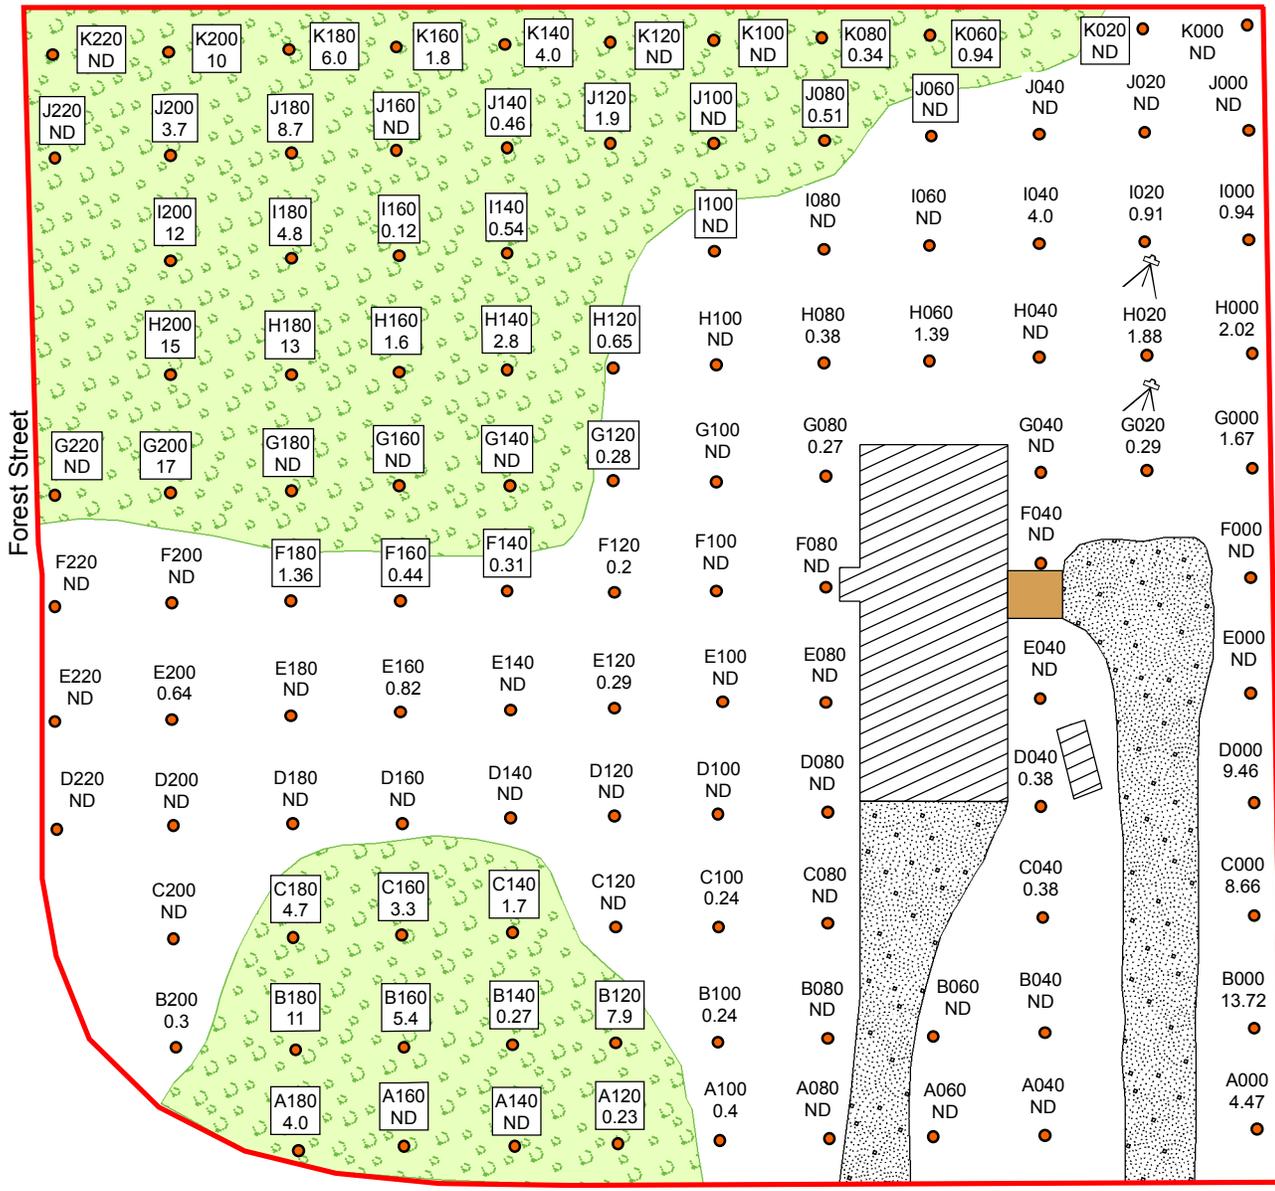

Mason Street

Not To Scale

Legend

ND = Non-Detect



- Sample Location
- Wood Deck
- Wooded Area
- Property Boundary
- Gravel Driveway
- Building
- Swing Set

SITE DIAGRAM


BALDWINVILLE RESIDENTIAL PROPERTIES
R-123
BALDWINVILLE, MASSACHUSETTS



REGION I SUPERFUND TECHNICAL ASSESSMENT AND RESPONSE TEAM

TDD NUMBER: 05-10-0004	CREATED BY: B. MAHANY	CREATED ON: 9/26/2006
FILE LOCATION: E:\MA_GIS\BRP_Phase4\MXDs\R123.MXD		FIGURE 2

Reported results are for AROCLOR 1254
and are reported in mg/kg.
mg/kg = parts per million (PPM).

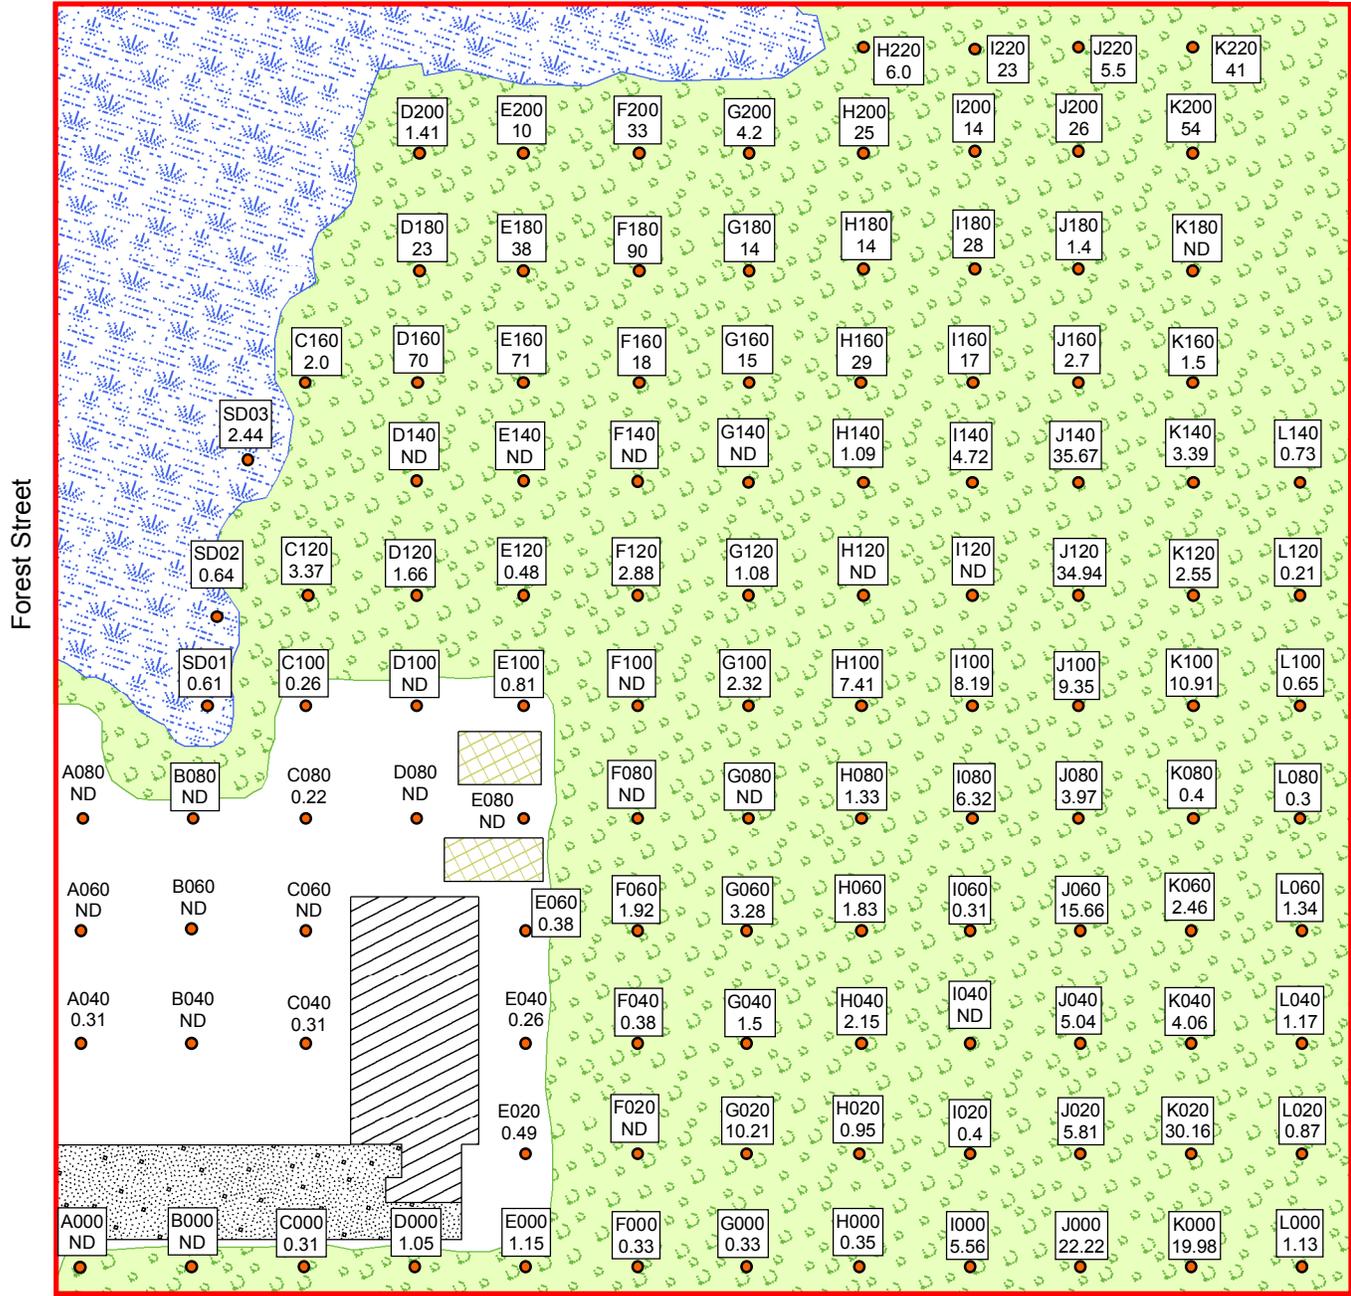

Not To Scale

Legend

- Sample Location
 - ▭ Gravel Driveway
 - ▭ Wetland
 - ▭ Property Boundary
 - ▭ Trailers
 - ▭ Wooded Area
 - ▭ Building
- ND = Non-Detect
- 0 5 10 20 30 40 50 60 Feet

SITE DIAGRAM


BALDWINVILLE RESIDENTIAL PROPERTIES
R-145
BALDWINVILLE, MASSACHUSETTS



REGION I SUPERFUND TECHNICAL ASSESSMENT AND RESPONSE TEAM

TDD NUMBER: 05-10-0004	CREATED BY: B. MAHANY	CREATED ON: 10/26/2006
FILE LOCATION: E:\MA_GIS\BRP_Phase4\MXD\IR145.MXD		FIGURE 2

Reported results are for AROCLOR 1254
and are reported in mg/kg.
mg/kg = parts per million (PPM).

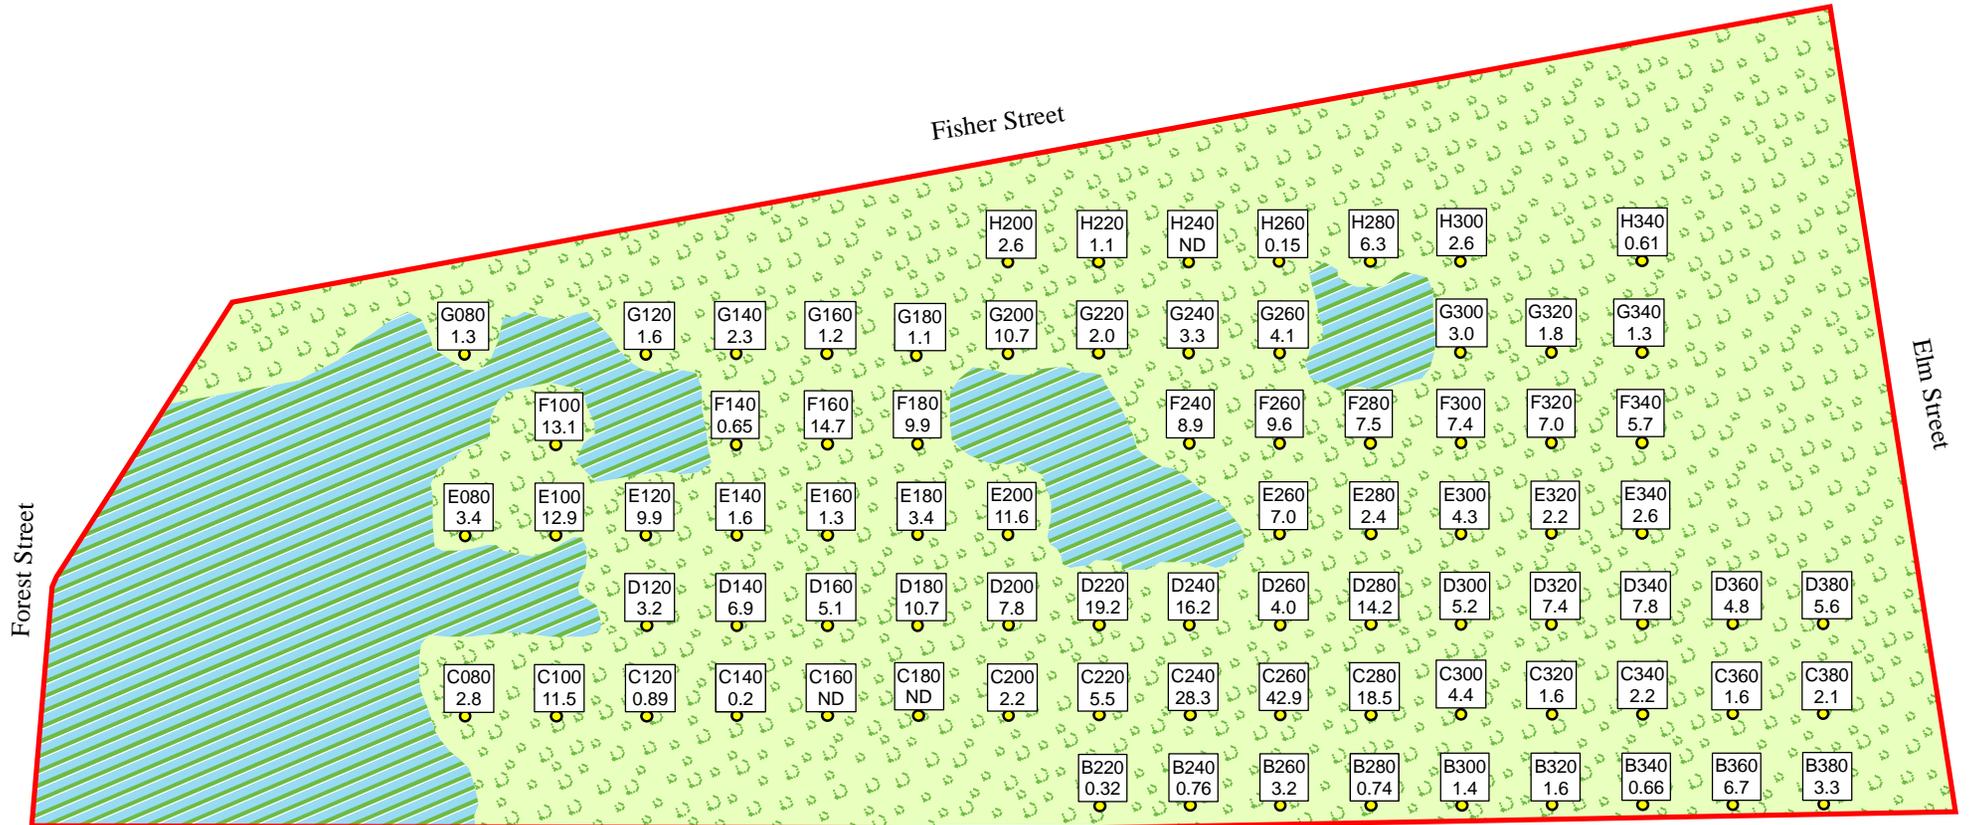


Not To Scale

SITE DIAGRAM

BALDWINVILLE RESIDENTIAL PROPERTIES
R-089
BALDWINVILLE, MASSACHUSETTS

Legend

- Sample Location
- Property Boundary
- Wooded Area
- Wetlands
- ND = Non-Detect

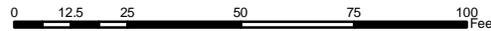

REGION I SUPERFUND TECHNICAL ASSESSMENT AND RESPONSE TEAM

TDD NUMBER: 05-10-0004	CREATED BY: D. MUZZRALL	CREATED ON: 8/28/2006
---------------------------	----------------------------	--------------------------



FILE LOCATION: E:\WA_GIS\BRP_Phase4_MXD\ R089_Tabloid.MXD	FIGURE 2
--	----------

Appendix D

Removal Excavation Diagrams

- Section 1 - Phase I Removal Diagrams
- Section 2 - Phase II Removal Diagrams
- Section 3 - Phase III Removal Diagrams
- Section 4 - Phase IV Removal Diagrams

Section 1 - Phase I Removal Diagrams

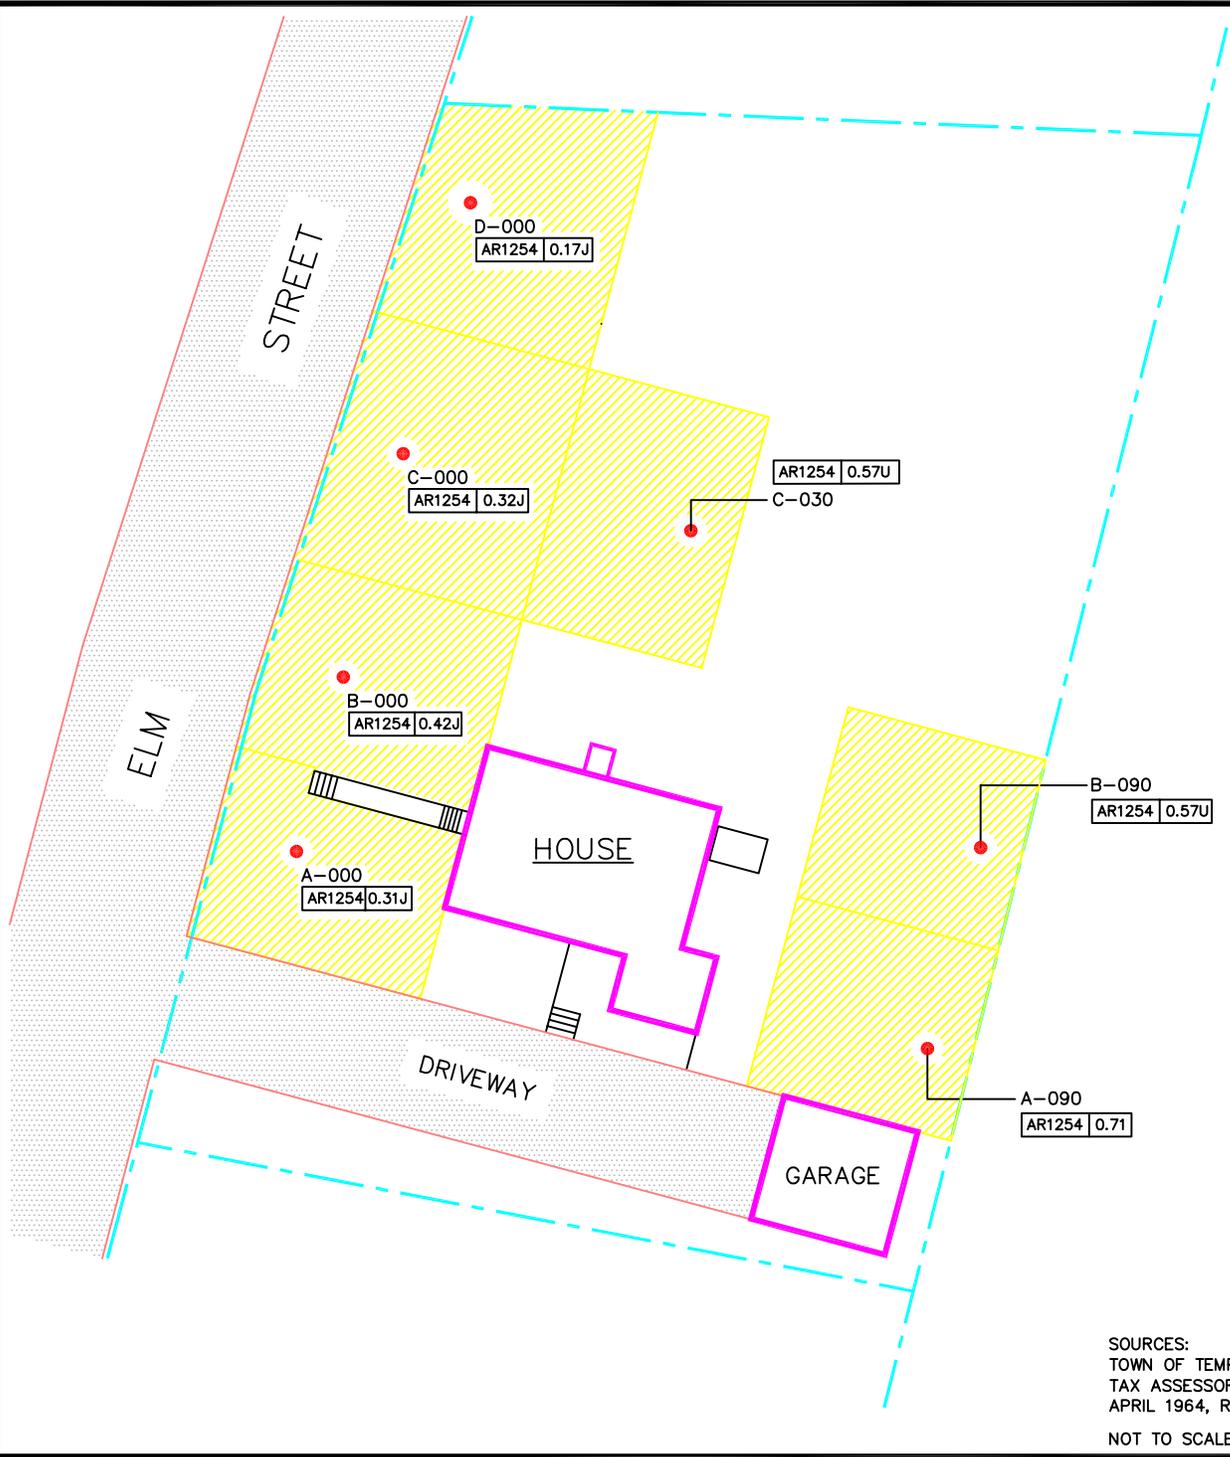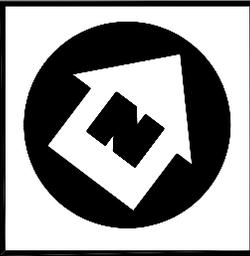

SOURCES:
TOWN OF TEMPLETON, MASSACHUSETTS
TAX ASSESSORS MAPS NOS. 6-4, AND 6.5
APRIL 1964, REVISED JANUARY 2001
NOT TO SCALE

LEGEND

○ ASPHALT PAVEMENT
- - - PROPERTY LINE

● SOIL SAMPLING LOCATION

— DENOTES SOIL SAMPLING POINT IDENTIFICATION
A-000
AR1254 | 0.0
AROCOR 1254 (PCB) RESULTS IN PARTS PER MILLION (PPM)

NOTES:
ALL RESULTS ARE REPORTED IN MG/KG (PARTS PER MILLION)
ND = NOT DETECTED
J = RESULT IS ESTIMATED

EXCAVATION DEPTH
1 FOOT

EXCAVATION DIAGRAM
BALDWINVILLE RESIDENTIAL PROPERTIES
R-003
BALDWINVILLE, MASSACHUSETTS



REGION I SUPERFUND TECHNICAL ASSESSMENT AND RESPONSE TEAM



TDD #
05-07-0013

DRAWN BY:
W. SHAW

DATE
3/22/05

FILE NAME:
R:\05070013\FIGURES\PROPERTY DIAGRAMS\EXCAVATION DIAGRAMS\FIGURE 3\PHASE 1\FIG_R003.DWG

FIGURE 3

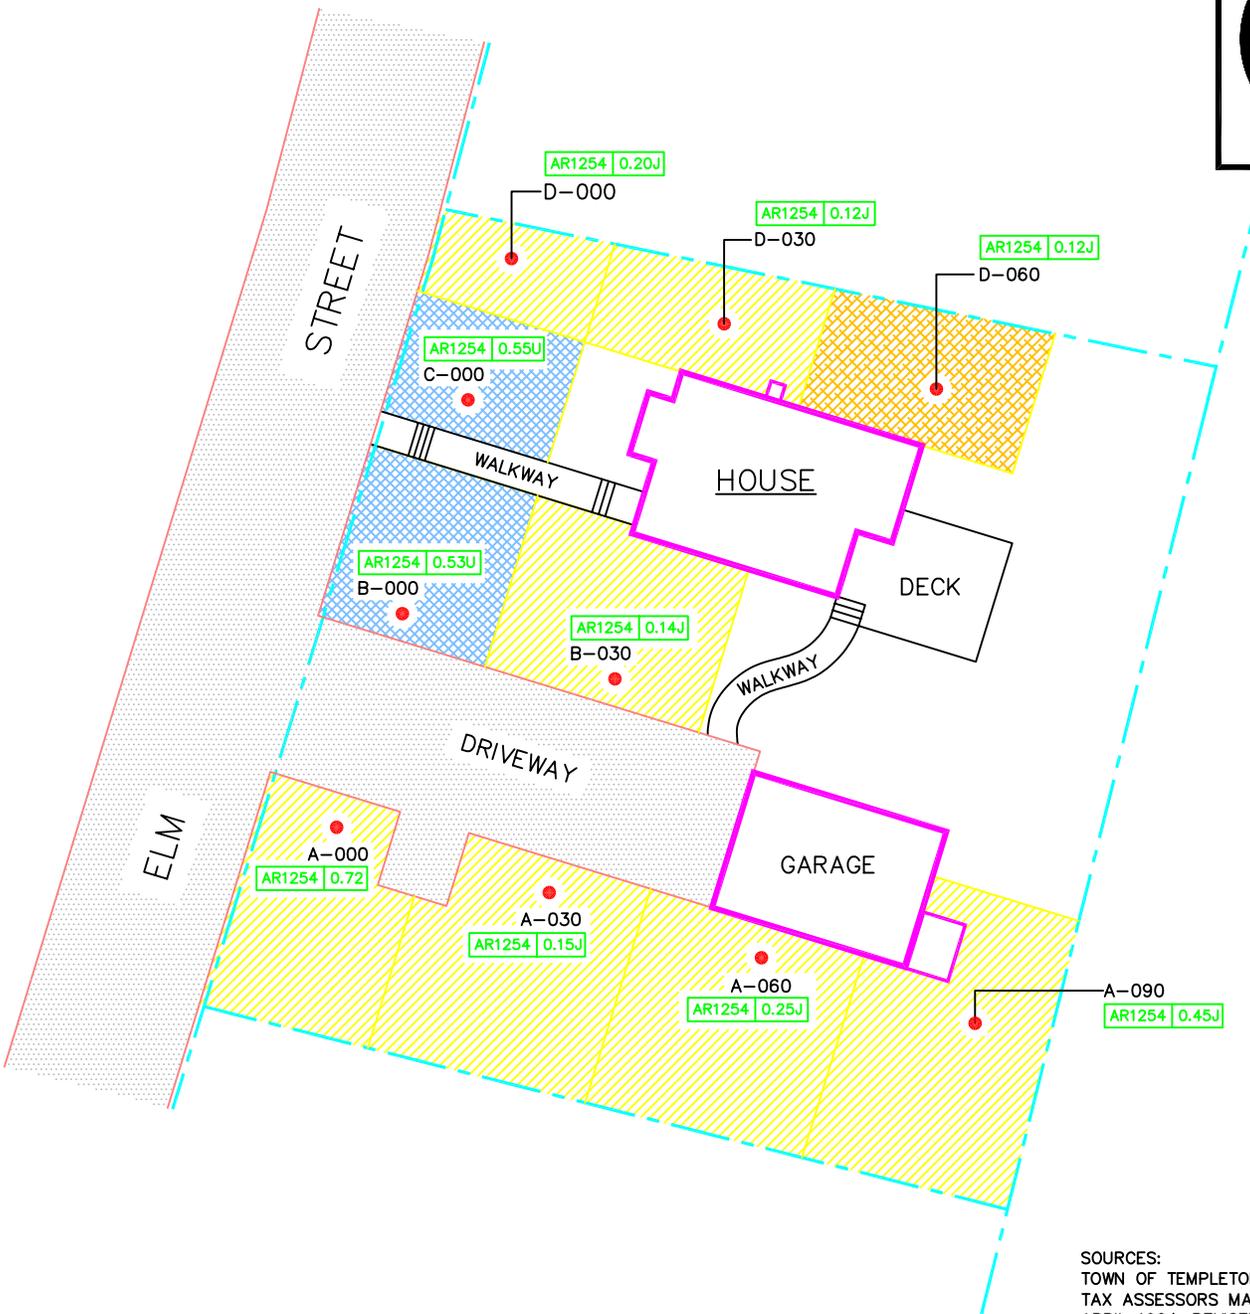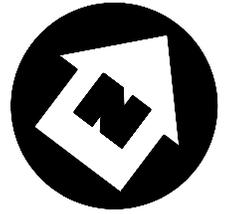

SOURCES:
TOWN OF TEMPLETON, MASSACHUSETTS
TAX ASSESSORS MAPS NOS. 6-4, AND 6.5
APRIL 1964, REVISED JANUARY 2001
NOT TO SCALE

LEGEND

- ASPHALT PAVEMENT
 - SOIL SAMPLING LOCATION
 - PROPERTY LINE
 - DENOTES SOIL SAMPLING POINT IDENTIFICATION
 - AROCLOR 1254 (PCB) RESULTS IN PARTS PER MILLION (PPM)
 - EXCAVATION DEPTH 1 FOOT
 - EXCAVATION DEPTH 1.5 FEET
 - EXCAVATION DEPTH 2 FEET
- NOTES:
ALL RESULTS ARE REPORTED IN MG/KG (PARTS PER MILLION)
ND = NOT DETECTED
J = RESULT IS ESTIMATED

EXCAVATION DIAGRAM

BALDWINVILLE RESIDENTIAL
PROPERTIES

R-004 & R-005

BALDWINVILLE, MASSACHUSETTS



REGION I SUPERFUND TECHNICAL ASSESSMENT AND RESPONSE TEAM


TDD #
05-07-0013

DRAWN BY:
W. SHAW

DATE
3/30/05

FILE NAME:
R:\05070013\FIGURES\PROPERTY DIAGRAMS\EXCAVATION
DIAGRAMS\FIGURE 3\PHASE I\FIG_R004_005.DWG

FIGURE 3

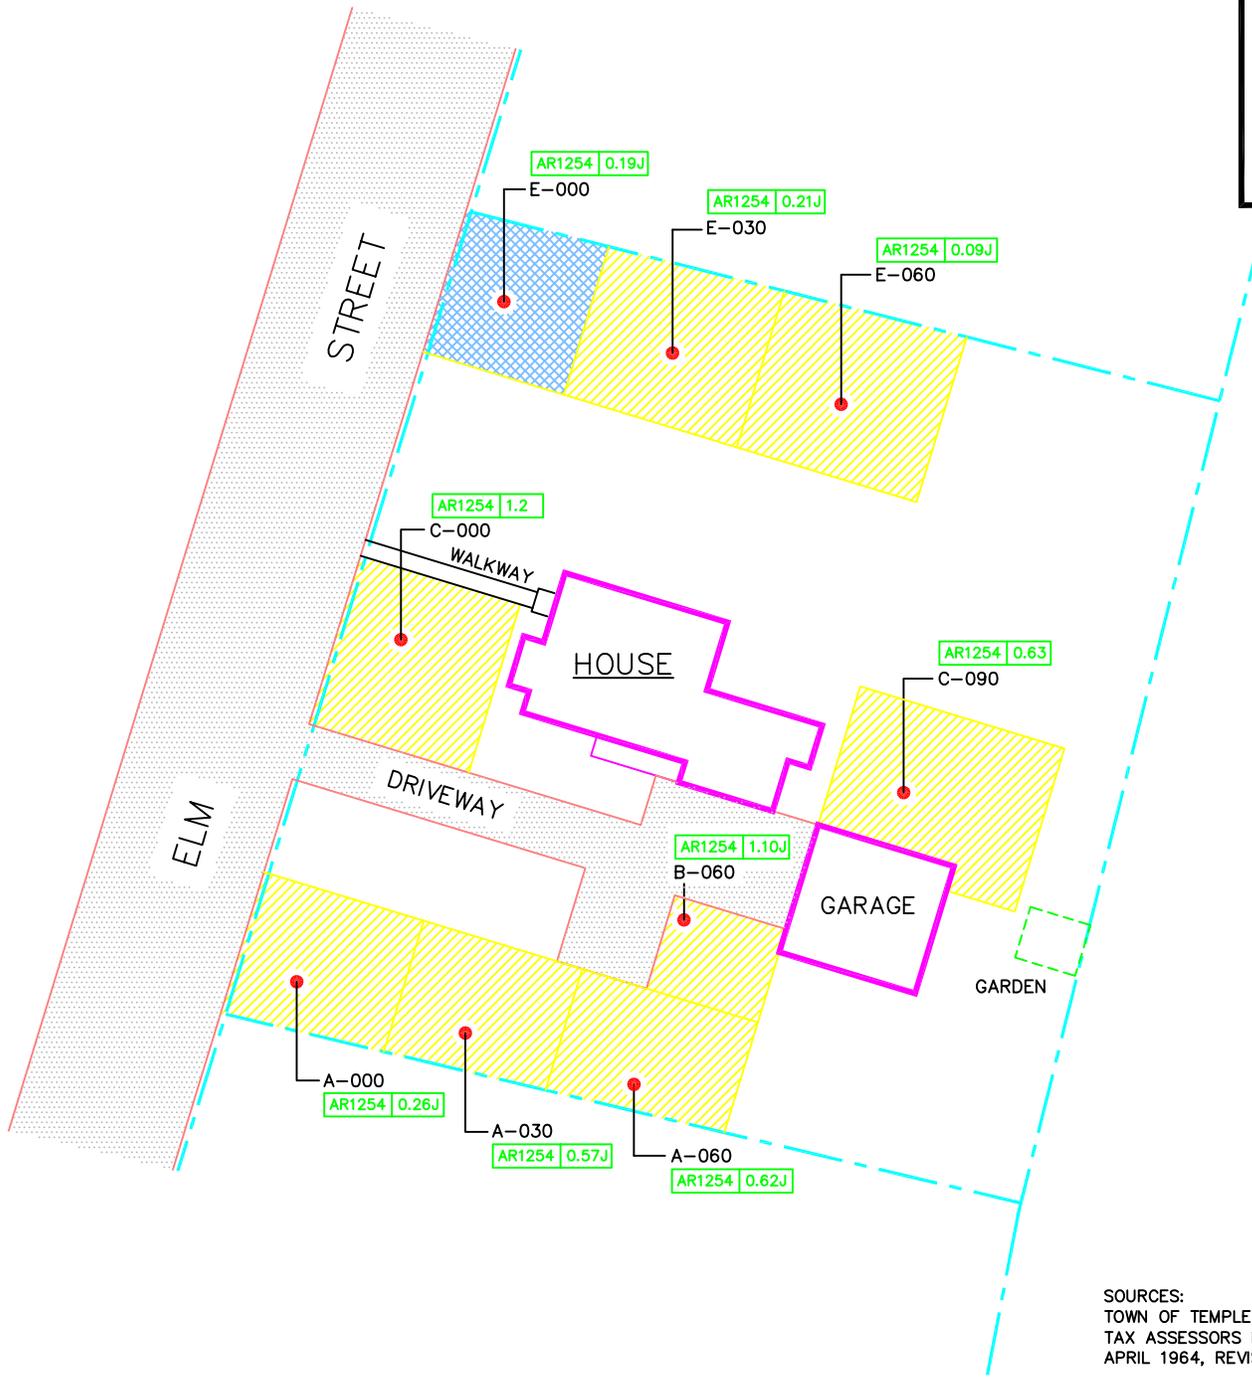

SOURCES:
 TOWN OF TEMPLETON, MASSACHUSETTS
 TAX ASSESSORS MAPS NOS. 6-4, AND 6.5
 APRIL 1964, REVISED JANUARY 2001
 NOT TO SCALE

LEGEND

○ ASPHALT PAVEMENT
 - - - PROPERTY LINE

● SOIL SAMPLING LOCATION

— DENOTES SOIL SAMPLING POINT IDENTIFICATION
 A-000 AROCLOR 1254 (PCB) RESULTS IN PARTS PER MILLION (PPM)
 AR1254 | 0.0

NOTES:
 ALL RESULTS ARE REPORTED IN MG/KG (PARTS PER MILLION)
 ND = NOT DETECTED
 J = RESULT IS ESTIMATED

EXCAVATION DEPTH
 ▨ 1 FOOT
 ▨ 1.5 FEET

EXCAVATION DIAGRAM
 BALDWINVILLE RESIDENTIAL PROPERTIES
 R-006
 BALDWINVILLE, MASSACHUSETTS



REGION I SUPERFUND TECHNICAL ASSESSMENT AND RESPONSE TEAM



TDD #
 05-07-0013

DRAWN BY:
 W. SHAW

DATE
 3/30/05

FILE NAME:
 R:\05070013\FIGURES\PROPERTY DIAGRAMS\EXCAVATION DIAGRAMS\FIGURE 3\PHASE 1\FIG_R006.DWG

FIGURE 3

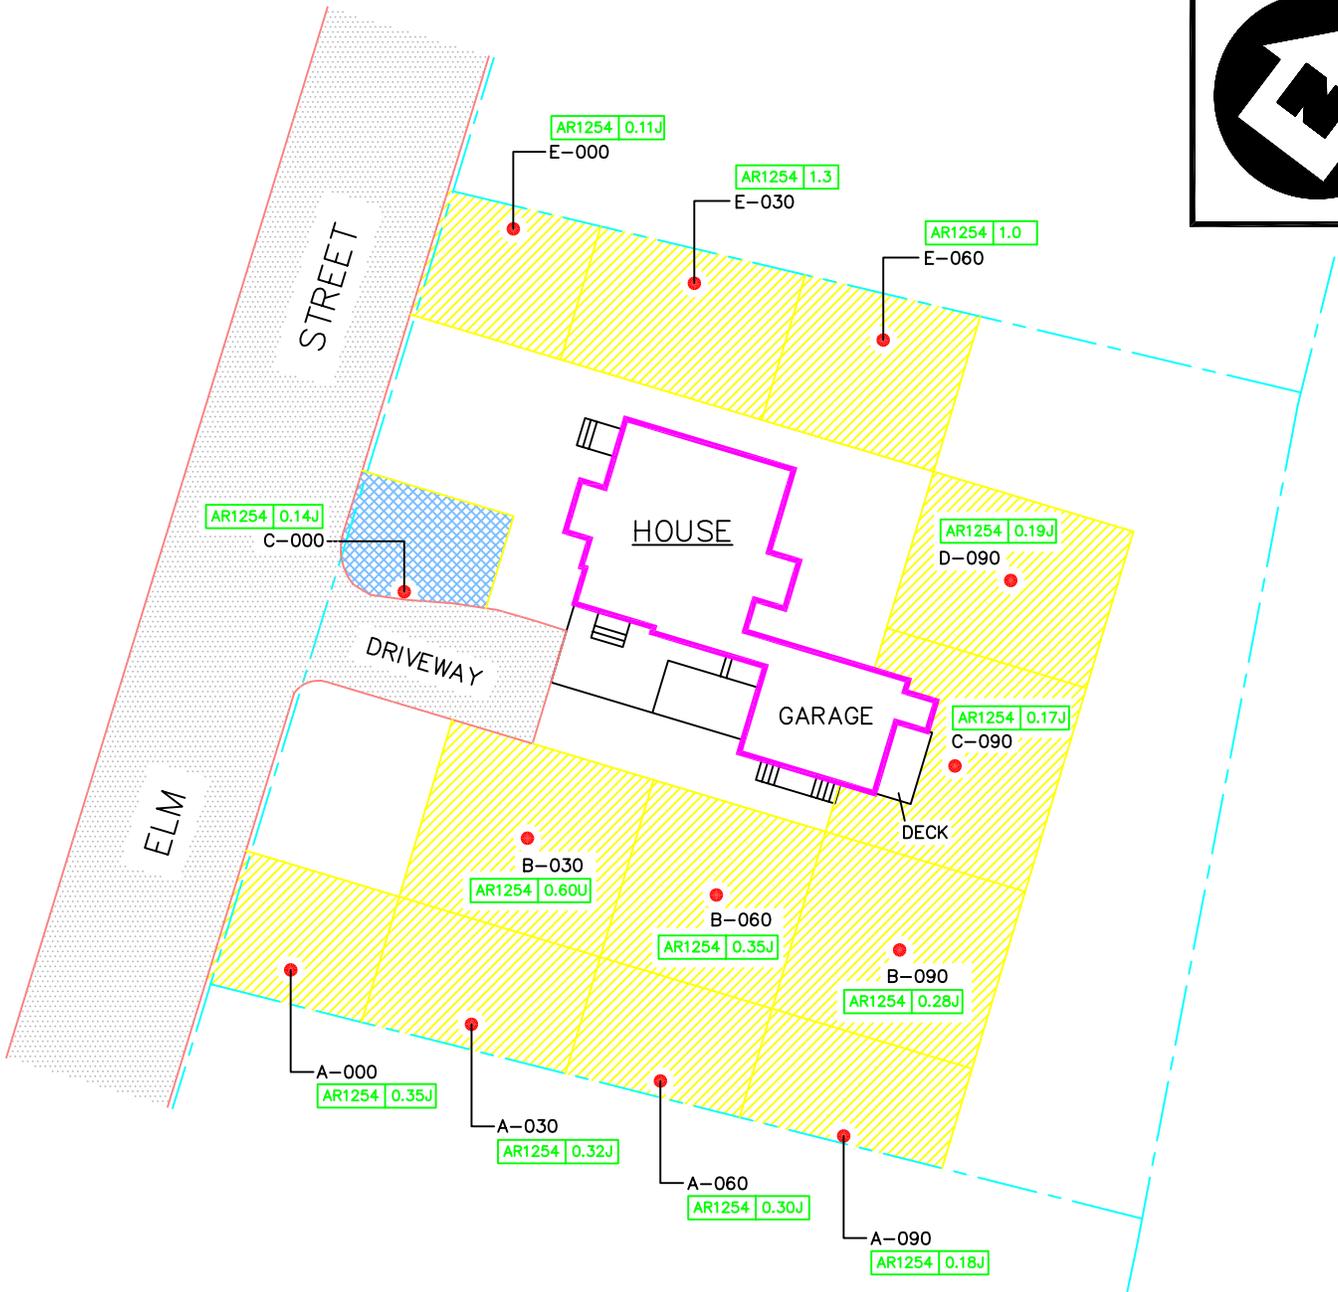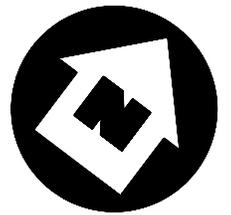

SOURCES:
 TOWN OF TEMPLETON, MASSACHUSETTS
 TAX ASSESSORS MAPS NOS. 6-4, AND 6.5
 APRIL 1964, REVISED JANUARY 2001
 NOT TO SCALE

LEGEND

○ ASPHALT PAVEMENT
 - - - PROPERTY LINE

● SOIL SAMPLING LOCATION

— DENOTES SOIL SAMPLING POINT IDENTIFICATION

A-000
 AR1254 | 0.0
 AROCLOR 1254 (PCB) RESULTS IN PARTS PER MILLION (PPM)

NOTES:
 ALL RESULTS ARE REPORTED IN MG/KG (PARTS PER MILLION)
 ND = NOT DETECTED
 J = RESULT IS ESTIMATED

EXCAVATION DEPTH
 1 FOOT
 1.5 FEET

EXCAVATION DIAGRAM
 BALDWINVILLE RESIDENTIAL PROPERTIES
 R-007
 BALDWINVILLE, MASSACHUSETTS



REGION I SUPERFUND TECHNICAL ASSESSMENT AND RESPONSE TEAM



TDD #
 05-07-0013

DRAWN BY:
 W. SHAW

DATE
 3/30/05

FILE NAME:
 R:\05070013\FIGURES\PROPERTY DIAGRAMS\EXCAVATION DIAGRAMS\FIGURE 3\PHASE I\FIG_R007.DWG

FIGURE 3

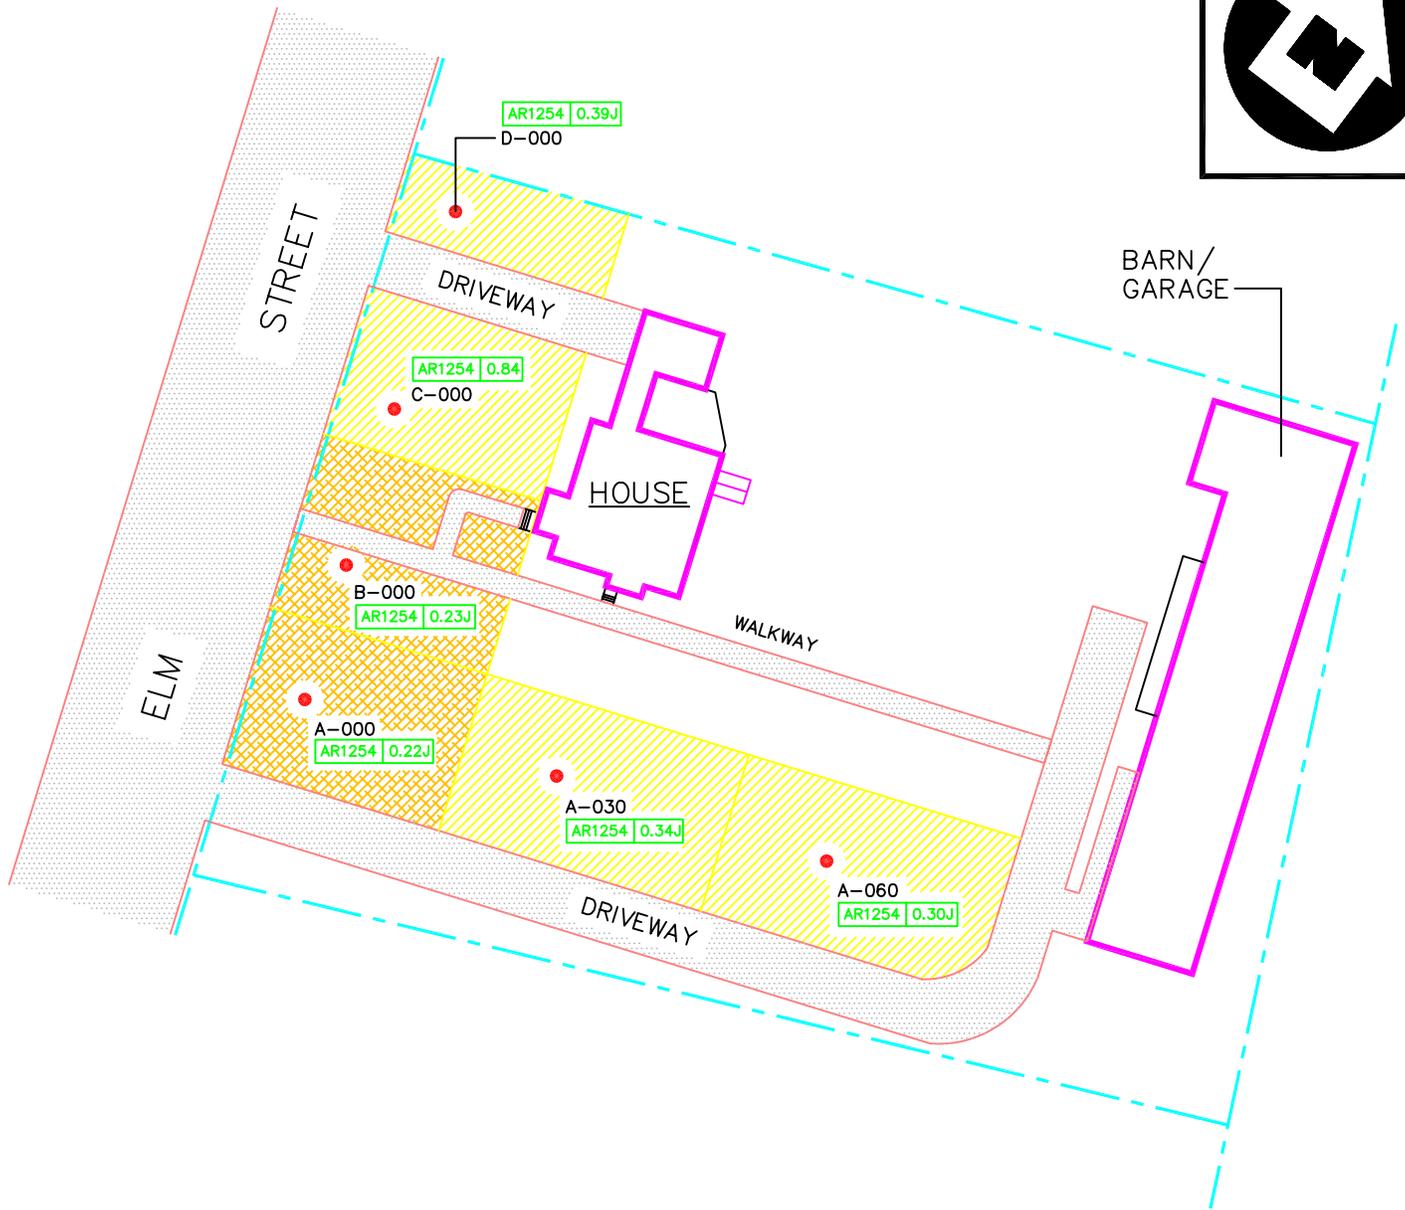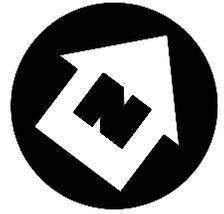

SOURCES:
TOWN OF TEMPLETON, MASSACHUSETTS
TAX ASSESSORS MAPS NOS. 6-4, AND 6.5
APRIL 1964, REVISED JANUARY 2001
NOT TO SCALE

LEGEND

○ ASPHALT PAVEMENT
- - - PROPERTY LINE

● SOIL SAMPLING LOCATION

— DENOTES SOIL SAMPLING POINT IDENTIFICATION

A-000
AR1254 | 0.0
— AROCLOR 1254 (PCB) RESULTS IN PARTS PER MILLION (PPM)

NOTES:
ALL RESULTS ARE REPORTED IN MG/KG (PARTS PER MILLION)
ND = NOT DETECTED
J = RESULT IS ESTIMATED

EXCAVATION DEPTH
▨ 1 FOOT
▩ 2 FEET

EXCAVATION DIAGRAM
BALDWINVILLE RESIDENTIAL PROPERTIES
R-009
BALDWINVILLE, MASSACHUSETTS



REGION I SUPERFUND TECHNICAL ASSESSMENT AND RESPONSE TEAM


TDD #
05-07-0013

DRAWN BY:
W. SHAW

DATE
3/23/05

FILE NAME:
R:\05070013\FIGURES\PROPERTY DIAGRAMS\EXCAVATION DIAGRAMS\FIGURE 3\PHASE I\FIG_R009.DWG

FIGURE 3

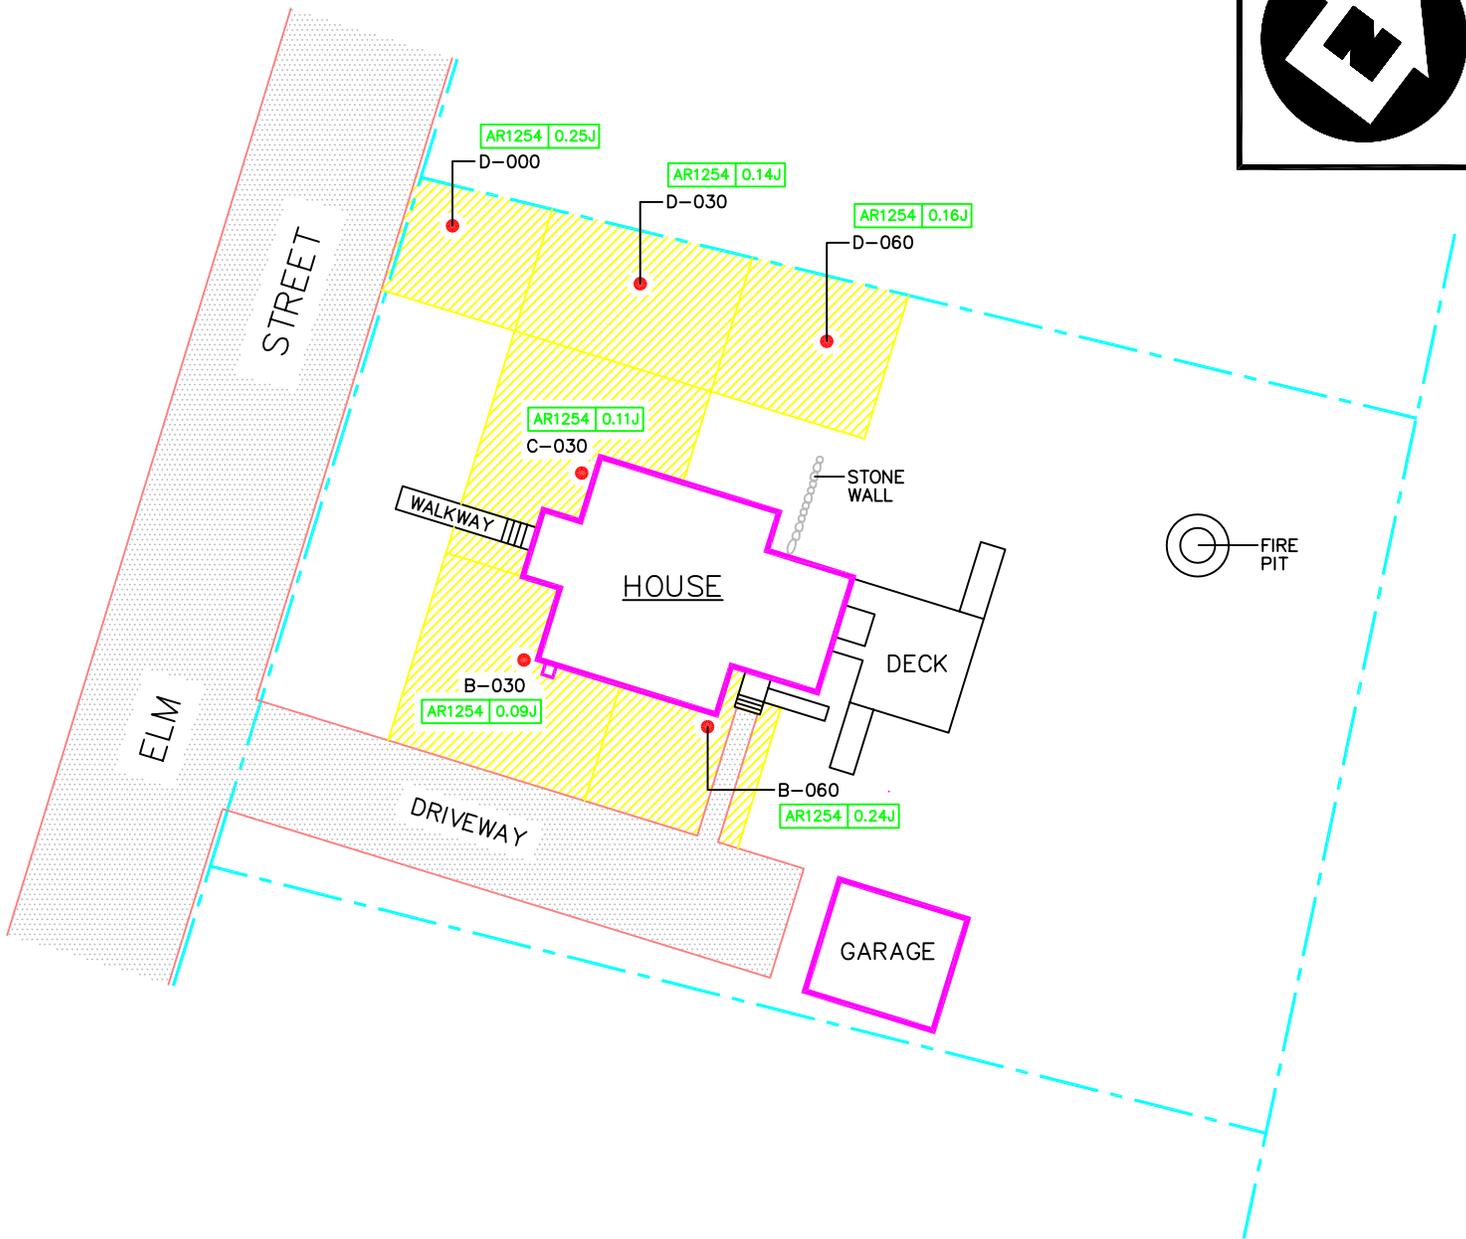

SOURCES:
 TOWN OF TEMPLETON, MASSACHUSETTS
 TAX ASSESSORS MAPS NOS. 6-4, AND 6.5
 APRIL 1964, REVISED JANUARY 2001
 NOT TO SCALE

LEGEND

- ASPHALT PAVEMENT
- SOIL SAMPLING LOCATION
- PROPERTY LINE
- DENOTES SOIL SAMPLING POINT IDENTIFICATION
- A-000 AROCLOR 1254 (PCB) RESULTS IN PARTS PER MILLION (PPM)
- AR1254 | 0.0
- EXCAVATION DEPTH 1 FOOT



NOTES:
 ALL RESULTS ARE REPORTED IN MG/KG (PARTS PER MILLION)
 ND = NOT DETECTED
 J = RESULT IS ESTIMATED

EXCAVATION DIAGRAM
 BALDWINVILLE RESIDENTIAL
 PROPERTIES
 R-010
 BALDWINVILLE, MASSACHUSETTS



REGION I SUPERFUND TECHNICAL ASSESSMENT AND RESPONSE TEAM

TDD # 05-07-0013	DRAWN BY: W. SHAW	DATE 3/31/05
FILE NAME: R:\05070013\FIGURES\PROPERTY DIAGRAMS\EXCAVATION DIAGRAMS\FIGURE 3\PHASE 1\FIG_R010.DWG		FIGURE 3

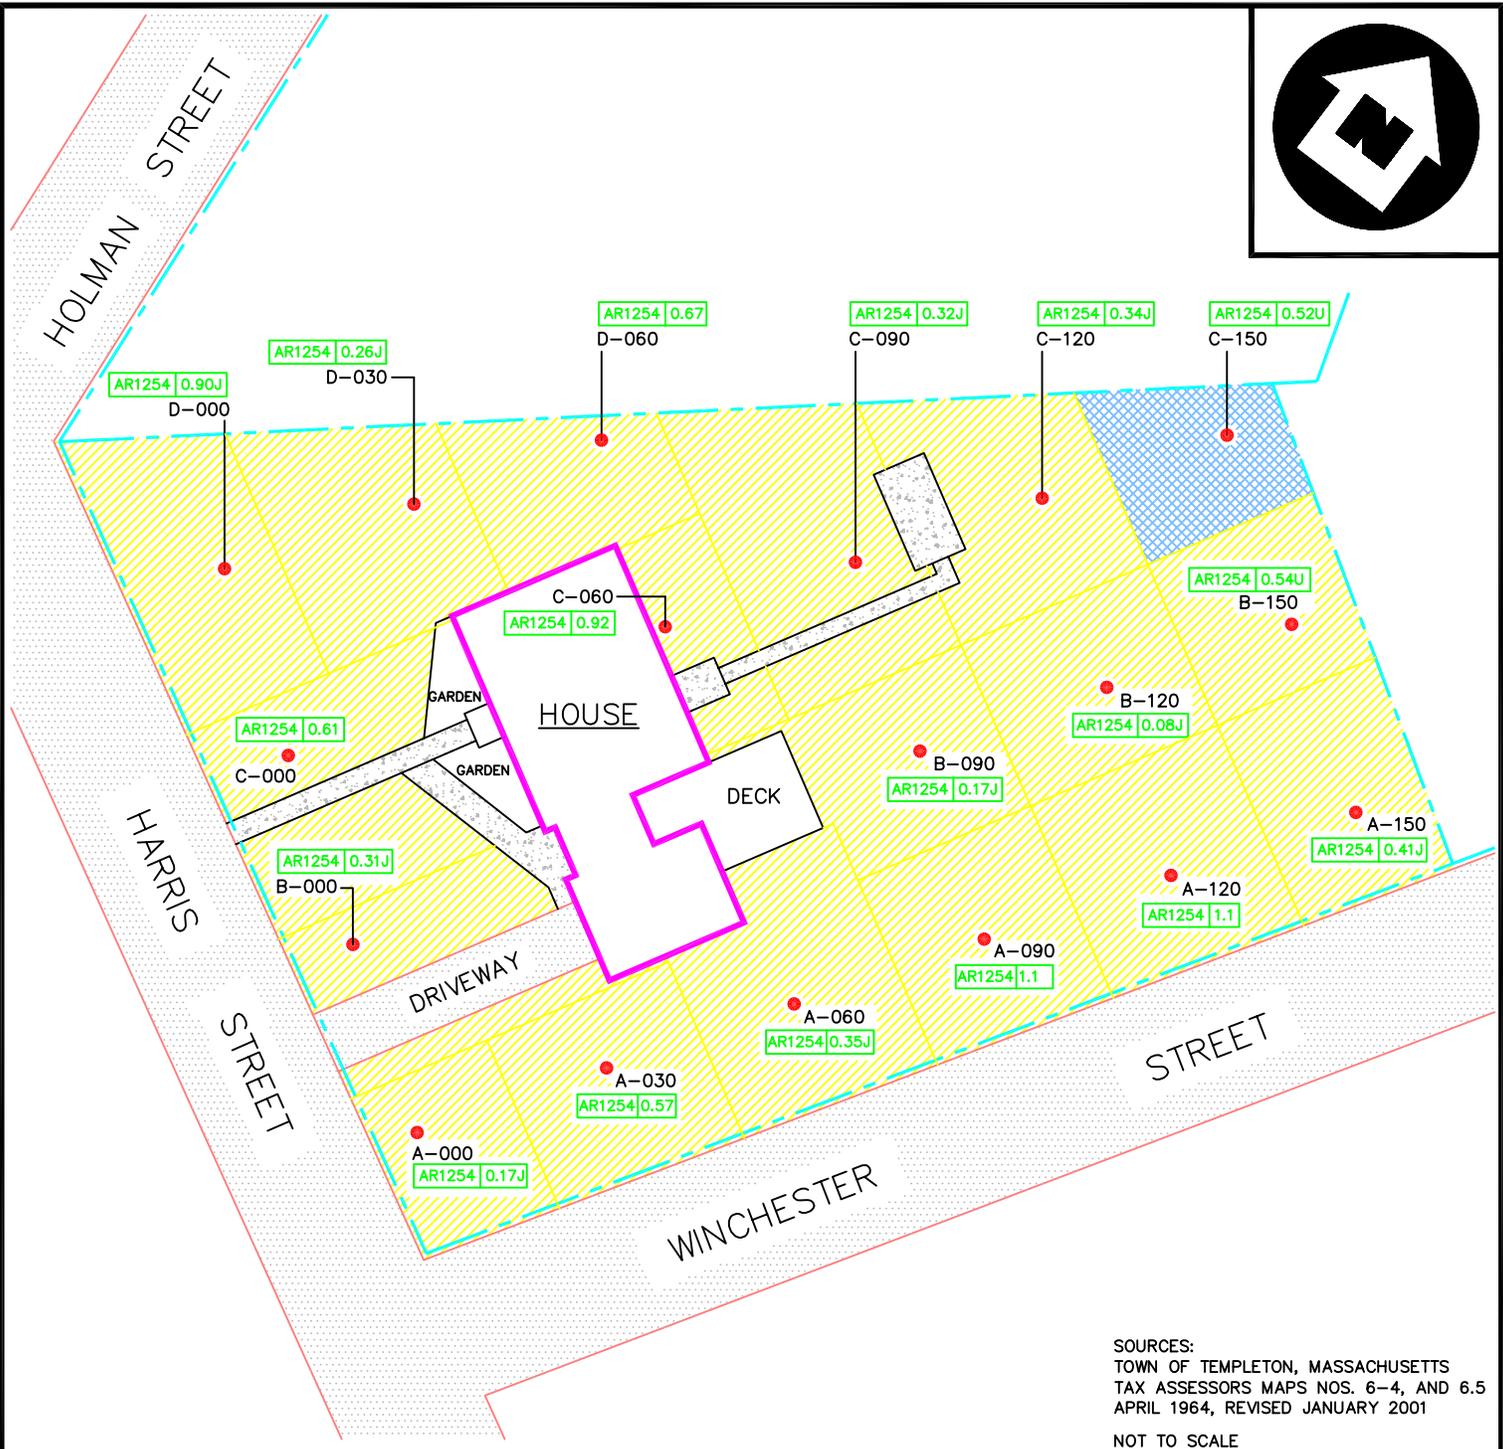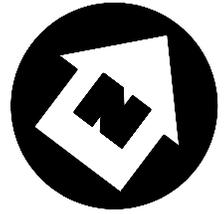

SOURCES:
TOWN OF TEMPLETON, MASSACHUSETTS
TAX ASSESSORS MAPS NOS. 6-4, AND 6.5
APRIL 1964, REVISED JANUARY 2001
NOT TO SCALE

LEGEND

- ASPHALT PAVEMENT
- CONCRETE WALKWAY
- PROPERTY LINE

- SOIL SAMPLING LOCATION

— DENOTES SOIL SAMPLING POINT IDENTIFICATION

A-000
AR1254 | 0.0 — AROCLOR 1254 (PCB) RESULTS IN PARTS PER MILLION (PPM)

NOTES:
ALL RESULTS ARE REPORTED IN MG/KG (PARTS PER MILLION)
ND = NOT DETECTED
J = RESULT IS ESTIMATED

EXCAVATION DEPTH

- 1 FOOT
- 1.5 FEET

EXCAVATION DIAGRAM
BALDWINVILLE RESIDENTIAL PROPERTIES
R-011
BALDWINVILLE, MASSACHUSETTS



REGION I SUPERFUND TECHNICAL ASSESSMENT AND RESPONSE TEAM



TDD #
05-07-0013

DRAWN BY:
W. SHAW

DATE
3/22/05

FILE NAME:
R:\05070013\FIGURES\PROPERTY DIAGRAMS\EXCAVATION DIAGRAMS\FIGURE 3\PHASE I\FIG_R011.DWG

FIGURE 3

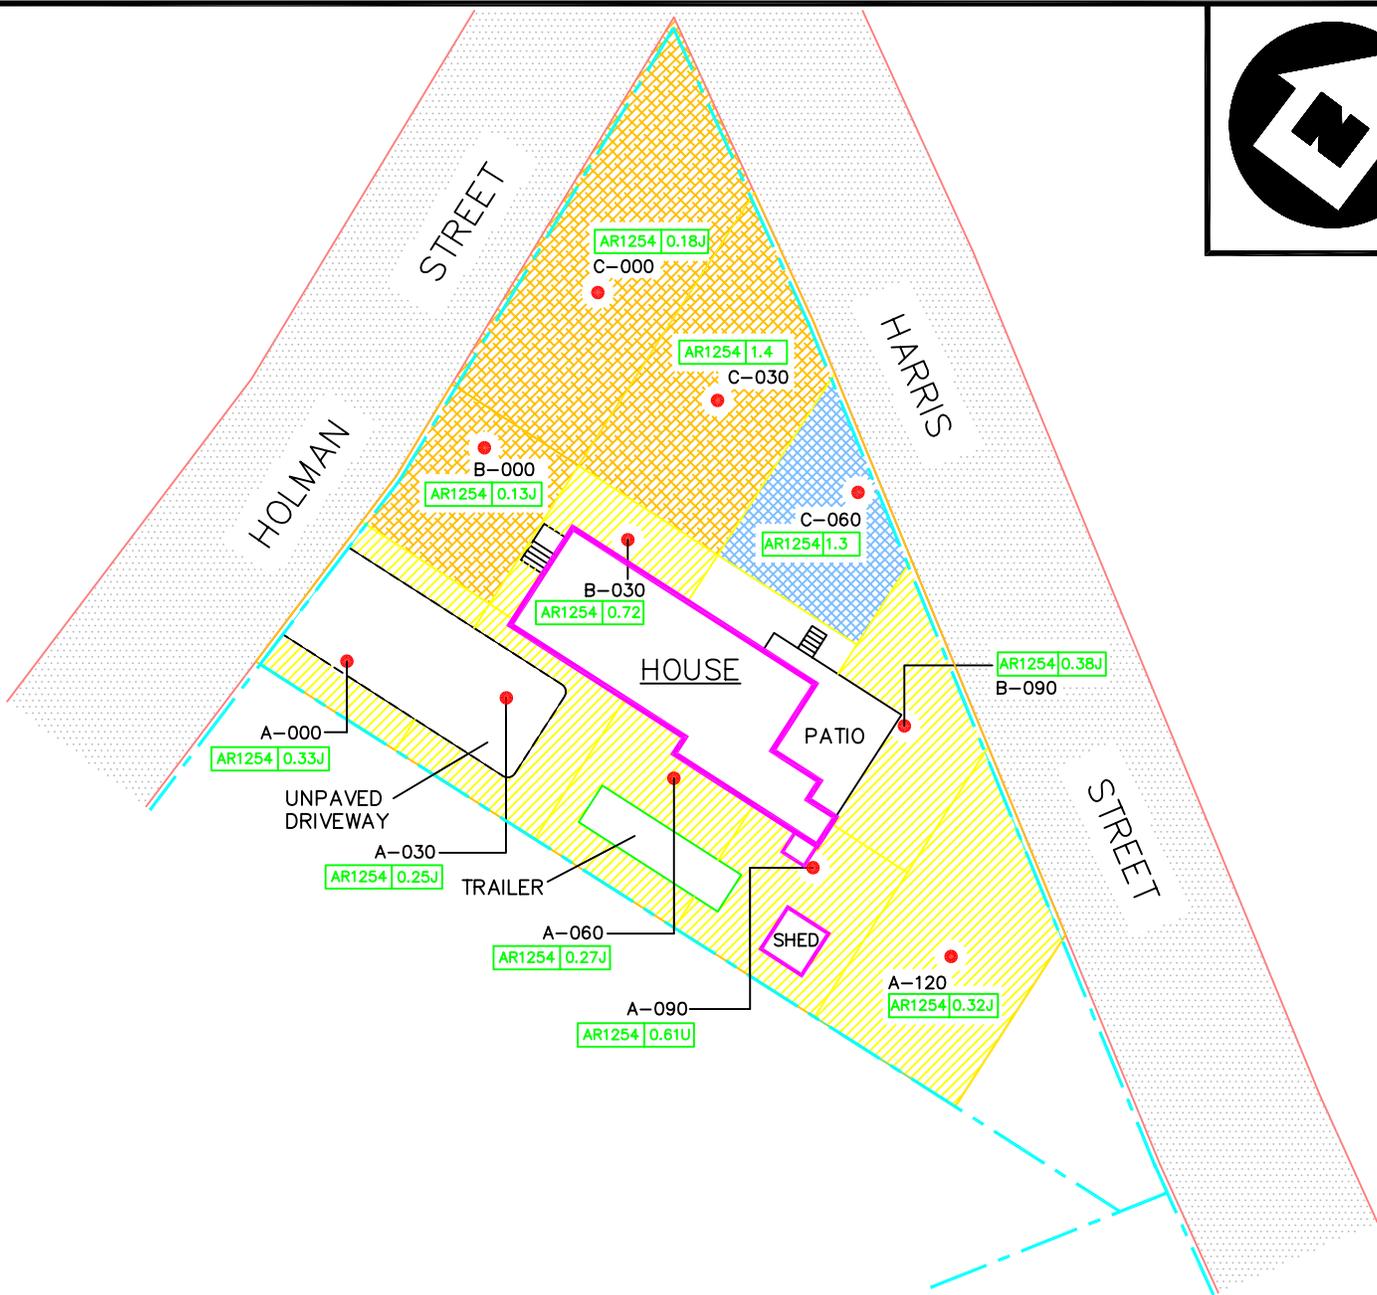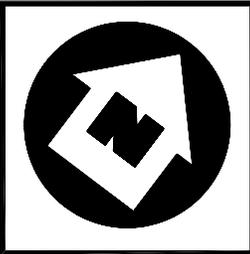

SOURCES:
 TOWN OF TEMPLETON, MASSACHUSETTS
 TAX ASSESSORS MAPS NOS. 6-4, AND 6.5
 APRIL 1964, REVISED JANUARY 2001
 NOT TO SCALE

LEGEND

○ ASPHALT PAVEMENT
 - - - PROPERTY LINE

● SOIL SAMPLING LOCATION

— DENOTES SOIL SAMPLING POINT IDENTIFICATION
 A-000 AROCLOR 1254 (PCB) RESULTS IN PARTS PER MILLION (PPM)
 AR1254 | 0.0

NOTES:
 ALL RESULTS ARE REPORTED IN MG/KG (PARTS PER MILLION)
 ND = NOT DETECTED
 J = RESULT IS ESTIMATED

EXCAVATION DEPTH
 ▨ 1 FOOT
 ▩ 1.5 FEET
 ▧ 2 FEET

EXCAVATION DIAGRAM
 BALDWINVILLE RESIDENTIAL PROPERTIES
 R-012
 BALDWINVILLE, MASSACHUSETTS



REGION I SUPERFUND TECHNICAL ASSESSMENT AND RESPONSE TEAM



TDD #
 05-07-0013

DRAWN BY:
 W. SHAW

DATE
 3/23/05

FILE NAME:
 R:\05070013\FIGURES\PROPERTY DIAGRAMS\EXCAVATION DIAGRAMS\FIGURE 3\PHASE 1\FIG_R012.DWG

FIGURE 3

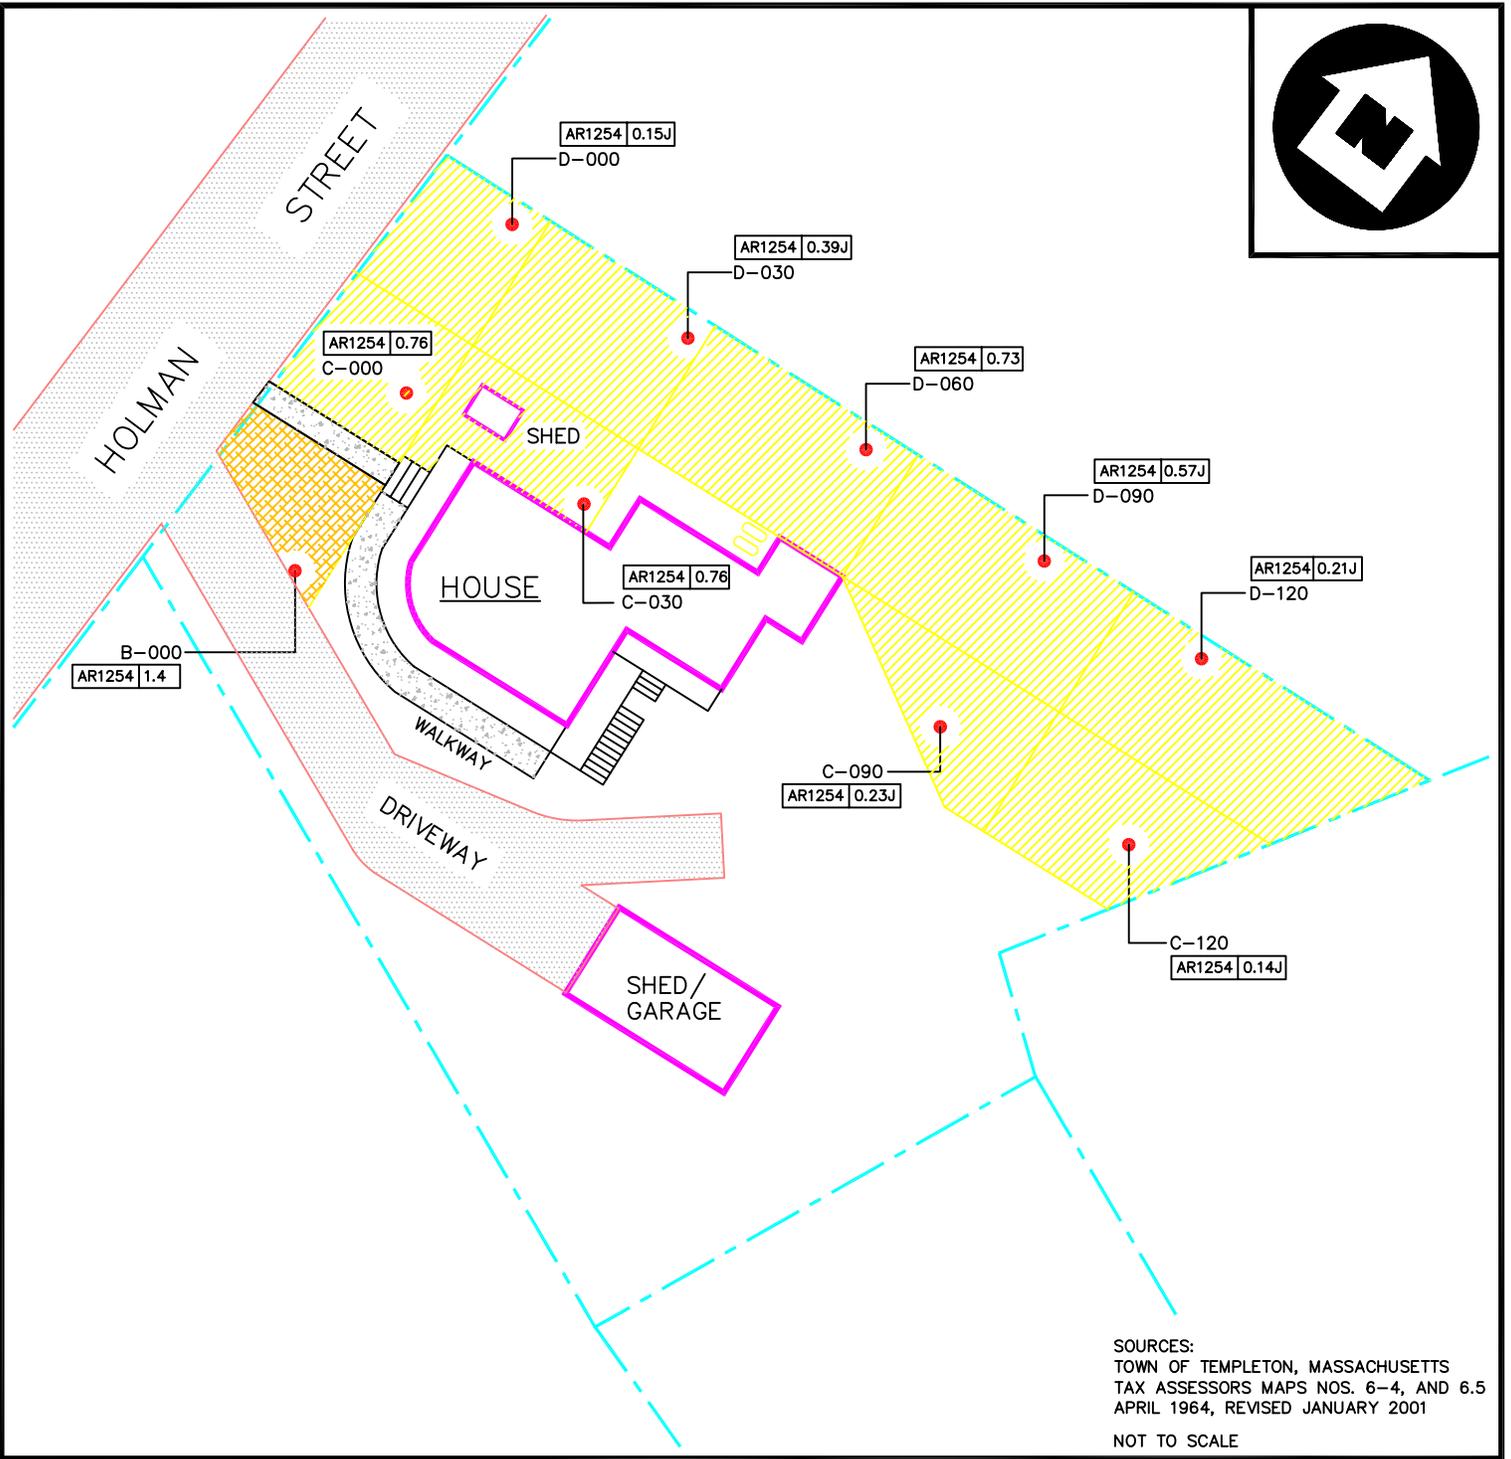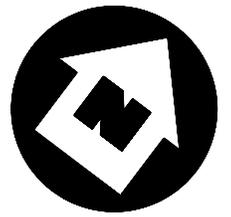

SOURCES:
TOWN OF TEMPLETON, MASSACHUSETTS
TAX ASSESSORS MAPS NOS. 6-4, AND 6.5
APRIL 1964, REVISED JANUARY 2001
NOT TO SCALE

LEGEND

- ASPHALT PAVEMENT
- CONCRETE WALKWAY
- ABOVEGROUND STORAGE TANKS (AST)
- PROPERTY LINE

- SOIL SAMPLING LOCATION
- DENOTES SOIL SAMPLING POINT IDENTIFICATION
- AROCLOR 1254 (PCB) RESULTS IN PARTS PER MILLION (PPM)



NOTES:
ALL RESULTS ARE REPORTED IN MG/KG (PARTS PER MILLION)
ND = NOT DETECTED
J = RESULT IS ESTIMATED

- EXCAVATION DEPTH 1 FOOT
- EXCAVATION DEPTH 2 FEET

EXCAVATION DIAGRAM
BALDWINVILLE RESIDENTIAL PROPERTIES
R-013
BALDWINVILLE, MASSACHUSETTS

REGION I SUPERFUND TECHNICAL ASSESSMENT AND RESPONSE TEAM

TDD # 05-07-0013	DRAWN BY: W. SHAW	DATE 3/23/05
FILE NAME: R:\05070013\FIGURES\PROPERTY DIAGRAMS\EXCAVATION DIAGRAMS\FIGURE 3\PHASE 1\FIG_R013.DWG		FIGURE 3

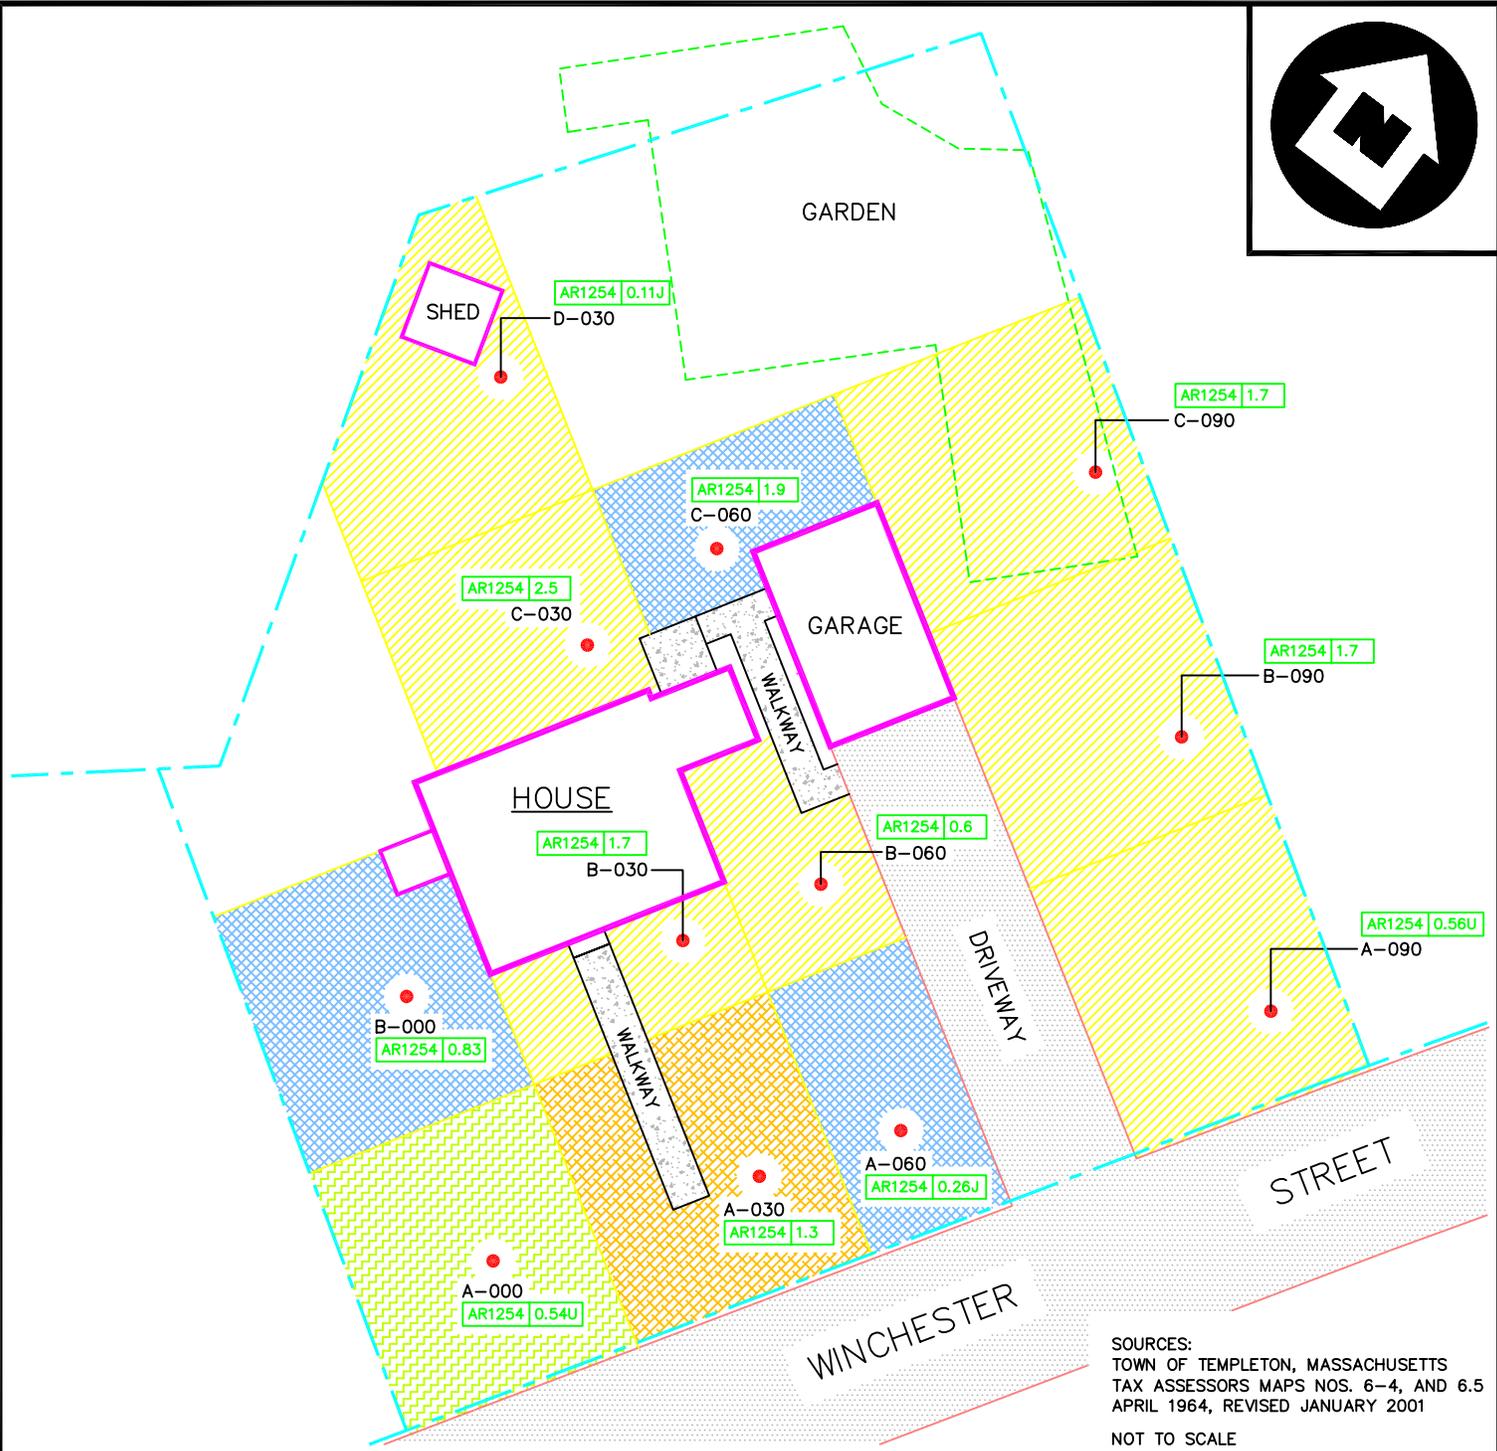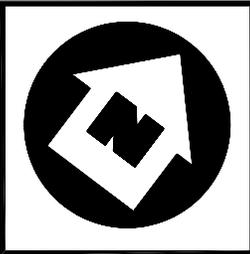

SOURCES:
TOWN OF TEMPLETON, MASSACHUSETTS
TAX ASSESSORS MAPS NOS. 6-4, AND 6.5
APRIL 1964, REVISED JANUARY 2001
NOT TO SCALE

LEGEND

- ASPHALT PAVEMENT
- CONCRETE WALKWAY
- PROPERTY LINE
- SOIL SAMPLING LOCATION
- DENOTES SOIL SAMPLING POINT IDENTIFICATION
- AROCLOR 1254 (PCB) RESULTS IN PARTS PER MILLION (PPM)


NOTES:
ALL RESULTS ARE REPORTED IN MG/KG (PARTS PER MILLION)
ND = NOT DETECTED
J = RESULT IS ESTIMATED

- EXCAVATION DEPTH 1 FOOT
- EXCAVATION DEPTH 1.5 FEET
- EXCAVATION DEPTH 2 FEET
- EXCAVATION DEPTH 3 FEET

EXCAVATION DIAGRAM
BALDWINVILLE RESIDENTIAL PROPERTIES
R-014
BALDWINVILLE, MASSACHUSETTS

REGION I SUPERFUND TECHNICAL ASSESSMENT AND RESPONSE TEAM

TDD # 05-07-0013	DRAWN BY: W. SHAW	DATE 3/24/05
FILE NAME: R:\05070013\FIGURES\PROPERTY DIAGRAMS\EXCAVATION DIAGRAMS\FIGURE 3\PHASE I\FIG_R014.DWG		FIGURE 3

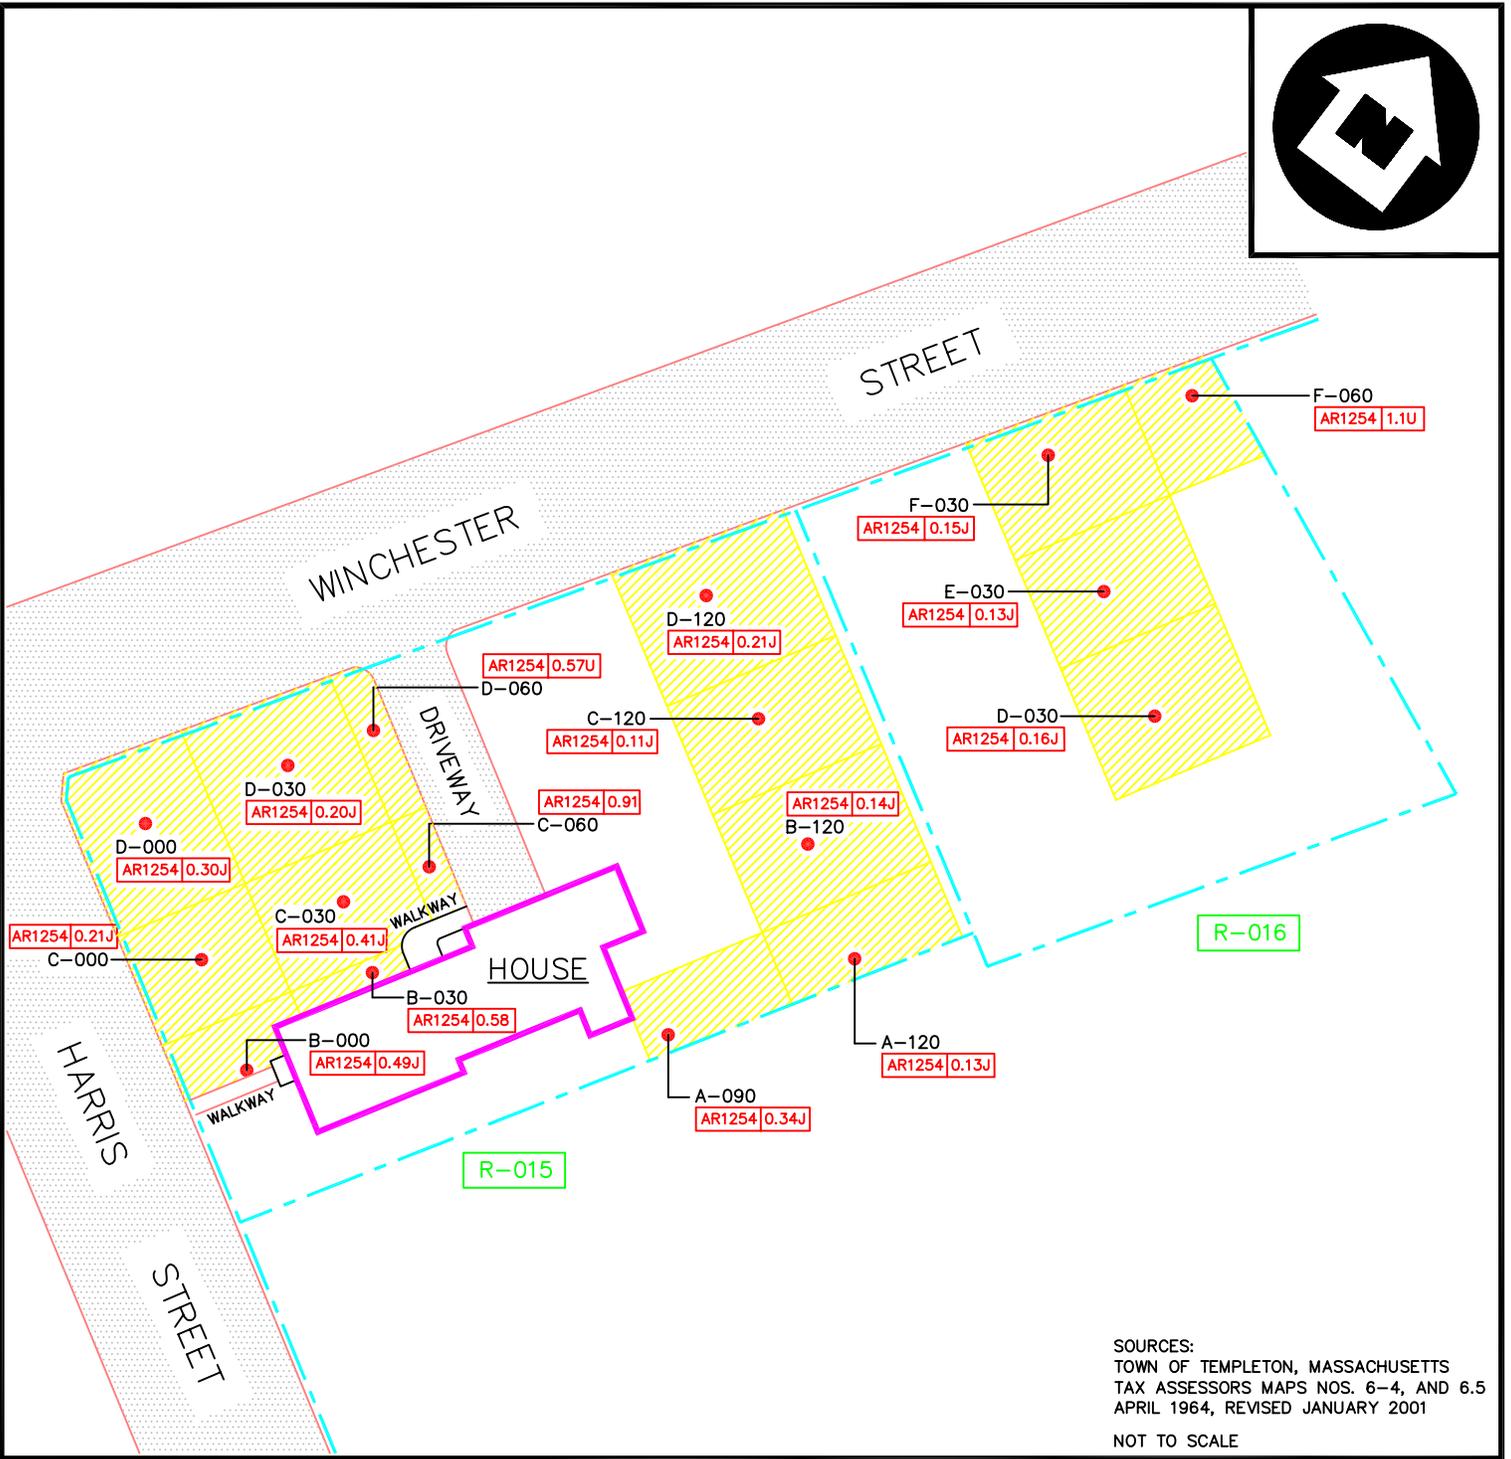

SOURCES:
TOWN OF TEMPLETON, MASSACHUSETTS
TAX ASSESSORS MAPS NOS. 6-4, AND 6.5
APRIL 1964, REVISED JANUARY 2001
NOT TO SCALE

LEGEND

○ ASPHALT PAVEMENT
- - - PROPERTY LINE

● SOIL SAMPLING LOCATION

— DENOTES SOIL SAMPLING POINT IDENTIFICATION

A-000
AR1254 | 0.0 — AROCLOR 1254 (PCB) RESULTS IN PARTS PER MILLION (PPM)

NOTES:
ALL RESULTS ARE REPORTED IN MG/KG (PARTS PER MILLION)
ND = NOT DETECTED
J = RESULT IS ESTIMATED

EXCAVATION DEPTH
1 FOOT

EXCAVATION DIAGRAM
BALDWINVILLE RESIDENTIAL PROPERTIES
R-015 & R-016
BALDWINVILLE, MASSACHUSETTS



REGION I SUPERFUND TECHNICAL ASSESSMENT AND RESPONSE TEAM



TDD #
05-07-0013

DRAWN BY:
W. SHAW

DATE
3/29/05

FILE NAME:
R:\05070013\FIGURES\PROPERTY DIAGRAMS\EXCAVATION DIAGRAMS\FIGURE 3\PHASE I\FIG_R015_016.DWG

FIGURE 3

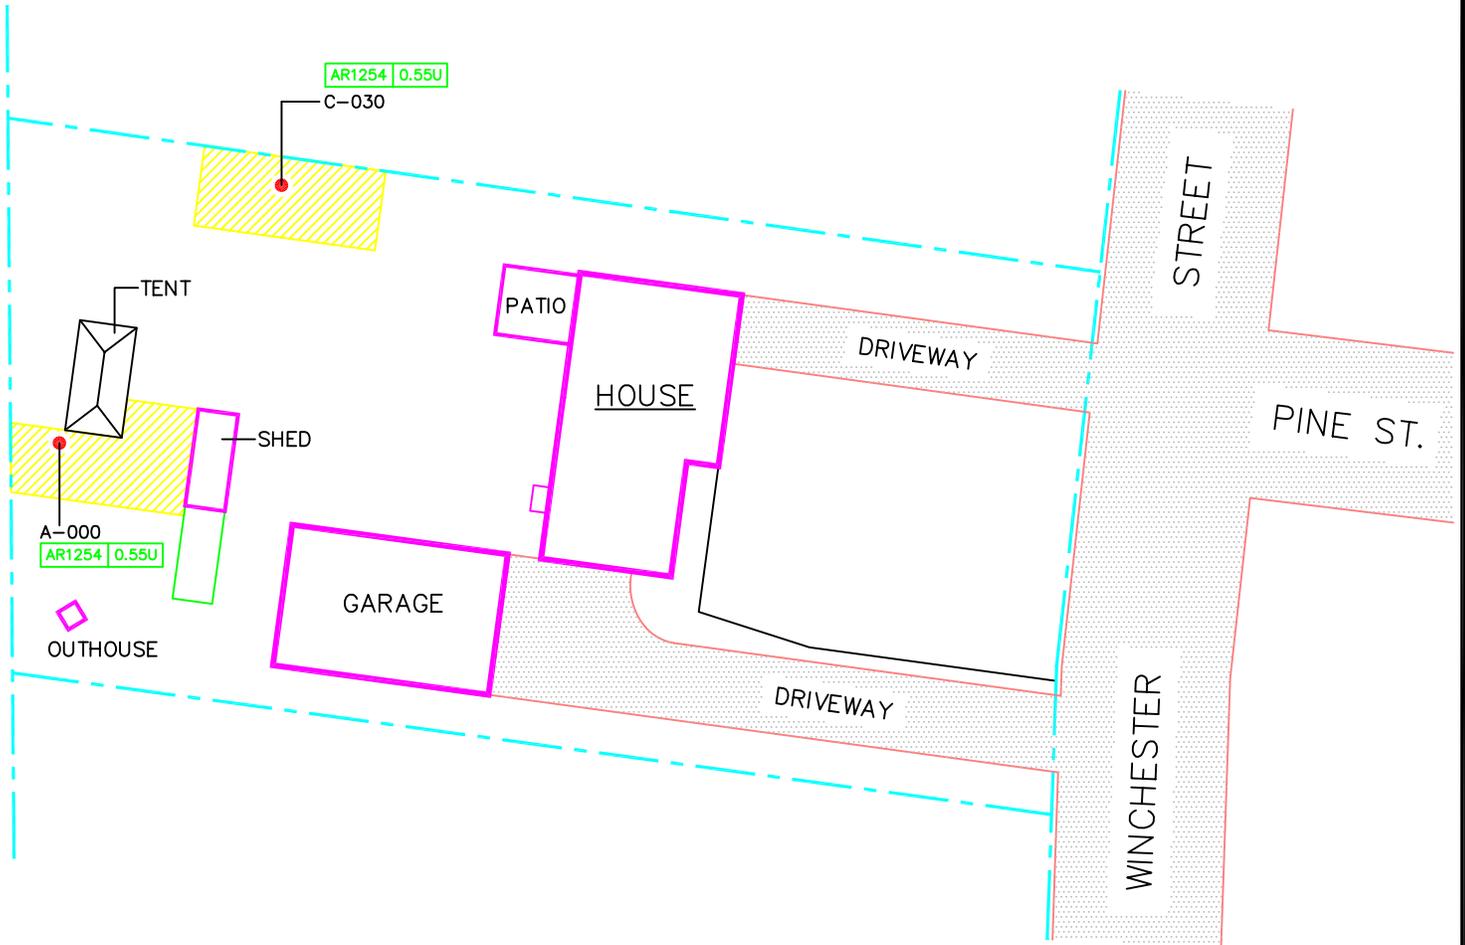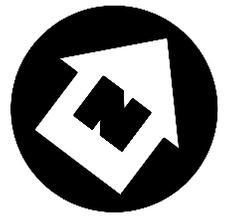

SOURCES:
 TOWN OF TEMPLETON, MASSACHUSETTS
 TAX ASSESSORS MAPS NOS. 6-4, AND 6.5
 APRIL 1964, REVISED JANUARY 2001
 NOT TO SCALE

LEGEND

○ ASPHALT PAVEMENT
 - - - PROPERTY LINE

● SOIL SAMPLING LOCATION

— DENOTES SOIL SAMPLING POINT IDENTIFICATION

A-000 AROCLOR 1254 (PCB) RESULTS IN PARTS PER MILLION (PPM)
 AR1254 | 0.0

NOTES:
 ALL RESULTS ARE REPORTED IN MG/KG (PARTS PER MILLION)
 ND = NOT DETECTED
 J = RESULT IS ESTIMATED

EXCAVATION DEPTH
 1 FOOT

EXCAVATION DIAGRAM

BALDWINVILLE RESIDENTIAL PROPERTIES
 R-019

BALDWINVILLE, MASSACHUSETTS



REGION I SUPERFUND TECHNICAL ASSESSMENT AND RESPONSE TEAM


TDD #
 05-07-0013

DRAWN BY:
 W. SHAW

DATE
 3/31/05

FILE NAME:
 R:\05070013\FIGURES\PROPERTY DIAGRAMS\EXCAVATION DIAGRAMS\FIGURE 3\PHASE I\FIG_R019.DWG

FIGURE 3

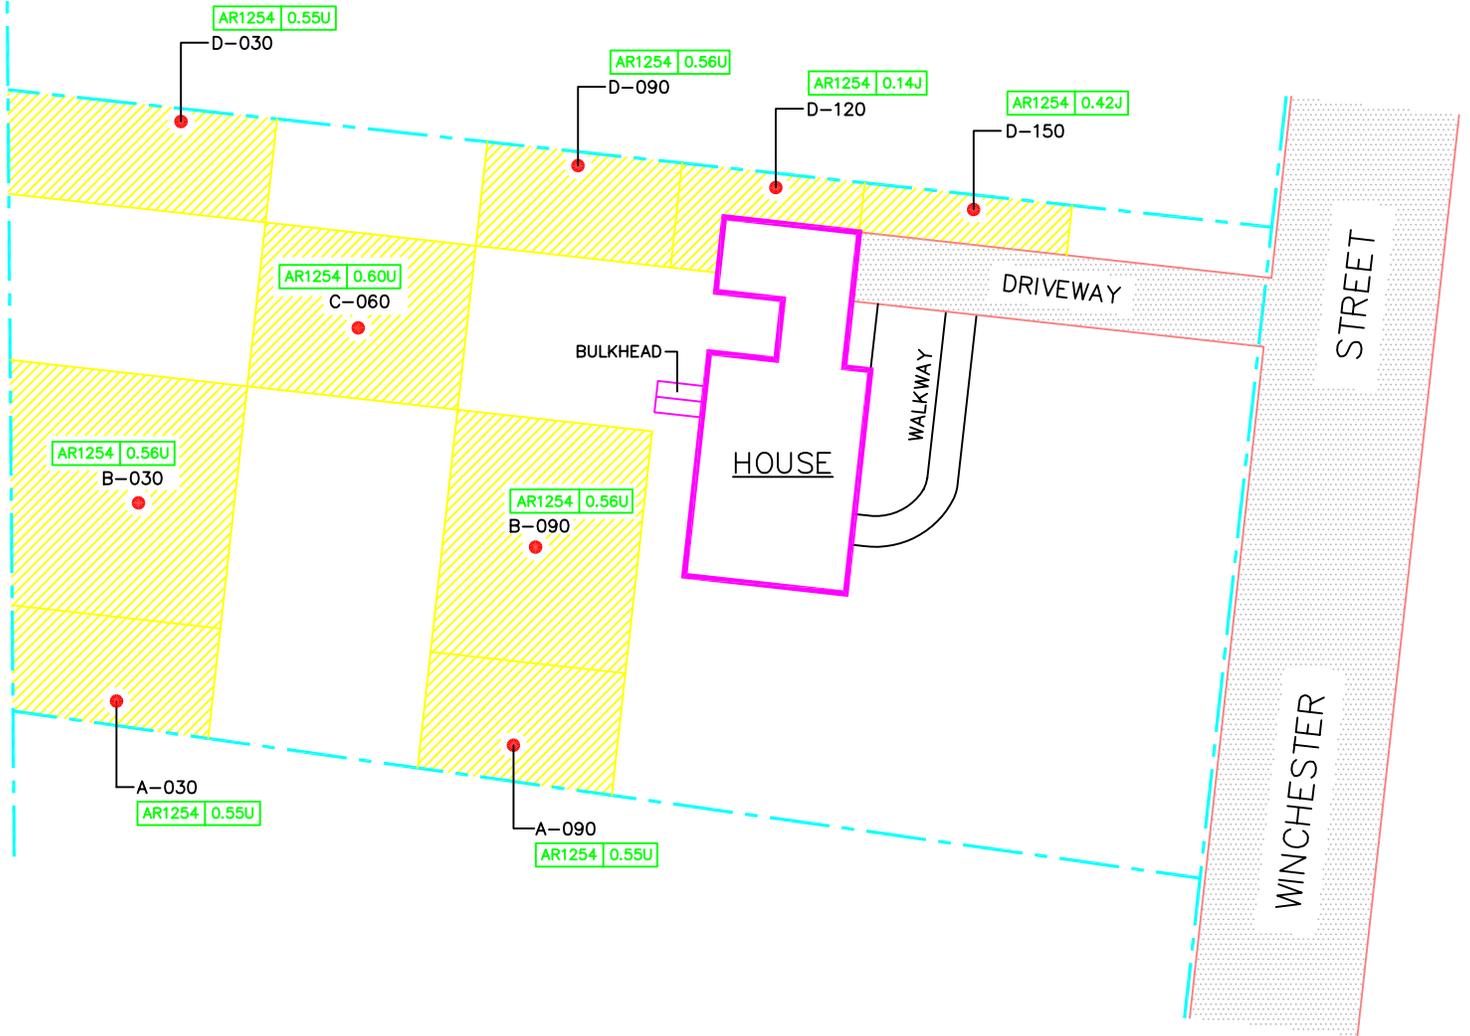

SOURCES:
TOWN OF TEMPLETON, MASSACHUSETTS
TAX ASSESSORS MAPS NOS. 6-4, AND 6.5
APRIL 1964, REVISED JANUARY 2001
NOT TO SCALE

LEGEND

ASPHALT PAVEMENT
 PROPERTY LINE

SOIL SAMPLING LOCATION

DENOTES SOIL SAMPLING POINT IDENTIFICATION

A-000
AR1254 0.0

AROCLOR 1254 (PCB) RESULTS IN PARTS PER MILLION (PPM)

NOTES:
ALL RESULTS ARE REPORTED IN MG/KG (PARTS PER MILLION)
ND = NOT DETECTED
J = RESULT IS ESTIMATED

EXCAVATION DEPTH
 1 FOOT

EXCAVATION DIAGRAM
BALDWINVILLE RESIDENTIAL PROPERTIES
R-020
BALDWINVILLE, MASSACHUSETTS



REGION I SUPERFUND TECHNICAL ASSESSMENT AND RESPONSE TEAM



TDD #
05-07-0013

DRAWN BY:
W. SHAW

DATE
3/31/05

FILE NAME:
R:\05070013\FIGURES\PROPERTY DIAGRAMS\EXCAVATION DIAGRAMS\FIGURE 3\PHASE 1\FIG_R020.DWG

FIGURE 3

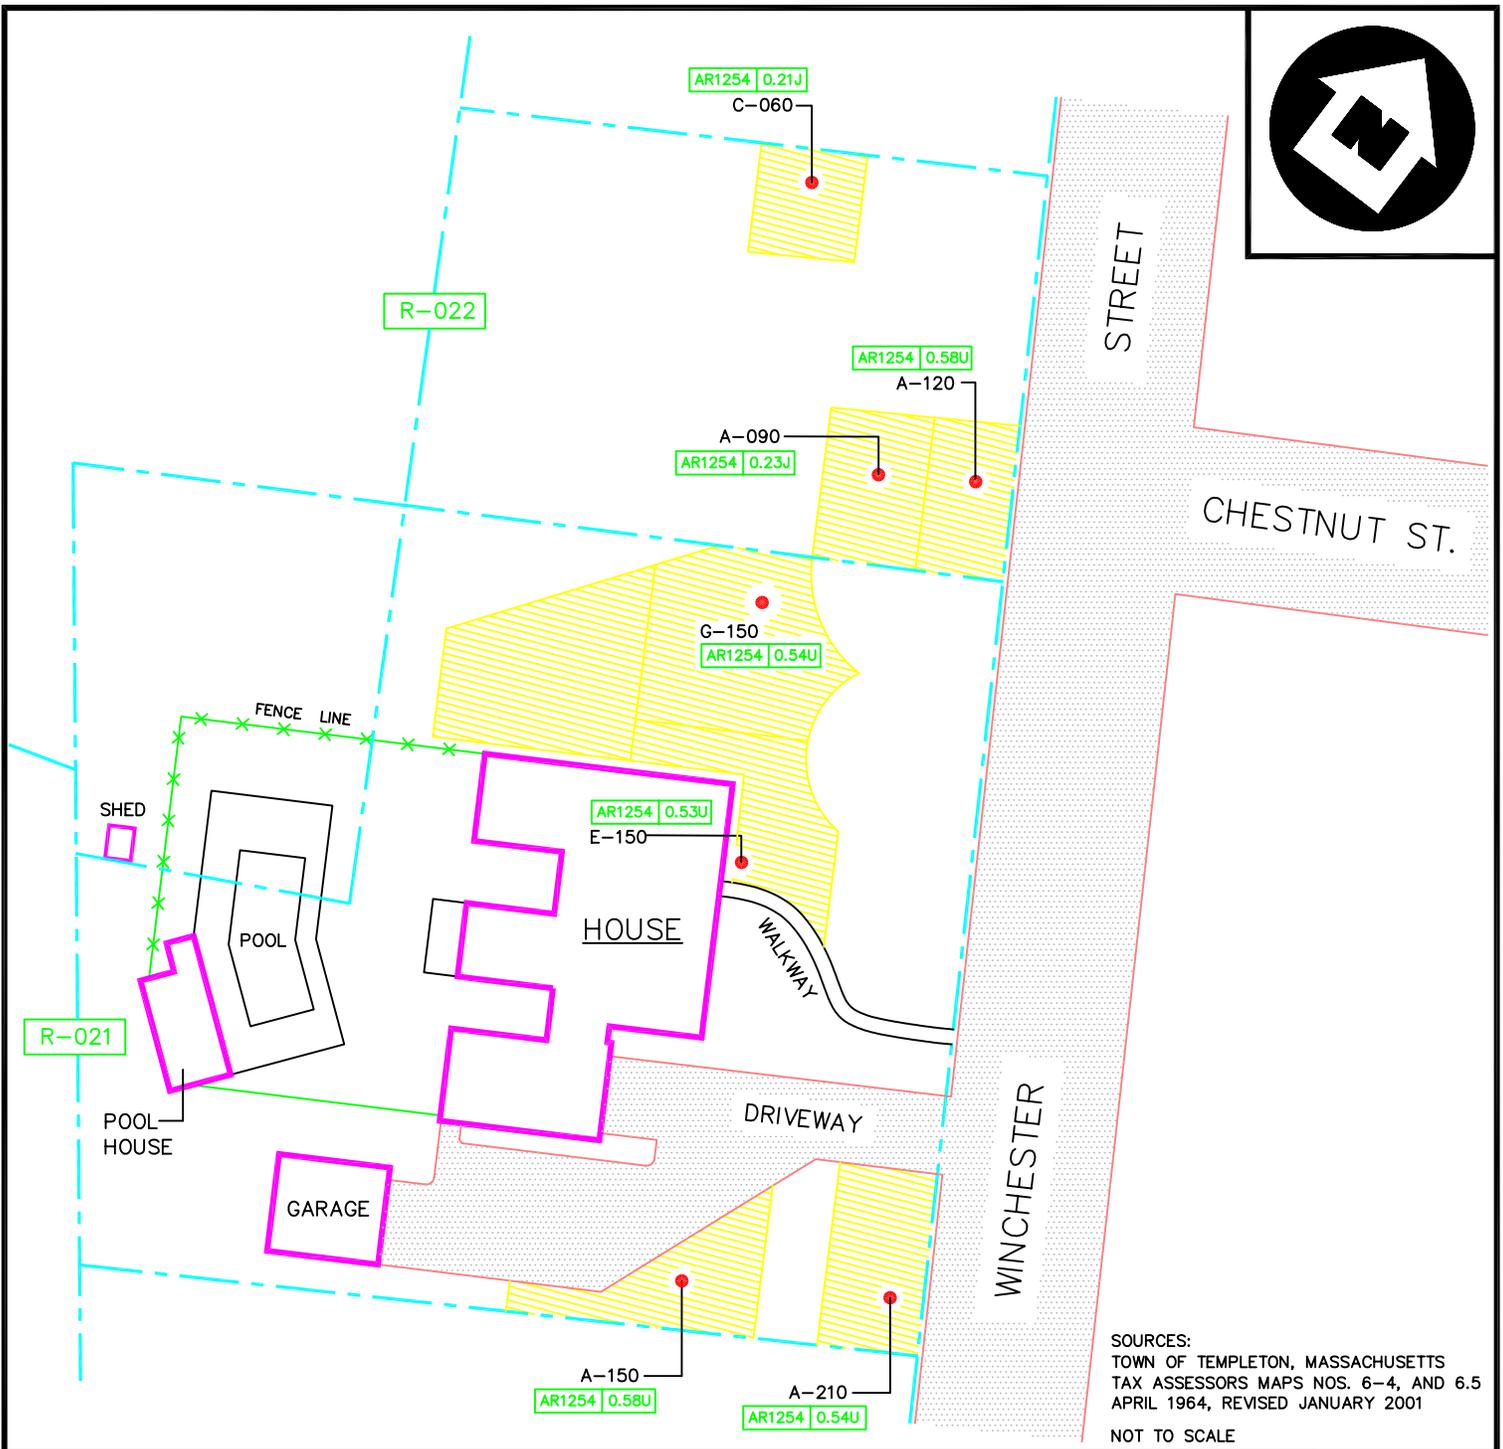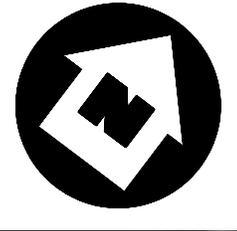

SOURCES:
 TOWN OF TEMPLETON, MASSACHUSETTS
 TAX ASSESSORS MAPS NOS. 6-4, AND 6.5
 APRIL 1964, REVISED JANUARY 2001
 NOT TO SCALE

LEGEND

- PROPERTY LINE
- SOIL SAMPLING LOCATION
- EXCAVATION DEPTH 1 FOOT
- PAVED AREA
- DENOTES SOIL SAMPLING POINT IDENTIFICATION
- NOTES:**
 ALL RESULTS ARE REPORTED IN MG/KG (PARTS PER MILLION)
 ND = NOT DETECTED
 J = RESULT IS ESTIMATED
- A-000** AROCLOR 1254 (PCB) RESULTS IN PARTS PER MILLION (PPM)
 AR1254 | 0.0



EXCAVATION DIAGRAM
 BALDWINVILLE RESIDENTIAL PROPERTIES
 R-021 & R-022
 BALDWINVILLE, MASSACHUSETTS



REGION I SUPERFUND TECHNICAL ASSESSMENT AND RESPONSE TEAM

TDD # 05-07-0013	DRAWN BY: W. SHAW	DATE 3/16/05
---------------------	----------------------	-----------------

FILE NAME: R:\05070013\FIGURES\PROPERTY DIAGRAMS\EXCAVATION DIAGRAMS\FIGURE 3\PHASE I\FIG_R021_022.DWG	FIGURE 3
---	-----------------

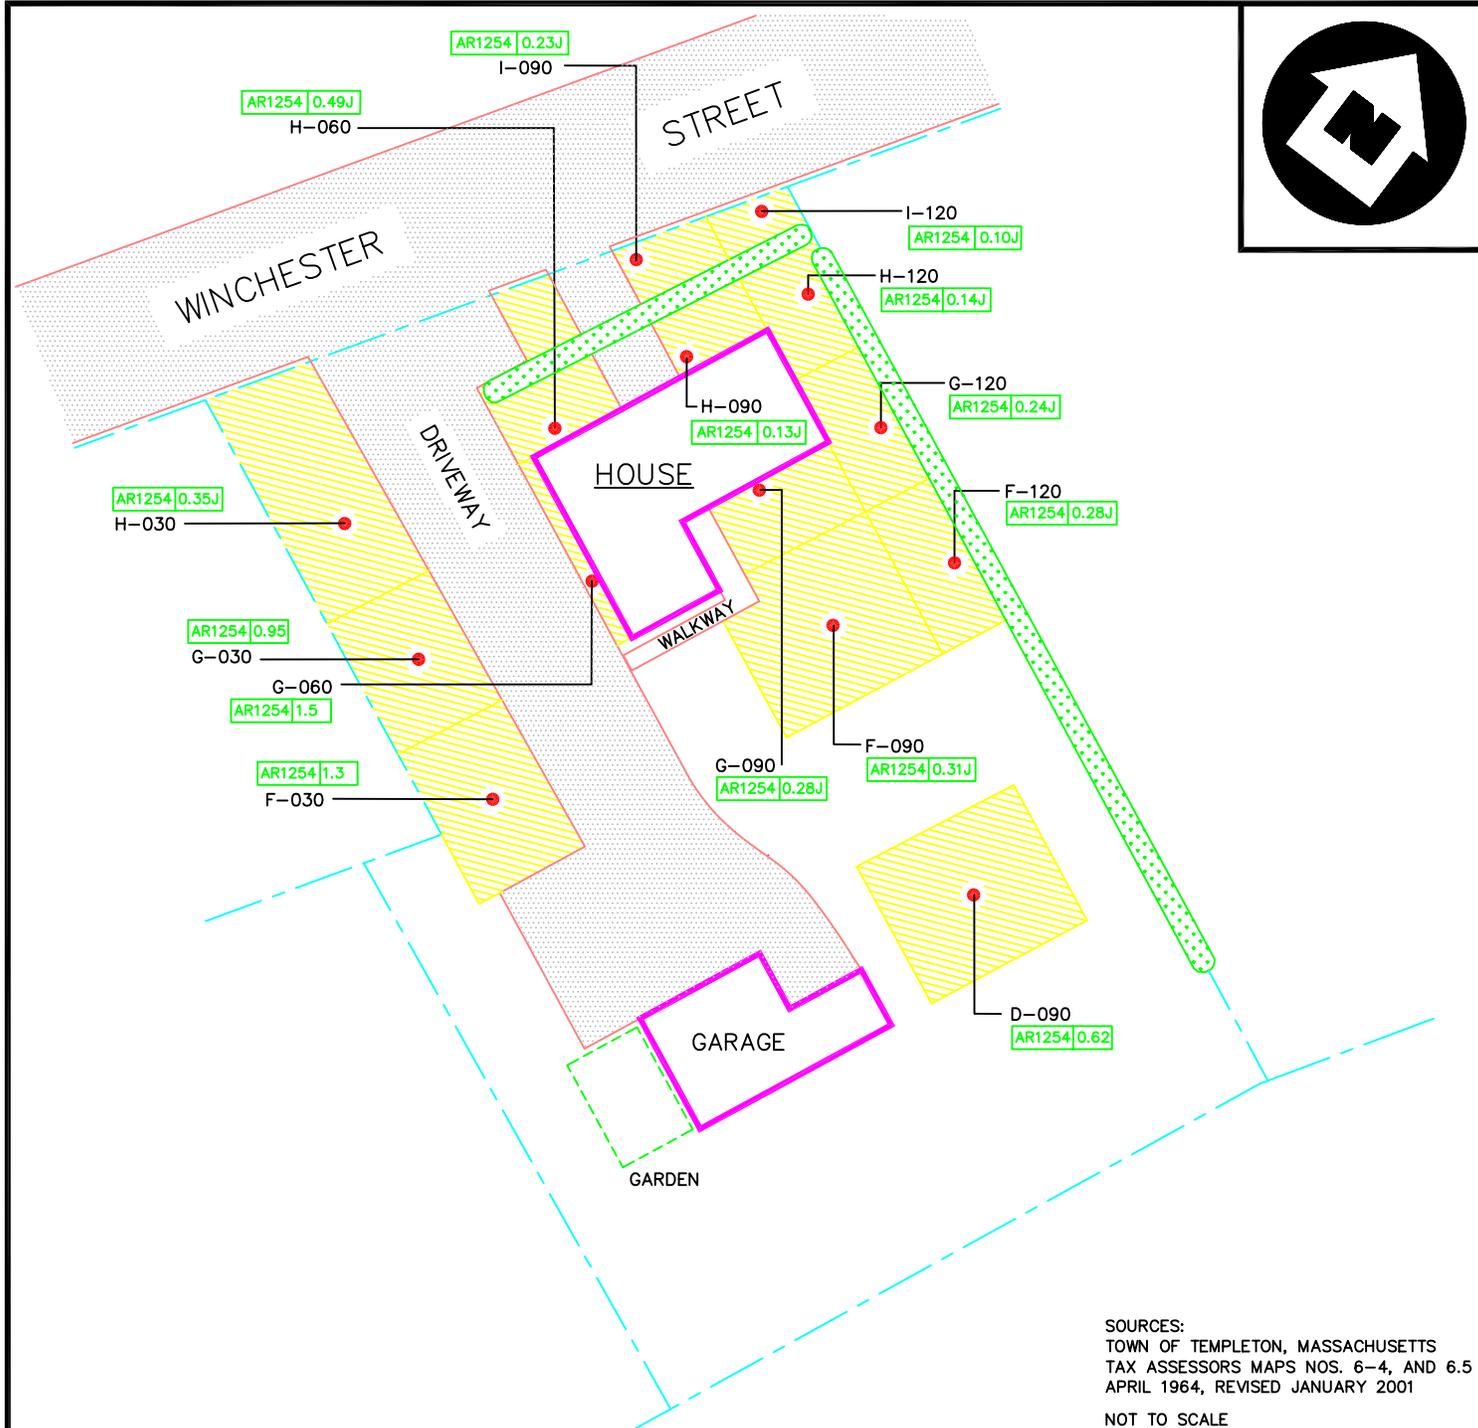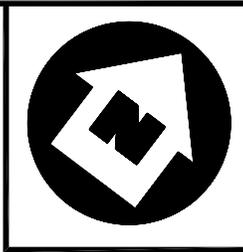

SOURCES:
 TOWN OF TEMPLETON, MASSACHUSETTS
 TAX ASSESSORS MAPS NOS. 6-4, AND 6.5
 APRIL 1964, REVISED JANUARY 2001
 NOT TO SCALE



LEGEND

- PAVED AREA
- SOIL SAMPLING LOCATION
- PROPERTY LINE
- PRIVET HEDGE (NOT EXCAVATED)
- DENOTES SOIL SAMPLING POINT IDENTIFICATION
- AROCLOR 1254 (PCB) RESULTS IN PARTS PER MILLION (PPM)
- NOTES:
ALL RESULTS ARE REPORTED IN MG/KG (PARTS PER MILLION)
ND = NOT DETECTED
J = RESULT IS ESTIMATED
- EXCAVATION DEPTH 1 FOOT

EXCAVATION DIAGRAM
 BALDWINVILLE RESIDENTIAL
 PROPERTIES
 R-028
 BALDWINVILLE, MASSACHUSETTS

WESTON SOLUTIONS
 REGION I SUPERFUND TECHNICAL ASSESSMENT AND RESPONSE TEAM

TDD # 05-07-0013	DRAWN BY: W. SHAW	DATE 2/18/05
FILE NAME: R:\05070013\FIGURES\PROPERTY DIAGRAMS\EXCAVATION DIAGRAMS\FIGURE 3\PHASE I\FIG_R028.DWG		FIGURE 3

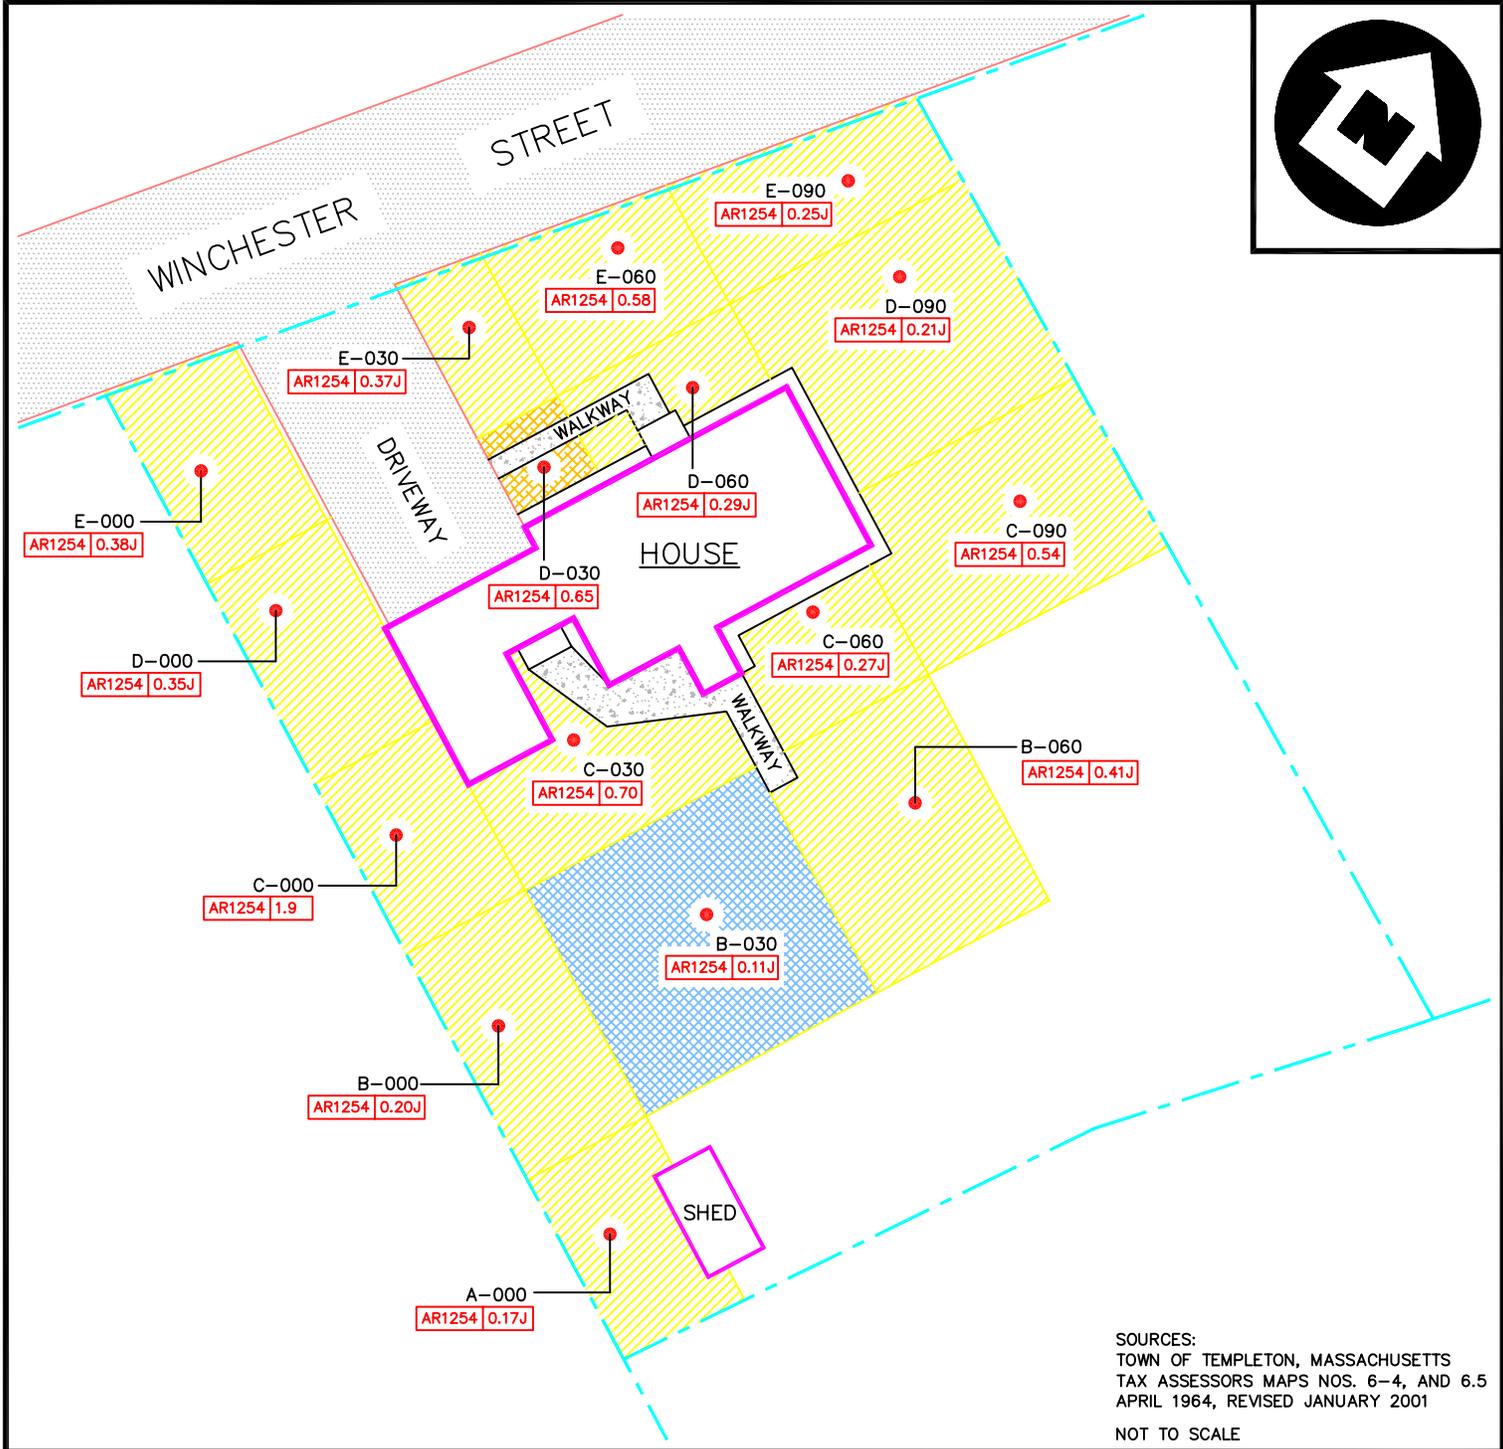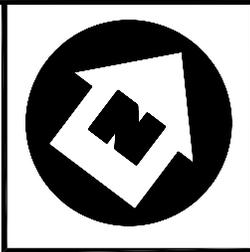

SOURCES:
TOWN OF TEMPLETON, MASSACHUSETTS
TAX ASSESSORS MAPS NOS. 6-4, AND 6.5
APRIL 1964, REVISED JANUARY 2001
NOT TO SCALE

LEGEND

- ASPHALT PAVEMENT
- CONCRETE WALKWAY
- PROPERTY LINE
- SOIL SAMPLING LOCATION
- DENOTES SOIL SAMPLING POINT IDENTIFICATION
- A-000 AROCLOR 1254 (PCB) RESULTS IN PARTS PER MILLION (PPM)

NOTES:
ALL RESULTS ARE REPORTED IN MG/KG (PARTS PER MILLION)
ND = NOT DETECTED
J = RESULT IS ESTIMATED

- EXCAVATION DEPTH 1 FOOT
- EXCAVATION DEPTH 1.5 FEET
- EXCAVATION DEPTH 2 FEET

EXCAVATION DIAGRAM

BALDWINVILLE RESIDENTIAL
PROPERTIES
R-029



BALDWINVILLE, MASSACHUSETTS



REGION I SUPERFUND TECHNICAL ASSESSMENT AND RESPONSE TEAM

TDD # 05-07-0013	DRAWN BY: W. SHAW	DATE 3/24/05
---------------------	----------------------	-----------------

FILE NAME: R:\05070013\FIGURES\PROPERTY DIAGRAMS\EXCAVATION DIAGRAMS\FIGURE 3\PHASE I\FIG_R029.DWG	FIGURE 3
--	----------

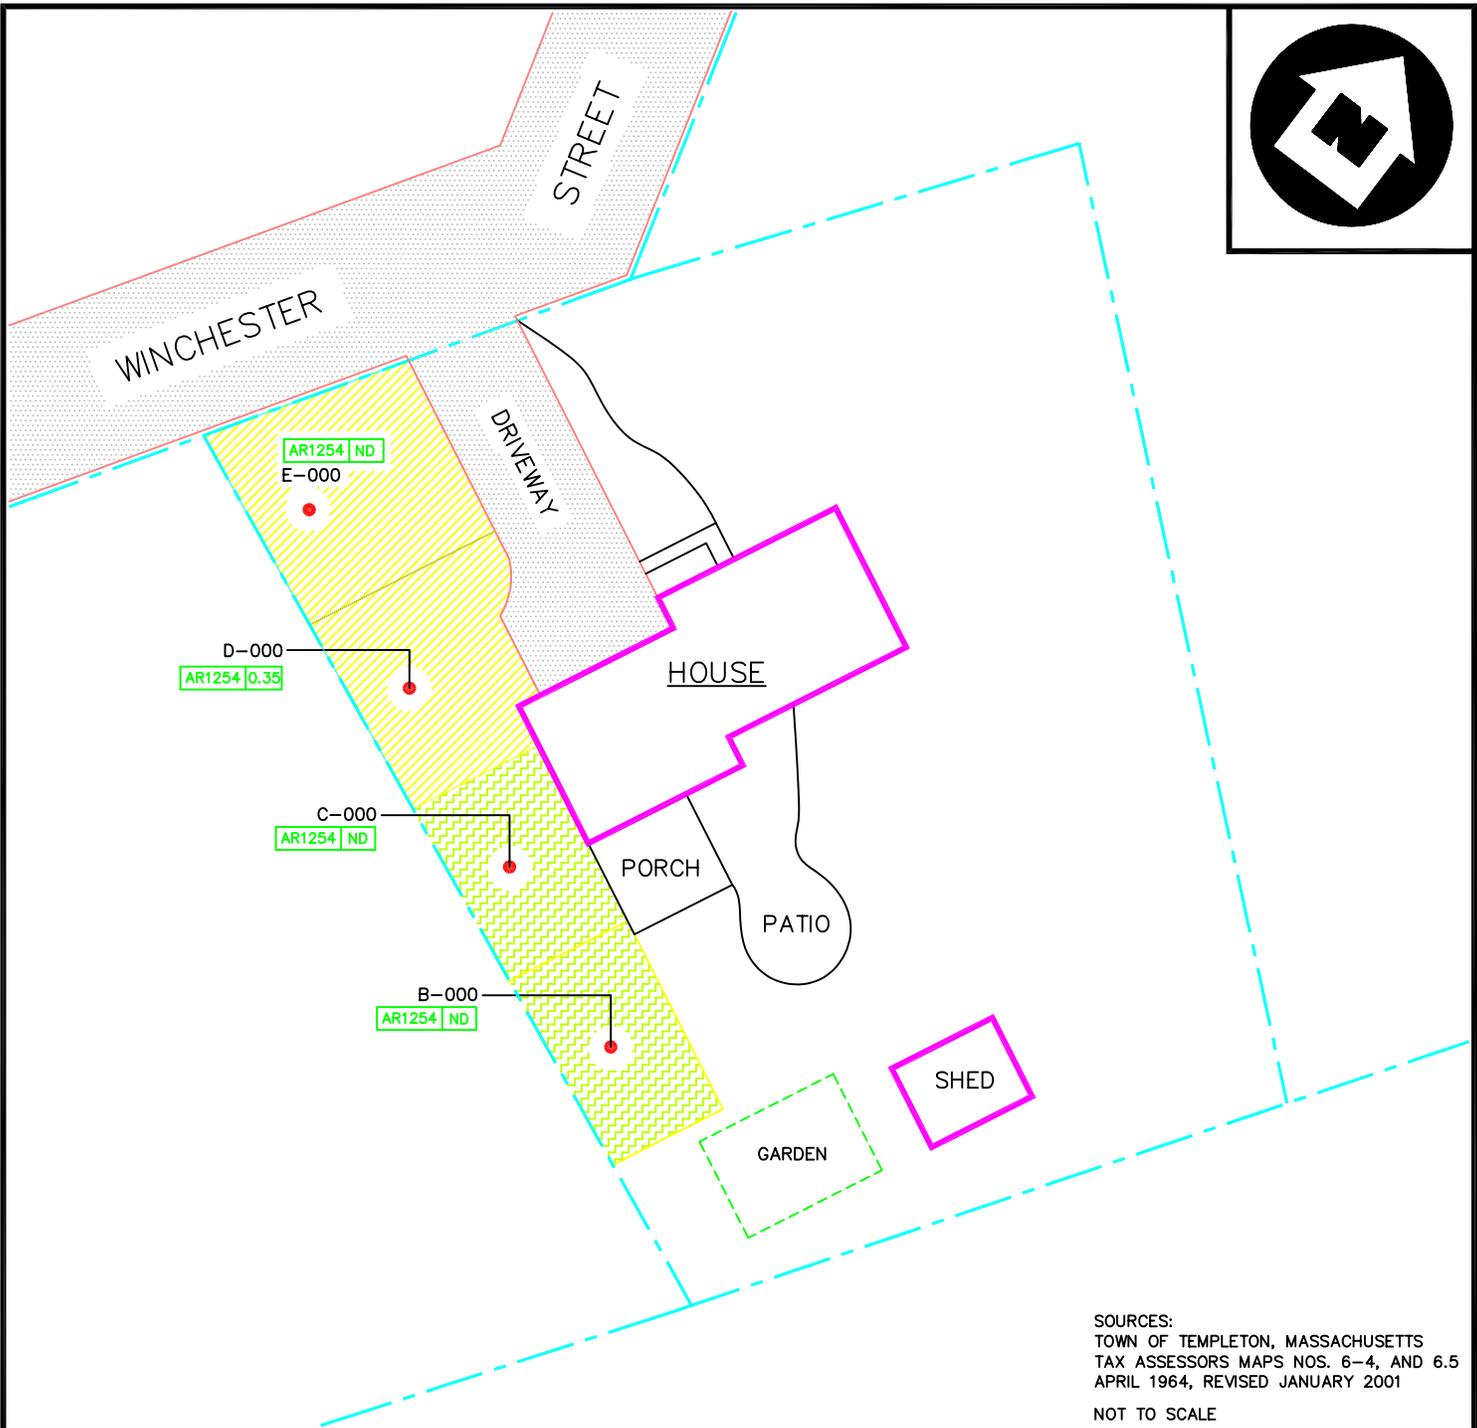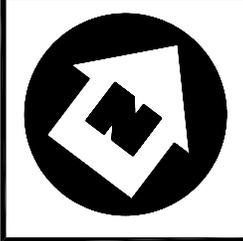

SOURCES:
 TOWN OF TEMPLETON, MASSACHUSETTS
 TAX ASSESSORS MAPS NOS. 6-4, AND 6.5
 APRIL 1964, REVISED JANUARY 2001
 NOT TO SCALE

LEGEND

- PAVED AREA
- SOIL SAMPLING LOCATION
- PROPERTY LINE
- DENOTES SOIL SAMPLING POINT IDENTIFICATION
- AROCLOR 1254 (PCB) RESULTS IN PARTS PER MILLION (PPM)

NOTES:
 ALL RESULTS ARE REPORTED IN MG/KG (PARTS PER MILLION)
 ND = NOT DETECTED
 J = RESULT IS ESTIMATED

- EXCAVATION DEPTH 1 FOOT
- EXCAVATION DEPTH 3 FEET

EXCAVATION DIAGRAM

BALDWINVILLE RESIDENTIAL PROPERTIES



R-030

BALDWINVILLE, MASSACHUSETTS



REGION I SUPERFUND TECHNICAL ASSESSMENT AND RESPONSE TEAM

TDD # 05-07-0013	DRAWN BY: K. BRENNAN	DATE 10/15/2005
FILE NAME: R:\05070013\FIGURES\PROPERTY DIAGRAMS\EXCAVATION DIAGRAMS\FIGURE 3\PHASE 1\FIG_R030.DWG		FIGURE 3

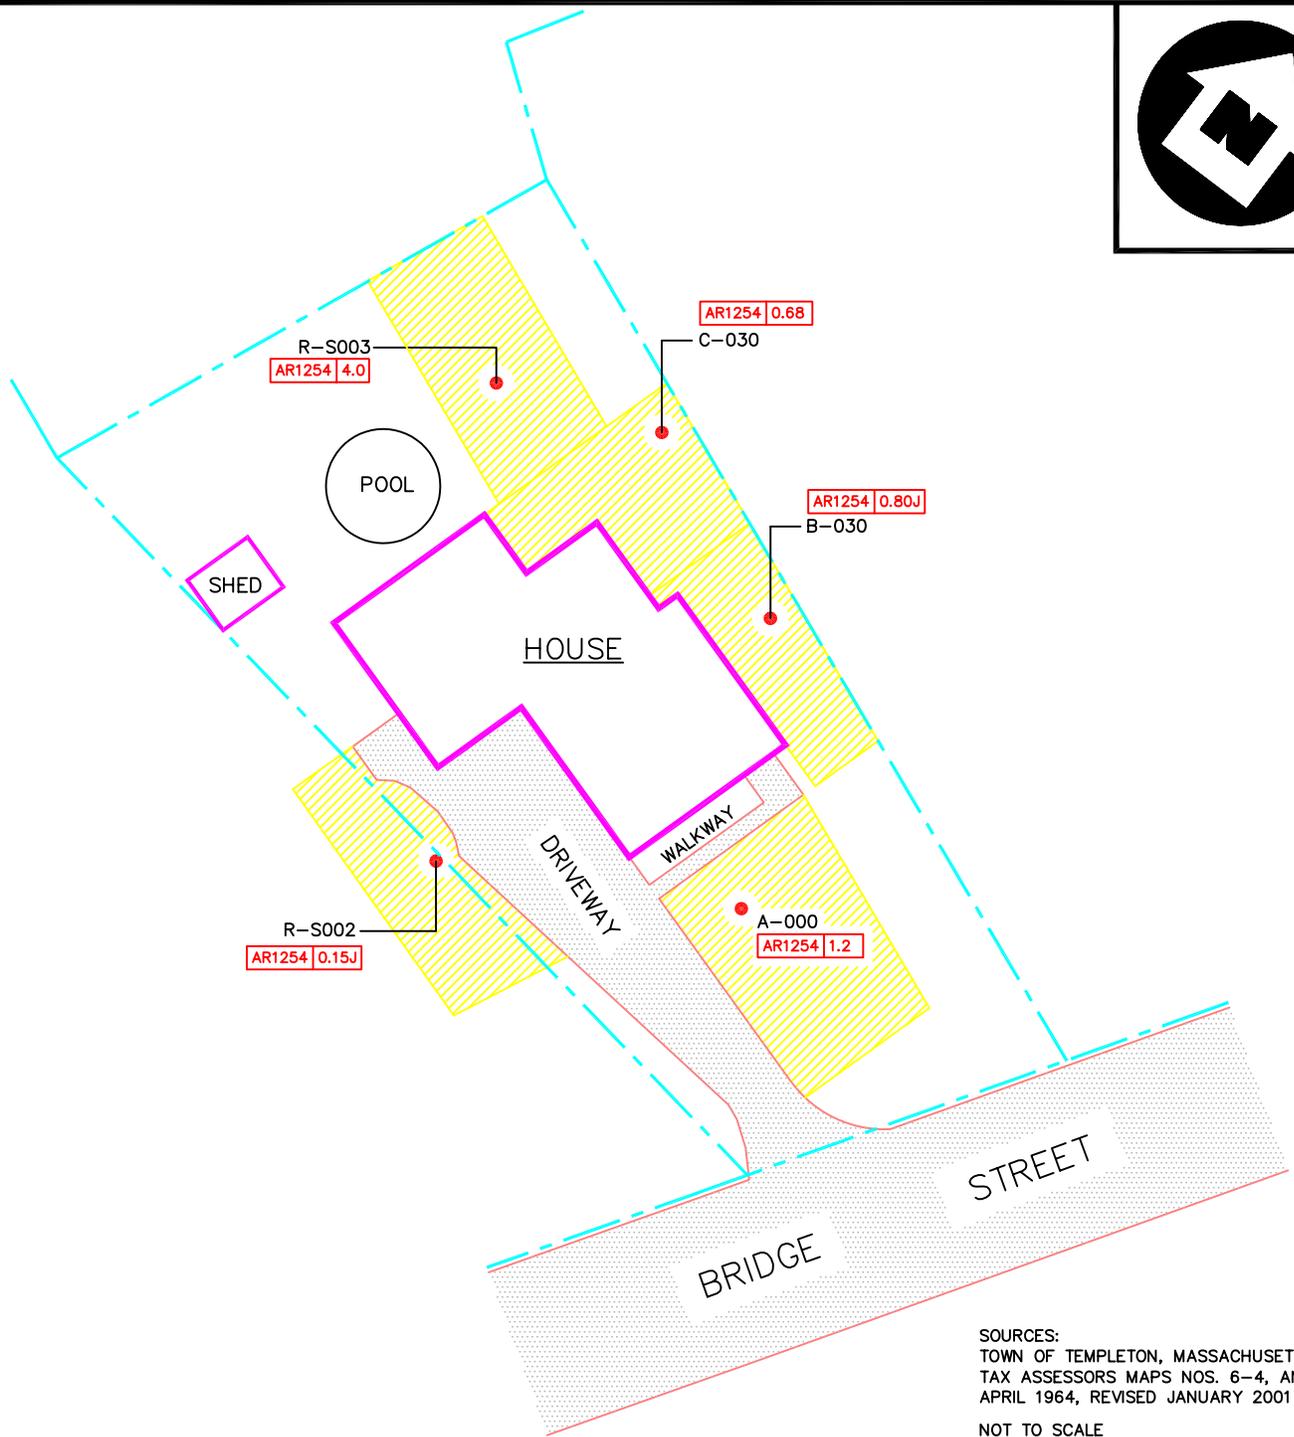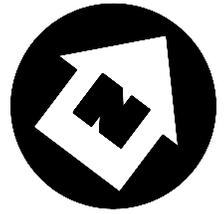

SOURCES:
TOWN OF TEMPLETON, MASSACHUSETTS
TAX ASSESSORS MAPS NOS. 6-4, AND 6.5
APRIL 1964, REVISED JANUARY 2001
NOT TO SCALE

LEGEND

PROPERTY LINE

SOIL SAMPLING LOCATION

DENOTES SOIL SAMPLING POINT IDENTIFICATION

A-000
AR1254 | 0.0
AROCLOR 1254 (PCB) RESULTS IN PARTS PER MILLION (PPM)

NOTES:
ALL RESULTS ARE REPORTED IN MG/KG (PARTS PER MILLION)
ND = NOT DETECTED
J = RESULT IS ESTIMATED

EXCAVATION DEPTH
 1 FOOT

EXCAVATION DIAGRAM
BALDWINVILLE RESIDENTIAL
PROPERTIES
R-032
BALDWINVILLE, MASSACHUSETTS



REGION I SUPERFUND TECHNICAL ASSESSMENT AND RESPONSE TEAM



TDD #
05-07-0013

DRAWN BY:
W. SHAW

DATE
3/24/05

FILE NAME:
R:\05070013\FIGURES\PROPERTY DIAGRAMS\EXCAVATION
DIAGRAMS\FIGURE 3\PHASE I\FIG_R032.DWG

FIGURE 3

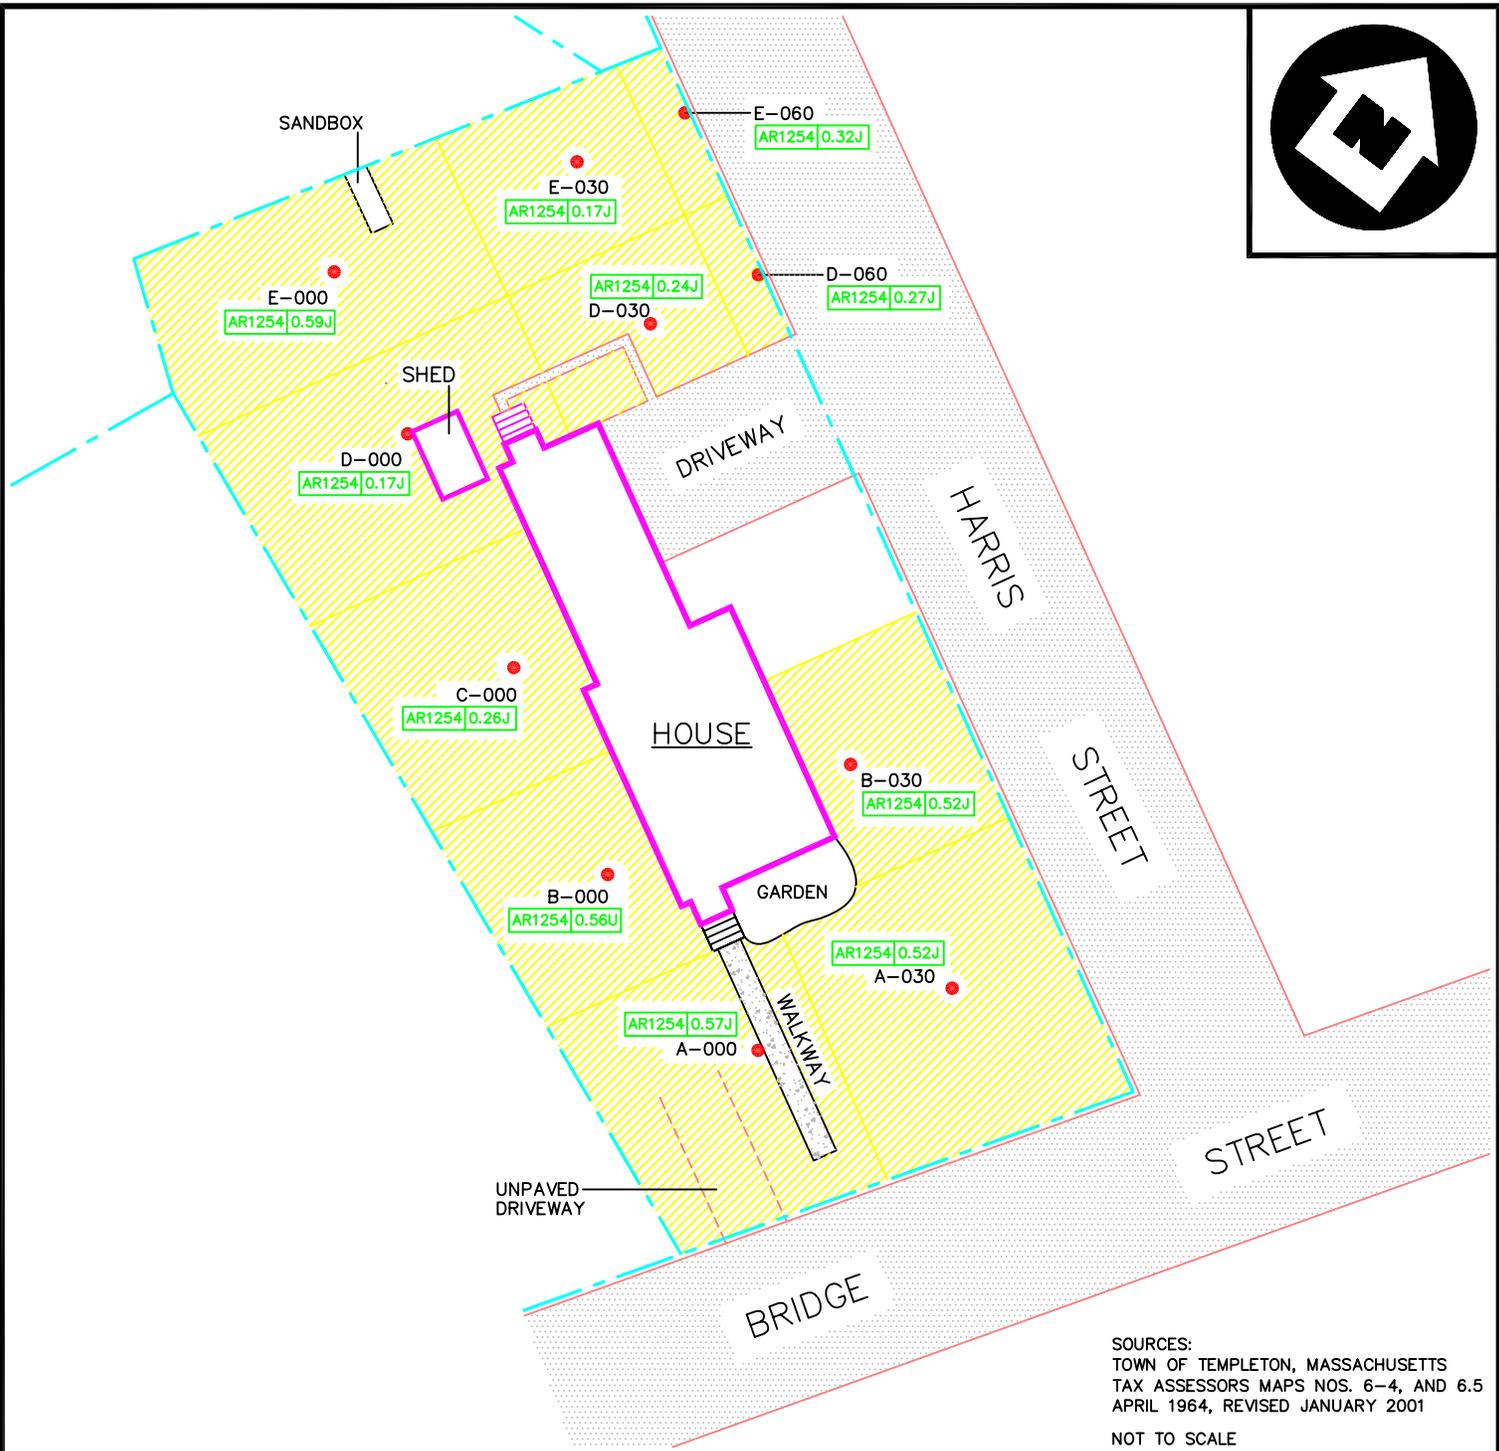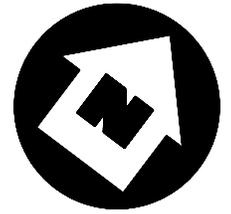

SOURCES:
 TOWN OF TEMPLETON, MASSACHUSETTS
 TAX ASSESSORS MAPS NOS. 6-4, AND 6.5
 APRIL 1964, REVISED JANUARY 2001
 NOT TO SCALE

LEGEND

- ASPHALT PAVEMENT
- CONCRETE WALKWAY
- PROPERTY LINE

- SOIL SAMPLING LOCATION

DENOTES SOIL SAMPLING POINT IDENTIFICATION
 A-000 AROCLOR 1254 (PCB) RESULTS IN PARTS PER MILLION (PPM)
 AR1254 | 0.0

NOTES:
 ALL RESULTS ARE REPORTED IN MG/KG (PARTS PER MILLION)
 ND = NOT DETECTED
 J = RESULT IS ESTIMATED

EXCAVATION DEPTH
 1 FOOT

EXCAVATION DIAGRAM

BALDWINVILLE RESIDENTIAL PROPERTIES
 R-033

BALDWINVILLE, MASSACHUSETTS



REGION I SUPERFUND TECHNICAL ASSESSMENT AND RESPONSE TEAM



TDD #
05-07-0013

DRAWN BY:
W. SHAW

DATE
3/28/05

FILE NAME:
R:\05070013\FIGURES\PROPERTY DIAGRAMS\EXCAVATION DIAGRAMS\FIGURE 3\PHASE 1\FIG_R033.DWG

FIGURE 3

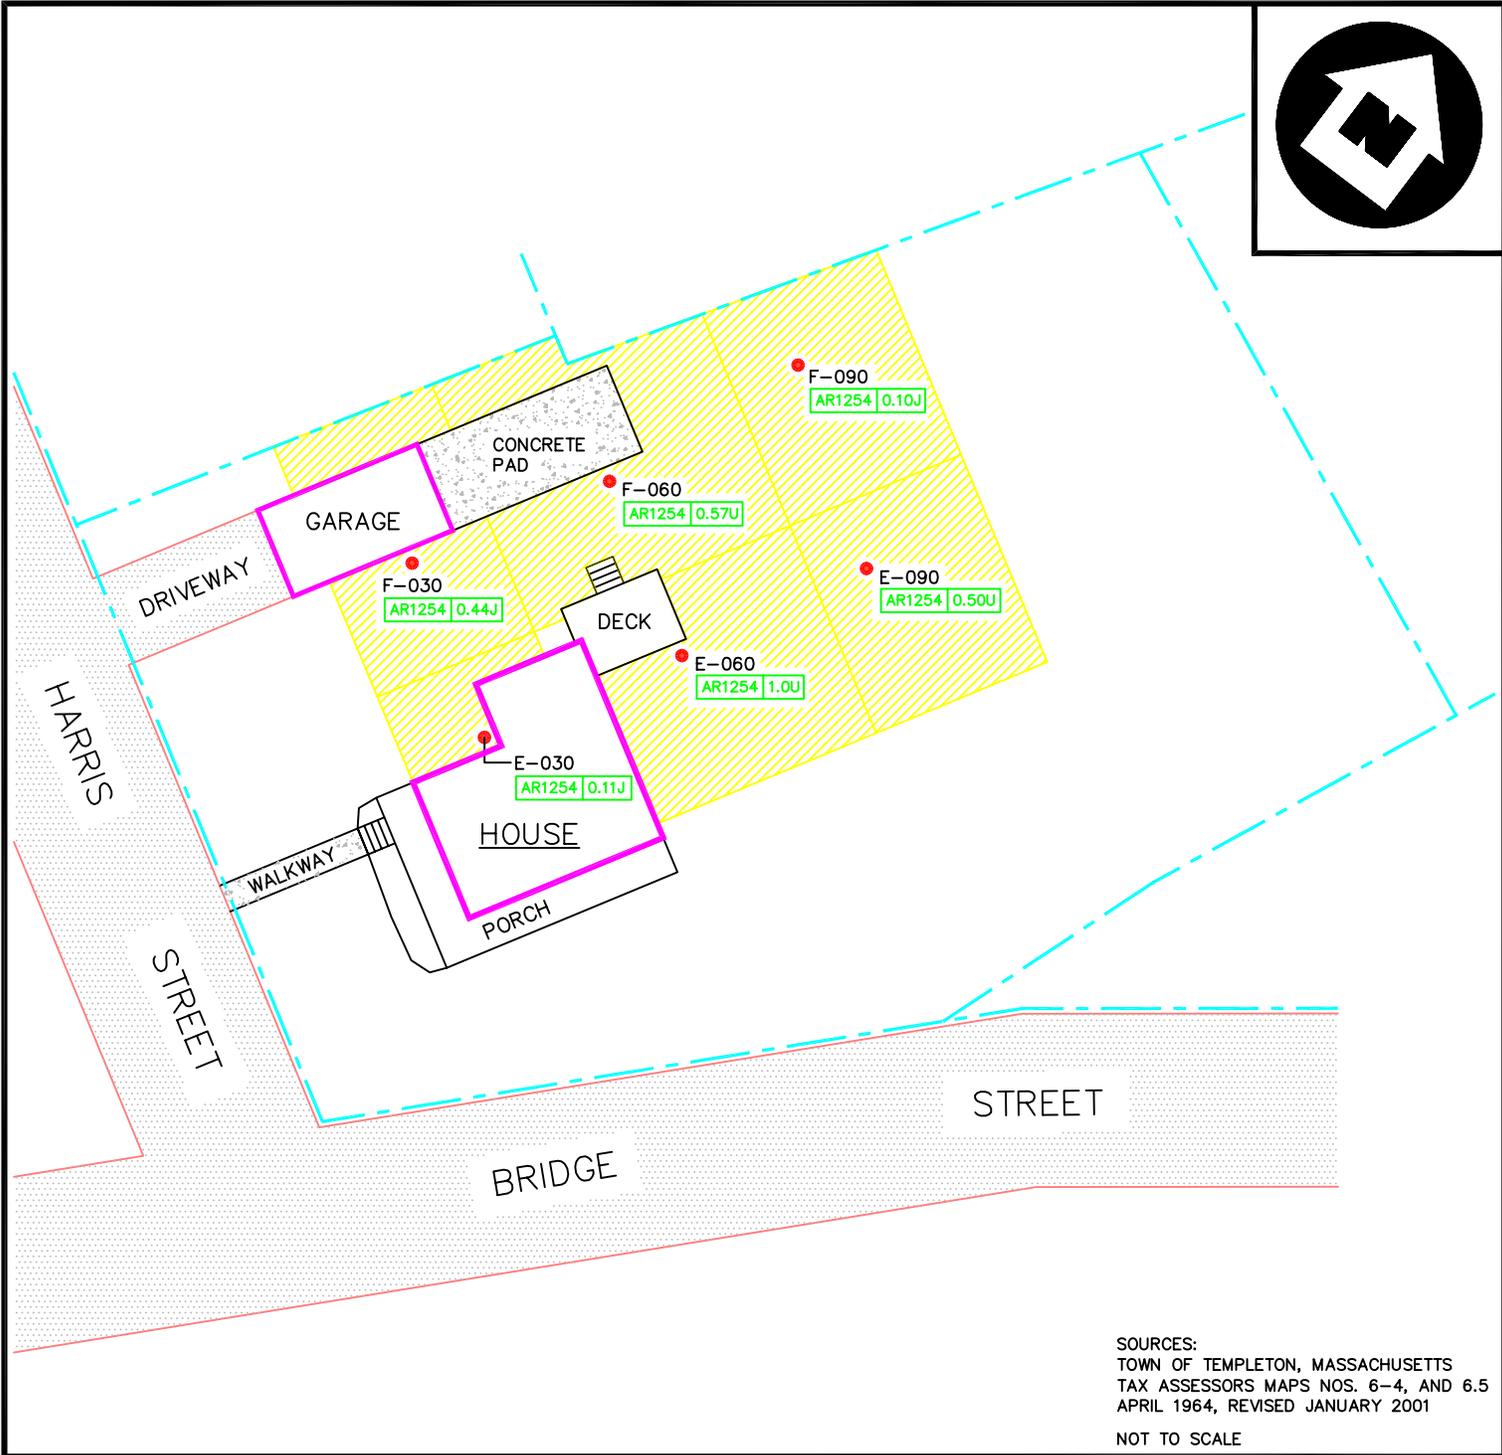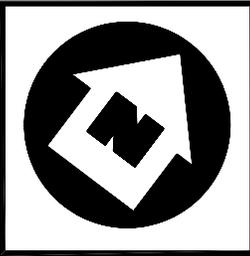

SOURCES:
 TOWN OF TEMPLETON, MASSACHUSETTS
 TAX ASSESSORS MAPS NOS. 6-4, AND 6.5
 APRIL 1964, REVISED JANUARY 2001
 NOT TO SCALE

LEGEND

- ASPHALT PAVEMENT
- CONCRETE WALKWAY
- - - PROPERTY LINE
- SOIL SAMPLING LOCATION
- DENOTES SOIL SAMPLING POINT IDENTIFICATION
- A-000 AROCLOR 1254 (PCB) RESULTS IN PARTS PER MILLION (PPM)
- AR1254 | 0.0
- NOTES:
 ALL RESULTS ARE REPORTED IN MG/KG (PARTS PER MILLION)
 ND = NOT DETECTED
 J = RESULT IS ESTIMATED
- EXCAVATION DEPTH
 1 FOOT

EXCAVATION DIAGRAM

BALDWINVILLE RESIDENTIAL
 PROPERTIES
 R-034

BALDWINVILLE, MASSACHUSETTS



REGION I SUPERFUND TECHNICAL ASSESSMENT AND RESPONSE TEAM


TDD #
 05-07-0013

DRAWN BY:
 W. SHAW

DATE
 3/28/05

FILE NAME:
 R:\05070013\FIGURES\PROPERTY DIAGRAMS\EXCAVATION
 DIAGRAMS\FIGURE 3\PHASE 1\FIG_R034.DWG

FIGURE 3

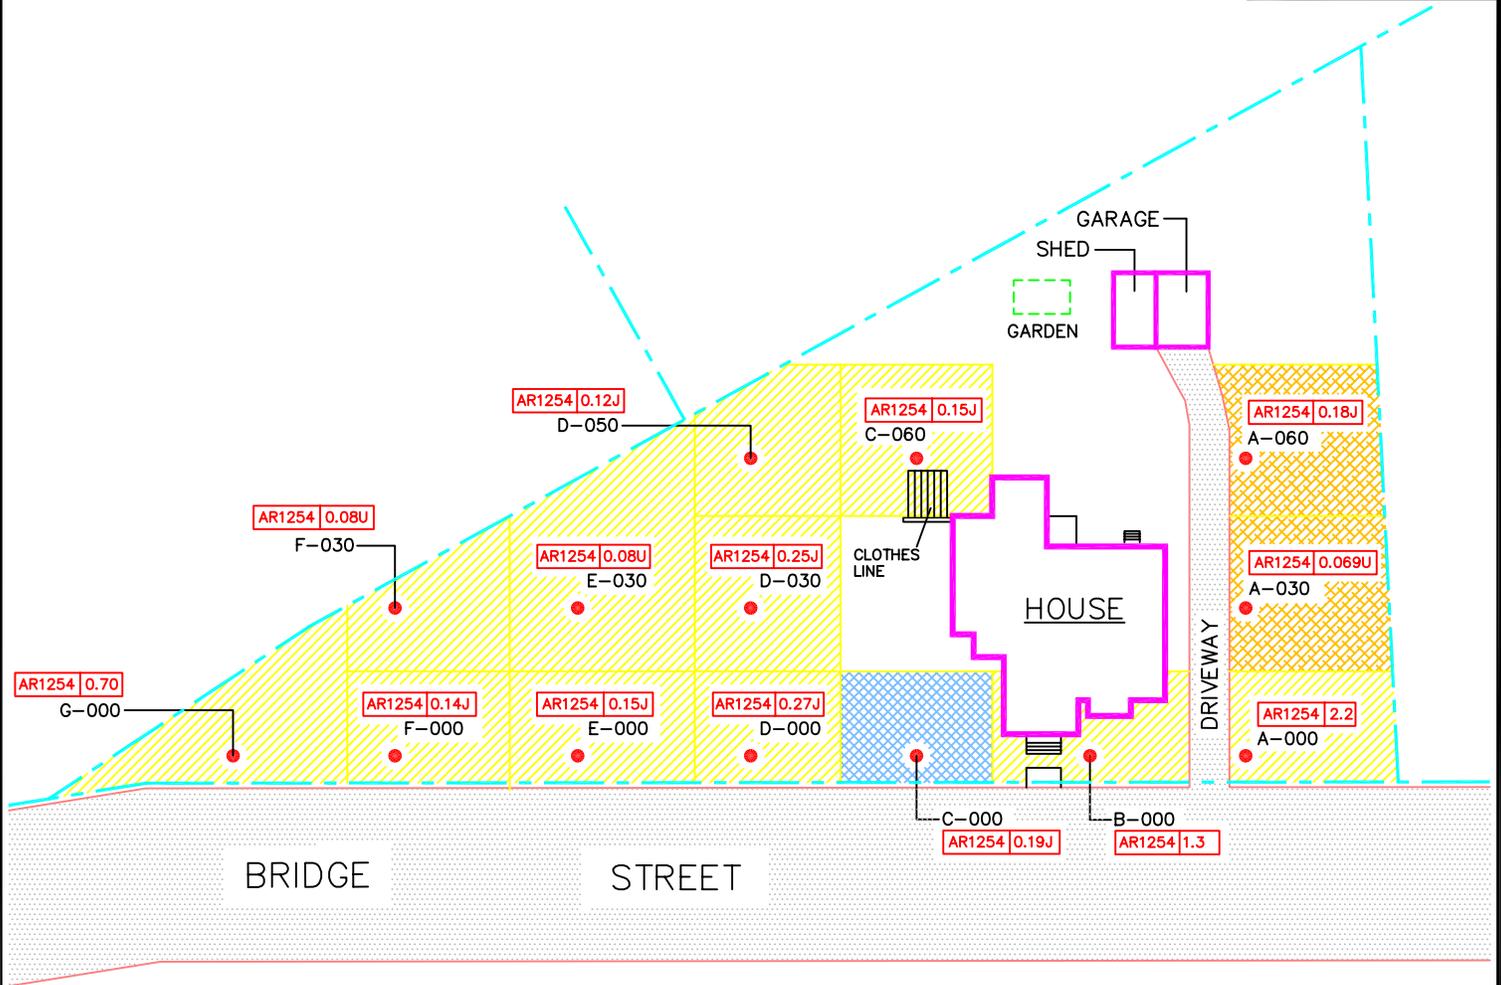

SOURCES:
 TOWN OF TEMPLETON, MASSACHUSETTS
 TAX ASSESSORS MAPS NOS. 6-4, AND 6.5
 APRIL 1964, REVISED JANUARY 2001
 NOT TO SCALE

LEGEND

- PROPERTY LINE
- SOIL SAMPLING LOCATION
- DENOTES SOIL SAMPLING POINT IDENTIFICATION
- A-000
AR1254 | 0.0 — AROCLOR 1254 (PCB) RESULTS IN PARTS PER MILLION (PPM)

NOTES:
 ALL RESULTS ARE REPORTED IN MG/KG (PARTS PER MILLION)
 ND = NOT DETECTED
 J = RESULT IS ESTIMATED

- EXCAVATION DEPTH 1 FOOT
- EXCAVATION DEPTH 1.5 FEET
- EXCAVATION DEPTH 2 FEET

EXCAVATION DIAGRAM

BALDWINVILLE RESIDENTIAL
 PROPERTIES
 R-035

BALDWINVILLE, MASSACHUSETTS



REGION I SUPERFUND TECHNICAL ASSESSMENT AND RESPONSE TEAM



TDD #
 05-07-0013

DRAWN BY:
 W. SHAW

DATE
 12/8/04

FILE NAME:
 R:\05070013\FIGURES\PROPERTY DIAGRAMS\EXCAVATION
 DIAGRAMS\FIGURE 3\PHASE 1\FIG_R035.DWG

FIGURE 3

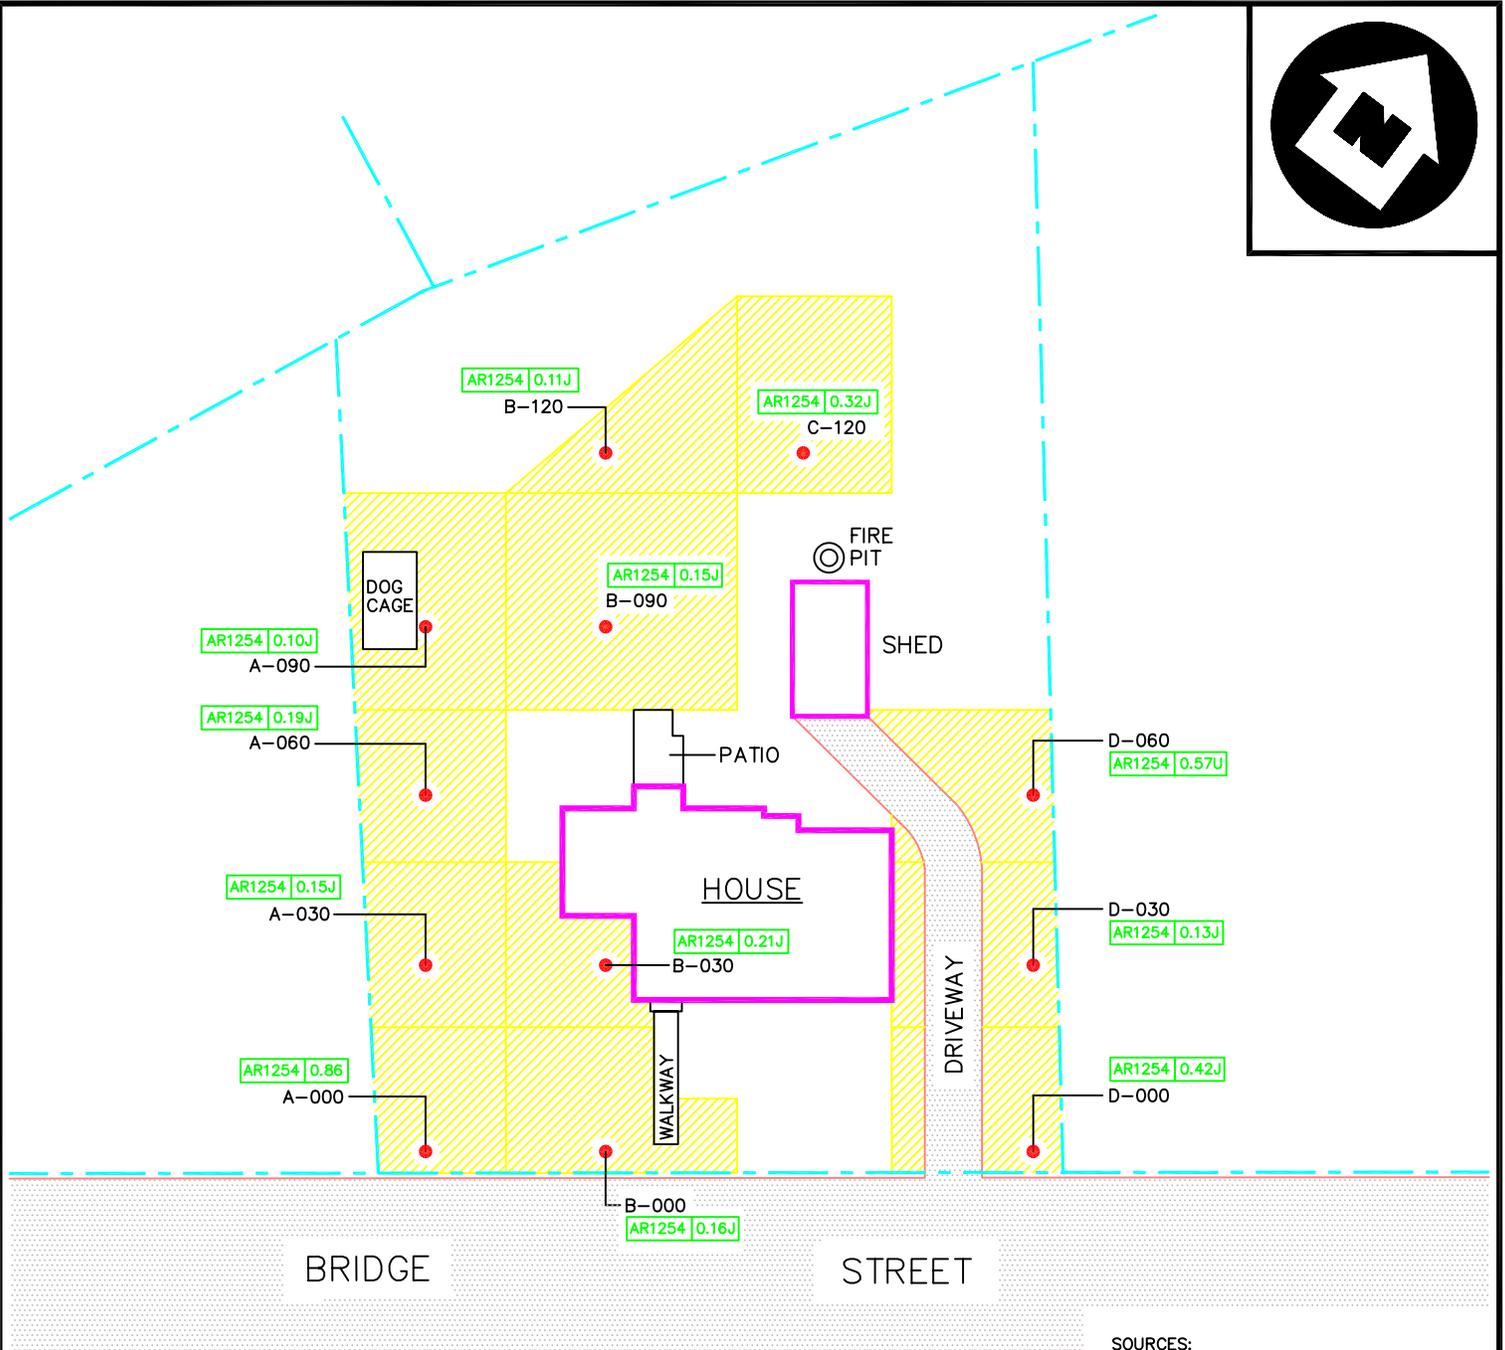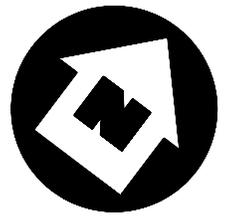

SOURCES:
TOWN OF TEMPLETON, MASSACHUSETTS
TAX ASSESSORS MAPS NOS. 6-4, AND 6.5
APRIL 1964, REVISED JANUARY 2001
NOT TO SCALE

LEGEND

○ ASPHALT PAVEMENT
- - - PROPERTY LINE

● SOIL SAMPLING LOCATION

— DENOTES SOIL SAMPLING POINT IDENTIFICATION

A-000
AR1254 | 0.0
AROCOR 1254 (PCB) RESULTS IN PARTS PER MILLION (PPM)

NOTES:
ALL RESULTS ARE REPORTED IN MG/KG (PARTS PER MILLION)
ND = NOT DETECTED
J = RESULT IS ESTIMATED

EXCAVATION DEPTH
1 FOOT

EXCAVATION DIAGRAM
BALDWINVILLE RESIDENTIAL PROPERTIES
R-036
BALDWINVILLE, MASSACHUSETTS



REGION I SUPERFUND TECHNICAL ASSESSMENT AND RESPONSE TEAM



TDD #
05-07-0013

DRAWN BY:
W. SHAW

DATE
3/29/05

FILE NAME:
R:\05070013\FIGURES\PROPERTY DIAGRAMS\EXCAVATION DIAGRAMS\FIGURE 3\PHASE 1\FIG_R036.DWG

FIGURE 3

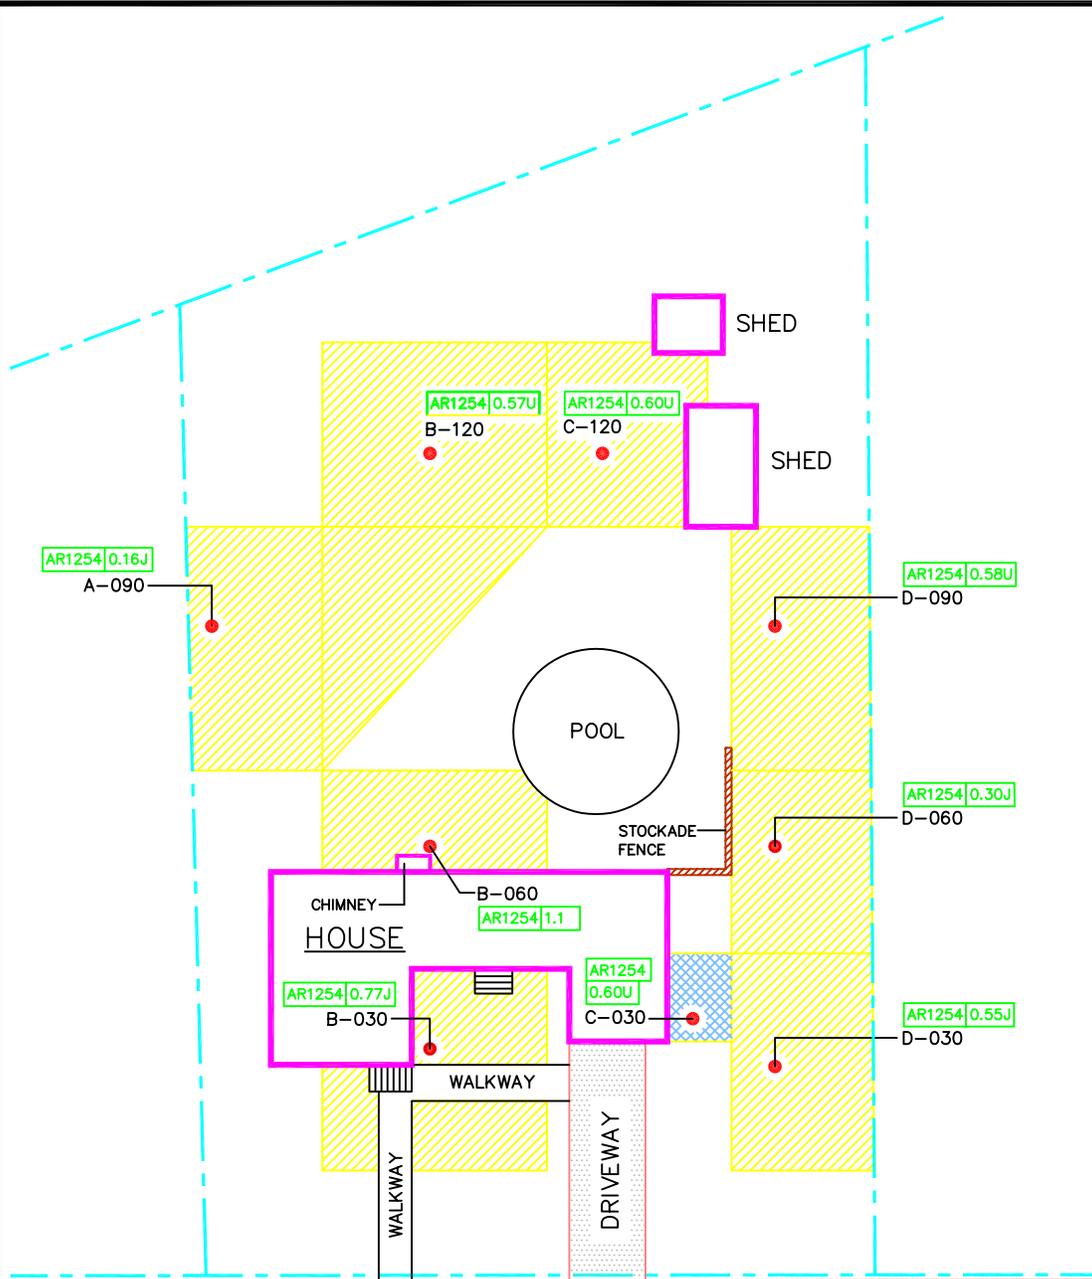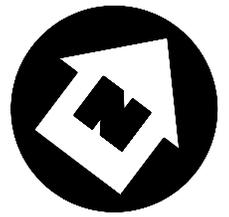

BRIDGE

STREET

SOURCES:
TOWN OF TEMPLETON, MASSACHUSETTS
TAX ASSESSORS MAPS NOS. 6-4, AND 6.5
APRIL 1964, REVISED JANUARY 2001
NOT TO SCALE

LEGEND

○ ASPHALT PAVEMENT
- - - PROPERTY LINE

● SOIL SAMPLING LOCATION

— DENOTES SOIL SAMPLING POINT IDENTIFICATION
A-000 AROCLOR 1254 (PCB) RESULTS IN PARTS PER MILLION (PPM)
AR1254 | 0.0

NOTES:
ALL RESULTS ARE REPORTED IN MG/KG (PARTS PER MILLION)
ND = NOT DETECTED
J = RESULT IS ESTIMATED

EXCAVATION DEPTH
1 FOOT
1.5 FEET

EXCAVATION DIAGRAM

BALDWINVILLE RESIDENTIAL PROPERTIES
R-037

BALDWINVILLE, MASSACHUSETTS



REGION I SUPERFUND TECHNICAL ASSESSMENT AND RESPONSE TEAM



TDD #
05-07-0013

DRAWN BY:
W. SHAW

DATE
3/30/05

FILE NAME:
R:\05070013\FIGURES\PROPERTY DIAGRAMS\EXCAVATION DIAGRAMS\FIGURE 3\PHASE 1\FIG_R037.DWG

FIGURE 3

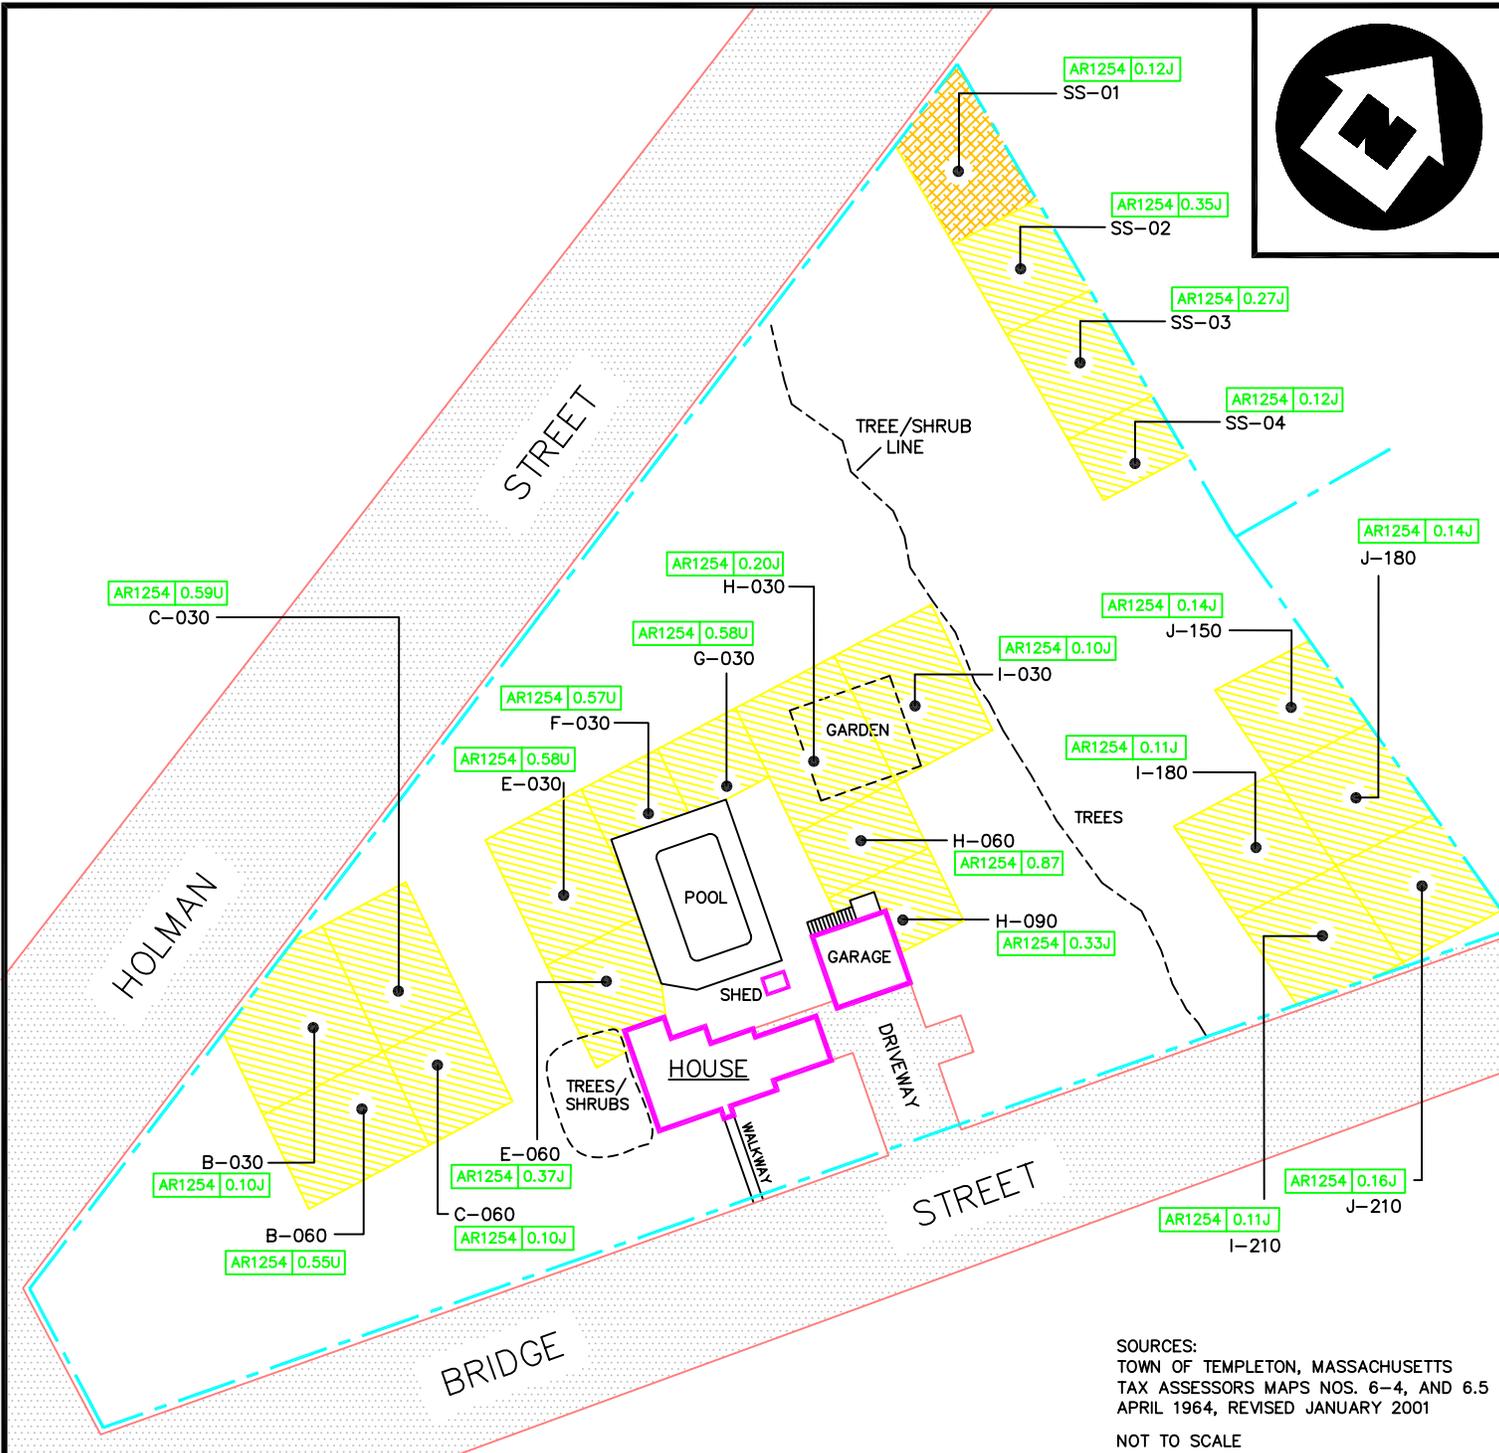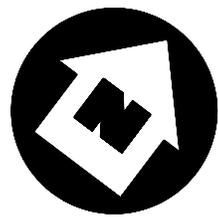

SOURCES:
TOWN OF TEMPLETON, MASSACHUSETTS
TAX ASSESSORS MAPS NOS. 6-4, AND 6.5
APRIL 1964, REVISED JANUARY 2001
NOT TO SCALE

LEGEND

- PAVED AREA
 - SOIL SAMPLING LOCATION
 - PROPERTY LINE
 - DENOTES SOIL SAMPLING POINT IDENTIFICATION
 - A-000 AROCLOR 1254 (PCB) RESULTS IN PARTS PER MILLION (PPM)
 - EXCAVATION DEPTH 1 FOOT
 - EXCAVATION DEPTH 2 FEET
- NOTES:
ALL RESULTS ARE REPORTED IN MG/KG (PARTS PER MILLION)
ND = NOT DETECTED
J = RESULT IS ESTIMATED

EXCAVATION DIAGRAM

BALDWINVILLE RESIDENTIAL
PROPERTIES
R-039



BALDWINVILLE, MASSACHUSETTS



REGION I SUPERFUND TECHNICAL ASSESSMENT AND RESPONSE TEAM

TDD # 05-07-0013	DRAWN BY: W. SHAW	DATE 12/8/04
---------------------	----------------------	-----------------

FILE NAME: R:\05070013\FIGURES\PROPERTY DIAGRAMS\EXCAVATION DIAGRAMS\FIGURE 3\PHASE I\FIG_R039.DWG	FIGURE 3
--	----------

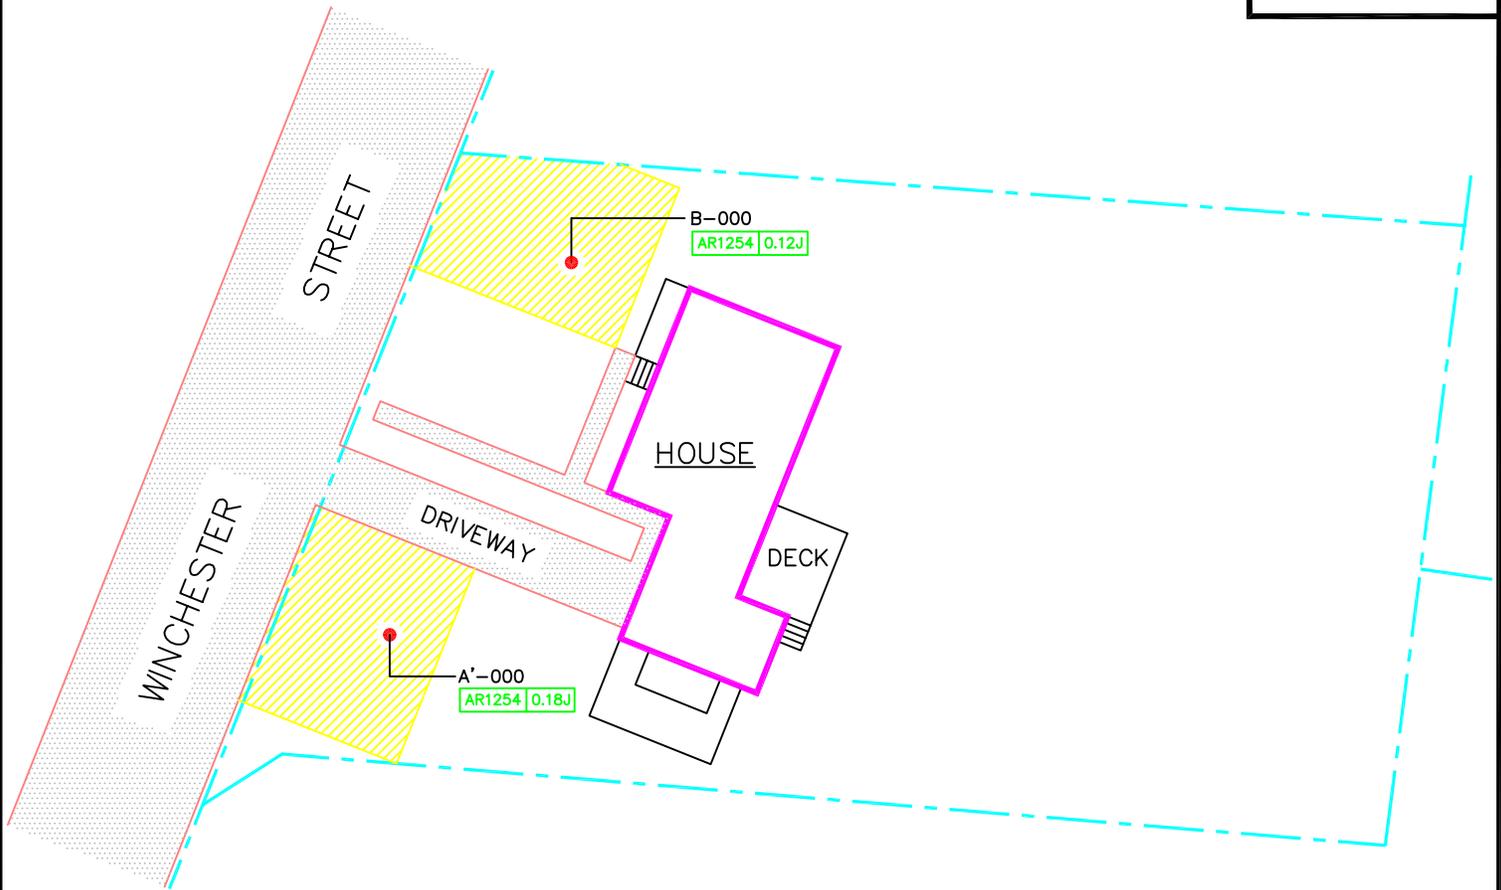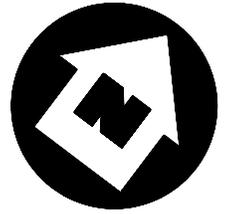

SOURCES:
TOWN OF TEMPLETON, MASSACHUSETTS
TAX ASSESSORS MAPS NOS. 6-4, AND 6.5
APRIL 1964, REVISED JANUARY 2001

NOT TO SCALE

LEGEND

○ ASPHALT PAVEMENT
- - - PROPERTY LINE

● SOIL SAMPLING LOCATION

— DENOTES SOIL SAMPLING POINT IDENTIFICATION

A-000
AR1254 | 0.0 — AROCLOR 1254 (PCB) RESULTS IN PARTS PER MILLION (PPM)

NOTES:
ALL RESULTS ARE REPORTED IN MG/KG (PARTS PER MILLION)

ND = NOT DETECTED
J = RESULT IS ESTIMATED

EXCAVATION DEPTH
1 FOOT

EXCAVATION DIAGRAM

BALDWINVILLE RESIDENTIAL PROPERTIES

R-041

BALDWINVILLE, MASSACHUSETTS



REGION I SUPERFUND TECHNICAL ASSESSMENT AND RESPONSE TEAM



TDD #
05-07-0013

DRAWN BY:
W. SHAW

DATE
4/1/05

FILE NAME:
R:\05070013\FIGURES\PROPERTY DIAGRAMS\EXCAVATION DIAGRAMS\FIGURE 3\PHASE 1\FIG_R041.DWG

FIGURE 3

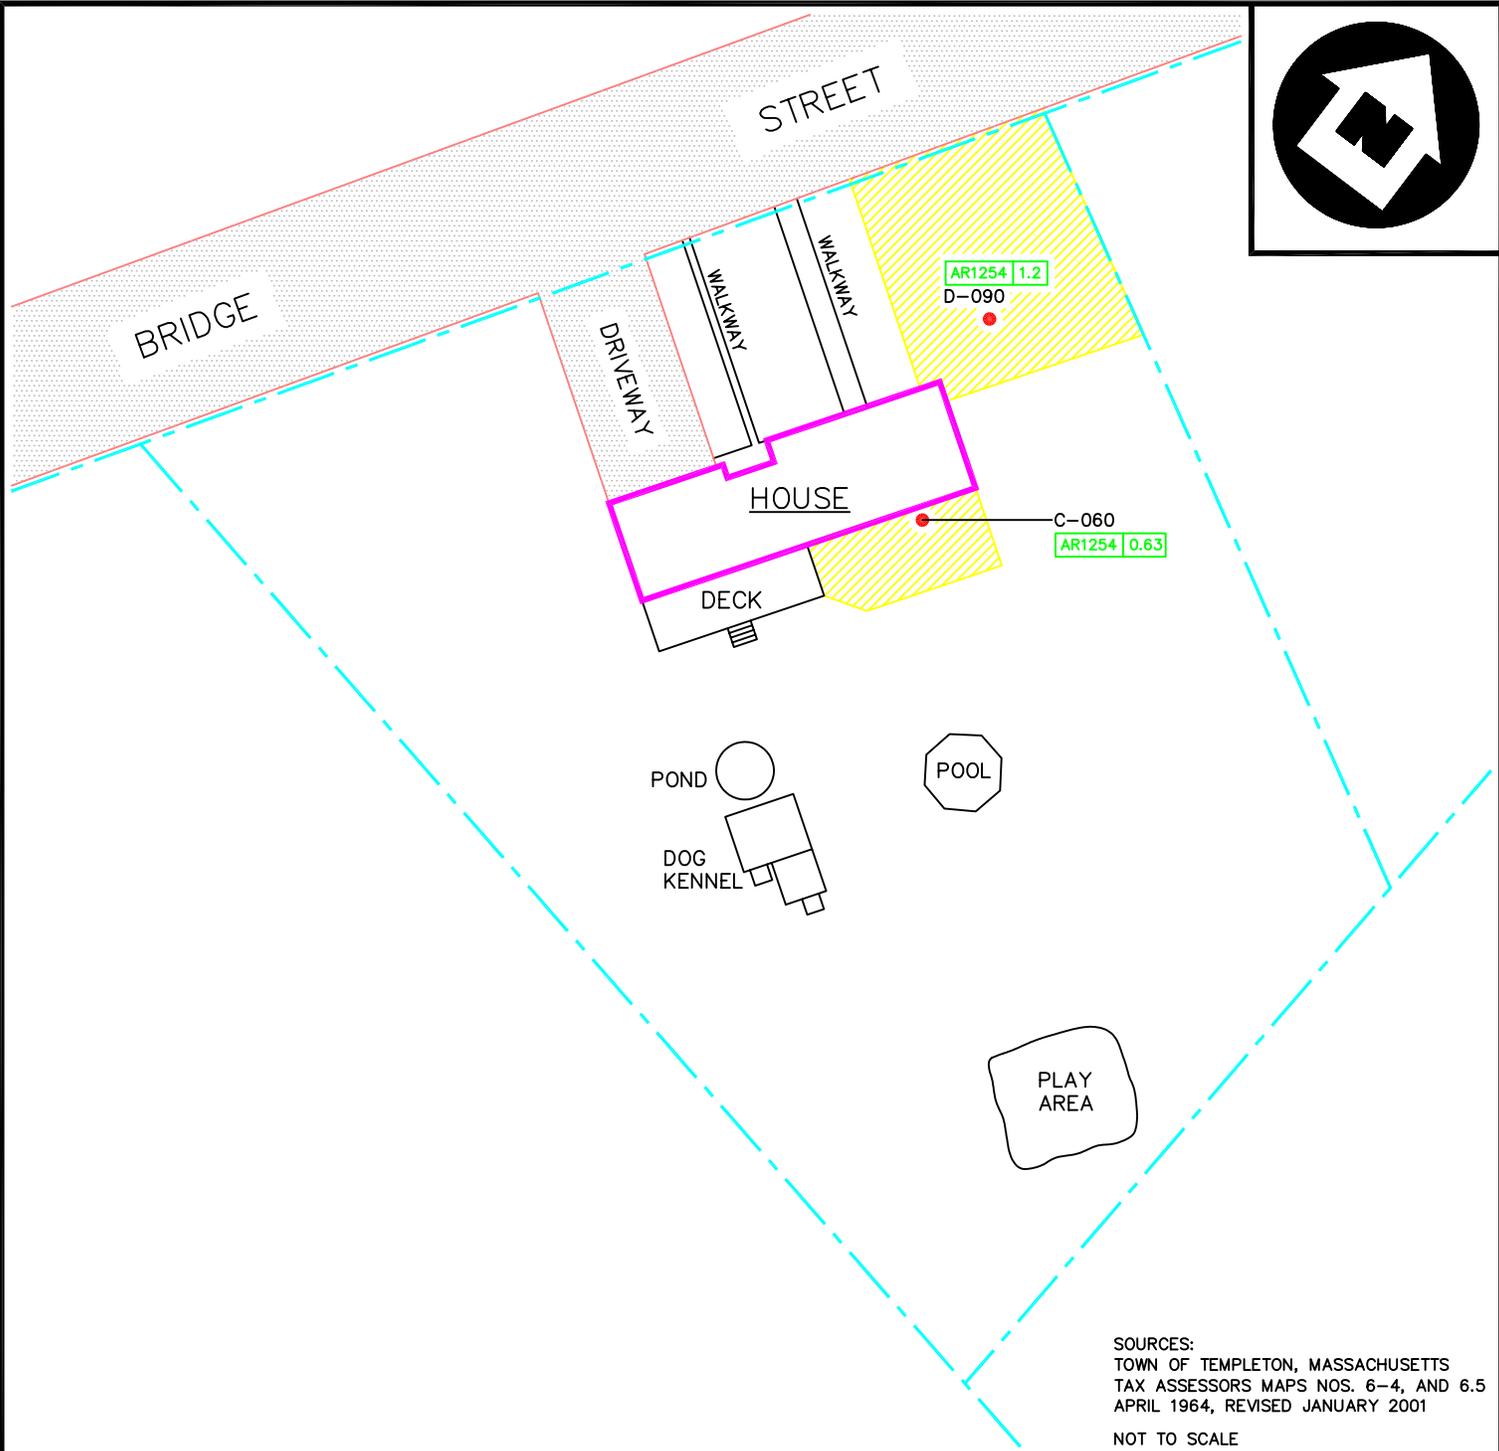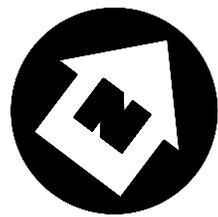

SOURCES:
 TOWN OF TEMPLETON, MASSACHUSETTS
 TAX ASSESSORS MAPS NOS. 6-4, AND 6.5
 APRIL 1964, REVISED JANUARY 2001
 NOT TO SCALE

LEGEND

ASPHALT PAVEMENT
 PROPERTY LINE

SOIL SAMPLING LOCATION

DENOTES SOIL SAMPLING POINT IDENTIFICATION

A-000 AROCLOR 1254 (PCB) RESULTS IN PARTS PER MILLION (PPM)
 AR1254 | 0.0

NOTES:
 ALL RESULTS ARE REPORTED IN MG/KG (PARTS PER MILLION)
 ND = NOT DETECTED
 J = RESULT IS ESTIMATED

EXCAVATION DEPTH
 1 FOOT

EXCAVATION DIAGRAM

BALDWINVILLE RESIDENTIAL PROPERTIES
 R-043

BALDWINVILLE, MASSACHUSETTS



REGION I SUPERFUND TECHNICAL ASSESSMENT AND RESPONSE TEAM



TDD #
 05-07-0013

DRAWN BY:
 W. SHAW

DATE
 3/29/05

FILE NAME:
 R:\05070013\FIGURES\PROPERTY DIAGRAMS\EXCAVATION DIAGRAMS\FIGURE 3\PHASE 1\FIG_R043.DWG

FIGURE 3

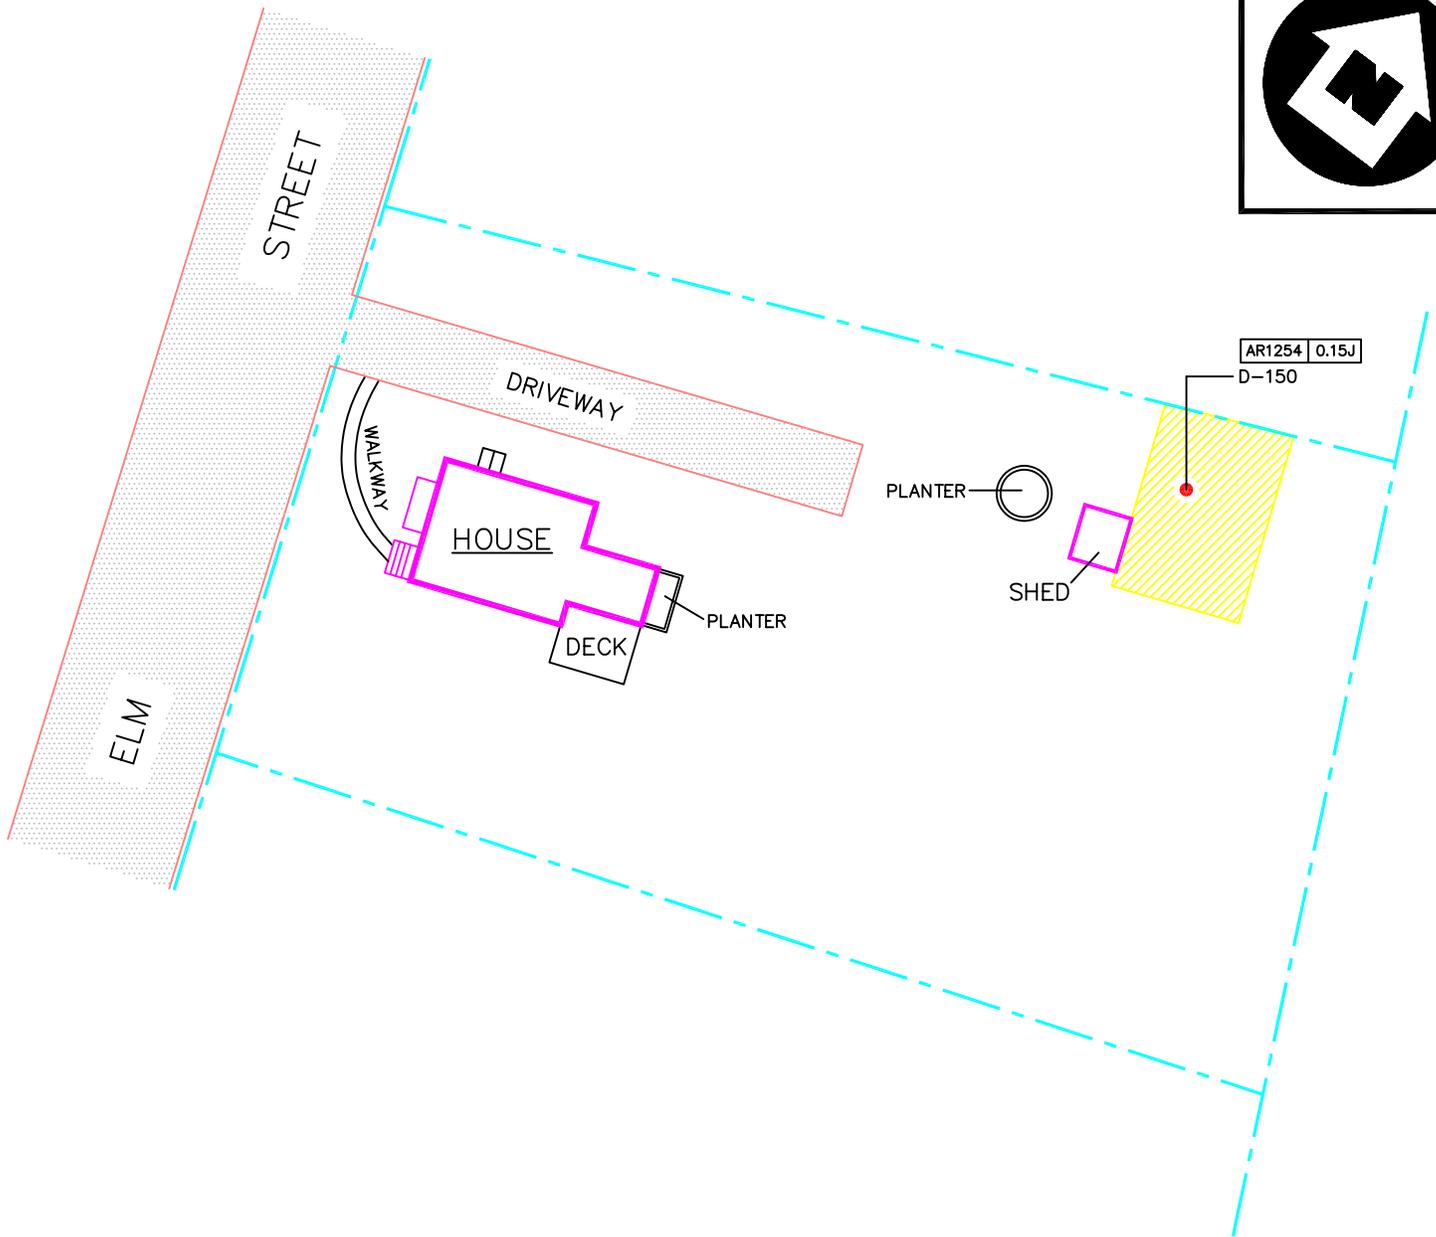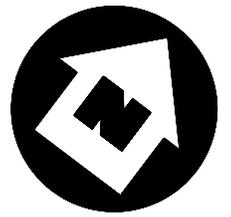

SOURCES:
 TOWN OF TEMPLETON, MASSACHUSETTS
 TAX ASSESSORS MAPS NOS. 6-4, AND 6.5
 APRIL 1964, REVISED JANUARY 2001
 NOT TO SCALE

LEGEND

○ ASPHALT PAVEMENT
 - - - PROPERTY LINE

● SOIL SAMPLING LOCATION

— DENOTES SOIL SAMPLING POINT IDENTIFICATION

A-000 AROCLOR 1254 (PCB) RESULTS IN PARTS PER MILLION (PPM)
 AR1254 | 0.0

NOTES:
 ALL RESULTS ARE REPORTED IN MG/KG (PARTS PER MILLION)
 ND = NOT DETECTED
 J = RESULT IS ESTIMATED

EXCAVATION DEPTH
 1 FOOT

EXCAVATION DIAGRAM

BALDWINVILLE RESIDENTIAL PROPERTIES
 R-047

BALDWINVILLE, MASSACHUSETTS



REGION I SUPERFUND TECHNICAL ASSESSMENT AND RESPONSE TEAM

TDD #
 05-07-0013

DRAWN BY:
 W. SHAW


DATE
 4/1/05

FILE NAME:
 R:\05070013\FIGURES\PROPERTY DIAGRAMS\EXCAVATION DIAGRAMS\FIGURE 3\PHASE 1\FIG_R047.DWG

FIGURE 3

Section 2 - Phase II Removal Diagrams

REPORTED RESULTS ARE FOR AROCLOR
 1254 AND ARE REPORTED IN MG/KG.
 MG/KG = PARTS PER MILLION (PPM).
 ND = NOT DETECTED.

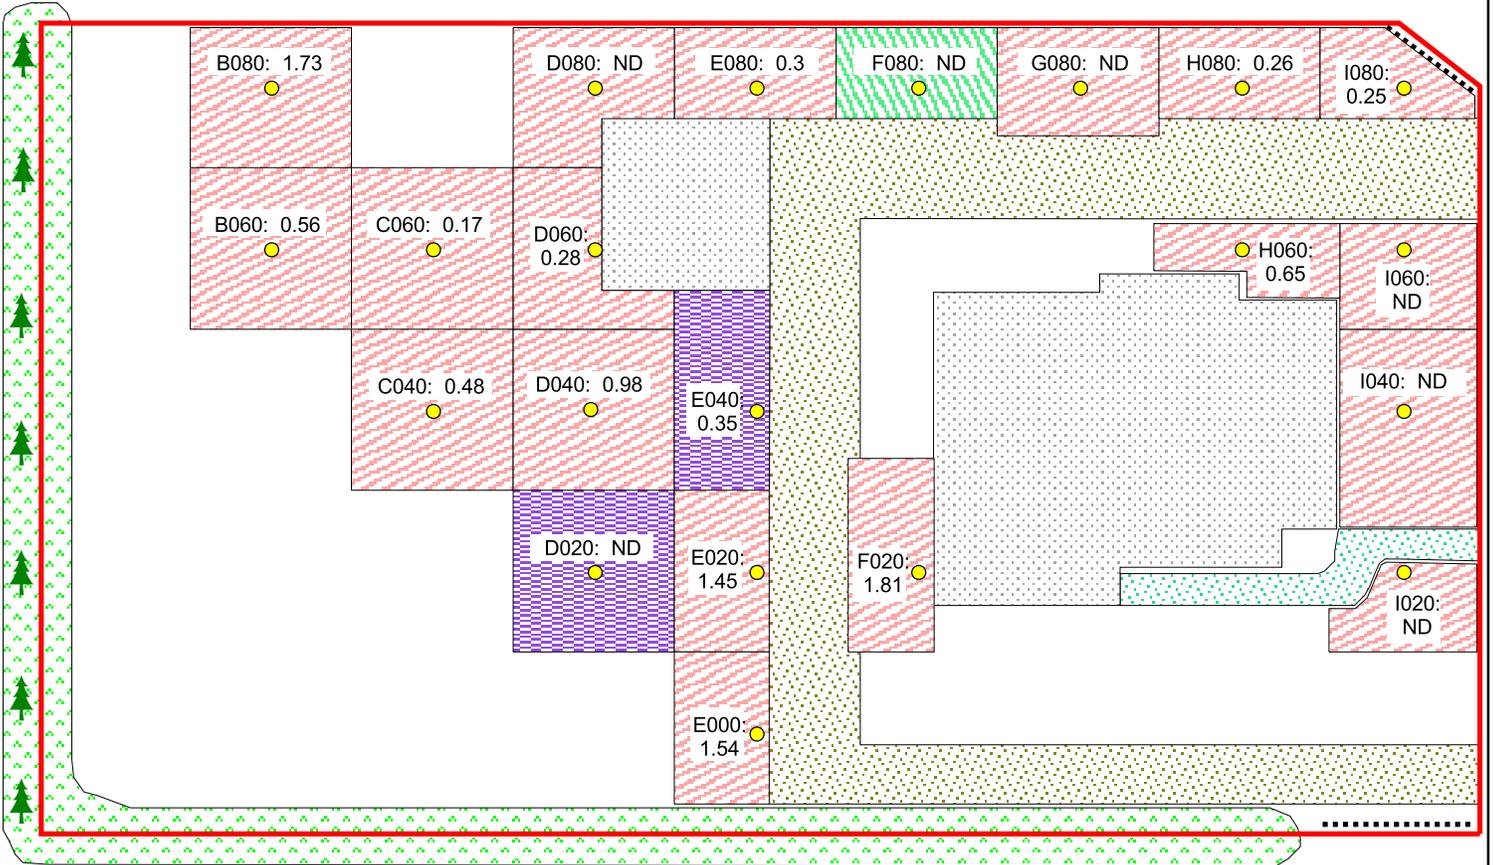

- SAMPLE LOCATION**
- R060
 - 🌲 TREE
 - ⚡ FENCE
 - ▭ PROPERTY BOUNDARY
 - ▭ BUILDING
 - ▭ GRAVEL AREA
 - ▭ WALKWAY
 - ▭ BUSHES

- EXCAVATION**
- ▭ 1 foot
 - ▭ 1.5 feet
 - ▭ 2 feet
 - ▭ 2.5 feet
 - ▭ 3 feet



NOT TO SCALE

EXCAVATION DIAGRAM

BALDWINVILLE RESIDENTIAL PROPERTIES
 R-060
 BALDWINVILLE, MASSACHUSETTS




REGION I SUPERFUND TECHNICAL ASSESSMENT AND RESPONSE TEAM

TDD NUMBER: 05-07-0013	CREATED BY: D. MUZRALL	CREATED ON: 1/19/2006
---------------------------	---------------------------	--------------------------

FILE LOCATION:
 E:\ARC_APRs\START2\
 baldwinville_phase2_removal_final.apr

FIGURE 3

REPORTED RESULTS ARE FOR AROCLOR 1254 AND ARE REPORTED IN MG/KG.
 MG/KG = PARTS PER MILLION (PPM).
 U = VALUE IS NON-DETECTED.
 J = VALUE IS ESTIMATED.
 ND = NOT DETECTED.

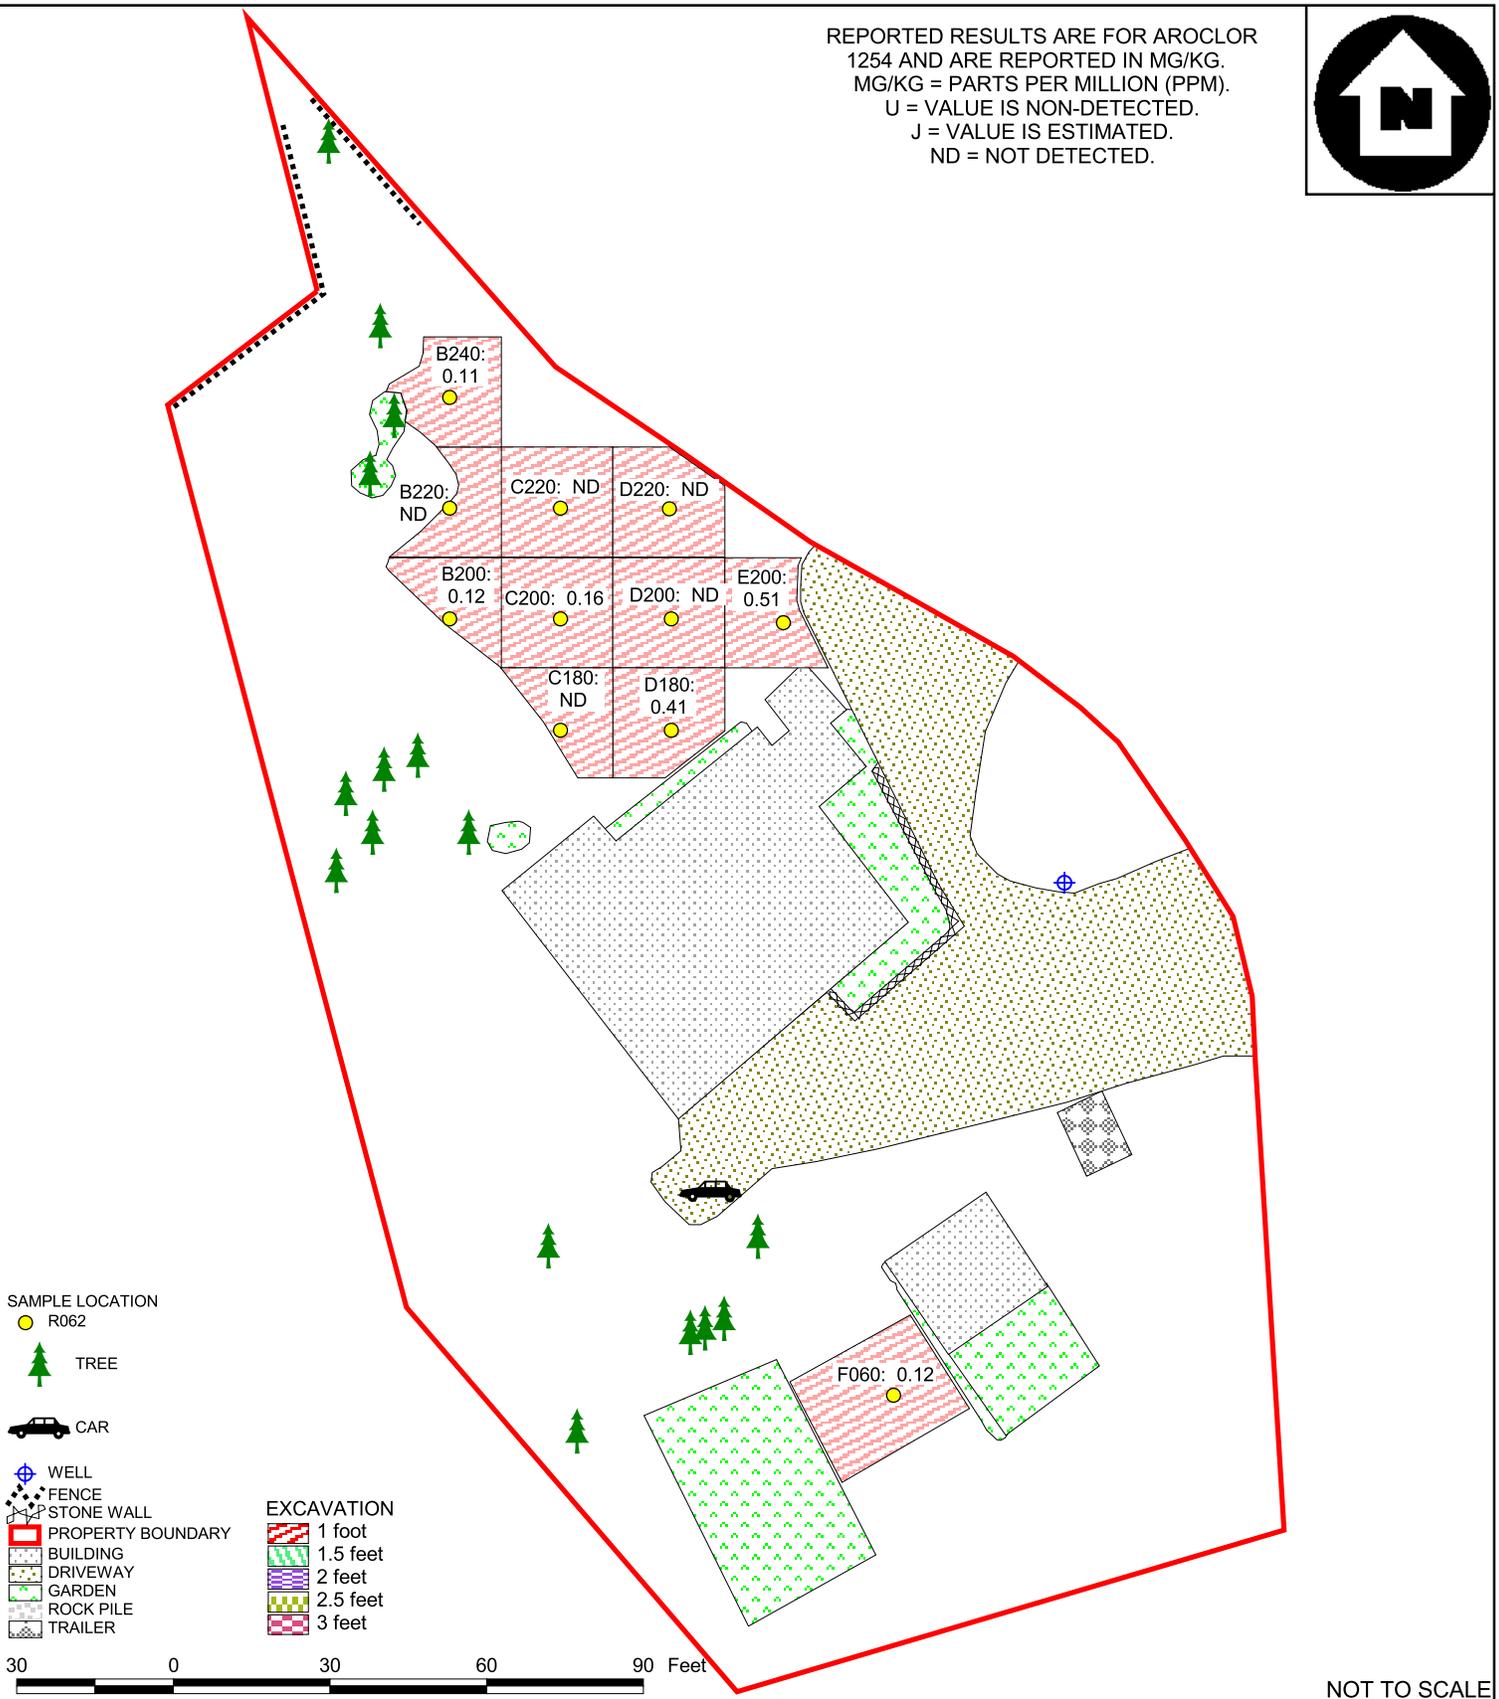

NOT TO SCALE

EXCAVATION DIAGRAM

BALDWINVILLE RESIDENTIAL PROPERTIES
 R062
 BALDWINVILLE, MASSACHUSETTS




REGION I SUPERFUND TECHNICAL ASSESSMENT AND RESPONSE TEAM

TDD NUMBER: 05-07-0013	CREATED BY: D. MUZRALL	CREATED ON: 1/19/2006
---------------------------	---------------------------	--------------------------

FILE LOCATION:
 E:\ARC_APRs\START2\
 baldwinville_phase2_removal_final.apr

FIGURE 3

REPORTED RESULTS ARE FOR AROCLOR
 1254 AND ARE REPORTED IN MG/KG.
 MG/KG = PARTS PER MILLION (PPM).
 ND = NOT DETECTED.

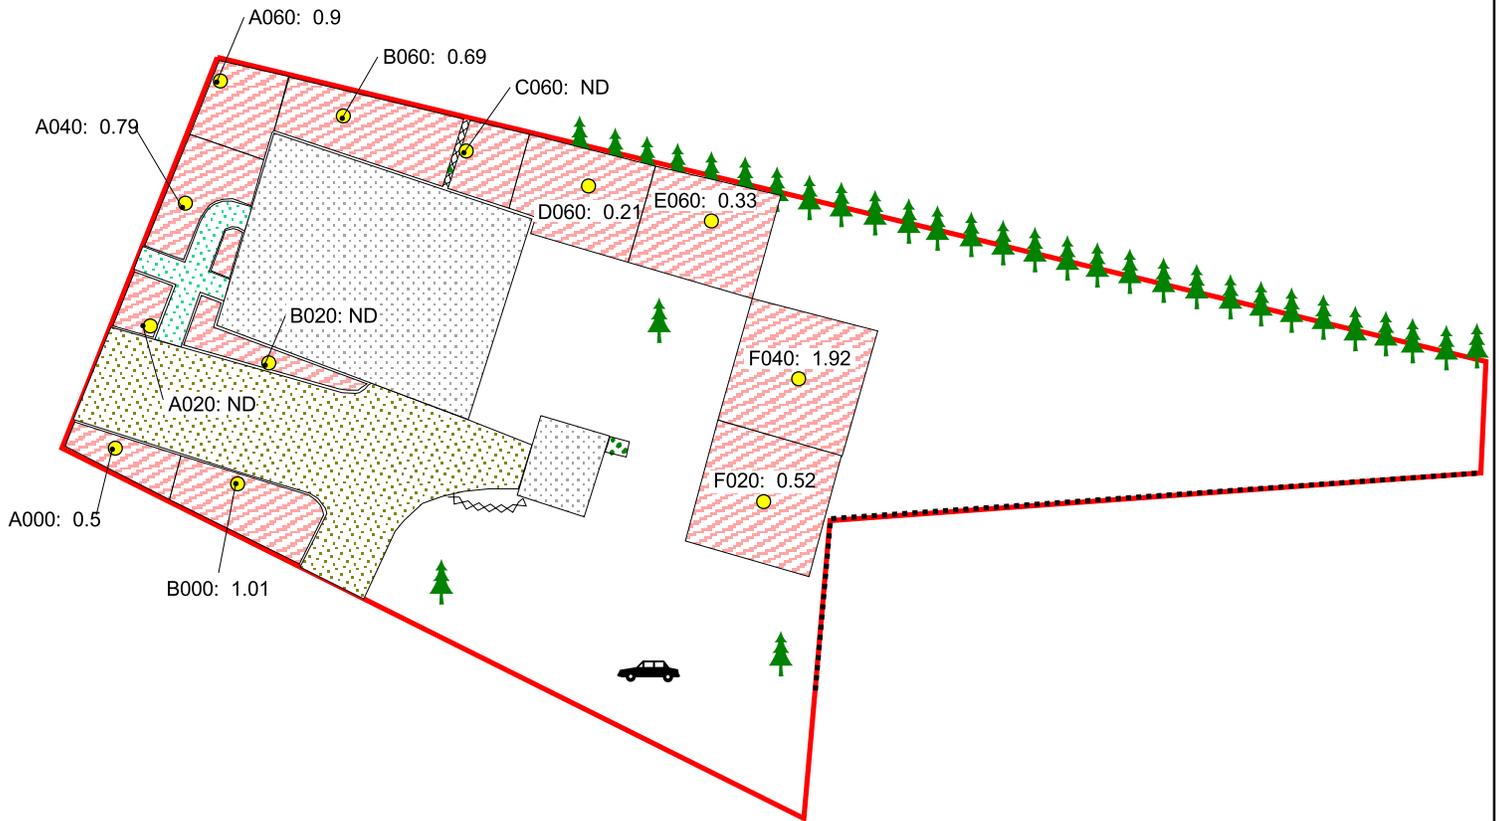

SAMPLE LOCATION
 ● R063



- STONE WALL
- FENCE
- BUILDING
- COMPOST PILE
- WALKWAY
- PAVED AREA
- PROPERTY BOUNDARY

- EXCAVATION
- 1 foot
 - 1.5 feet
 - 2 feet
 - 2.5 feet
 - 3 feet



NOT TO SCALE

EXCAVATION DIAGRAM

BALDWINVILLE RESIDENTIAL PROPERTIES
 R-063
 BALDWINVILLE, MASSACHUSETTS




REGION I SUPERFUND TECHNICAL ASSESSMENT AND RESPONSE TEAM

TDD NUMBER: 05-07-0013	CREATED BY: D. MUZRALL	CREATED ON: 1/19/2006
---------------------------	---------------------------	--------------------------

FILE LOCATION:
 E:\ARC_APRs\START2\
 baldwinville_phase2_removal_final.apr

FIGURE 3

REPORTED RESULTS ARE FOR AROCLOR
1254 AND ARE REPORTED IN MG/KG.
MG/KG = PARTS PER MILLION (PPM).
ND = NOT DETECTED.

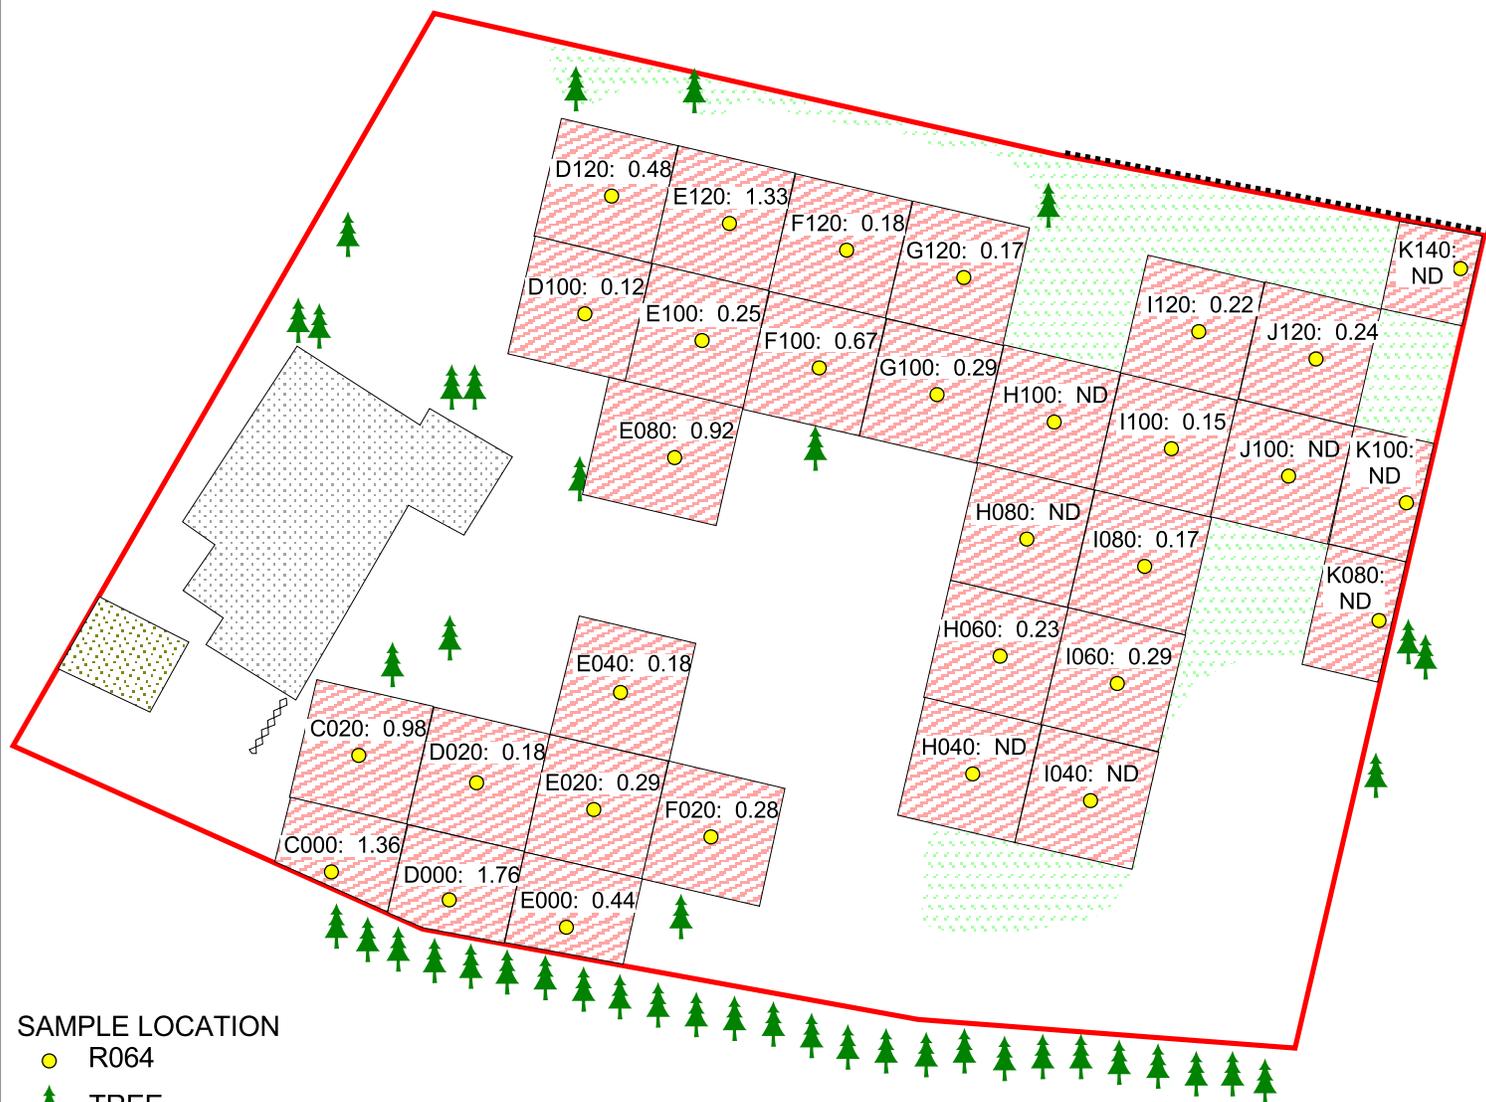

SAMPLE LOCATION

- R064
- TREE
- STONEWALL
- FENCE
- BUILDING
- PAVED AREA
- PROPERTY BOUNDARY
- OVERGROWN AREA

EXCAVATION

- 1 foot
- 1.5 feet
- 2 feet
- 2.5 feet
- 3 feet



NOT TO SCALE

EXCAVATION DIAGRAM


**BALDWINVILLE RESIDENTIAL PROPERTIES
R064
BALDWINVILLE, MASSACHUSETTS**



REGION I SUPERFUND TECHNICAL ASSESSMENT AND RESPONSE TEAM

TDD NUMBER: 05-07-0013	CREATED BY: D. MUZRALL	CREATED ON: 1/19/2006
FILE LOCATION: E:\ARC_APRs\START2\ baldwinville_phase2_removal_final.apr		FIGURE 3

REPORTED RESULTS ARE FOR AROCLOR
1254 AND ARE REPORTED IN MG/KG.
MG/KG = PARTS PER MILLION (PPM).

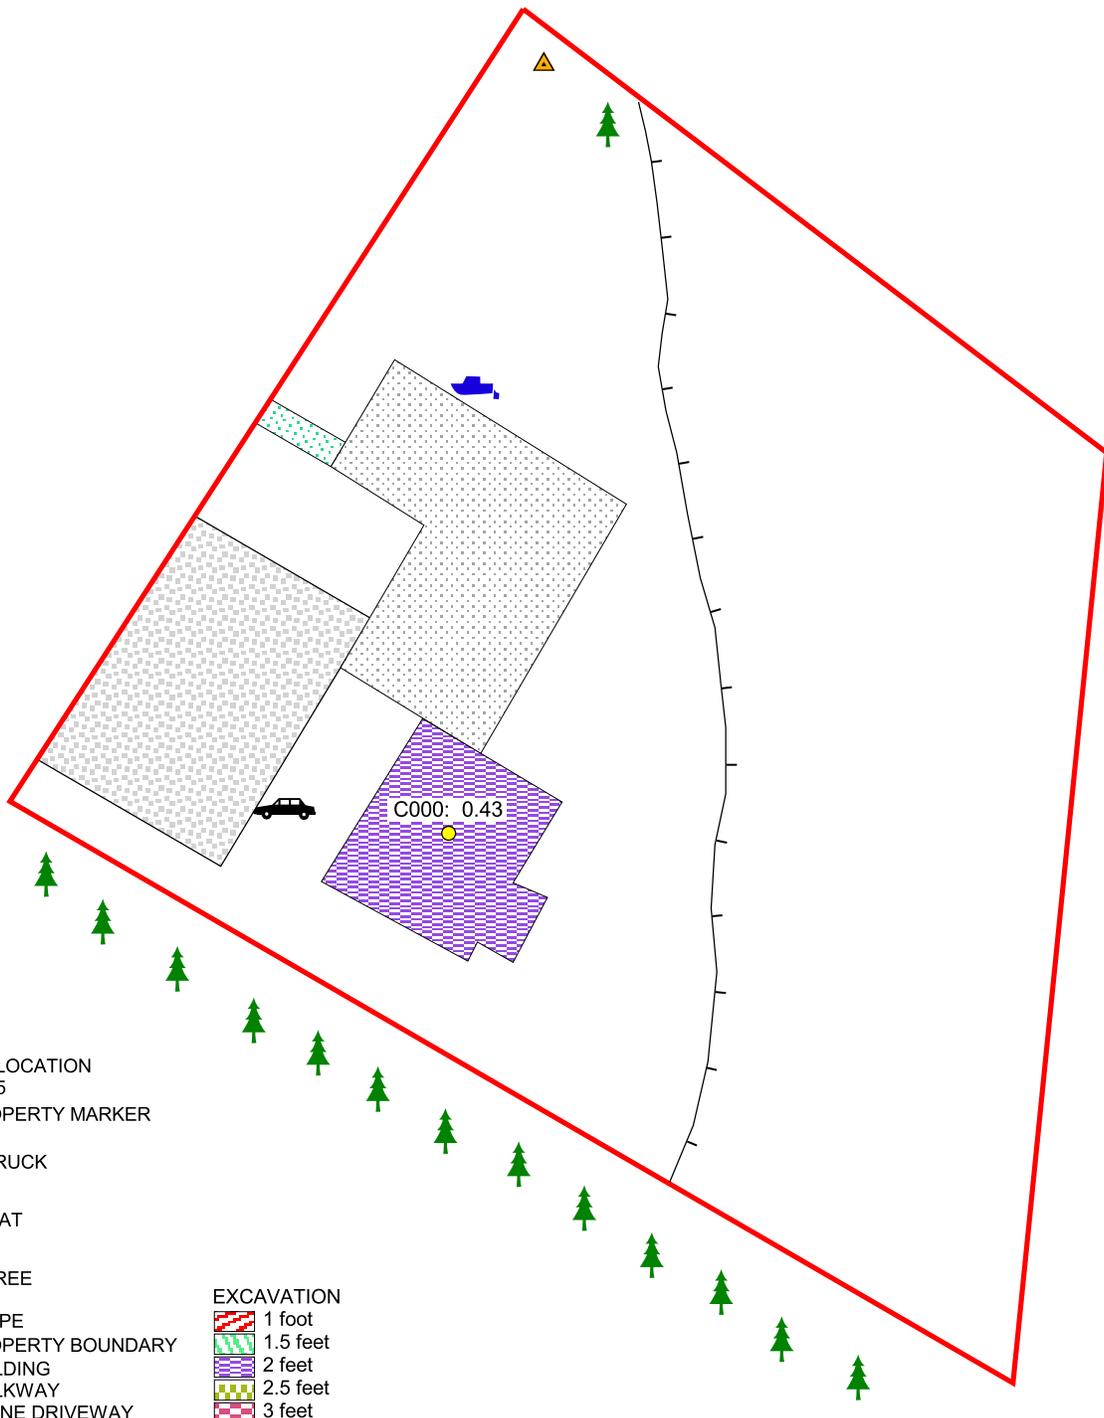

SAMPLE LOCATION
● R065
▲ PROPERTY MARKER

TRUCK
BOAT
TREE

∇ SLOPE
□ PROPERTY BOUNDARY
▨ BUILDING
▧ WALKWAY
▩ STONE DRIVEWAY

EXCAVATION
▨ 1 foot
▧ 1.5 feet
▩ 2 feet
▩ 2.5 feet
▩ 3 feet

20 0 20 40 60 80 100 Feet

NOT TO SCALE

EXCAVATION DIAGRAM

BALDWINVILLE RESIDENTIAL PROPERTIES
R065
BALDWINVILLE, MASSACHUSETTS




REGION I SUPERFUND TECHNICAL ASSESSMENT AND RESPONSE TEAM

TDD NUMBER: 05-07-0013	CREATED BY: D. MUZRALL	CREATED ON: 1/19/2006
---------------------------	---------------------------	--------------------------

FILE LOCATION: E:\ARC_APRs\START2\ baldwinville_phase2_removal_final.apr	FIGURE 3
--	----------

REPORTED RESULTS ARE FOR AROCLOR
 1254 AND ARE REPORTED IN MG/KG.
 MG/KG = PARTS PER MILLION (PPM).
 ND = NOT DETECTED.

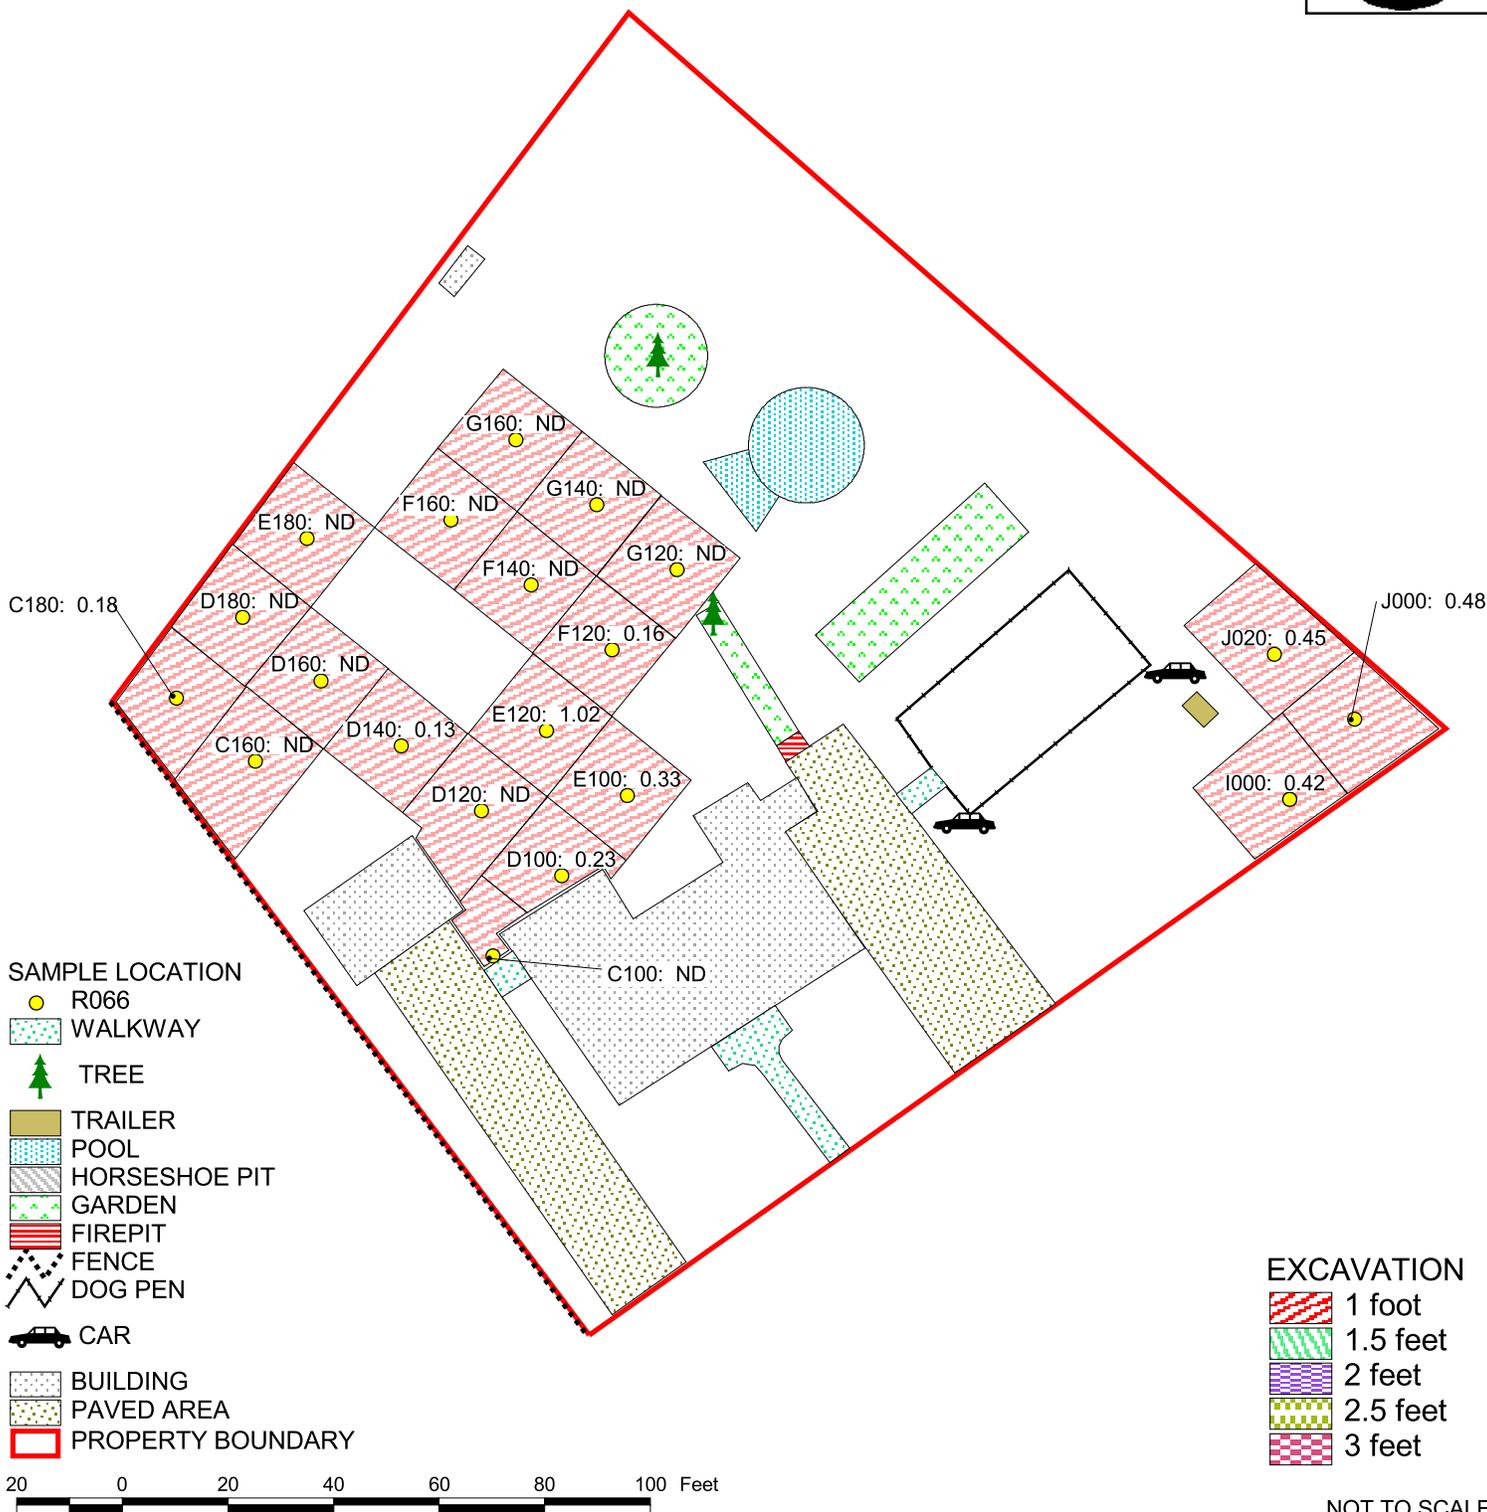

EXCAVATION DIAGRAM

BALDWINVILLE RESIDENTIAL PROPERTIES
R-066
BALDWINVILLE, MASSACHUSETTS

WESTON SOLUTIONS
 Restoring Resource Efficiency

REGION I SUPERFUND TECHNICAL ASSESSMENT AND RESPONSE TEAM

TDD NUMBER: 05-07-0013	CREATED BY: D. MUZRALL	CREATED ON: 1/19/2006
FILE LOCATION: E:\ARC_APRs\START2\ baldwinville_phase2_removal_final.apr		FIGURE 3

REPORTED RESULTS ARE FOR AROCLOR 1254 AND ARE REPORTED IN MG/KG.
 MG/KG = PARTS PER MILLION (PPM).
 ND = NOT DETECTED.



EXCAVATION DIAGRAM


BALDWINVILLE RESIDENTIAL PROPERTIES
 R-067
 BALDWINVILLE, MASSACHUSETTS



REGION I SUPERFUND TECHNICAL ASSESSMENT AND RESPONSE TEAM

TDD NUMBER: 05-07-0013	CREATED BY: D. MUZRALL	CREATED ON: 1/19/2006
FILE LOCATION: E:\ARC_APRs\START2\ baldwinville_phase2_removal_final.apr		FIGURE 3

REPORTED RESULTS ARE FOR AROCLOR
1254 AND ARE REPORTED IN MG/KG.
MG/KG = PARTS PER MILLION (PPM).

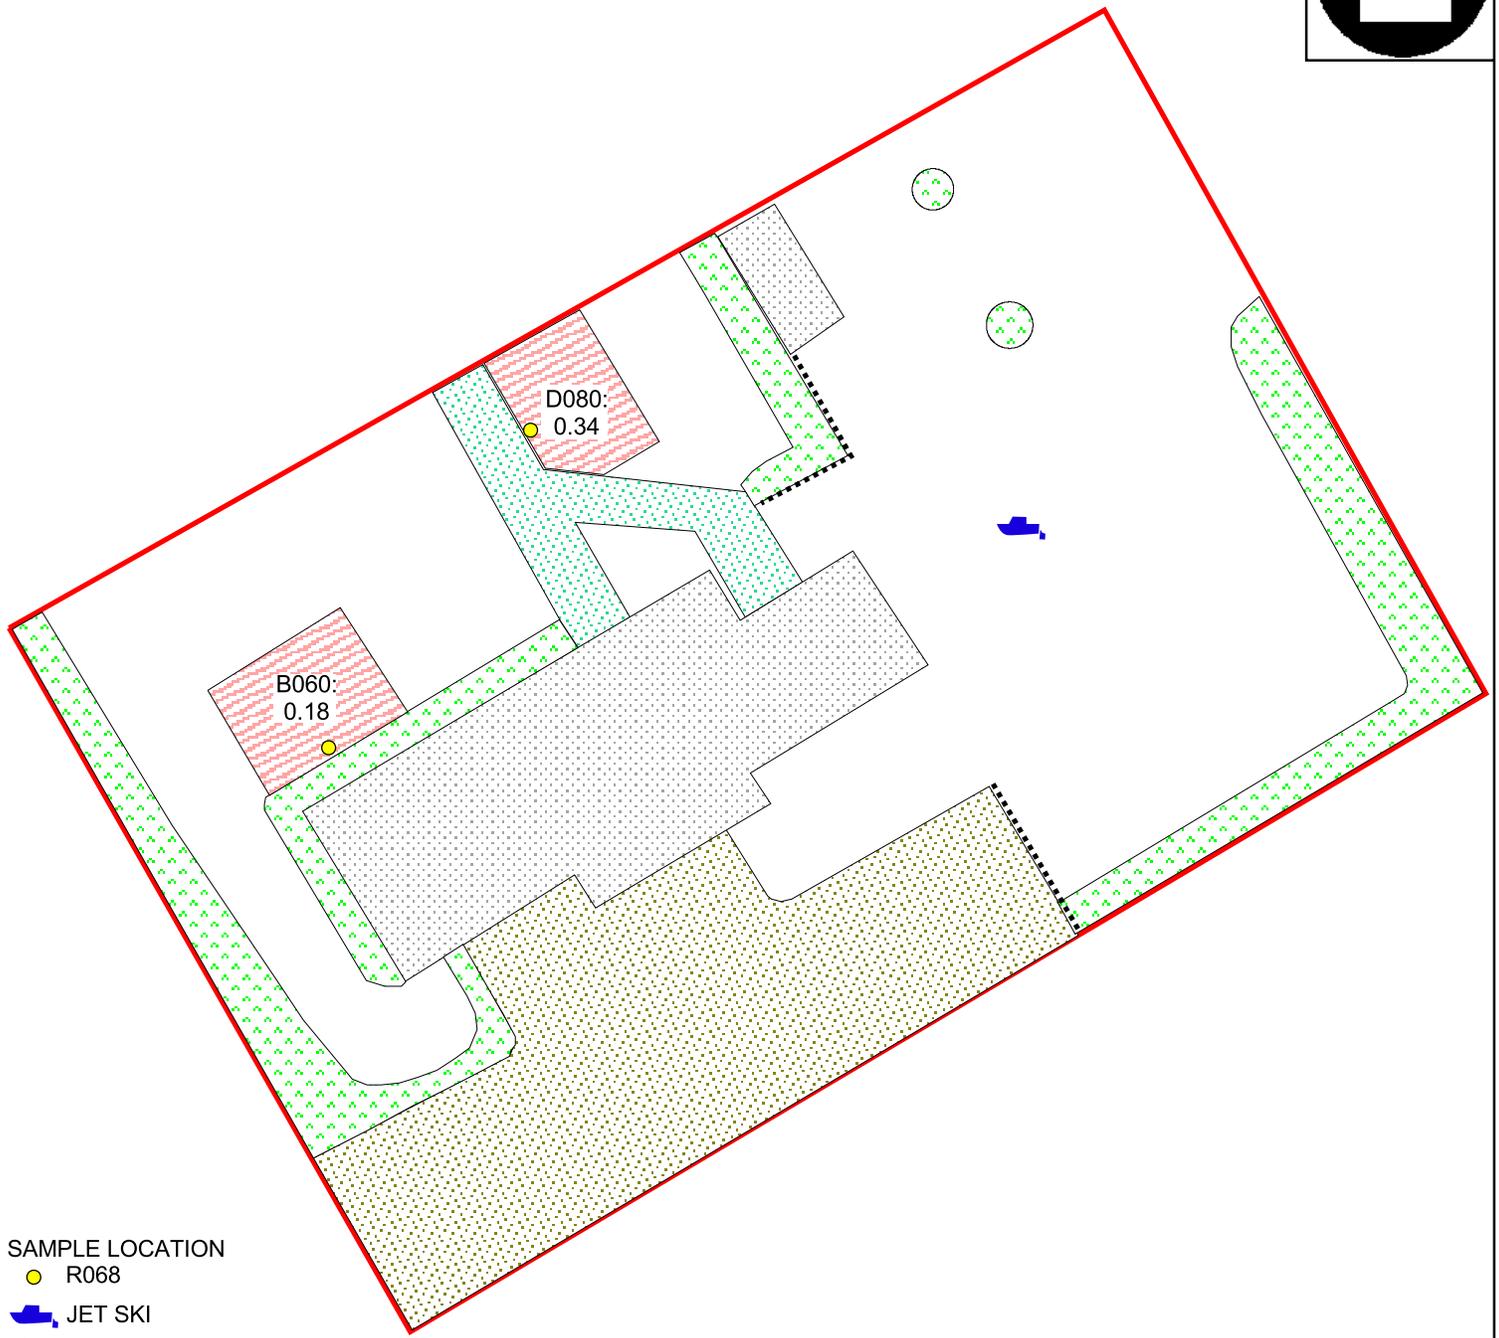

SAMPLE LOCATION

- R068
- JET SKI

- FENCE
- GARDEN
- BUILDING
- WALKWAY
- PAVED AREA
- PROPERTY BOUNDARY

EXCAVATION

- 1 foot
- 1.5 feet
- 2 feet
- 2.5 feet
- 3 feet

20 0 20 40 60 80 100 Feet

NOT TO SCALE

EXCAVATION DIAGRAM

BALDWINVILLE RESIDENTIAL PROPERTIES
R-068
BALDWINVILLE, MASSACHUSETTS




REGION I SUPERFUND TECHNICAL ASSESSMENT AND RESPONSE TEAM

TDD NUMBER: 05-07-0013	CREATED BY: D. MUZRALL	CREATED ON: 1/19/2006
---------------------------	---------------------------	--------------------------

FILE LOCATION:
E:\ARC_APRs\START2\
baldwinville_phase2_removal_final.apr

FIGURE 3

REPORTED RESULTS ARE FOR AROCLOR
 1254 AND ARE REPORTED IN MG/KG.
 MG/KG = PARTS PER MILLION (PPM).
 ND = NOT DETECTED.

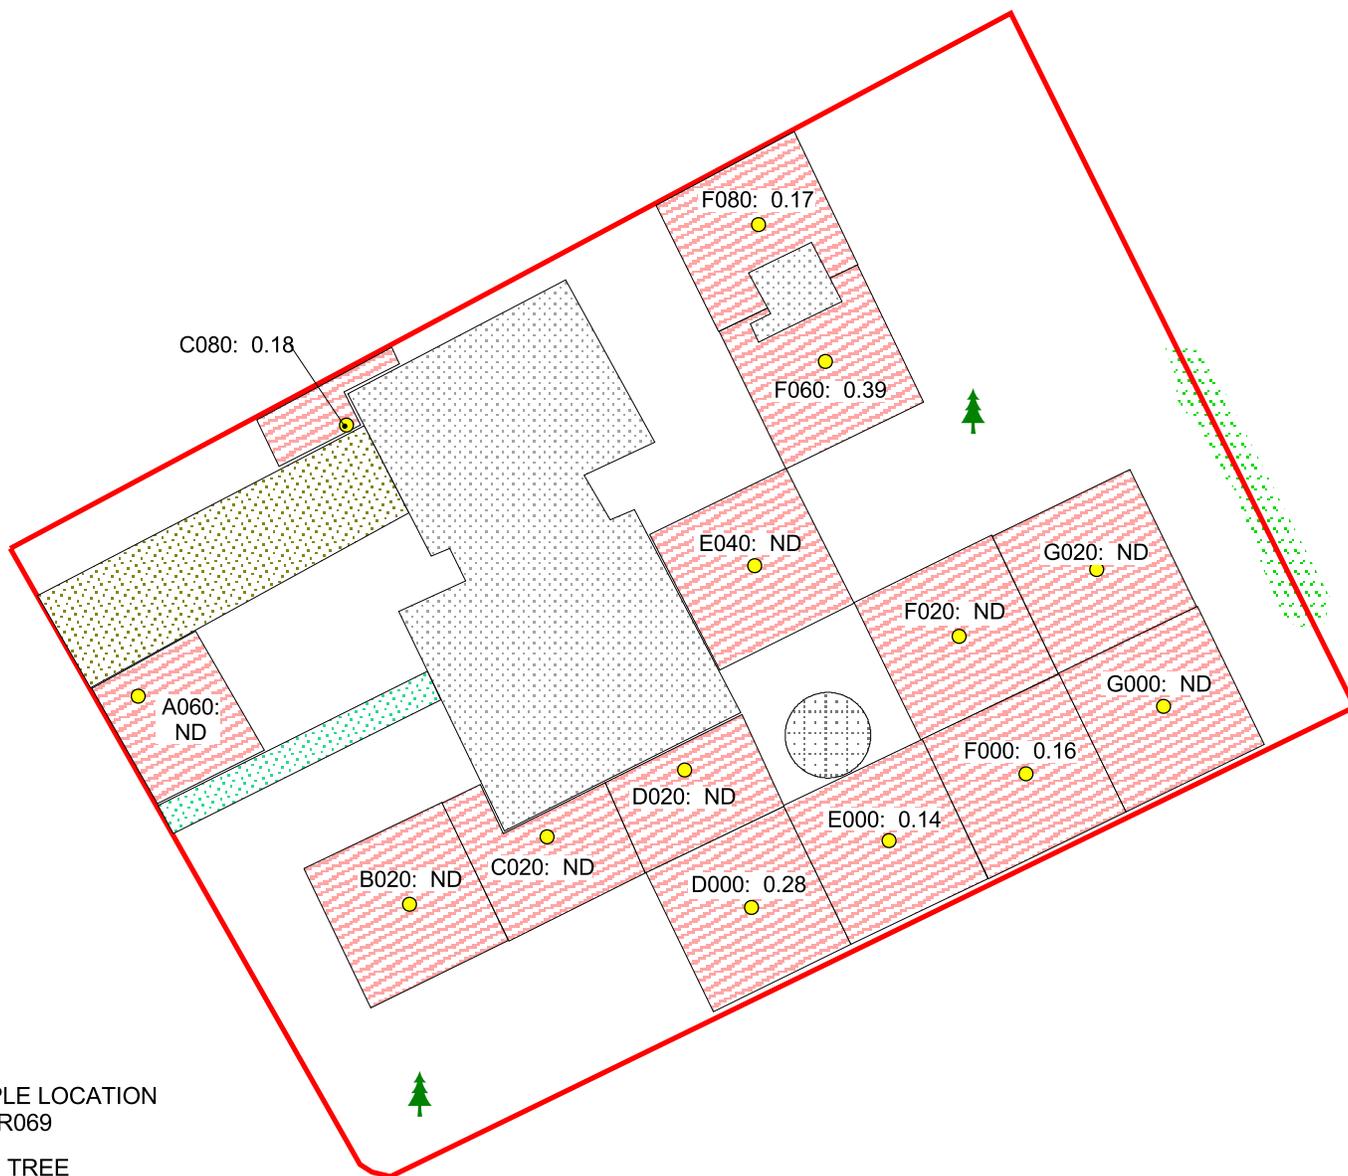

SAMPLE LOCATION

- R069
- 🌲 TREE

- ▨ TRAMPOLINE
- ▨ FIRE PIT
- ▨ BUILDING
- ▨ PAVED AREA
- ▨ WALKWAY
- ▨ PROPERTY BOUNDARY
- ▨ OVERGROWN

- EXCAVATION
- ▨ 1 foot
 - ▨ 1.5 feet
 - ▨ 2 feet
 - ▨ 2.5 feet
 - ▨ 3 feet



NOT TO SCALE

EXCAVATION DIAGRAM


BALDWINVILLE RESIDENTIAL PROPERTIES
 R-069
 BALDWINVILLE, MASSACHUSETTS



REGION I SUPERFUND TECHNICAL ASSESSMENT AND RESPONSE TEAM

TDD NUMBER: 05-07-0013	CREATED BY: D. MUZRALL	CREATED ON: 1/19/2006
FILE LOCATION: E:\ARC_APRs\START2\ baldwinville_phase2_removal_final.apr		FIGURE 3

REPORTED RESULTS ARE FOR AROCLOR
1254 AND ARE REPORTED IN MG/KG.
MG/KG = PARTS PER MILLION (PPM).

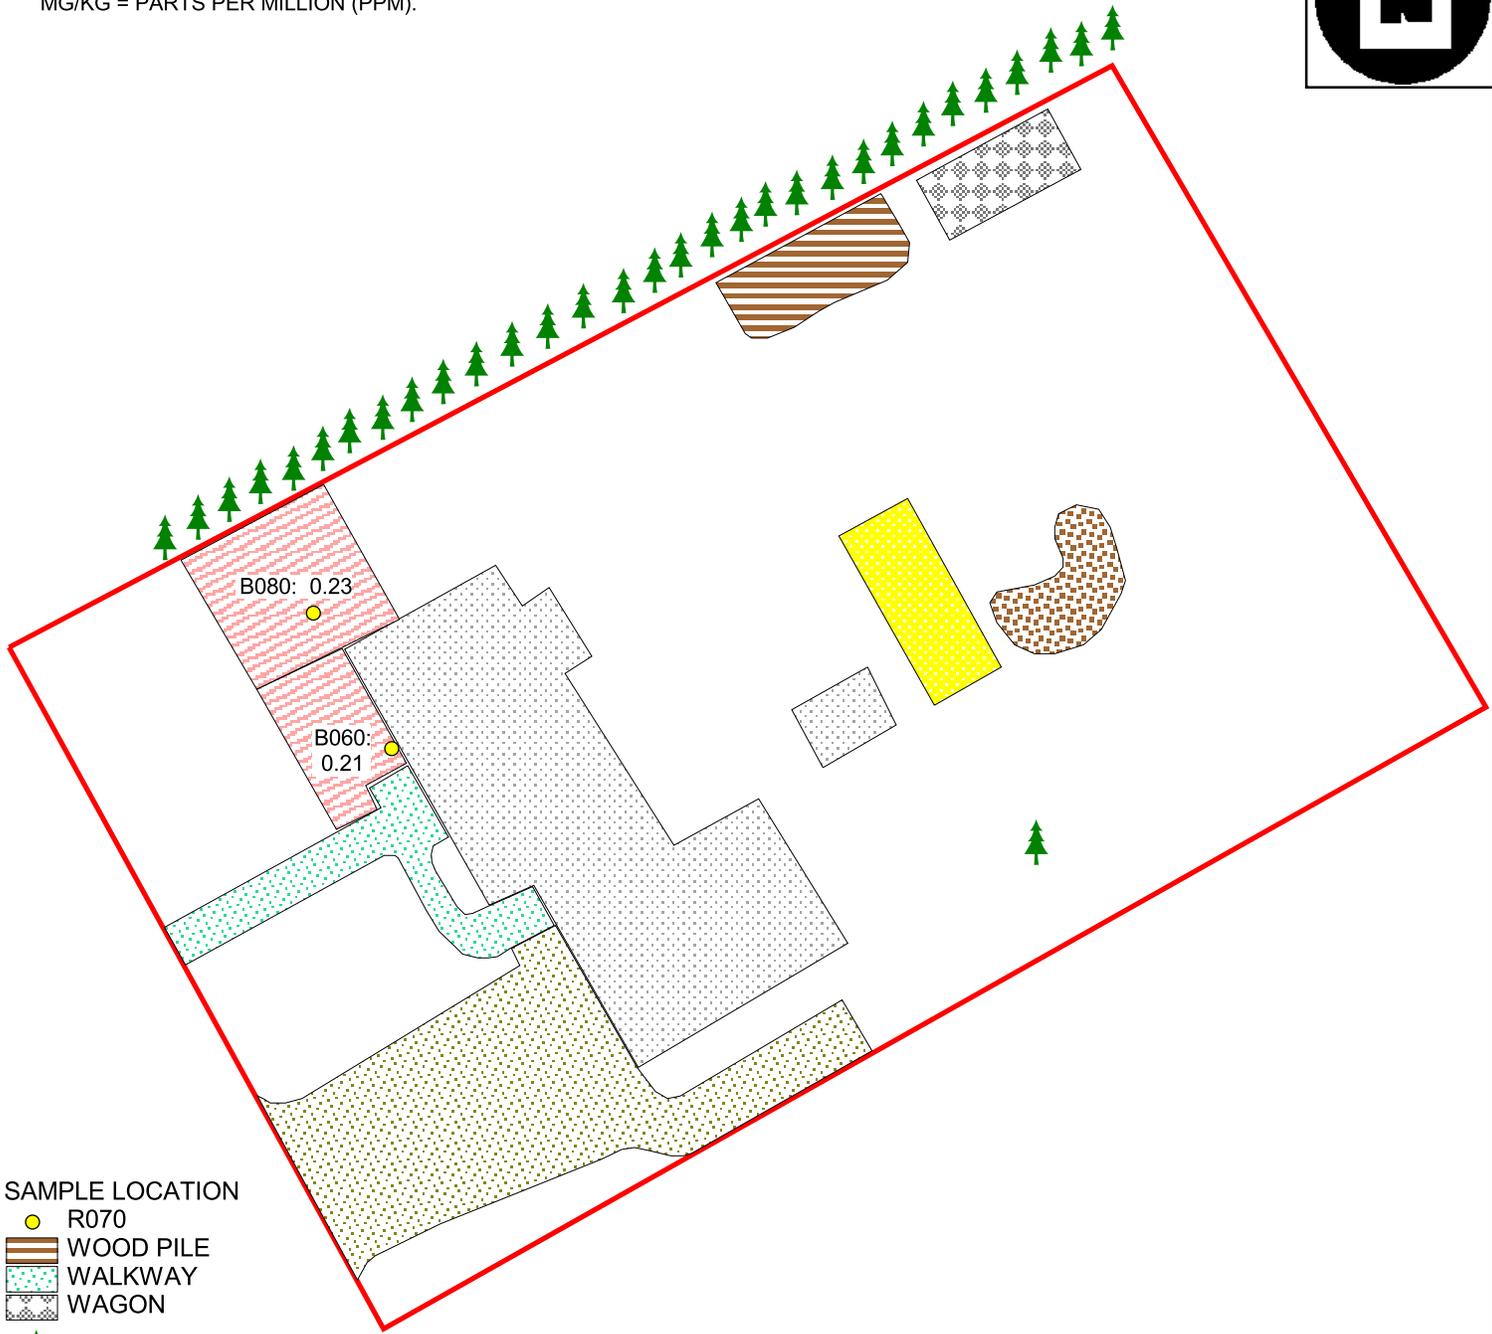

SAMPLE LOCATION

- R070
- WOOD PILE
- WALKWAY
- WAGON



- PAVED AREA
- MOUNDED AREA
- BUILDING
- BACKHOE
- PROPERTY BOUNDARY

EXCAVATION

- 1 foot
- 1.5 feet
- 2 feet
- 2.5 feet
- 3 feet



NOT TO SCALE

EXCAVATION DIAGRAM

BALDWINVILLE RESIDENTIAL PROPERTIES
R-070
BALDWINVILLE, MASSACHUSETTS




REGION I SUPERFUND TECHNICAL ASSESSMENT AND RESPONSE TEAM

TDD NUMBER: 05-07-0013	CREATED BY: D. MUZRALL	CREATED ON: 1/19/2006
---------------------------	---------------------------	--------------------------

FILE LOCATION:
E:\ARC_APRs\START2\
baldwinville_phase2_removal_final.apr

FIGURE 3

REPORTED RESULTS ARE FOR AROCLOR
 1254 AND ARE REPORTED IN MG/KG.
 MG/KG = PARTS PER MILLION (PPM).
 ND = NOT DETECTED.

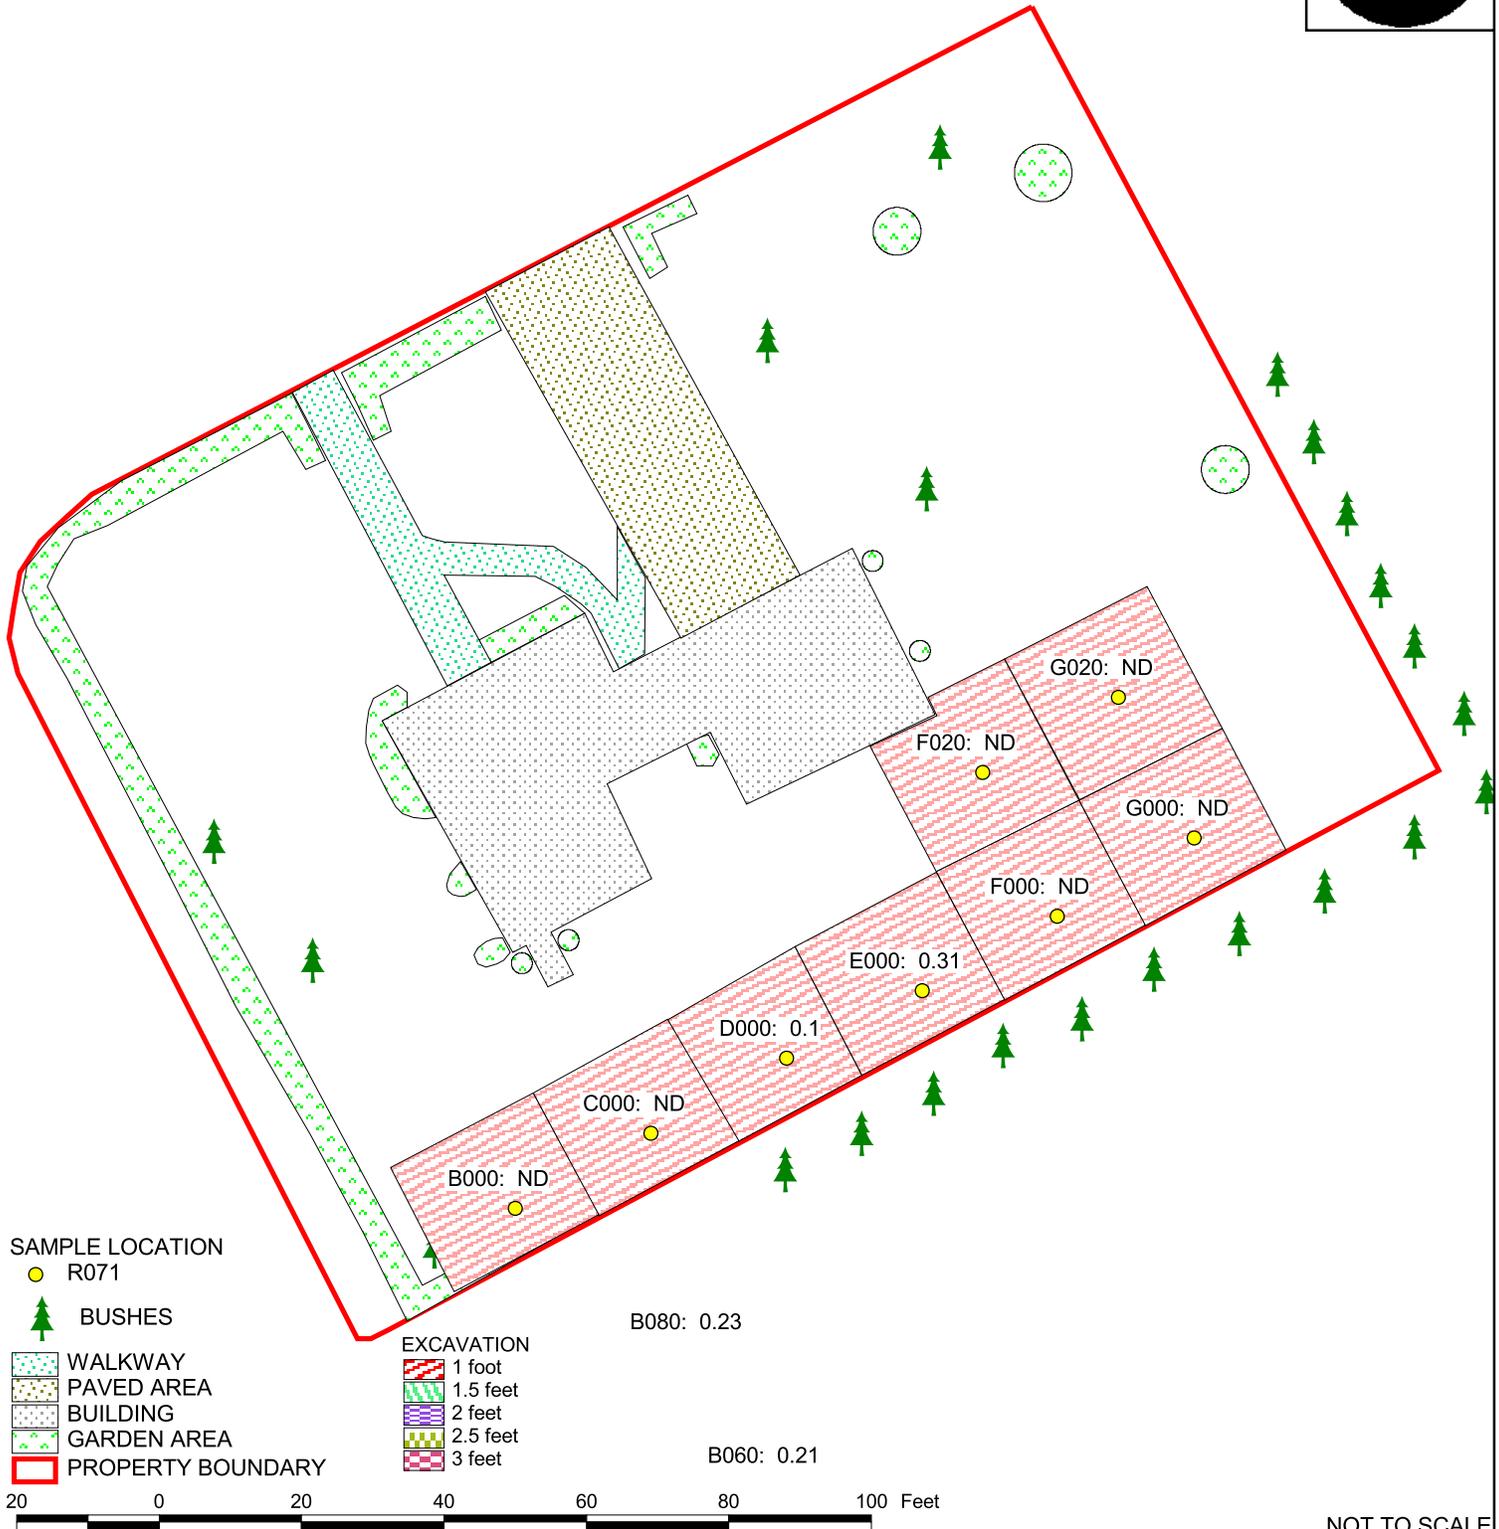

EXCAVATION DIAGRAM


BALDWINVILLE RESIDENTIAL PROPERTIES
 R-071
 BALDWINVILLE, MASSACHUSETTS



REGION I SUPERFUND TECHNICAL ASSESSMENT AND RESPONSE TEAM

TDD NUMBER: 05-07-0013	CREATED BY: D. MUZRALL	CREATED ON: 1/19/2006
FILE LOCATION: E:\ARC_APRs\START2\ baldwinville_phase2_removal_final.apr		FIGURE 3

REPORTED RESULTS ARE FOR AROCLOR
 1254 AND ARE REPORTED IN MG/KG.
 MG/KG = PARTS PER MILLION (PPM).
 ND = NOT DETECTED.

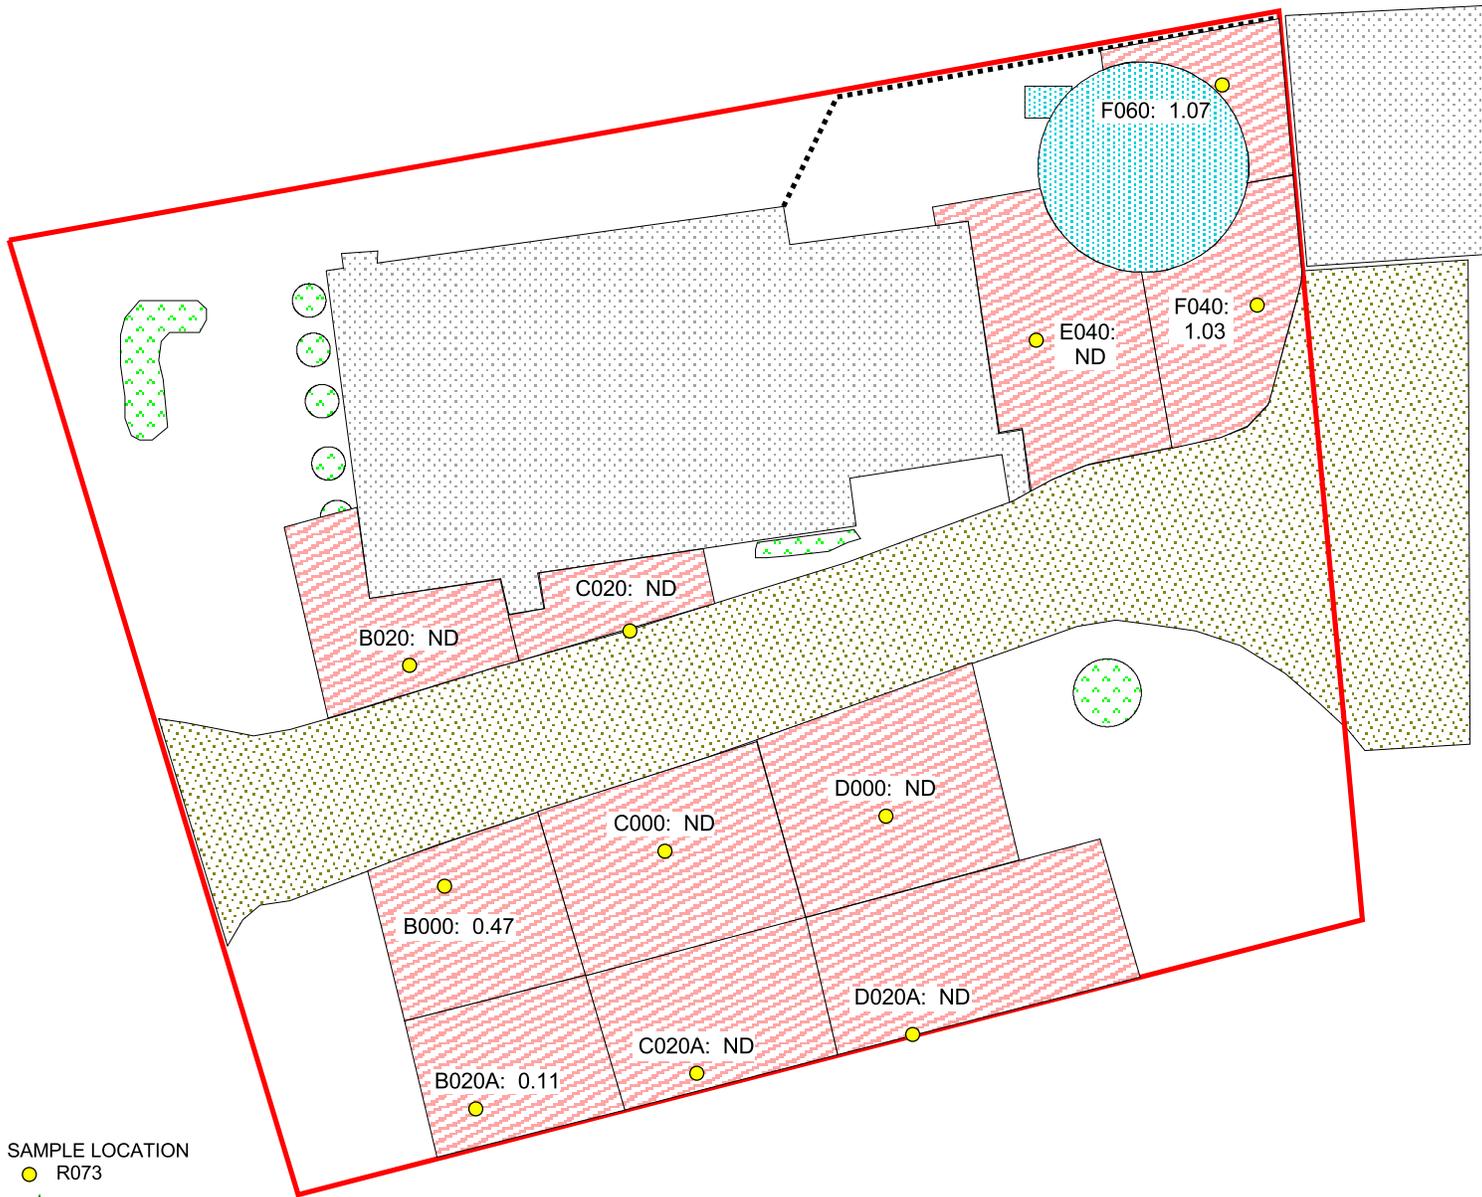

- SAMPLE LOCATION
 ● R073
- 🌲 TREE
- 🌿 GARDEN AREA
 - 🚧 FENCE
 - 🏠 BUILDING
 - 🏊 POOL
 - 🔴 PROPERTY BOUNDARY
 - 🏞️ GRAVEL AREA

- EXCAVATION
- 🔴 1 foot
 - 🟢 1.5 feet
 - 🟡 2 feet
 - 🟠 2.5 feet
 - 🟤 3 feet



NOT TO SCALE

EXCAVATION DIAGRAM

BALDWINVILLE RESIDENTIAL PROPERTIES
 R-073
 BALDWINVILLE, MASSACHUSETTS




REGION I SUPERFUND TECHNICAL ASSESSMENT AND RESPONSE TEAM

TDD NUMBER: 05-07-0013	CREATED BY: D. MUZRALL	CREATED ON: 1/19/2006
---------------------------	---------------------------	--------------------------

FILE LOCATION:
 E:\ARC_APRs\START2\
 baldwinville_phase2_removal_final.apr

FIGURE 3

REPORTED RESULTS ARE FOR AROCLOR
1254 AND ARE REPORTED IN MG/KG.
MG/KG = PARTS PER MILLION (PPM).

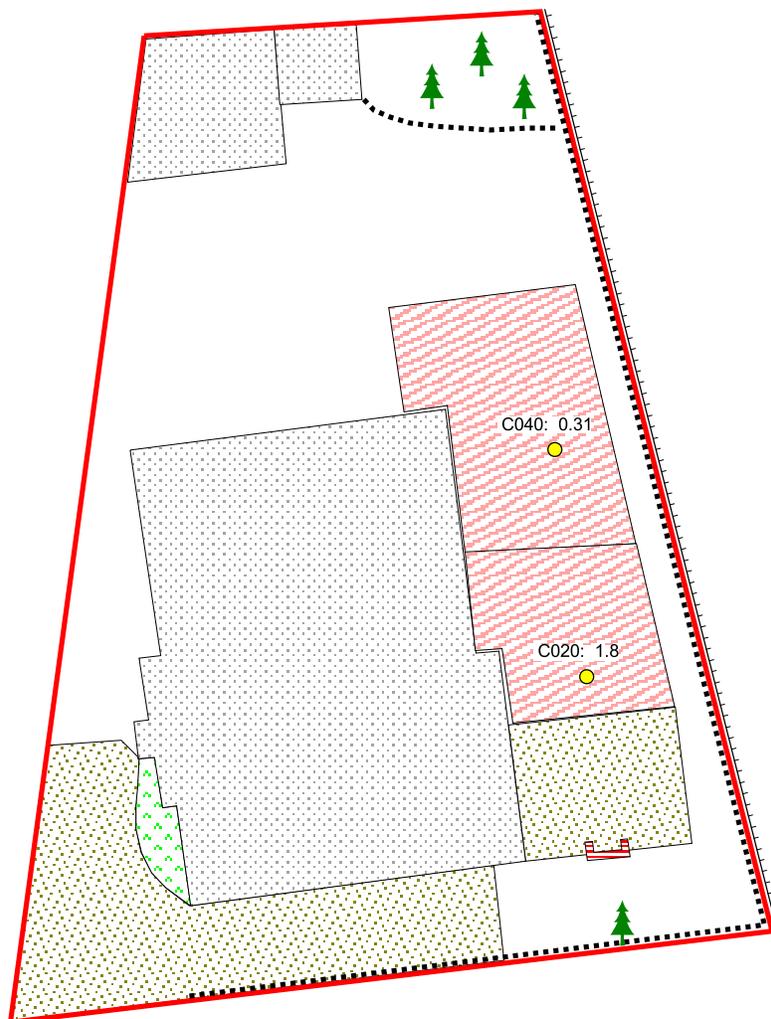

SAMPLE LOCATION
● R076

▲ TREE

- ▲ SLOPE FENCE
- ▭ PROPERTY BOUNDARY
- ▭ BUILDING
- ▭ FIRE PIT
- ▭ GRAVEL AREA
- ▭ FLOWER BED

- EXCAVATION
- ▭ 1 foot
 - ▭ 1.5 feet
 - ▭ 2 feet
 - ▭ 2.5 feet
 - ▭ 3 feet



NOT TO SCALE

EXCAVATION DIAGRAM

BALDWINVILLE RESIDENTIAL PROPERTIES
R-076
BALDWINVILLE, MASSACHUSETTS




REGION I SUPERFUND TECHNICAL ASSESSMENT AND RESPONSE TEAM

TDD NUMBER: 05-07-0013	CREATED BY: D. MUZRALL	CREATED ON: 1/19/2006
---------------------------	---------------------------	--------------------------

FILE LOCATION:
E:\ARC_APRs\START2\
baldwinville_phase2_removal_final.apr

FIGURE 3

REPORTED RESULTS ARE FOR AROCLOR
1254 AND ARE REPORTED IN MG/KG.
MG/KG = PARTS PER MILLION (PPM).

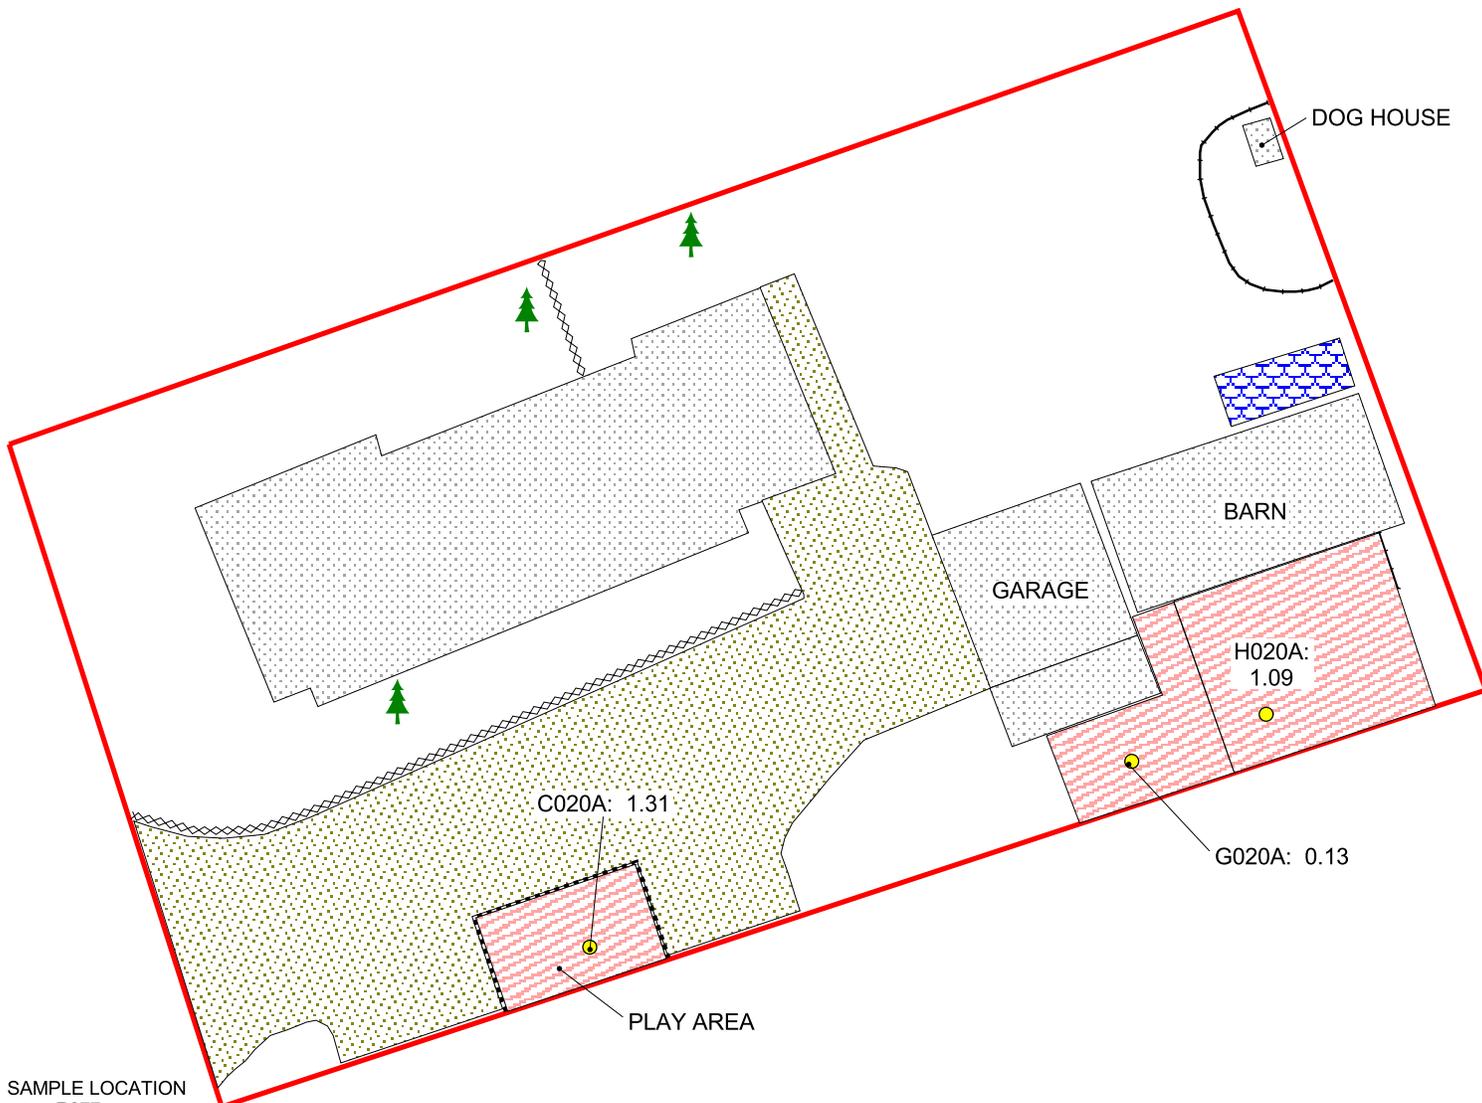

- SAMPLE LOCATION**
● R077
- ▲ TREE
- ▬ RETAINING WALL
▬ FENCE
▬ DOG PEN
▬ PAVED AREA
▬ BUILDING
▬ RV
▬ PROPERTY BOUNDARY

- EXCAVATION**
- ▨ 1 foot
 - ▨ 1.5 feet
 - ▨ 2 feet
 - ▨ 2.5 feet
 - ▨ 3 feet



NOT TO SCALE

EXCAVATION DIAGRAM

BALDWINVILLE RESIDENTIAL PROPERTIES
R-077
BALDWINVILLE, MASSACHUSETTS



REGION I SUPERFUND TECHNICAL ASSESSMENT AND RESPONSE TEAM

TDD NUMBER: 05-07-0013	CREATED BY: D. MUZRALL	CREATED ON: 1/19/2006
---------------------------	---------------------------	--------------------------

FILE LOCATION:
E:\ARC_APRs\START2\
baldwinville_phase2_removal_final.apr

FIGURE 3

REPORTED RESULTS ARE FOR AROCLOR
 1254 AND ARE REPORTED IN MG/KG.
 MG/KG = PARTS PER MILLION (PPM).
 ND = NOT DETECTED.



SAMPLE LOCATION

- R078
- 🌲 TREE
- 🚩 FLAG POLE
- ⚡ FENCE
- ▭ PROPERTY BOUNDARY
- 🌿 BUSHES
- 🌱 GARDEN
- 🏠 BUILDING
- 🛤 PAVED AREA

- EXCAVATION
- ▨ 1 foot
 - ▨ 1.5 feet
 - ▨ 2 feet
 - ▨ 2.5 feet
 - ▨ 3 feet

20 0 20 40 60 80 100 Feet

NOT TO SCALE

EXCAVATION DIAGRAM

BALDWINVILLE RESIDENTIAL PROPERTIES
 R-078
 BALDWINVILLE, MASSACHUSETTS




REGION I SUPERFUND TECHNICAL ASSESSMENT AND RESPONSE TEAM

TDD NUMBER: 05-07-0013	CREATED BY: D. MUZRALL	CREATED ON: 1/19/2006
---------------------------	---------------------------	--------------------------

FILE LOCATION:
 E:\ARC_APRs\START2\
 baldwinville_phase2_removal_final.apr

FIGURE 3

REPORTED RESULTS ARE FOR AROCLOR
 1254 AND ARE REPORTED IN MG/KG.
 MG/KG = PARTS PER MILLION (PPM).
 ND = NOT DETECTED.

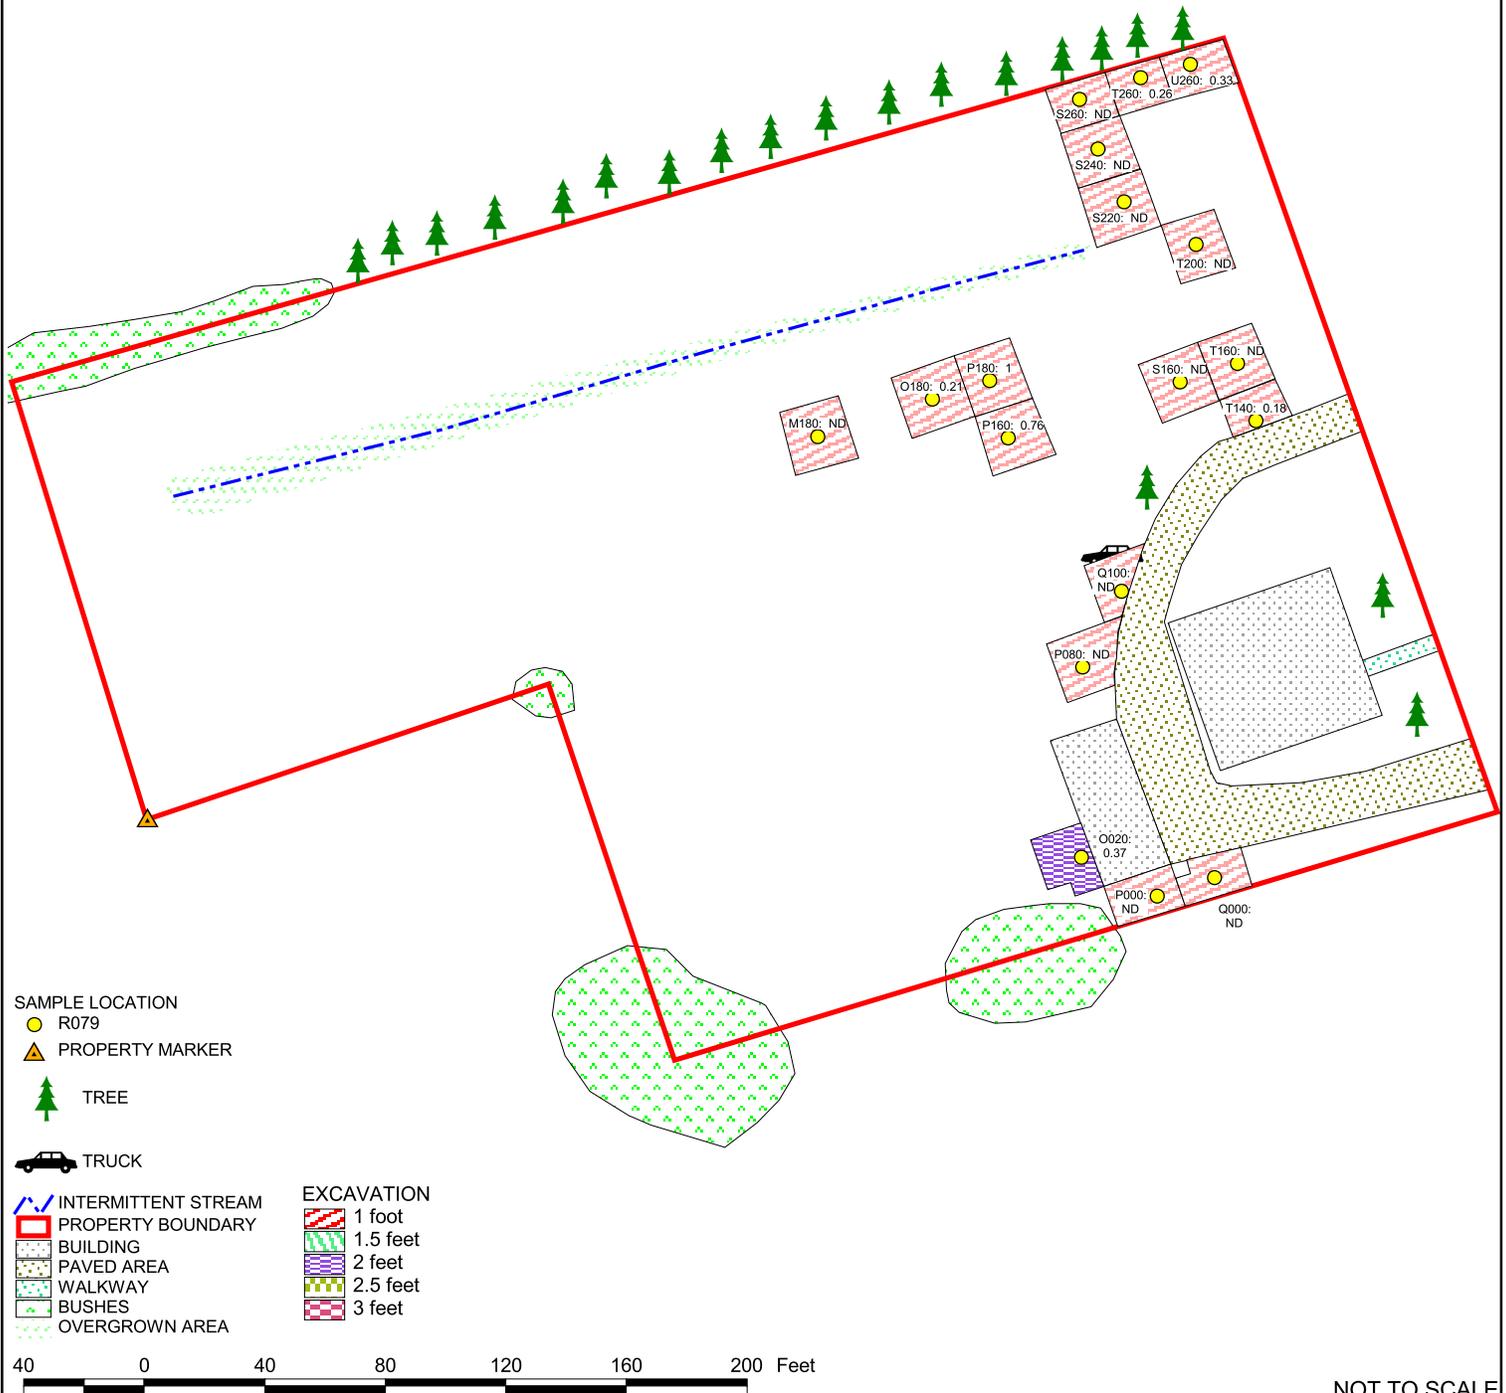

EXCAVATION DIAGRAM


BALDWINVILLE RESIDENTIAL PROPERTIES
 R-079
 BALDWINVILLE, MASSACHUSETTS



REGION I SUPERFUND TECHNICAL ASSESSMENT AND RESPONSE TEAM

TDD NUMBER: 05-07-0013	CREATED BY: D. MUZRALL	CREATED ON: 1/19/2006
FILE LOCATION: E:\ARC_APRs\START2\ baldwinville_phase2_removal_final.apr		FIGURE 3

REPORTED RESULTS ARE FOR AROCLOR
 1254 AND ARE REPORTED IN MG/KG.
 MG/KG = PARTS PER MILLION (PPM).
 ND = NOT DETECTED.

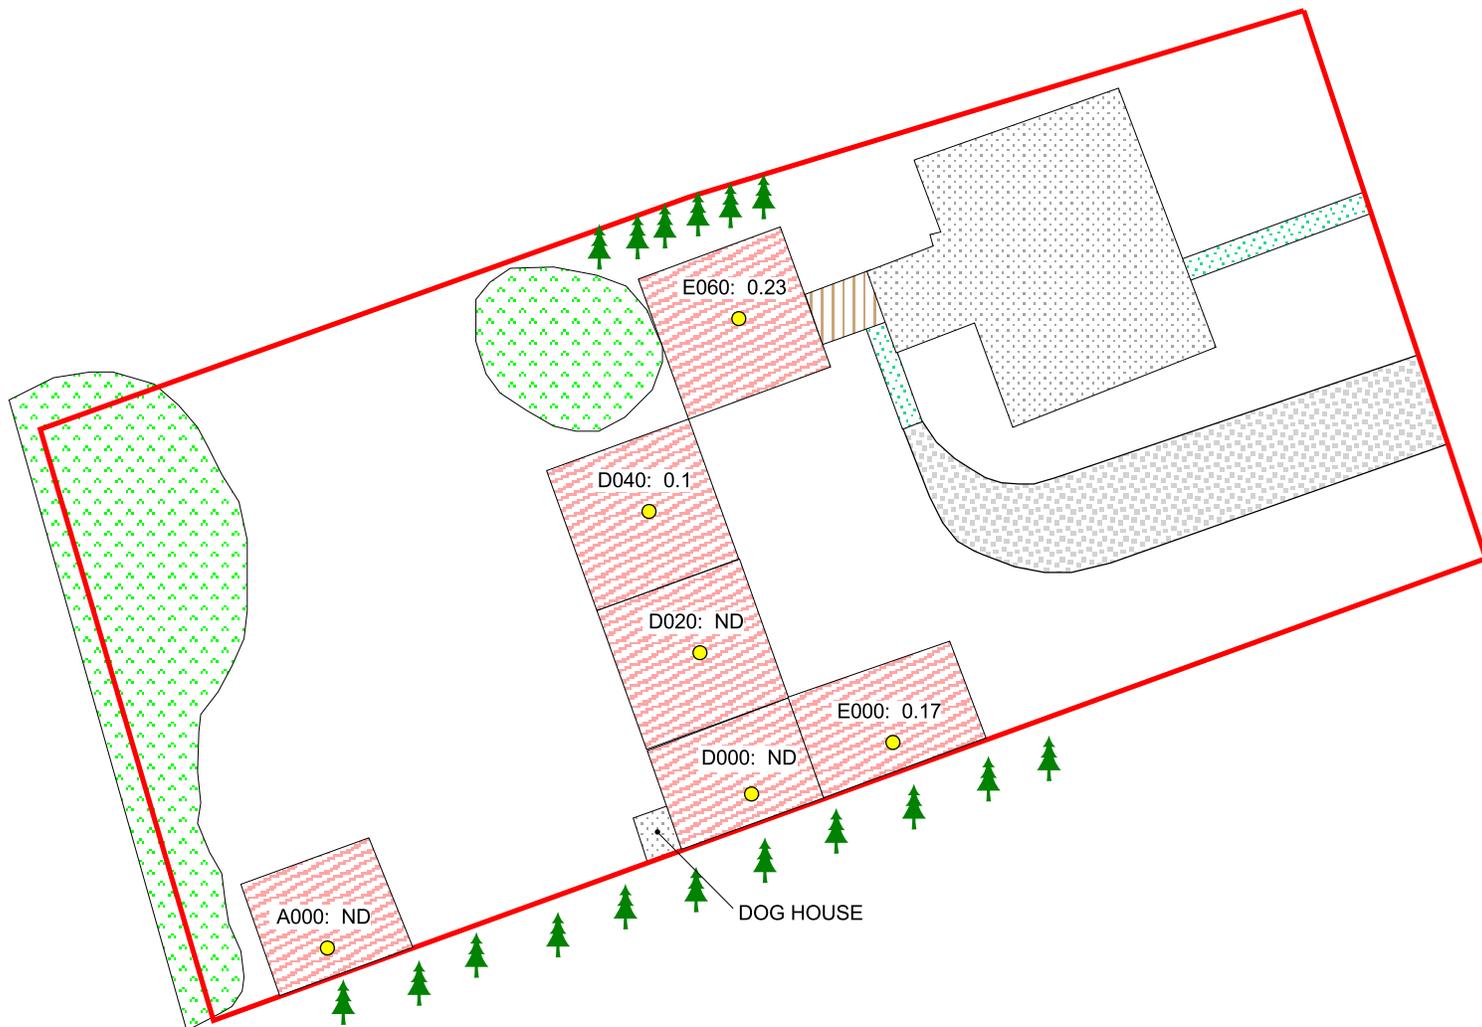

SAMPLE LOCATION

● R080

▲ TREE

PROPERTY BOUNDARY

- BUILDING
- PORCH
- BUSHES
- WALKWAY
- GRAVEL DRIVEWAY

EXCAVATION

- 1 foot
- 1.5 feet
- 2 feet
- 2.5 feet
- 3 feet

30 0 30 60 90 120 150 Feet

EXCAVATION DIAGRAM

BALDWINVILLE RESIDENTIAL PROPERTIES
 R080
 BALDWINVILLE, MASSACHUSETTS




REGION I SUPERFUND TECHNICAL ASSESSMENT AND RESPONSE TEAM

TDD NUMBER: 05-07-0013	CREATED BY: D. MUZRALL	CREATED ON: 1/19/2006
---------------------------	---------------------------	--------------------------

FILE LOCATION:
 E:\ARC_APRs\START2\
 baldwinville_phase2_removal_final.apr

FIGURE 3

REPORTED RESULTS ARE FOR AROCLOR
 1254 AND ARE REPORTED IN MG/KG.
 MG/KG = PARTS PER MILLION (PPM).
 ND = NOT DETECTED.

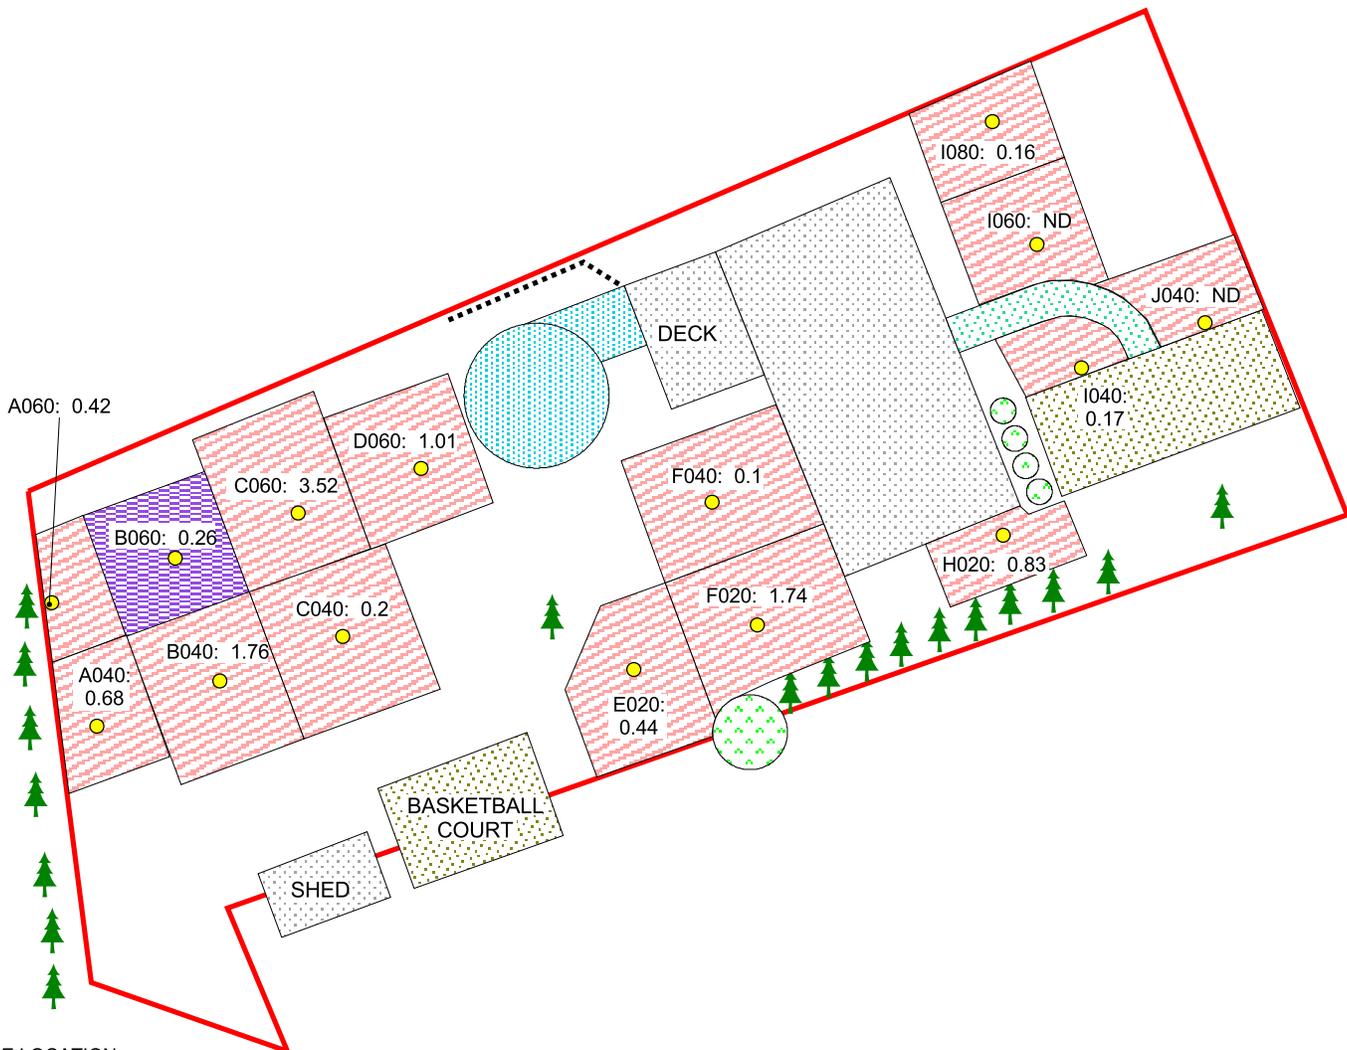

SAMPLE LOCATION
 ● R081



- FENCE
- WALKWAY
- PAVED AREA
- BUILDING
- POOL
- BUSHES
- PROPERTY BOUNDARY

- EXCAVATION
- 1 foot
 - 1.5 feet
 - 2 feet
 - 2.5 feet
 - 3 feet



NOT TO SCALE

EXCAVATION DIAGRAM

BALDWINVILLE RESIDENTIAL PROPERTIES
 R-081
 BALDWINVILLE, MASSACHUSETTS




REGION I SUPERFUND TECHNICAL ASSESSMENT AND RESPONSE TEAM

TDD NUMBER: 05-07-0013	CREATED BY: D. MUZRALL	CREATED ON: 1/19/2006
---------------------------	---------------------------	--------------------------

FILE LOCATION:
 E:\ARC_APRs\START2\
 baldwinville_phase2_removal_final.apr

FIGURE 3

REPORTED RESULTS ARE FOR AROCLOR
1254 AND ARE REPORTED IN MG/KG.
MG/KG = PARTS PER MILLION (PPM).

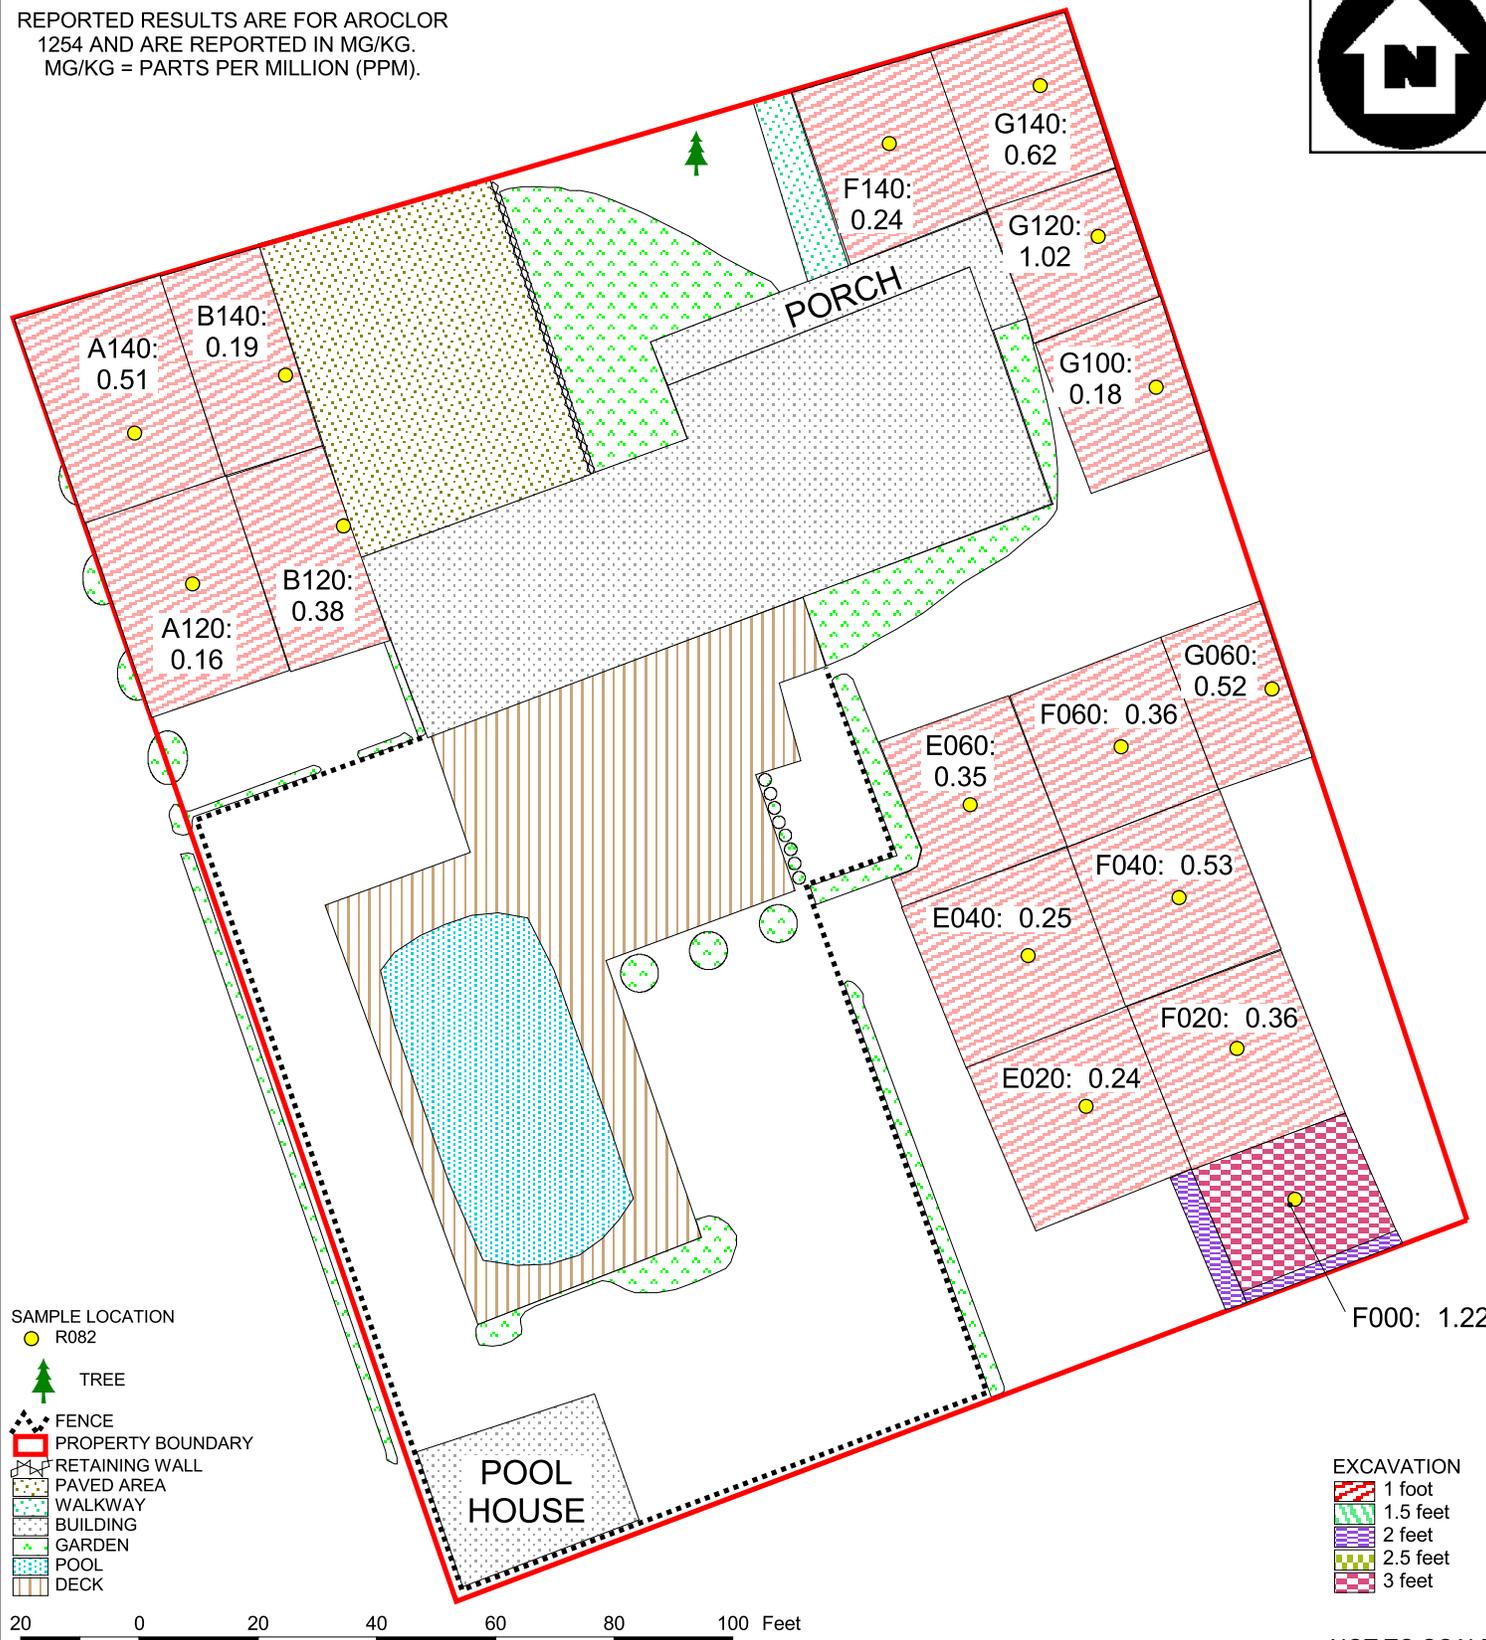

EXCAVATION DIAGRAM

BALDWINVILLE RESIDENTIAL PROPERTIES
R-082
BALDWINVILLE, MASSACHUSETTS


WESTON SOLUTIONS
Restoring Resource Efficiency

REGION I SUPERFUND TECHNICAL ASSESSMENT AND RESPONSE TEAM

TDD NUMBER: 05-07-0013	CREATED BY: D. MUZRALL	CREATED ON: 1/19/2006
FILE LOCATION: E:\ARC_APRs\START2\ baldwinville_phase2_removal_final.apr		FIGURE 3

NOT TO SCALE

REPORTED RESULTS ARE FOR AROCLOR
 1254 AND ARE REPORTED IN MG/KG.
 MG/KG = PARTS PER MILLION (PPM).
 ND = NOT DETECTED.

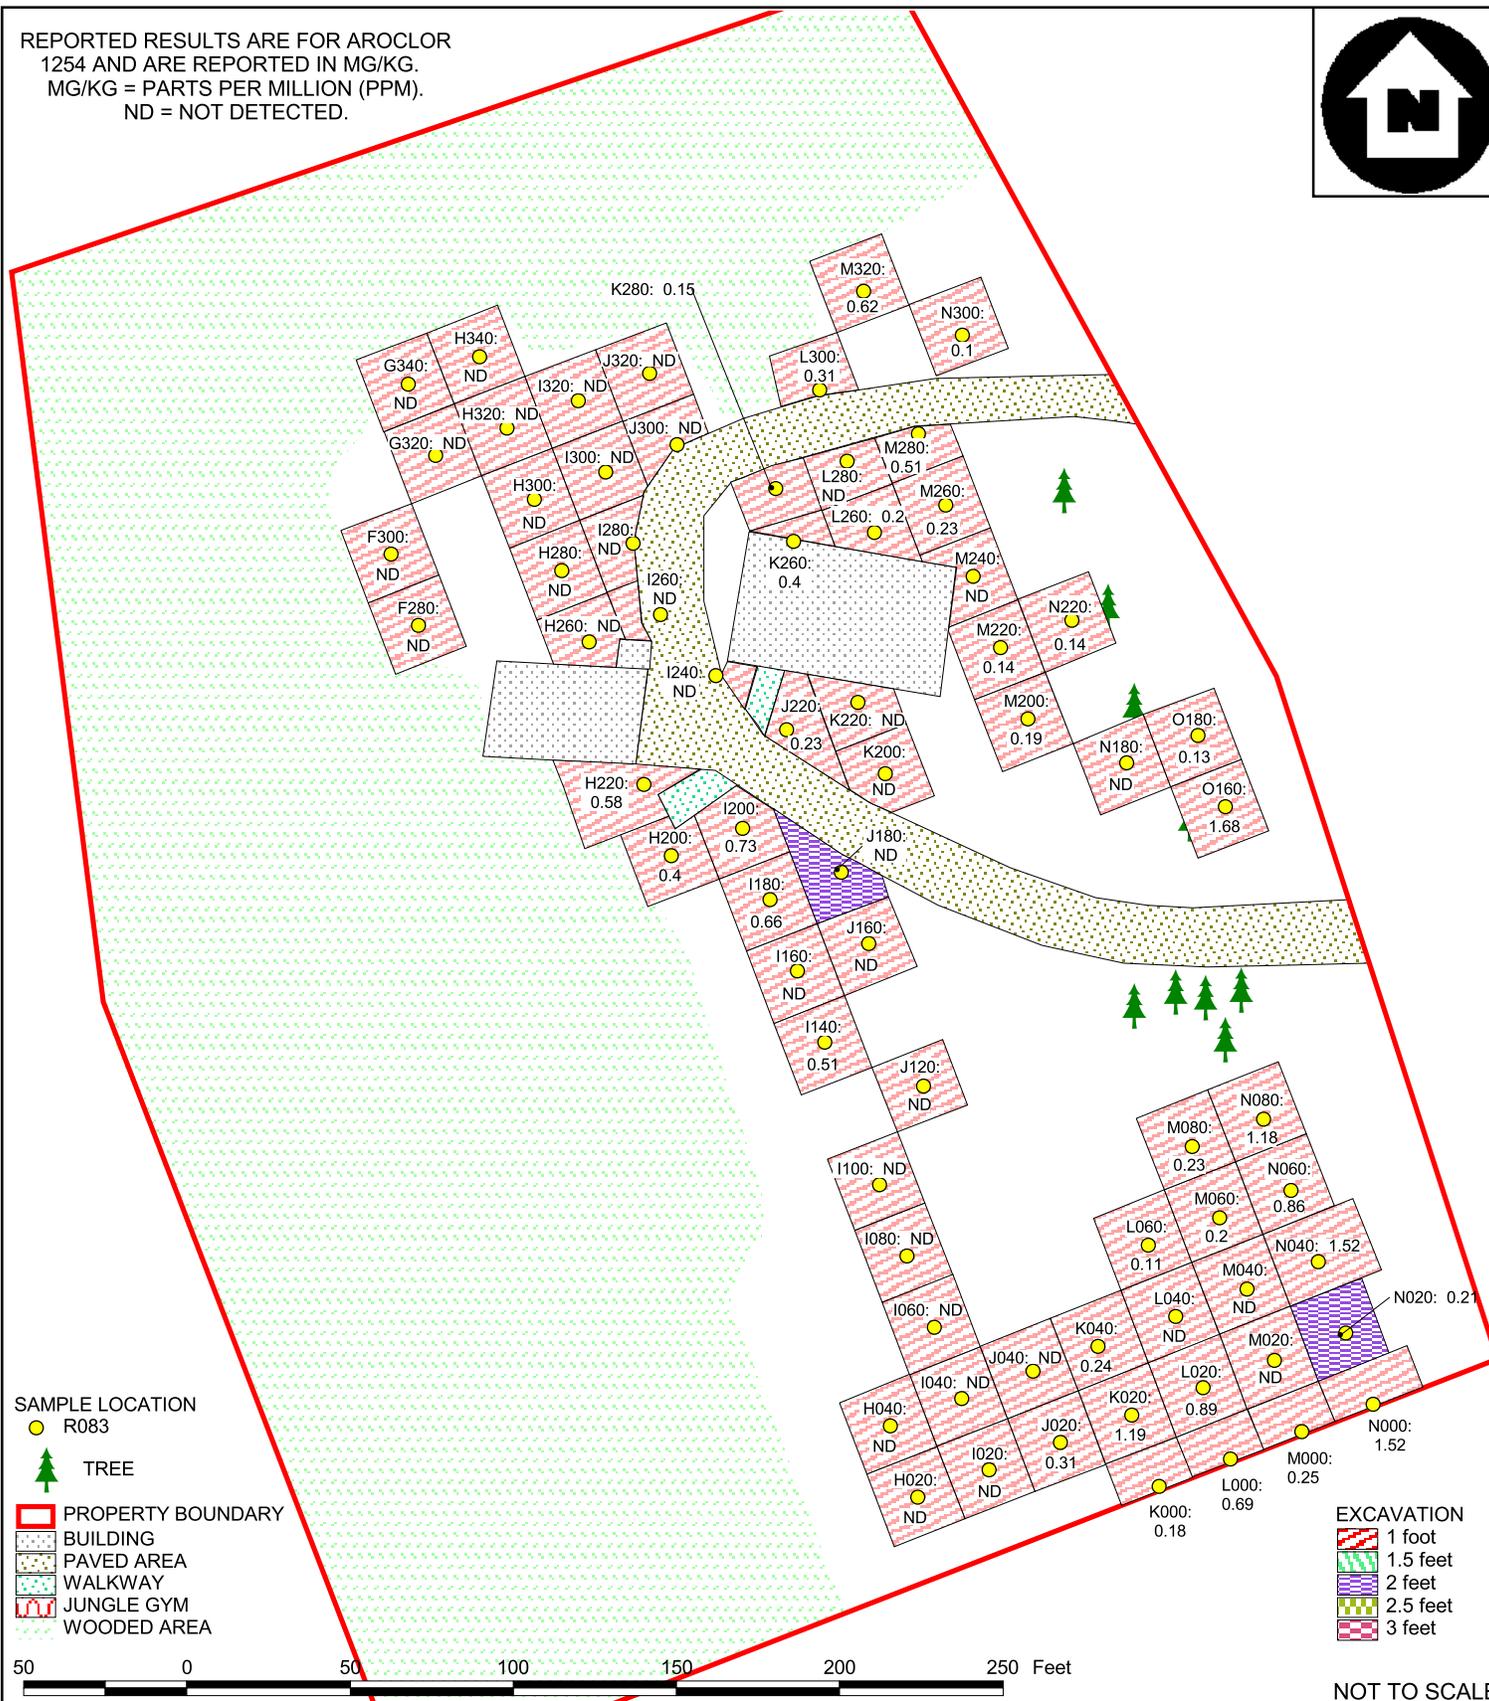

SAMPLE LOCATION

● R083



TREE

▭ PROPERTY BOUNDARY

▭ BUILDING

▭ PAVED AREA

▭ WALKWAY

▭ JUNGLE GYM

▭ WOODED AREA

EXCAVATION

▭ 1 foot

▭ 1.5 feet

▭ 2 feet

▭ 2.5 feet

▭ 3 feet

50 0 50 100 150 200 250 Feet

NOT TO SCALE

EXCAVATION DIAGRAM

BALDWINVILLE RESIDENTIAL PROPERTIES
 R083A
 BALDWINVILLE, MASSACHUSETTS




REGION I SUPERFUND TECHNICAL ASSESSMENT AND RESPONSE TEAM

TDD NUMBER: 05-07-0013	CREATED BY: D. MUZRALL	CREATED ON: 1/19/2006
---------------------------	---------------------------	--------------------------

FILE LOCATION:
 E:\ARC_APRs\START2\
 baldwinville_phase2_removal_final.apr

FIGURE 3

REPORTED RESULTS ARE FOR AROCLOR 1254 AND ARE REPORTED IN MG/KG. MG/KG = PARTS PER MILLION (PPM). ND = NOT DETECTED.

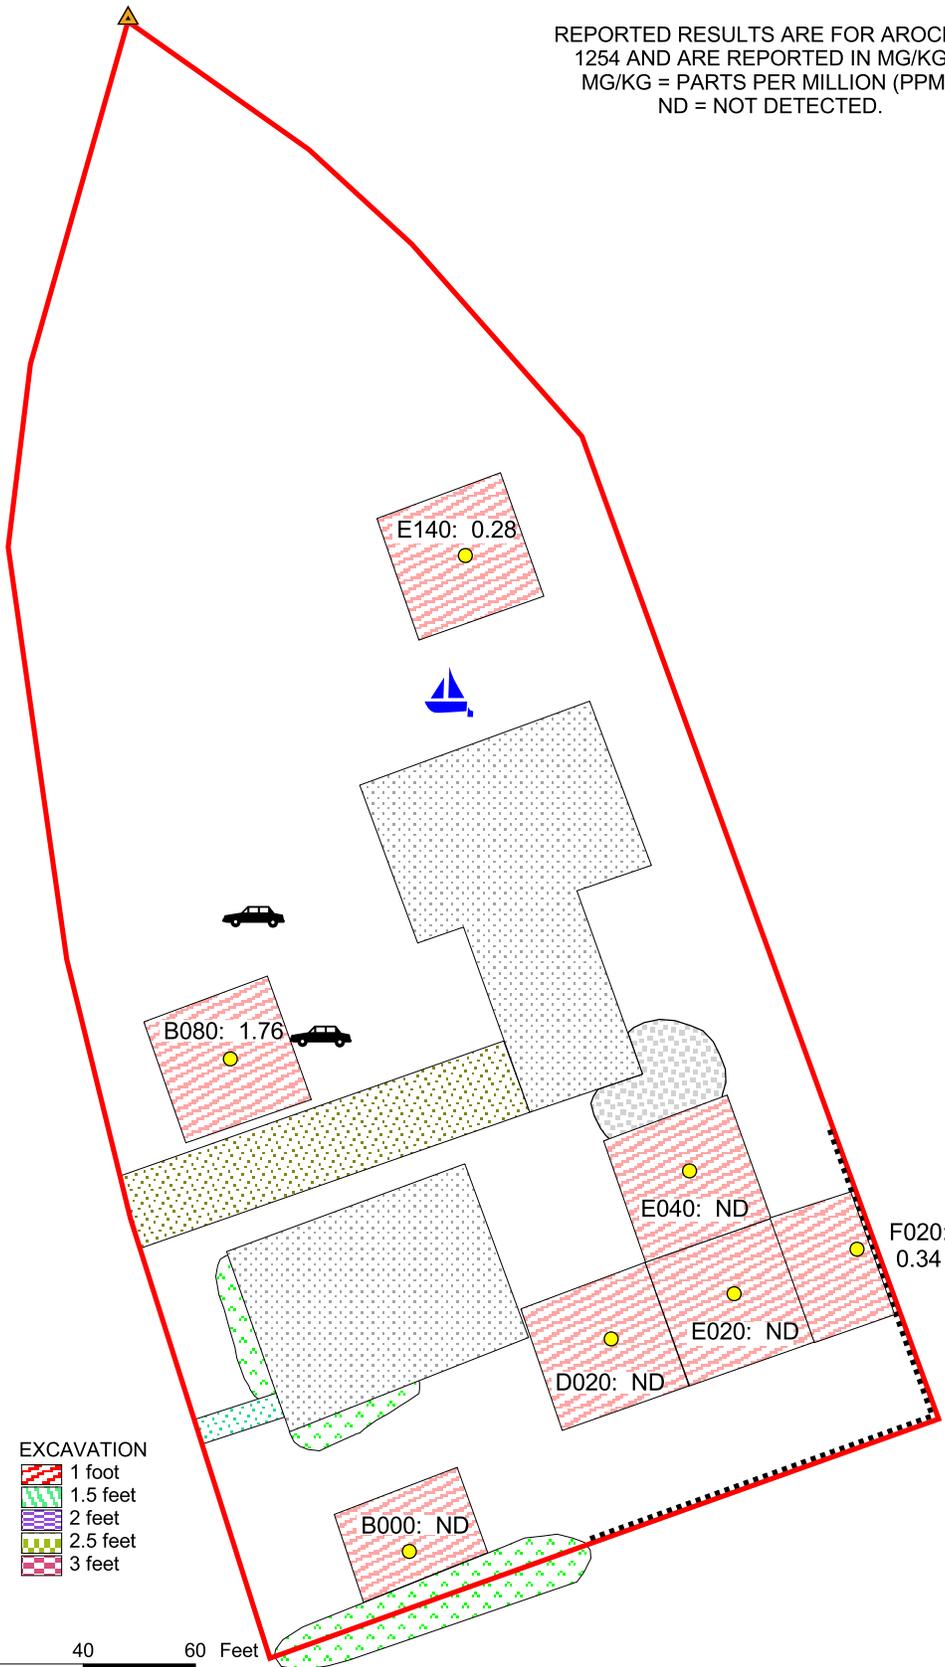

- SAMPLE LOCATION R084
- PROPERTY MARKER
- TREE
- CAR
- SAILBOAT
- FENCE
- PROPERTY BOUNDARY
- BUILDING
- PAVED AREA
- WALKWAY
- DEBRIS PILE
- BUSHES

- EXCAVATION**
- 1 foot
 - 1.5 feet
 - 2 feet
 - 2.5 feet
 - 3 feet

20 0 20 40 60 Feet

NOT TO SCALE

EXCAVATION DIAGRAM

BALDWINVILLE RESIDENTIAL PROPERTIES
R-084
BALDWINVILLE, MASSACHUSETTS




REGION I SUPERFUND TECHNICAL ASSESSMENT AND RESPONSE TEAM

TDD NUMBER: 05-07-0013	CREATED BY: D. MUZRALL	CREATED ON: 1/19/2006
---------------------------	---------------------------	--------------------------

FILE LOCATION:
E:\ARC_APRs\START2\
baldwinville_phase2_removal_final.apr

FIGURE 3

REPORTED RESULTS ARE FOR AROCLOR
 1254 AND ARE REPORTED IN MG/KG.
 MG/KG = PARTS PER MILLION (PPM).
 ND = NOT DETECTED.

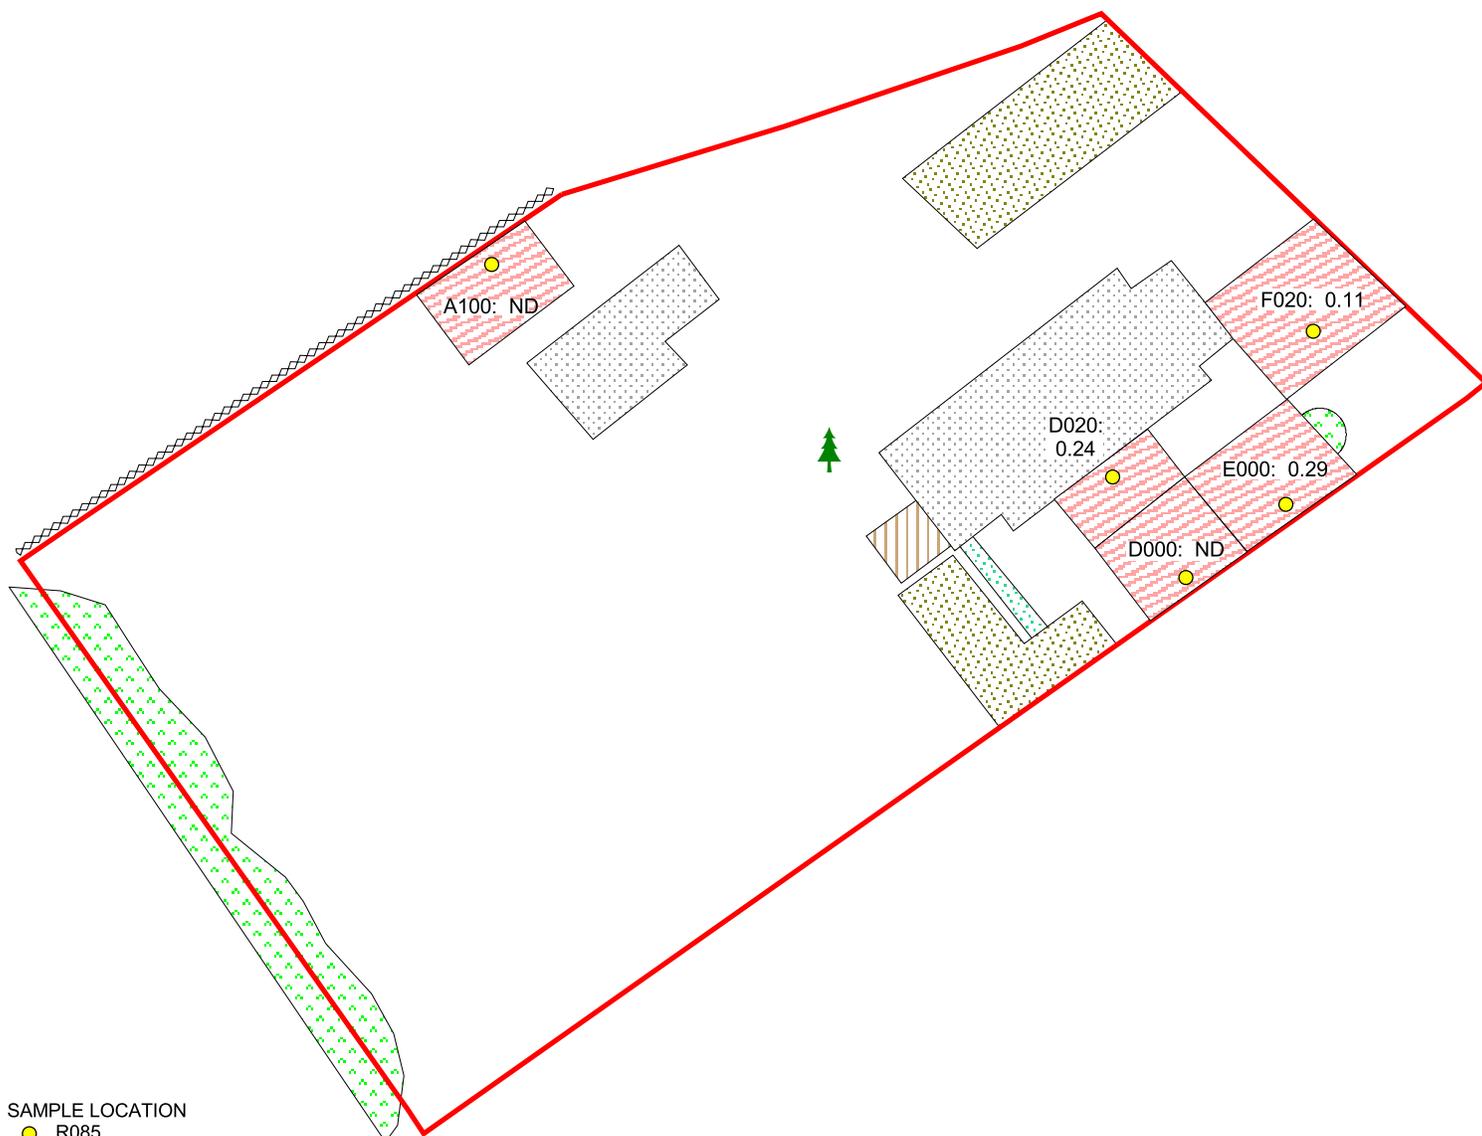

SAMPLE LOCATION
 ● R085



- RETAINING WALL
- PROPERTY BOUNDARY
- BUILDING
- DECK
- PAVED AREA
- WALKWAY
- BUSHES

- EXCAVATION
- 1 foot
 - 1.5 feet
 - 2 feet
 - 2.5 feet
 - 3 feet



NOT TO SCALE

EXCAVATION DIAGRAM

BALDWINVILLE RESIDENTIAL PROPERTIES
 R085
 BALDWINVILLE, MASSACHUSETTS



REGION I SUPERFUND TECHNICAL ASSESSMENT AND RESPONSE TEAM


TDD NUMBER: 05-07-0013	CREATED BY: D. MUZRALL	CREATED ON: 1/19/2006
---------------------------	---------------------------	--------------------------

FILE LOCATION:
 E:\ARC_APRs\START2\
 baldwinville_phase2_removal_final.apr

FIGURE 3

Section 3 - Phase III Removal Diagrams


Reported results are for AROCLOR 1254
 and are reported in mg/kg.
 mg/kg = parts per million (PPM).

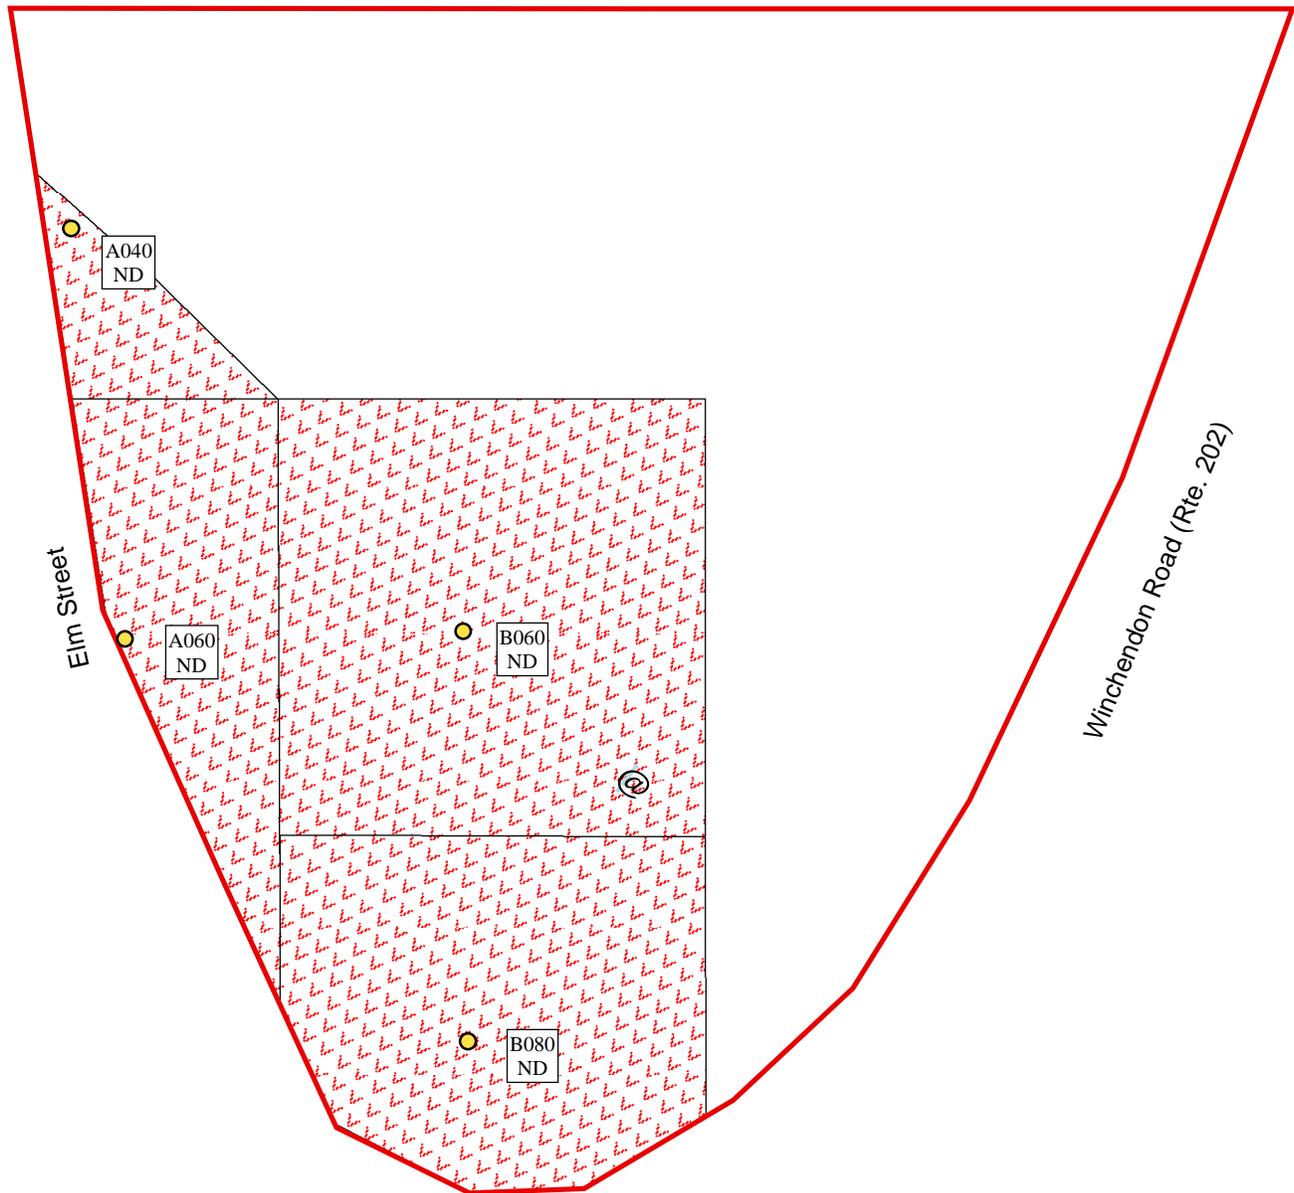

Not To Scale

Legend

- Sample Location
- Property Boundary
- @ Catch Basin
- ▾ ▾ ▾
 ▾ ▾ ▾
 Excavation Depth
- 1 Foot

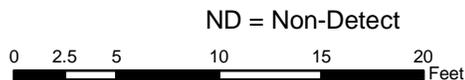

EXCAVATION DIAGRAM

BALDWINVILLE RESIDENTIAL PROPERTIES
 R-090
 BALDWINVILLE, MASSACHUSETTS




REGION I SUPERFUND TECHNICAL ASSESSMENT AND RESPONSE TEAM

TDD NUMBER: 05-07-0013	CREATED BY: B. MAHANY	CREATED ON: 11/6/2006
FILE LOCATION: E:\MA_GIS\BRP_Phase3\MXDs\R090_Removal.MXD		FIGURE 3

Reported results are for AROCLOR 1254
and are reported in mg/kg.
mg/kg = parts per million (PPM).

Walnut Street

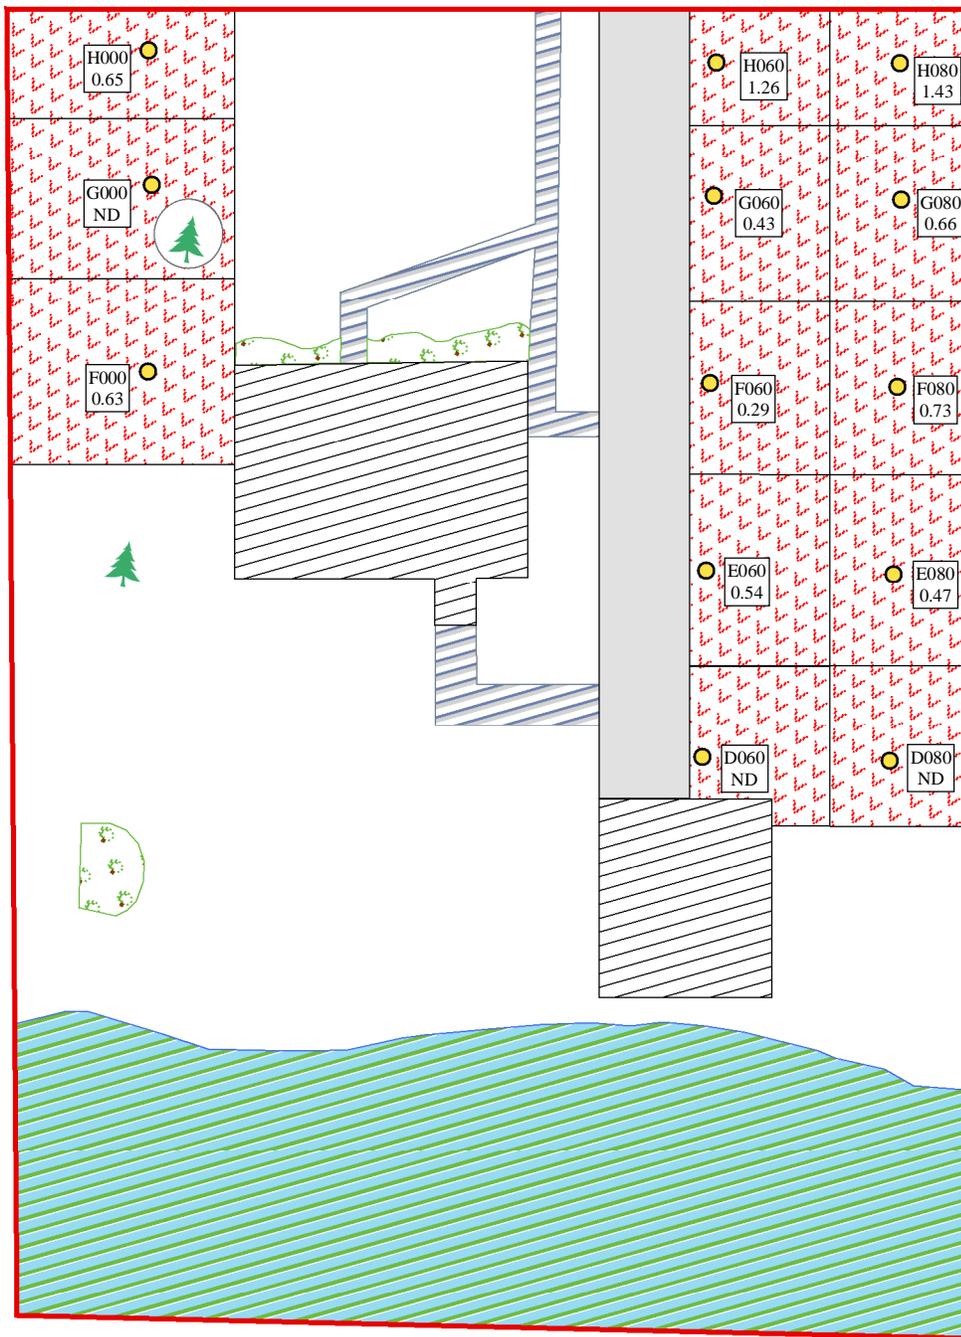

Not To Scale

Legend

- Trees
- Property Boundary
- Paved Driveway
- Wetlands
- Garden
- Paved Walkway
- Excavation Depth
- Building
- 1 Foot

ND = Non-Detect



EXCAVATION DIAGRAM

BALDWINVILLE RESIDENTIAL PROPERTIES
R-091
BALDWINVILLE, MASSACHUSETTS




REGION I SUPERFUND TECHNICAL ASSESSMENT AND RESPONSE TEAM

TDD NUMBER: 05-07-0013	CREATED BY: B. MAHANY	CREATED ON: 11/6/2006
---------------------------	--------------------------	--------------------------

FILE LOCATION: E:\WA_GIS\BRP_Phase3\MXD\R091_Removal.MXD	FIGURE 3
---	----------

Reported results are for AROCLOR 1254
and are reported in mg/kg.
mg/kg = parts per million (PPM).

Walnut Street

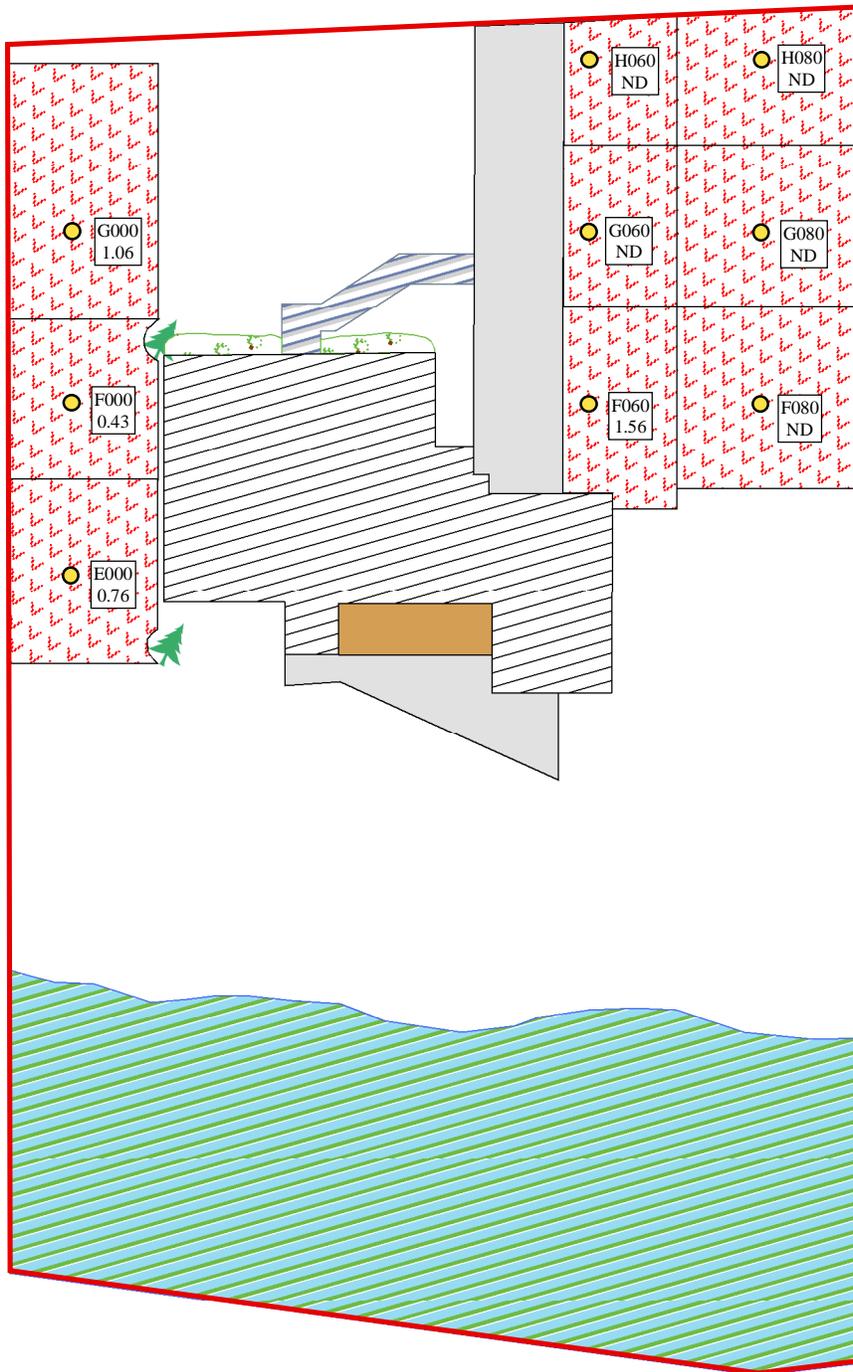

Not to Scale



ND = Non-Detect

Legend

- Sample Location
- Wood Deck
- ▨ Paved Walkway
- ▭ Excavation Depth
- ▭ Property Boundary
- ▭ Paved Driveway
- ▨ Wetlands
- ▭ 1 Foot
- ▨ Building
- Garden
- Trees

EXCAVATION DIAGRAM

BALDWINVILLE RESIDENTIAL PROPERTIES
R-092
BALDWINVILLE, MASSACHUSETTS




REGION I SUPERFUND TECHNICAL ASSESSMENT AND RESPONSE TEAM

TDD NUMBER: 05-07-0013	CREATED BY: B. MAHANY	CREATED ON: 11/6/2006
FILE LOCATION: E:\MA_GIS\BRP_Phase3\MXDs\R092_Removal.MXD		FIGURE 3

Reported results are for AROCLOR 1254
and are reported in mg/kg.
mg/kg = parts per million (PPM).



Walnut Street

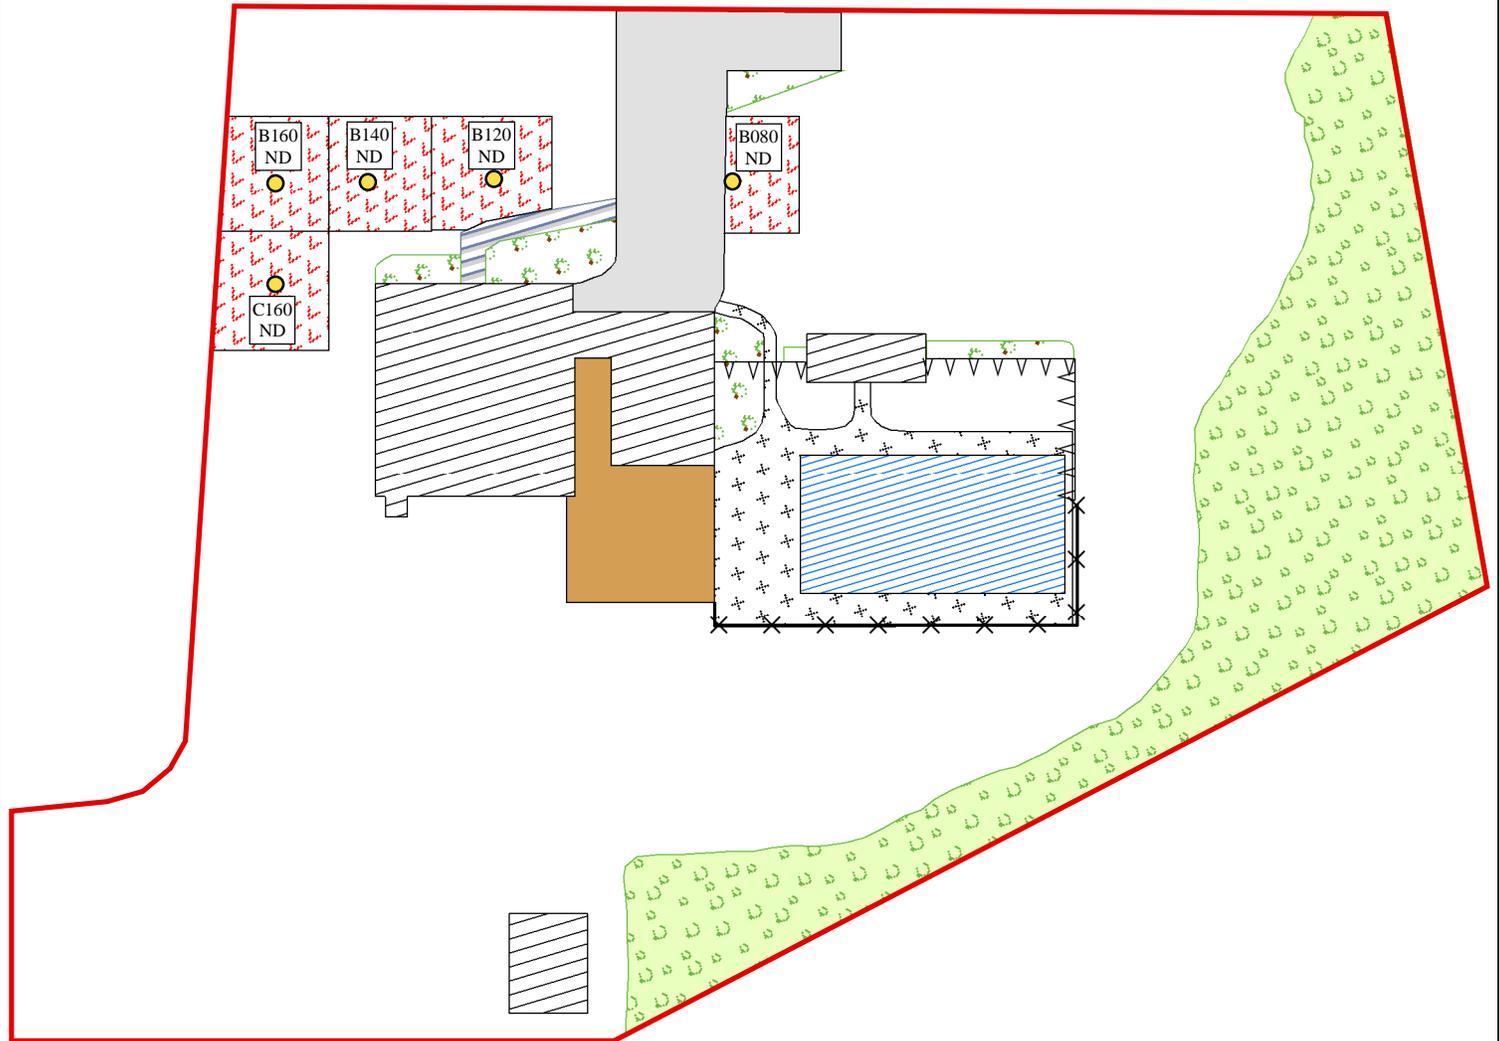


Not To Scale

Legend

- Sample Location
- Property Boundary
- Paved Driveway
- Building
- Garden
- Pool
- Wood Deck
- Wooded Area
- Paved Walkway
- Concrete Patio
- Chain-link Fence
- Stockade Fence
- Excavation Depth 1 Foot

ND = Non-Detect

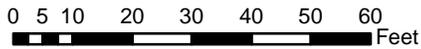

EXCAVATION DIAGRAM


BALDWINVILLE RESIDENTIAL PROPERTIES
R-093
BALDWINVILLE, MASSACHUSETTS



REGION I SUPERFUND TECHNICAL ASSESSMENT AND RESPONSE TEAM

TDD NUMBER: 05-07-0013	CREATED BY: B. MAHANY	CREATED ON: 10/12/2006
FILE LOCATION: E:\MA_GIS\BRP_Phase3\MXD\R093_Removal.MXD		FIGURE 3

Reported results are for AROCLOR 1254
 and are reported in mg/kg.
 mg/kg = parts per million (PPM).

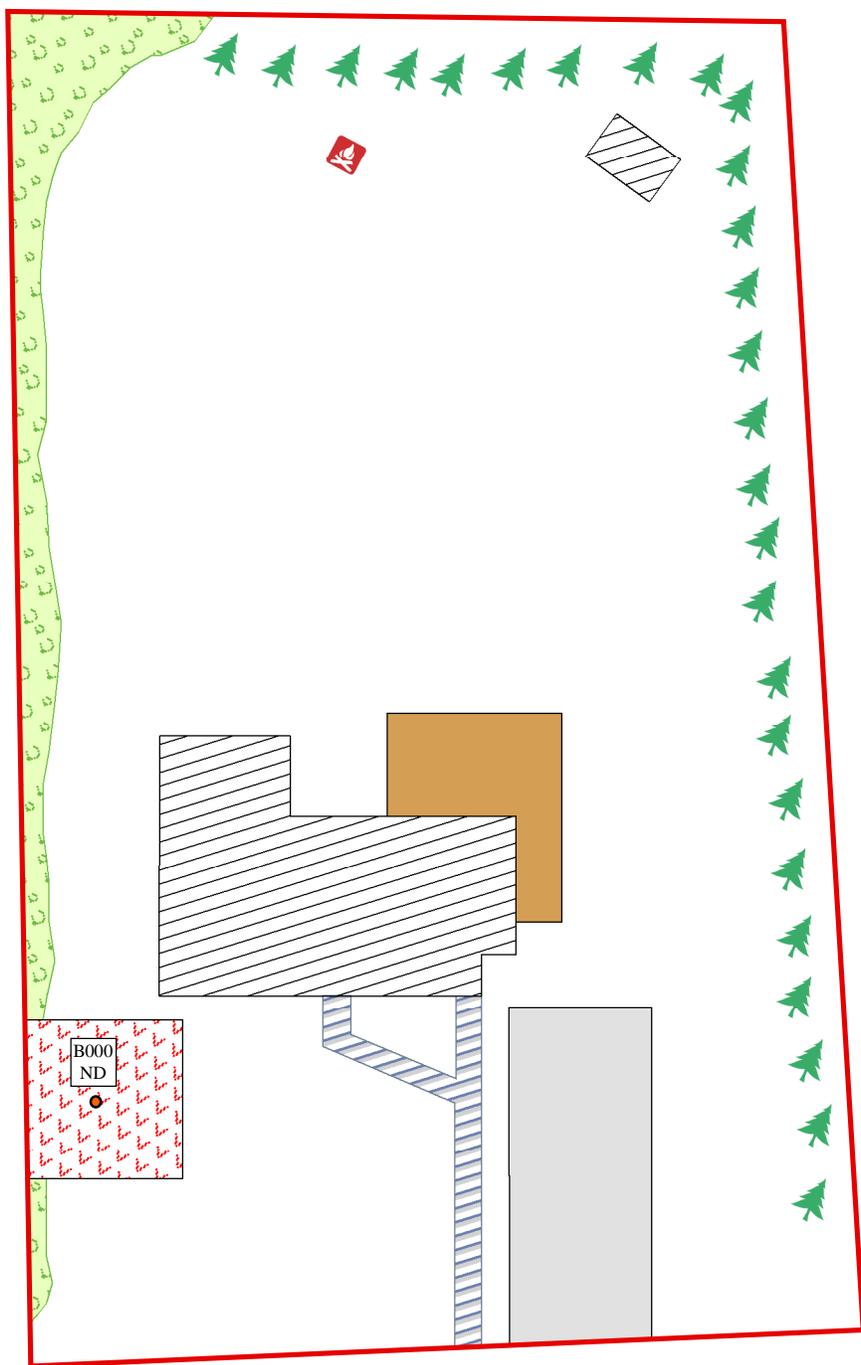


Beech Street

Not To Scale

ND = Non-Detect

Legend

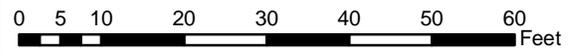

- Sample Location
- Property Boundary
- Wooded Area
- Paved Driveway
- Paved Walkway
- Building
- Wood Deck
- Tree
- Firepit
- Excavation Depth 1 Foot

EXCAVATION DIAGRAM

BALDWINVILLE RESIDENTIAL PROPERTIES
 R-102
 BALDWINVILLE, MASSACHUSETTS




REGION I SUPERFUND TECHNICAL ASSESSMENT AND RESPONSE TEAM

TDD NUMBER: 05-07-0013	CREATED BY: B. MAHANY	CREATED ON: 10/16/2006
---------------------------	--------------------------	---------------------------

FILE LOCATION: E:\MA_GIS\BRP_Phase3\MXDs\R102_Removal.MXD	FIGURE 3
--	----------

Reported results are for AROCLOR 1254
and are reported in mg/kg.
mg/kg = parts per million (PPM).

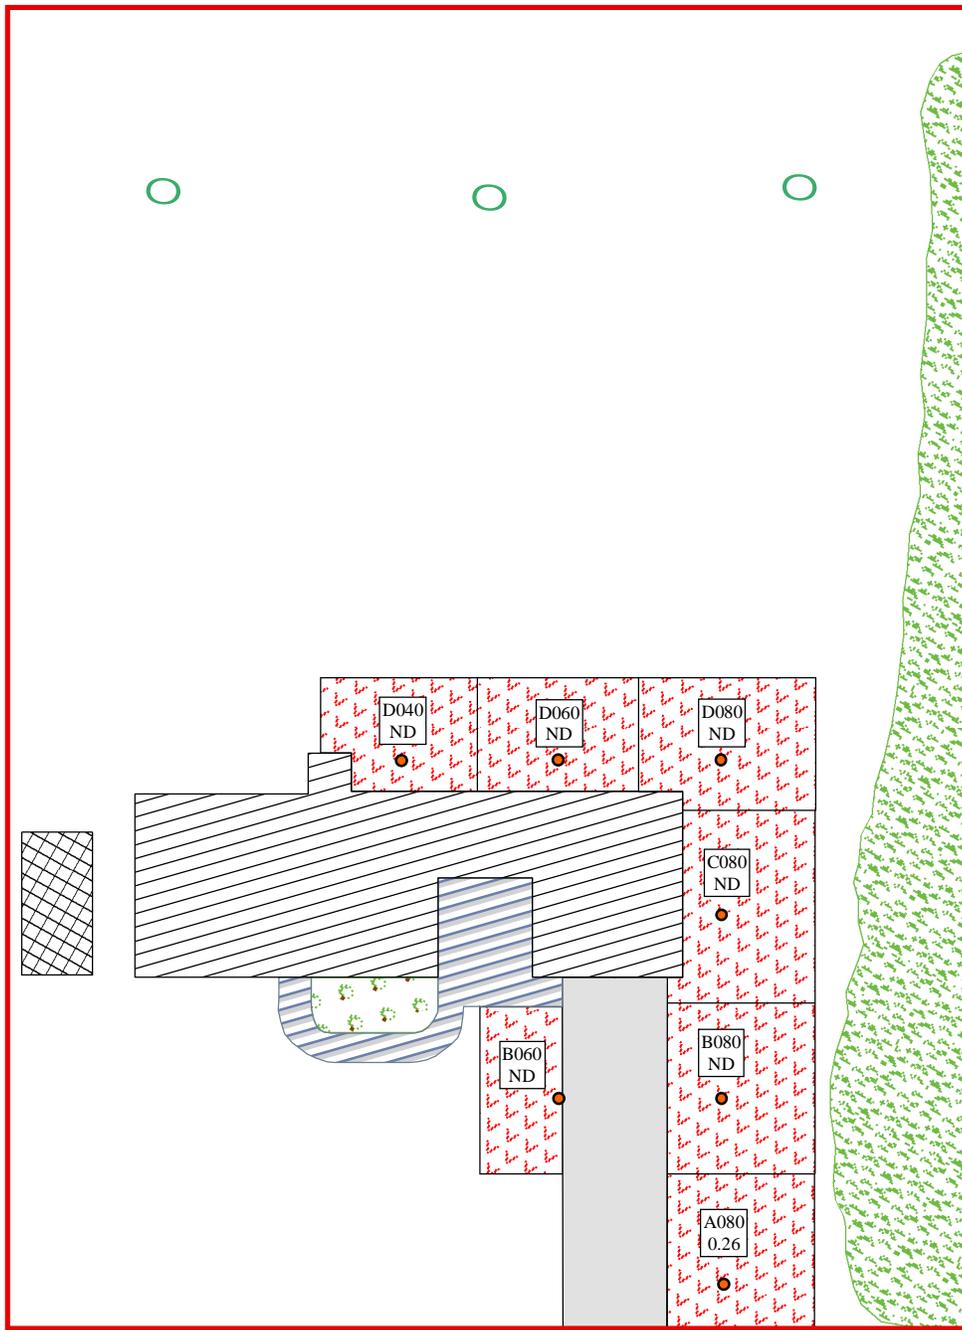

Beech Street

Not To Scale

Legend

ND = Non-Detect

0 5 10 20 30 40 50 60 Feet

- Sample Location
- Property Boundary
- Paved Driveway
- Bushes
- Trees
- ▨ Building
- Garden
- Excavation Depth
- ▨ Paved Walkway
- Trailer
- 1 Foot

EXCAVATION DIAGRAM

BALDWINVILLE RESIDENTIAL PROPERTIES
R-103
BALDWINVILLE, MASSACHUSETTS




REGION I SUPERFUND TECHNICAL ASSESSMENT AND RESPONSE TEAM

TDD NUMBER: 05-07-0013	CREATED BY: B. MAHANY	CREATED ON: 10/16/2006
---------------------------	--------------------------	---------------------------

FILE LOCATION: E:\MA_GIS\BRP_Phase3\MXD\SR103_Removal.MXD	FIGURE 3
--	----------

Reported results are for AROCLOR 1254 and are reported in mg/kg. mg/kg = parts per million (PPM).

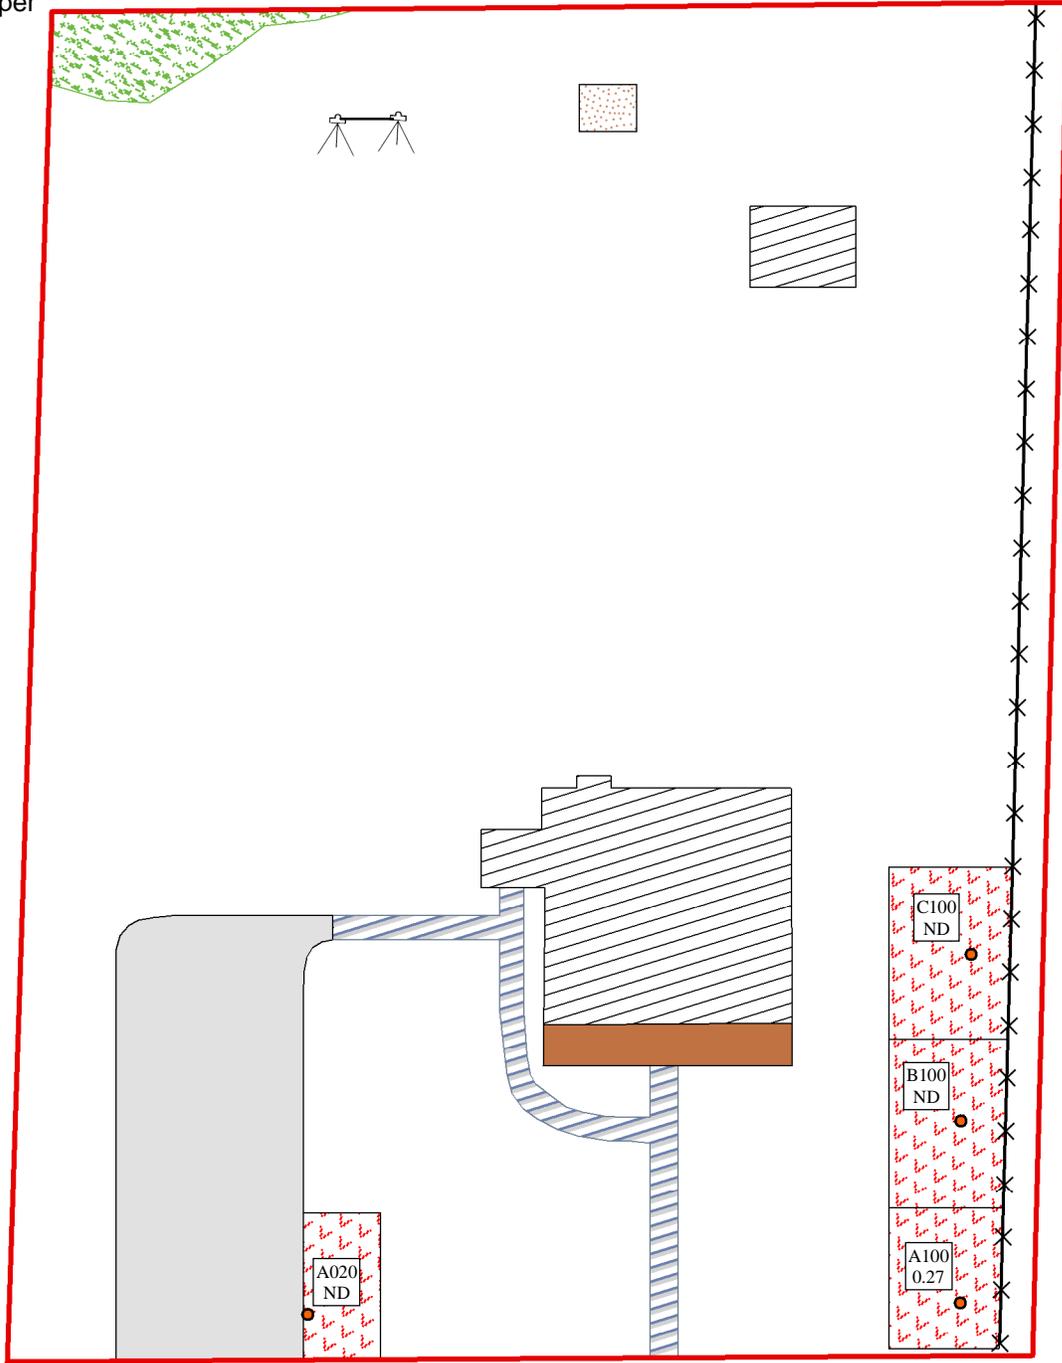

Pine Street

Not To Scale

Legend

- Sample Location
- ▨ Building
- ▤ Sand Box
- ▩ Paved Walkway
- ▭ Property Boundary
- ▨ Bushes
- ⊞ Chain-link Fence
- Excavation Depth
- Porch
- @ Swing Set
- ▭ Paved Driveway
- ▨ 1 Foot

ND = Non-Detect

0 5 10 20 30 40 50 60 Feet

EXCAVATION DIAGRAM


BALDWINVILLE RESIDENTIAL PROPERTIES
R-108
BALDWINVILLE, MASSACHUSETTS



REGION I SUPERFUND TECHNICAL ASSESSMENT AND RESPONSE TEAM

TDD NUMBER: 05-07-0013	CREATED BY: B. MAHANY	CREATED ON: 10/16/2006
FILE LOCATION: E:\WA_GIS\BRP_Phase3\MXDs\R108_Removal.MXD		FIGURE 3

Reported results are for AROCLOR 1254
and are reported in mg/kg.
mg/kg = parts per million (PPM).

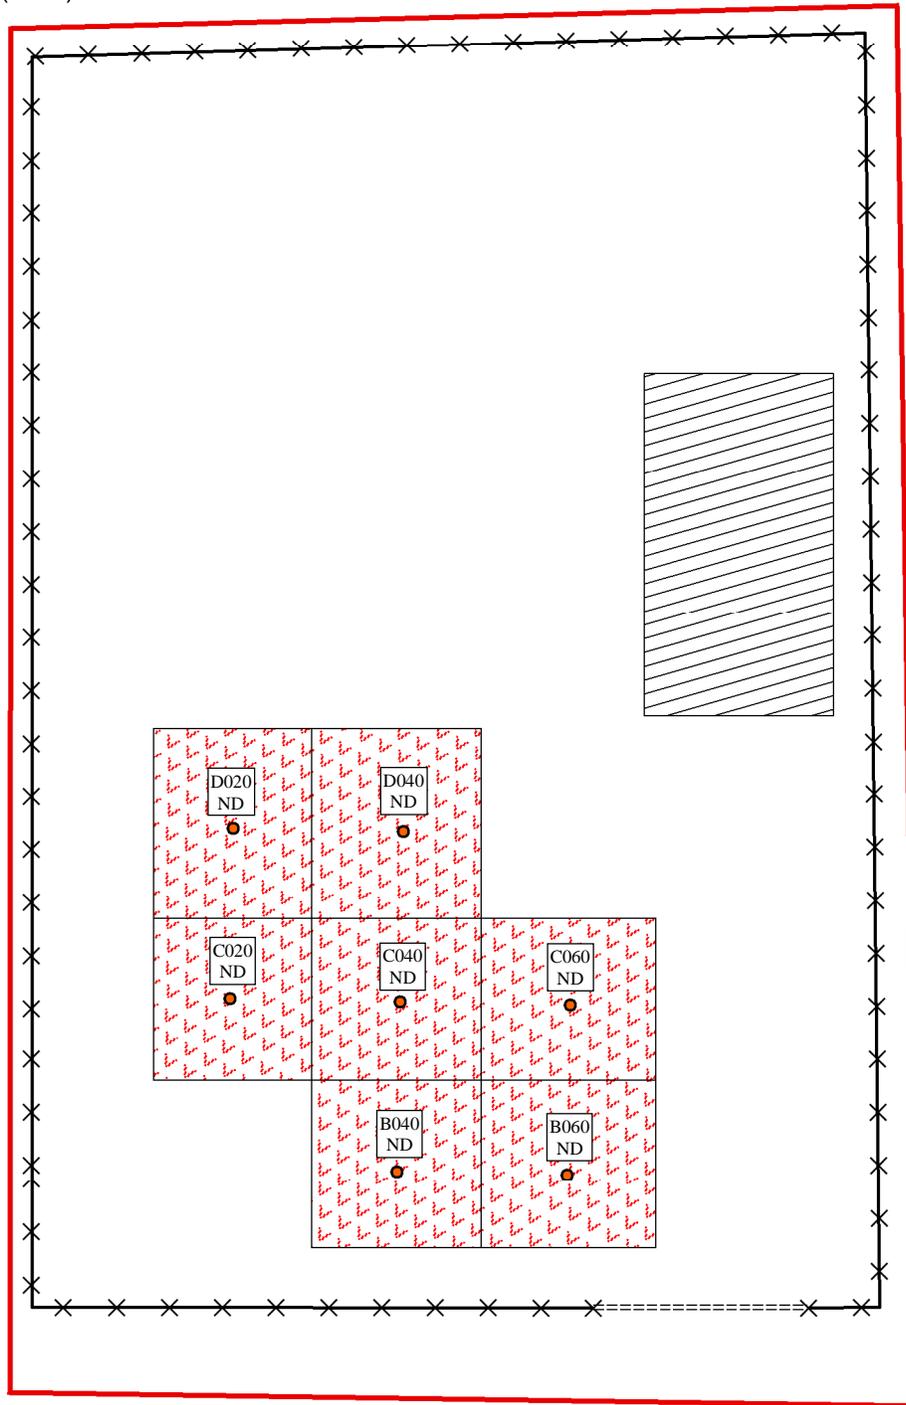

Pine Street

Not To Scale

Legend



ND = Non-Detect

- Sample Location
- ▭ Property Boundary
- ==== Fence Gate
- ▨ Temporary Garage
- ⊠ Chain-link Fence
- ▭ Excavation Depth 1 Foot

EXCAVATION DIAGRAM

BALDWINVILLE RESIDENTIAL PROPERTIES
R-109
BALDWINVILLE, MASSACHUSETTS




REGION I SUPERFUND TECHNICAL ASSESSMENT AND RESPONSE TEAM

TDD NUMBER: 05-07-0013	CREATED BY: B. MAHANY	CREATED ON: 10/16/2006
---------------------------	--------------------------	---------------------------

FILE LOCATION: E:\MA_GIS\BRP_Phase3_MXDs\R109_Removal.MXD	FIGURE 3
--	----------


Reported results are for AROCLOR 1254
and are reported in mg/kg.
mg/kg = parts per million (PPM).

Chestnut Street

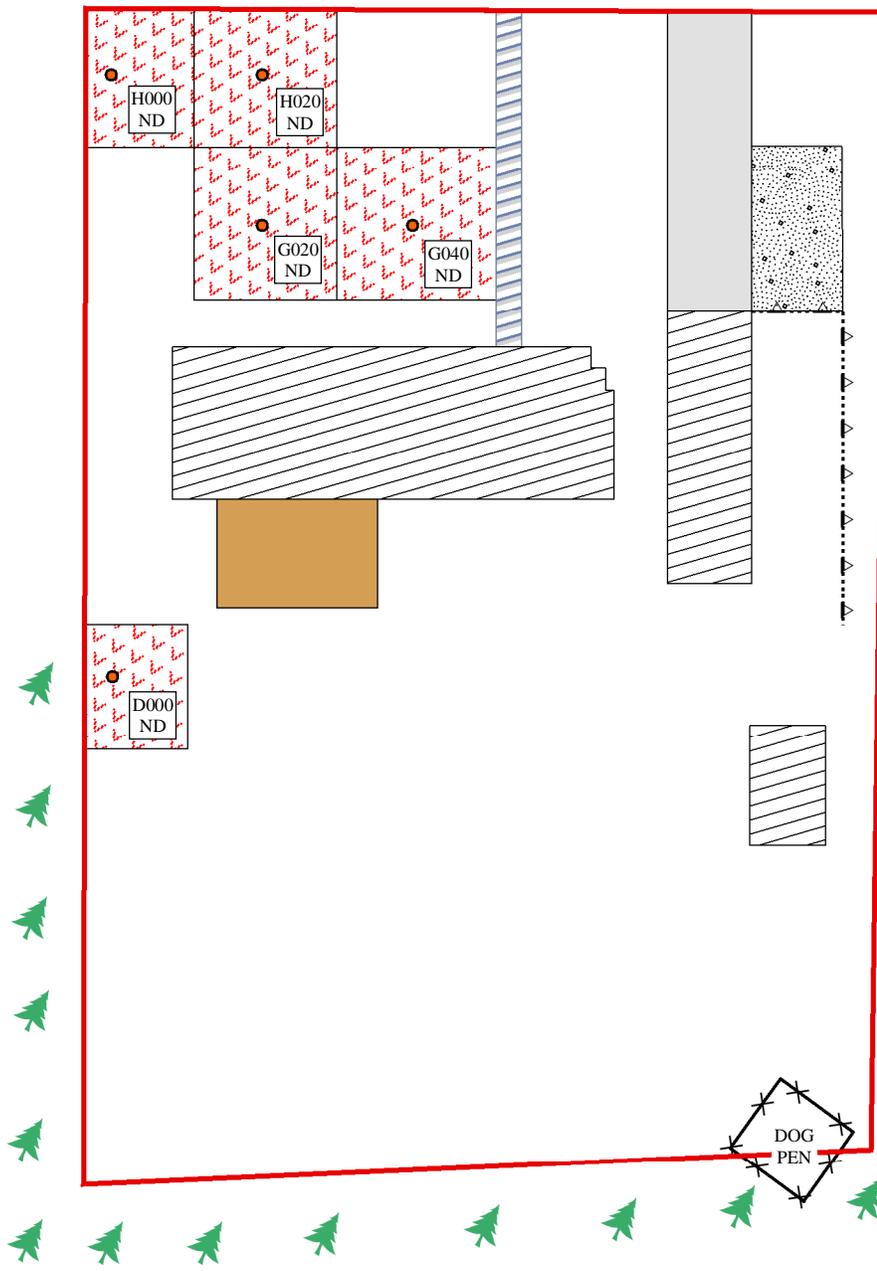

Not To Scale

Legend

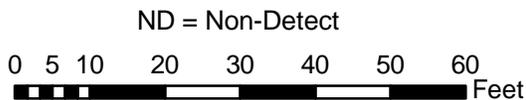

- Sample Location
- Property Boundary
- ▨ Paved Walkway
- Wood Deck
- ⊠ Chain-link Fence
- ⋯ / Picket Fence
- ▨ Gravel Driveway
- Paved Driveway
- ▨ Building
- Trees
- Excavation Depth**
- ▨ 1 Foot

EXCAVATION DIAGRAM

BALDWINVILLE RESIDENTIAL PROPERTIES
R-111
BALDWINVILLE, MASSACHUSETTS




REGION I SUPERFUND TECHNICAL ASSESSMENT AND RESPONSE TEAM

TDD NUMBER: 05-07-0013	CREATED BY: B. MAHANY	CREATED ON: 10/16/2006
---------------------------	--------------------------	---------------------------

FILE LOCATION: E:\MA_GIS\BRP_Phase3_MXD\BR111_Removal.MXD	FIGURE 3
--	----------


Reported results are for AROCLOR 1254
 and are reported in mg/kg.
 mg/kg = parts per million (PPM).

Mason Street

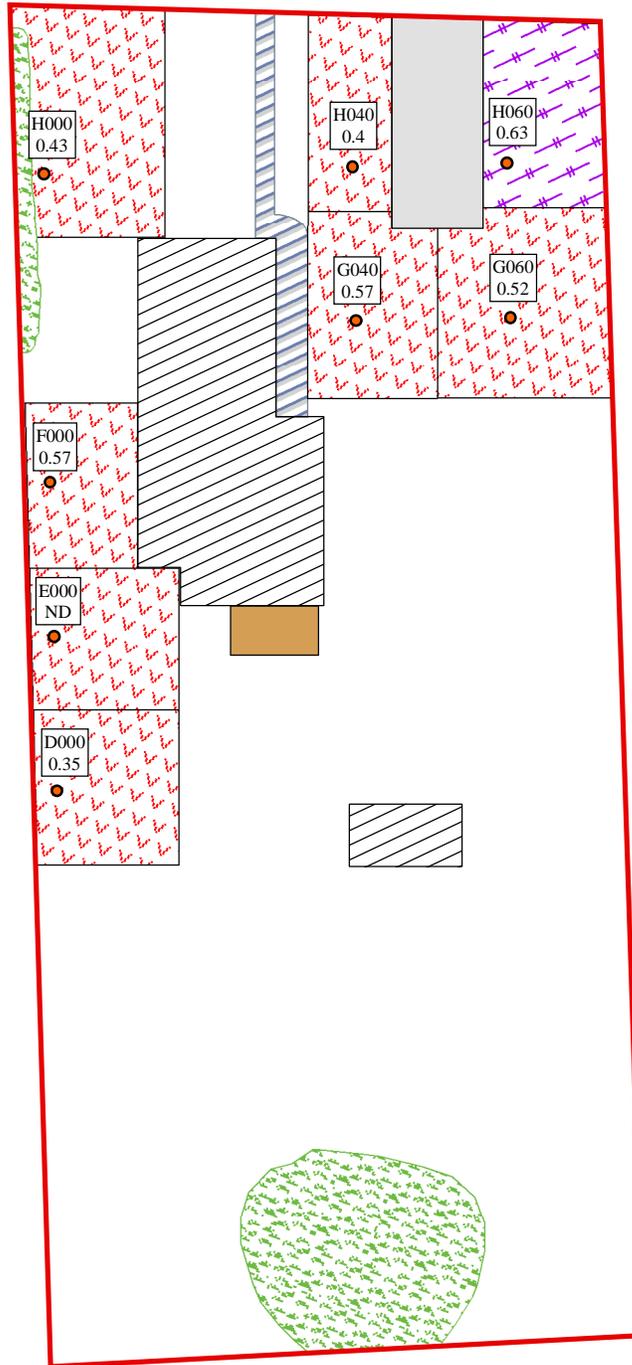

Not To Scale

Legend

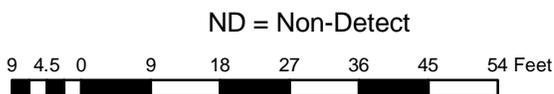

ND = Non-Detect

- Sample Location
- ▭ Property Boundary
- ▨ Building
- ▭ Paved Driveway
- ▭ Wood Deck
- ▨ Paved Walkway
- ▨ Bushes
- Excavation Depth**
- ▨ 1 Foot
- ▨ 1.5 Feet

EXCAVATION DIAGRAM

BALDWINVILLE RESIDENTIAL PROPERTIES
 R-119
 BALDWINVILLE, MASSACHUSETTS




REGION I SUPERFUND TECHNICAL ASSESSMENT AND RESPONSE TEAM

TDD NUMBER: 05-07-0013	CREATED BY: B. MAHANY	CREATED ON: 10/17/2006
---------------------------	--------------------------	---------------------------

FILE LOCATION: E:\MA_GIS\BRP_Phase3_MXD\R119_Removal.MXD	FIGURE 3
---	----------

Reported results are for AROCLOR 1254
and are reported in mg/kg.
mg/kg = parts per million (PPM).

Mason Street

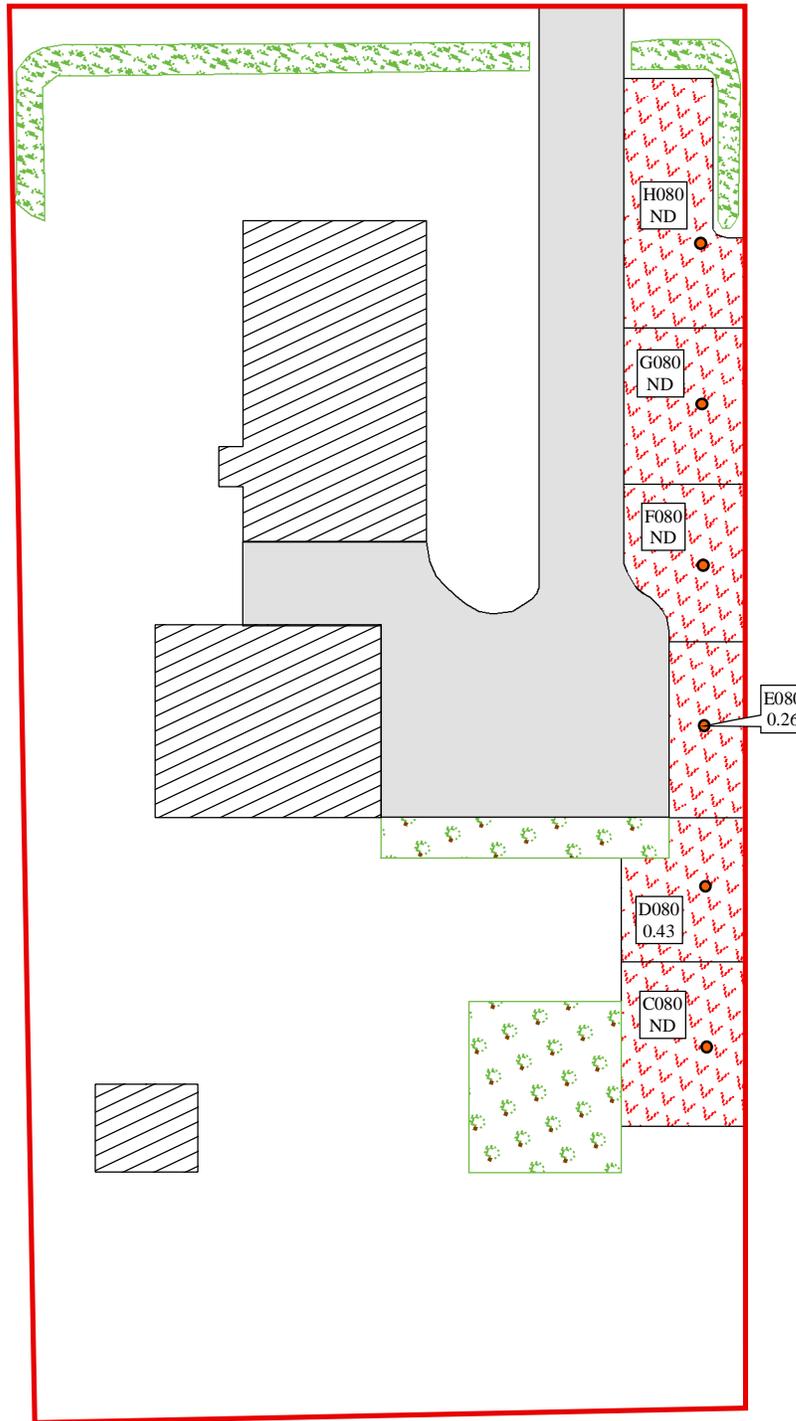

Not To Scale

Legend

ND = Non-Detect

0 5 10 20 30 40 50 60 Feet

- Sample Location
- ▨ Building
- 🌿 Bushes
- ▭ Property Boundary
- ▭ Paved Driveway
- Excavation Depth**
- 🌿 Garden
- ▭ 1 Foot

EXCAVATION DIAGRAM

BALDWINVILLE RESIDENTIAL PROPERTIES
R-120
BALDWINVILLE, MASSACHUSETTS




REGION I SUPERFUND TECHNICAL ASSESSMENT AND RESPONSE TEAM

TDD NUMBER: 05-07-0013	CREATED BY: B. MAHANY	CREATED ON: 10/17/2006
FILE LOCATION: E:\MA_GIS\BRP_Phase3\MXD\R120_Removal.MXD		FIGURE 3


Reported results are for AROCLOR 1254
and are reported in mg/kg.
mg/kg = parts per million (PPM).

Mason Street

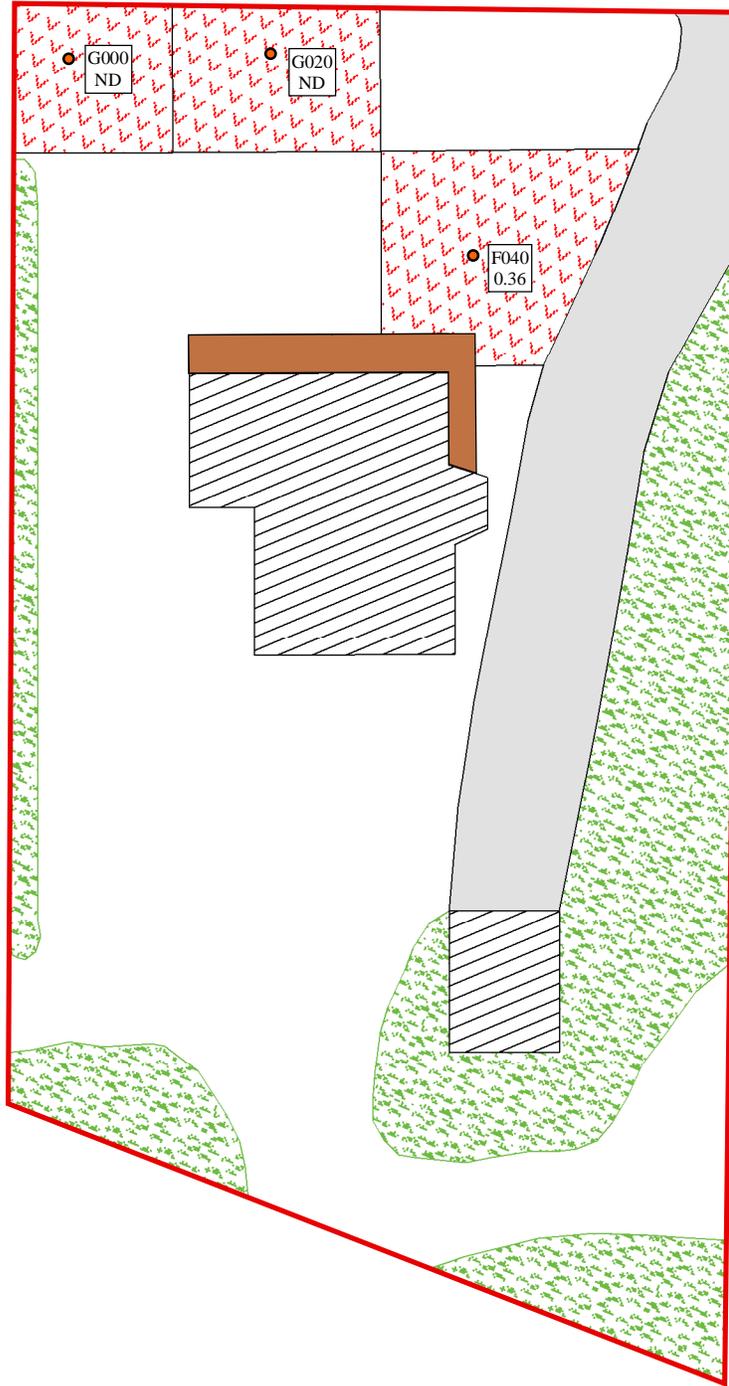

Not To Scale

Legend

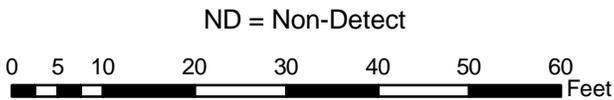

- Sample Location
- ▨ Building
- Porch
- ▭ Property Boundary
- Bushes
- Excavation Depth
- Paved Driveway
- 1 Foot

EXCAVATION DIAGRAM

BALDWINVILLE RESIDENTIAL PROPERTIES
R-121
BALDWINVILLE, MASSACHUSETTS




REGION I SUPERFUND TECHNICAL ASSESSMENT AND RESPONSE TEAM

TDD NUMBER: 05-07-0013	CREATED BY: B. MAHANY	CREATED ON: 10/17/2006
---------------------------	--------------------------	---------------------------

FILE LOCATION: E:\MA_GIS\BRP_Phase3_MXD\BR121_Removal.MXD	FIGURE 3
--	----------

Section 4 - Phase IV Removal Diagrams

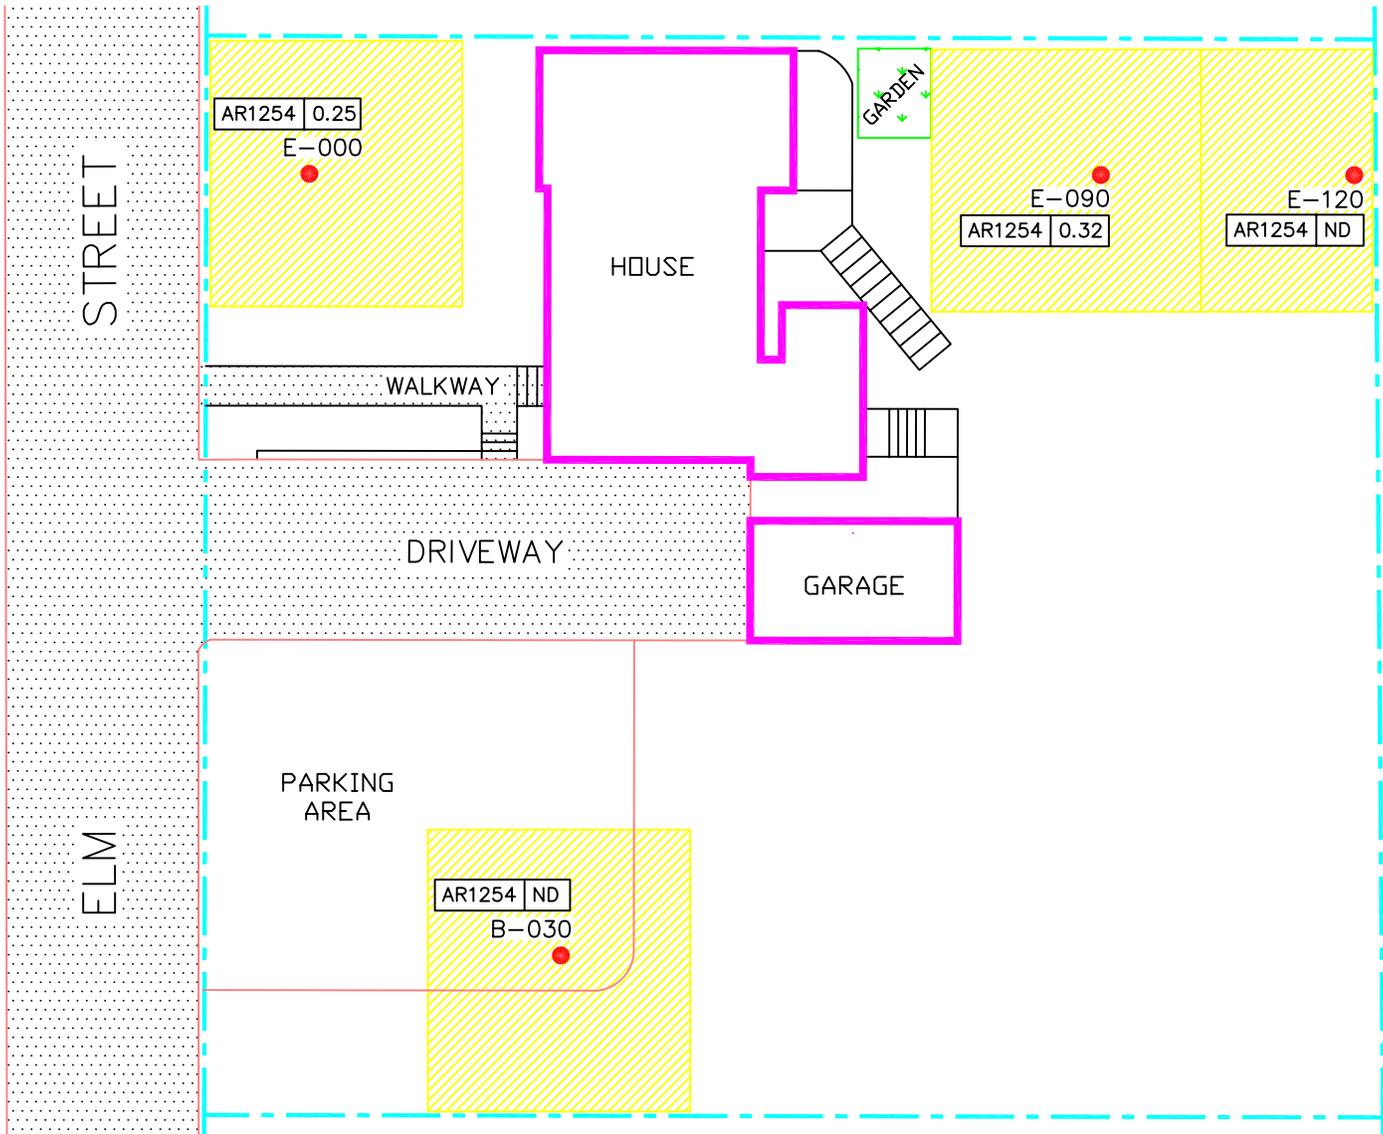

SOURCES:
TOWN OF TEMPLETON, MASSACHUSETTS
TAX ASSESSORS MAPS NOS. 6-4, AND 6.5
APRIL 1964, REVISED JANUARY 2001

LEGEND

NOT TO SCALE

PAVED AREA
 PROPERTY LINE

SOIL SAMPLING LOCATION

DENOTES SOIL SAMPLING POINT IDENTIFICATION
A-000 AROCLOR 1254 (PCB) RESULTS IN PARTS PER MILLION (PPM)
AR1254 | 0.0

NOTES:
ALL RESULTS ARE REPORTED IN MG/KG (PARTS PER MILLION)
ND = NOT DETECTED

EXCAVATION DEPTH
 1 FOOT

EXCAVATION DIAGRAM

BALDWINVILLE RESIDENTIAL PROPERTIES
R-008
BALDWINVILLE, MASSACHUSETTS



REGION I SUPERFUND TECHNICAL ASSESSMENT AND RESPONSE TEAM

TDD #
05-07-0013


DRAWN BY:
K. BRENNAN

DATE
5/15/07

FILE NAME:
R:\05070013\FIGURES\PROPERTY DIAGRAMS\EXCAVATION DIAGRAMS\FIGURE 3\PHASE 4\FIG_R008.DWG

FIGURE 3

Reported results are for AROCLOR 1254
and are reported in mg/kg.
mg/kg = parts per million (PPM).

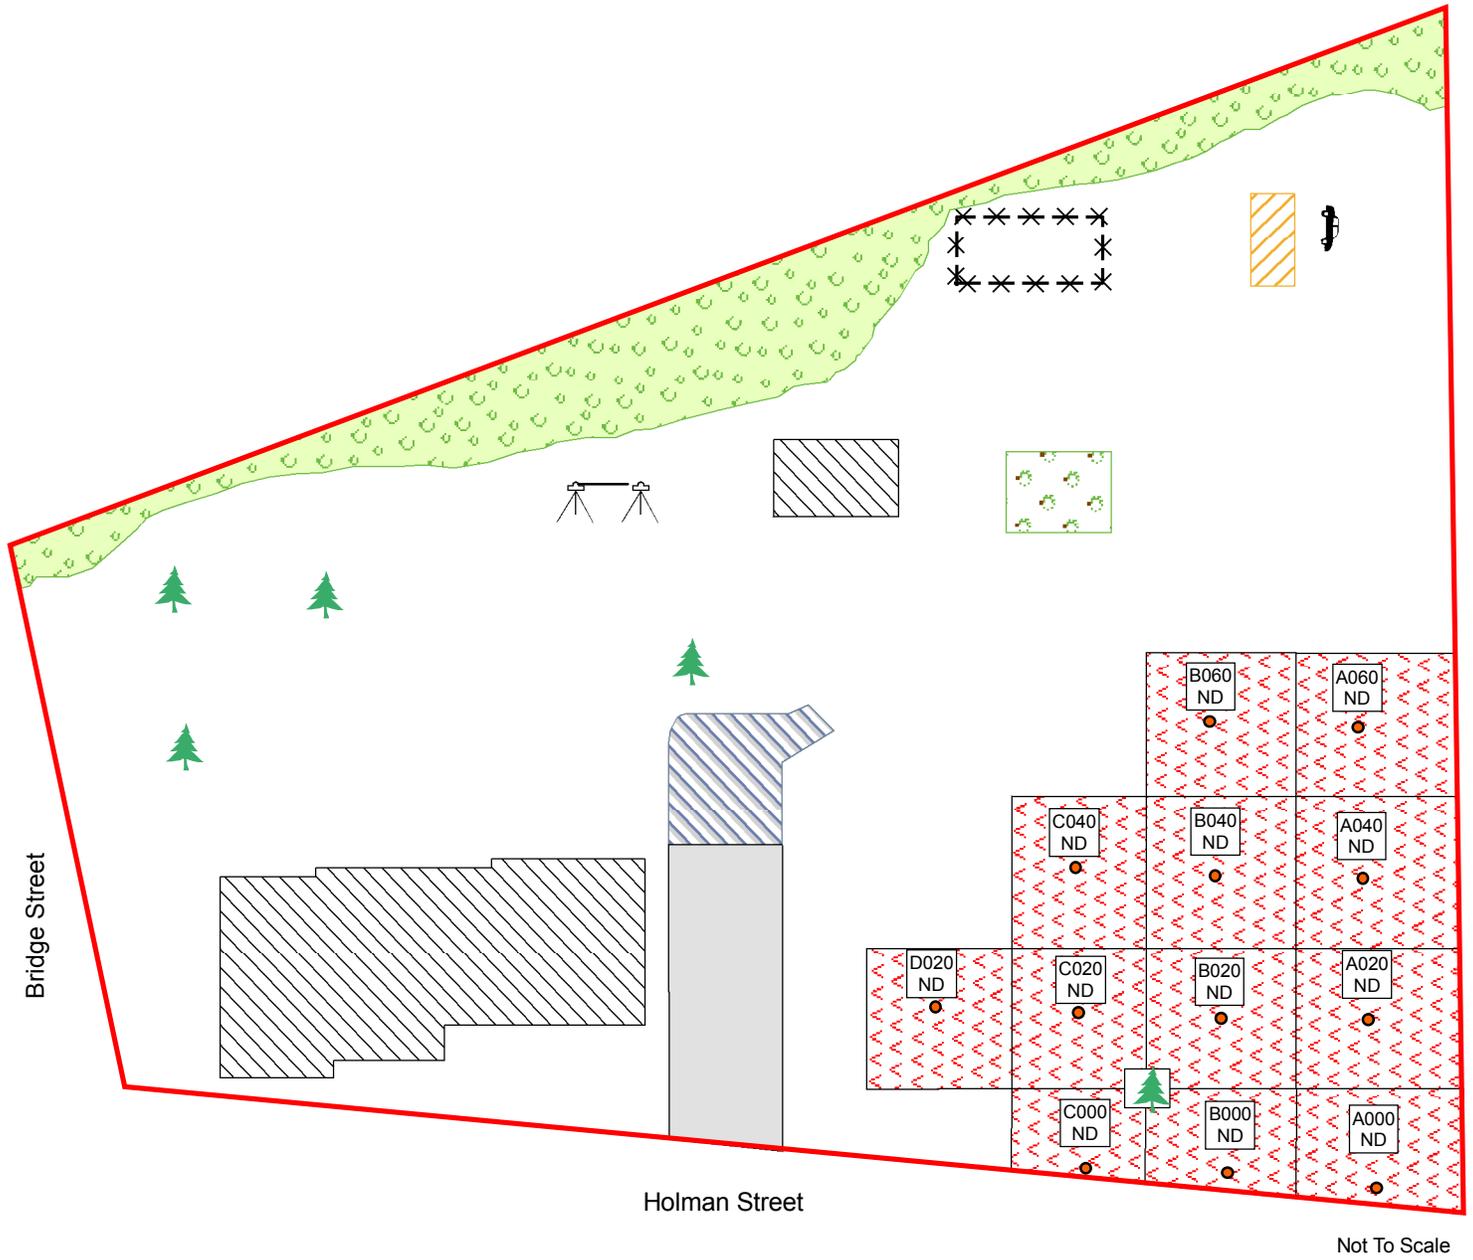


Not To Scale

Legend

- Sample Location
- Property Boundary
- Buildings
- Wooded Area
- Paved Driveway
- Concrete Patio
- Garden
- Trailer
- Swing Set
- Dog Pen
- Vehicle
- Trees
- Excavation
- 1 Foot

ND = Non-Detect

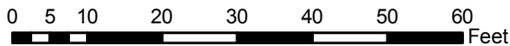

EXCAVATION DIAGRAM

BALDWINVILLE RESIDENTIAL PROPERTIES
R-061
BALDWINVILLE, MASSACHUSETTS





REGION I SUPERFUND TECHNICAL ASSESSMENT AND RESPONSE TEAM

TDD NUMBER: 05-07-0013	CREATED BY: B. MAHANY	CREATED ON: 1/4/2007
---------------------------	--------------------------	-------------------------

FILE LOCATION: E:\MA_GIS\BRP_Phase4\MXD\Rs\061_Removal.MXD	FIGURE 3
---	----------

Reported results are for AROCLOR 1254
and are reported in mg/kg.
mg/kg = parts per million (PPM).

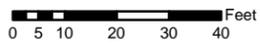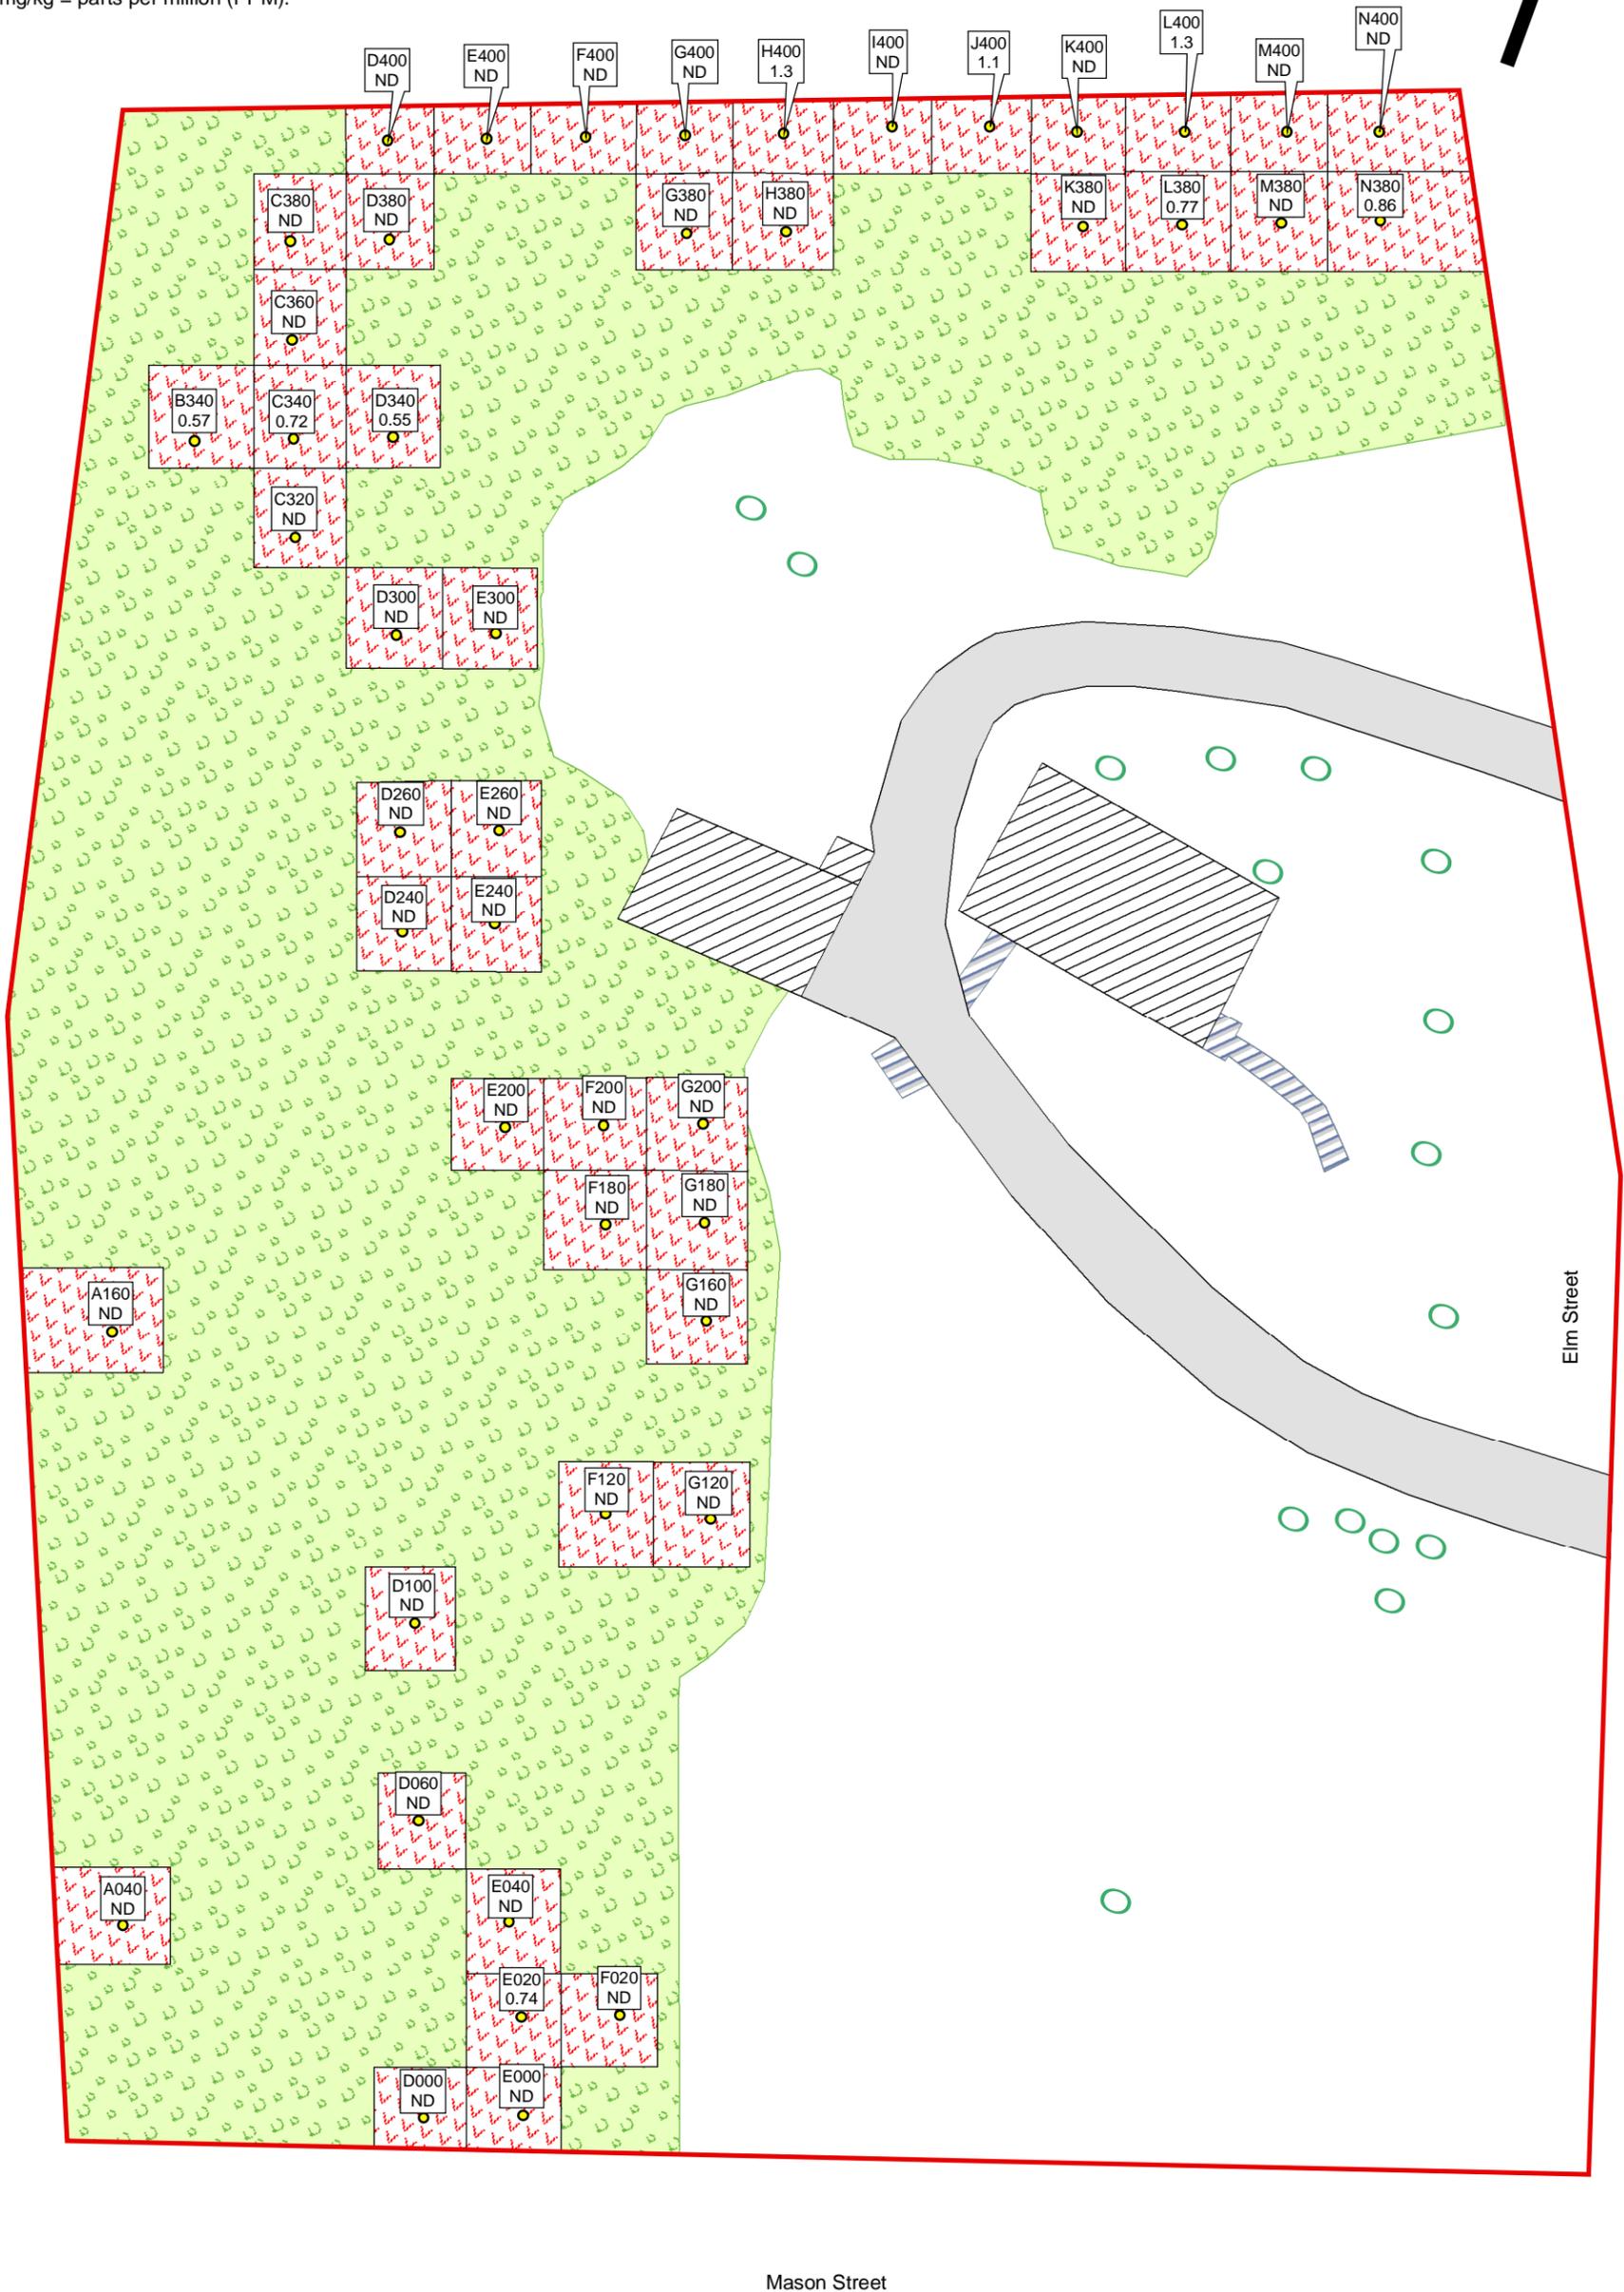

Mason Street

Elm Street

Not To Scale

EXCAVATION DIAGRAM

BALDWINVILLE RESIDENTIAL PROPERTIES
R083B
BALDWINVILLE, MASSACHUSETTS

Legend

- Sample Location
- Tree
- ▨ Building
- ▭ Property Boundary
- ▭ Paved Driveway
- ▨ Paved Walkway
- ▨ Wooded Area
- ▨ 1 Foot Excavation
- ND = Non-Detect




REGION I SUPERFUND TECHNICAL ASSESSMENT AND RESPONSE TEAM

TDD NUMBER: 05-07-0013 CREATED BY: B. MAHANY CREATED ON: 12/19/2006

FILE LOCATION: E:\WA_GIS\BRP_Phase4\MXD\R083_Removal.MXD FIGURE 3

Reported results are for AROCLOR 1254
and are reported in mg/kg.
mg/kg = parts per million (PPM).

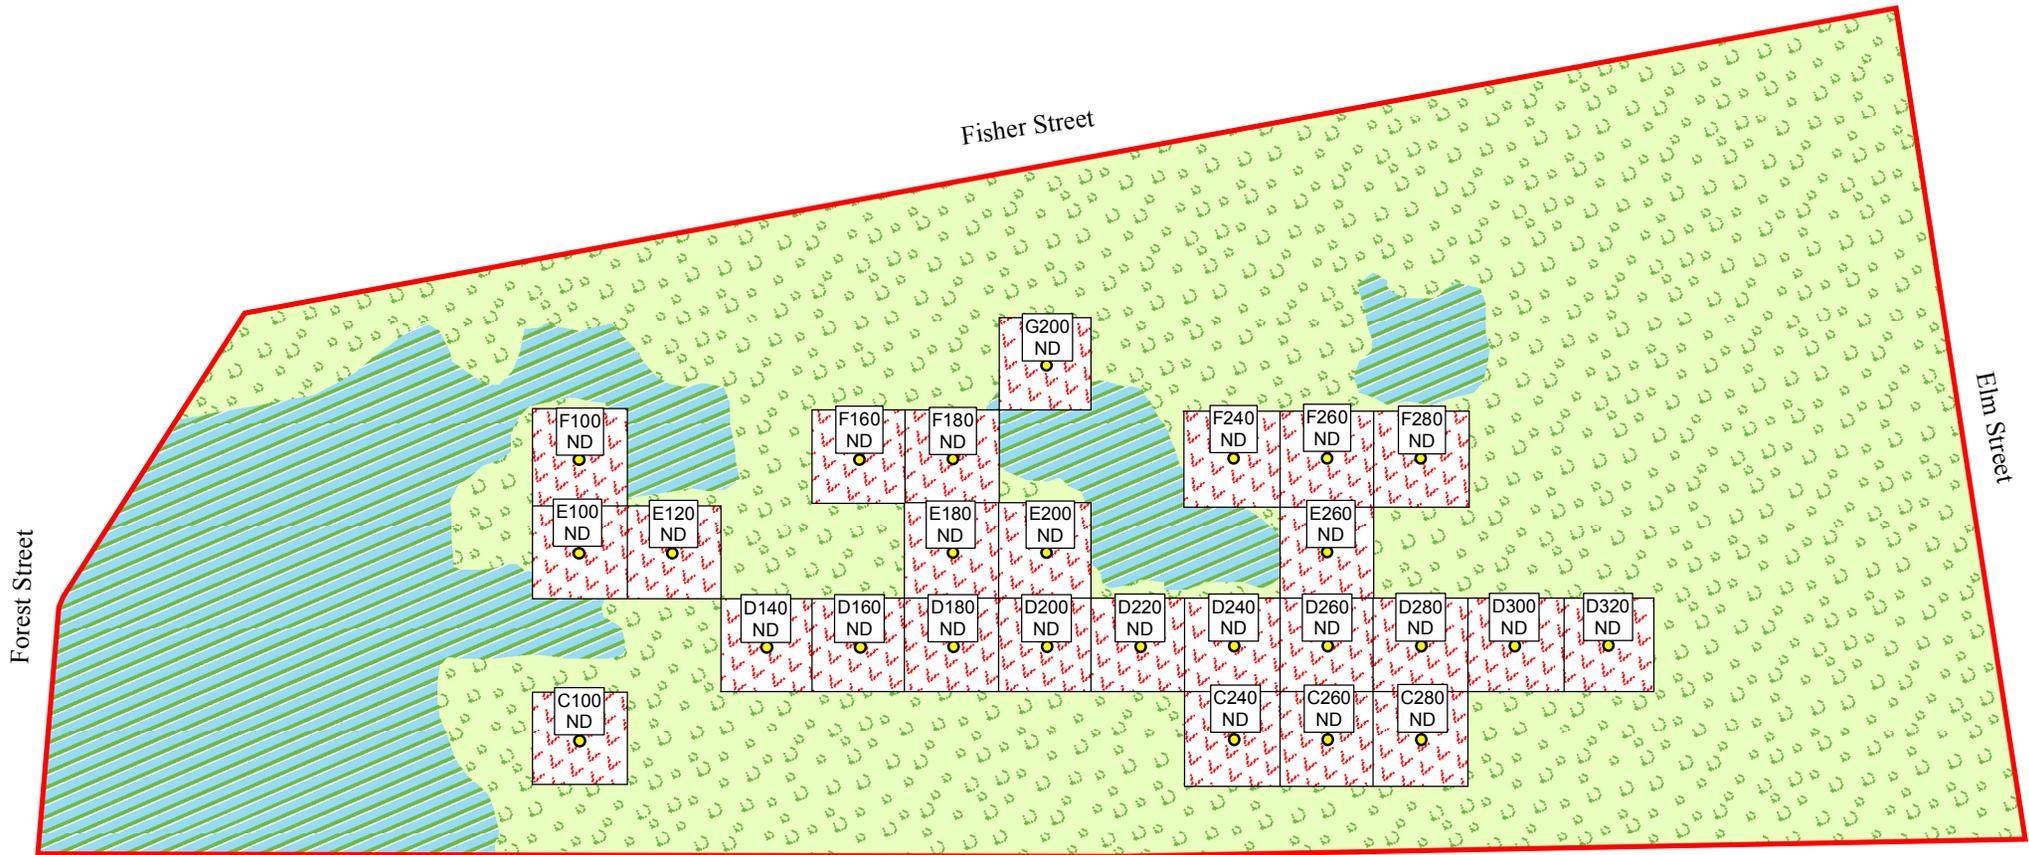

Not To Scale

EXCAVATION DIAGRAM

BALDWINVILLE RESIDENTIAL PROPERTIES
R-089
BALDWINVILLE, MASSACHUSETTS

Legend

- Sample Location
- ▭ Property Boundary
- ▨ Wetlands
- ▨ Wooded Area
- Excavation**
- ▭ 1 Foot

ND = Non-Detect




REGION I SUPERFUND TECHNICAL ASSESSMENT AND RESPONSE TEAM

DD NUMBER: 05-07-0013	CREATED BY: D. MUZRALL	CREATED ON: 8/28/2006
--------------------------	---------------------------	--------------------------

FILE LOCATION: E:\MA_GIS\BRP_Phase4\MXDsl R089_Tabloid.MXD	FIGURE 3
--	----------

Reported results are for AROCLOR 1254
and are reported in mg/kg.
mg/kg = parts per million (PPM).

Mason Street

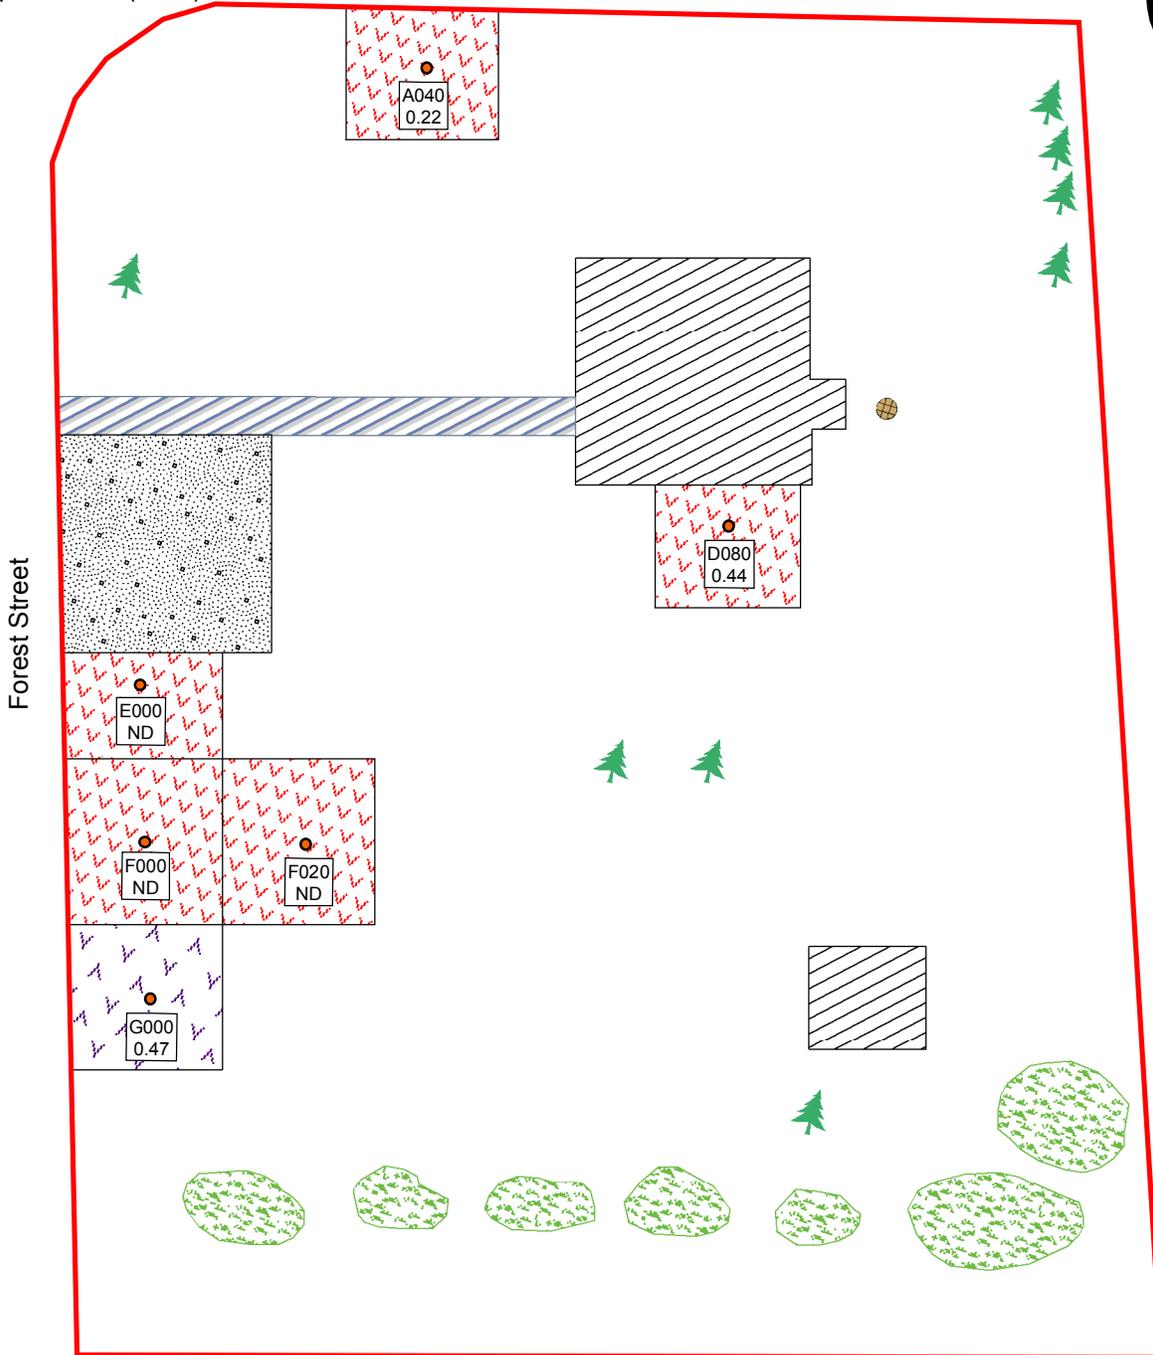


Not To Scale

Legend

- Sample Location
- ▭ Property Boundary
- 🌲 Trees
- 🌿 Bushes
- ▭ Gravel Driveway
- ▭ Paved Walkway
- 🌐 Well/Septic Cover
- ▭ Building
- Excavation**
- ▭ 1 Foot
- ▭ 1.5 Feet

ND = Non-Detect

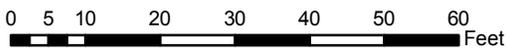

EXCAVATION DIAGRAM

BALDWINVILLE RESIDENTIAL PROPERTIES
R-122
BALDWINVILLE, MASSACHUSETTS




REGION I SUPERFUND TECHNICAL ASSESSMENT AND RESPONSE TEAM

TDD NUMBER: 05-07-0013	CREATED BY: B. MAHANY	CREATED ON: 12/26/2006
---------------------------	--------------------------	---------------------------

FILE LOCATION: E:\MA_GIS\BRP_Phase4\MXDs\R122_Removal.MXD	FIGURE 3
--	----------

Reported results are for AROCLOR 1254
and are reported in mg/kg.
mg/kg = parts per million (PPM).

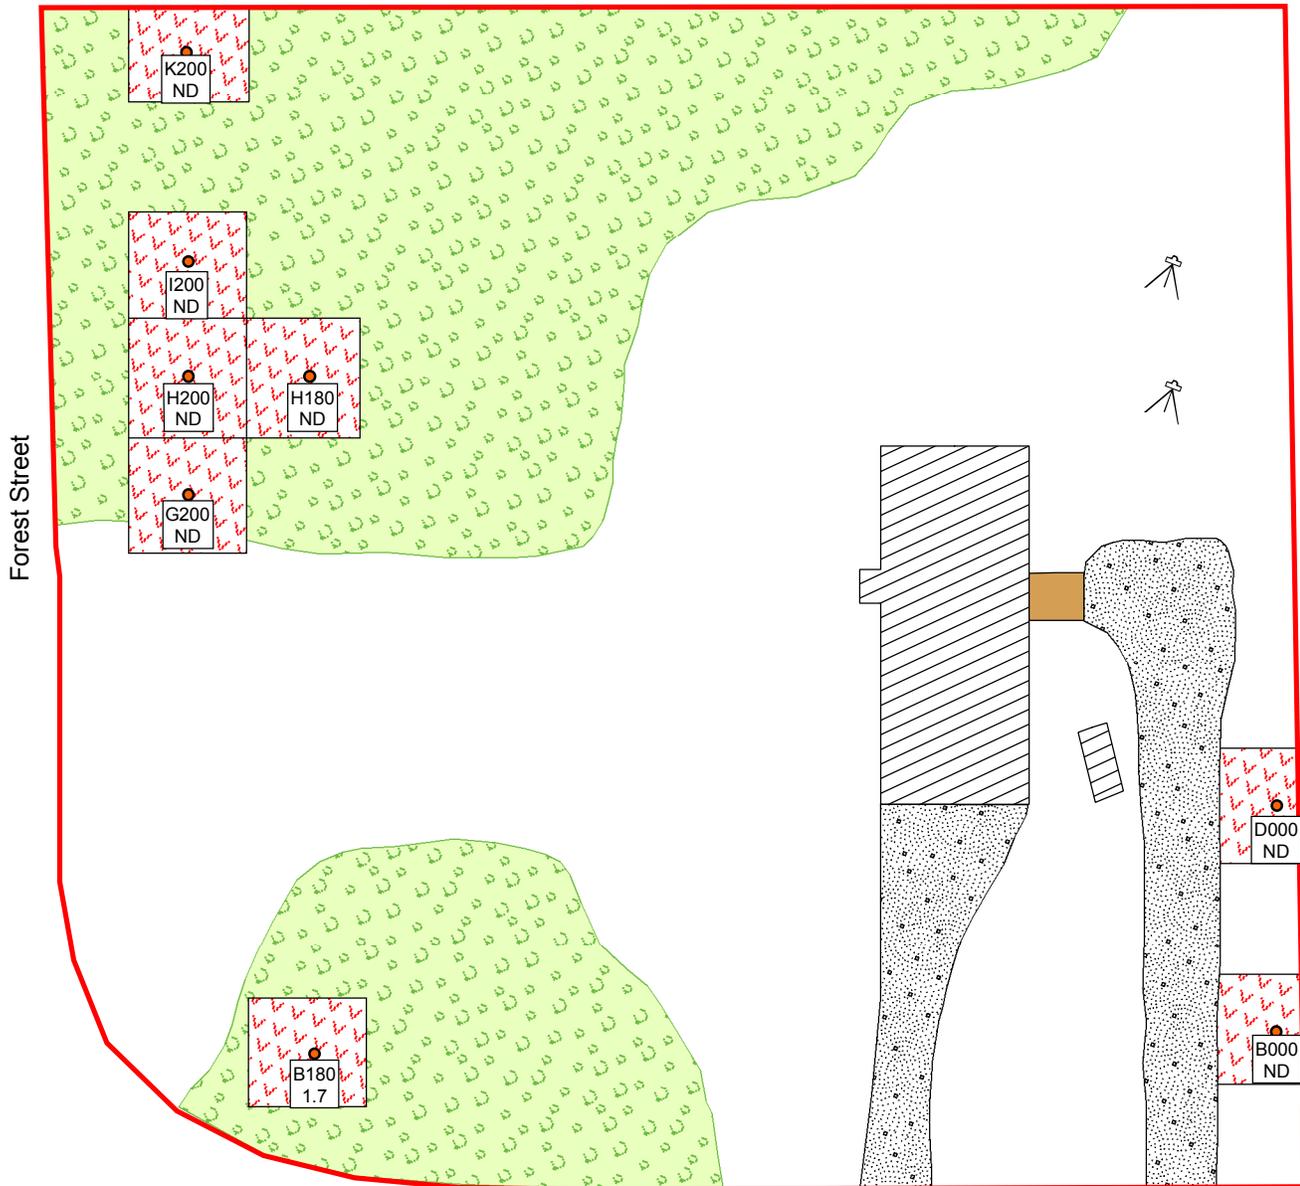

Mason Street

Not To Scale

Legend

ND = Non-Detect



- Sample Location
- Wood Deck
- Wooded Area
- ▭ Property Boundary
- Gravel Driveway
- Excavation
- ▨ Building
- ⊙ Swing Set
- ▨ 1 Foot

EXCAVATION DIAGRAM


BALDWINVILLE RESIDENTIAL PROPERTIES
R-123
BALDWINVILLE, MASSACHUSETTS



REGION I SUPERFUND TECHNICAL ASSESSMENT AND RESPONSE TEAM

TDD NUMBER: 05-07-0013	CREATED BY: B. MAHANY	CREATED ON: 12/26/2006
FILE LOCATION: E:\MA_GIS\BRP_Phase4\MXDslR123_Removal.MXD		FIGURE 3


Reported results are for AROCLOR 1254
and are reported in mg/kg.
mg/kg = parts per million (PPM).

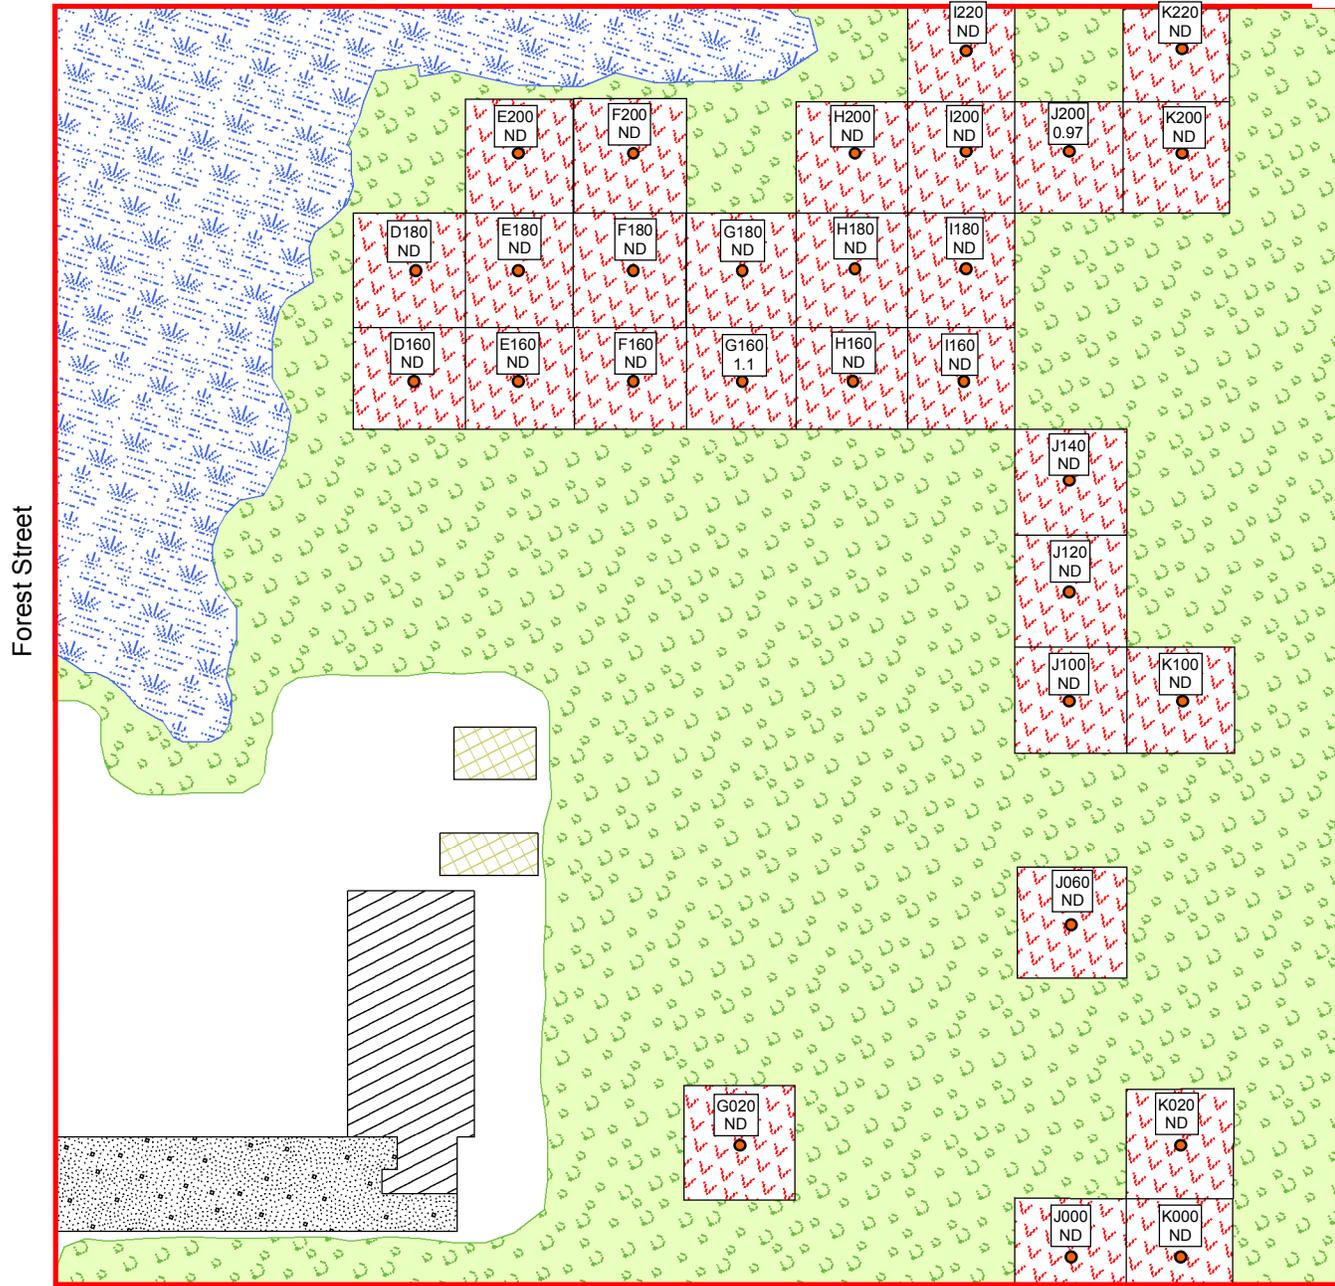

Not To Scale

Legend

ND = Non-Detect

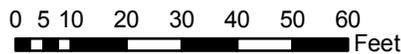

- Sample Location
- ▨ Buildings
- ▩ Trailers
- ▭ Property Boundary
- ▨ Wetland
- ▨ Excavation
- ▨ Gravel Driveway
- ▨ Wooded Area
- ▨ 1 Foot

EXCAVATION DIAGRAM

BALDWINVILLE RESIDENTIAL PROPERTIES
R-145
BALDWINVILLE, MASSACHUSETTS



REGION I SUPERFUND TECHNICAL ASSESSMENT AND RESPONSE TEAM

TDD NUMBER: 05-07-0013	CREATED BY: B. MAHANY	CREATED ON: 12/28/2006
FILE LOCATION: E:\WA_GIS\BRP_Phase4_\MXDs\R145_Removal.MXD		FIGURE 3

Appendix E

Waste Disposal Summary Table (Table 1)

Table 1
Waste Disposal Summary Table
Baldwinville Residential Properties Removal Action
Baldwinville, Massachusetts

Phase	Wastestream	Start Date	End Date	Total Weight (tons)	Total No. of Loads
I	Non-hazardous PCB Soil	10/19/2004	2/4/2005	8450.98	227
	PCB-contaminated Debris	2/7/2005	2/9/2005	102.9	6
II	Hazardous PCB-contaminated Soil	6/16/2005	6/16/2005	101.97	3
	Non-hazardous PCB-contaminated Soil	6/9/2005	10/12/2005	5120.41	141
	Non-hazardous PCB-contaminated Tree Stumps	10/5/2005	10/10/2005	164.32	11
III	Non-hazardous PCB-contaminated Soil	6/6/2006	6/12/2006	334.56	10
IV	Hazardous PCB-contaminated Soil	8/11/2006	8/11/2006	85.03	3
	Non-hazardous PCB-contaminated Soil	6/13/2006	11/6/2006	2260.7	65
	PCB-contaminated Tree Stumps	8/14/2006	11/7/2006	250.3	19
Total				16871.17	485

PCB = Polychlorinated Biphenyl
 No. = Number

Appendix F

Baldwinville Residential Properties Table (Table 2)

**Table 2
Baldwinville Residential Properties Table**

Property ID	PA/SI Sample Date	Excavation Start Date	Excavation Complete	Loam & Backfill Complete	Seeding Complete	Shrubbery & Tree Installation Complete	Pre-Excavation PCB Average (ppm)	Pre-Excavation PCB Maximum (ppm)	Post-Excavation PCB Average (ppm)	Post-Excavation PCB		No. of Grids Planned to Excavate	No. of Grids Accessed for Removal	No. of Grids Actually Excavated	Total No. of Samples (Removal)	Volume Excavated (yd ³)
										Maximum (ppm)	Sample Location					
R-003	7/9/2003	11/11/2004	11/16/2004	4/15/2005	5/18/2005	9/29/2005	6.82	20	1.24	5.9	C090	6	7	8	23	266.7
R-004/R-005	7/17/2003	11/16/2004	11/23/2004	4/15/2005	5/18/2005	No S/T	11.78	34	1.48	8.9	C090	9	10	10	24	333.3
R-006	7/9/2003	11/16/2004	11/23/2004	4/15/2005	5/18/2005	9/29/2005	6.38	11	1.42	6.5	B030	9	9	9	27	299.7
R-007	7/10/2003	11/23/2004	12/7/2004	4/15/2005	5/18/2005	9/29/2005	12.44	19	1.33	7.7	B000	13	13	13	33	433.4
R-008 *	7/10/2003	10/17/2006	10/20/2006	10/24/2006	10/26/2006	6/13/2007	4.37	14	1.78	3	D090	4	4	3.67	17	122.3
R-009	7/16/2003	11/29/2004	12/3/2004	4/15/2005	5/18/2005	9/29/2005	8.09	19	1.77	9	C090	6	6	7.33	16	244.4
R-010	7/15/2003	12/3/2004	12/7/2004	4/15/2005	5/18/2005	9/29/2005	4.49	18	1.65	6.4	C090	5	6	6	15	200
R-011	6/10/2003	8/19/2004	9/1/2004	4/19/2005	5/18/2005	9/29/2005	18.82	31	0.2	9.3	C150WW1A	16	18	16.6	30	553.4
R-012	6/26/2003	10/11/2004	10/19/2004	4/19/2005	5/10/2005	No S/T	29.1	69	0.52	5.2	B060	9	11	9	35	300
R-013	7/7/2003	10/11/2004	11/2/2004	4/19/2005	5/10/2005	10/5/2005	14.12	34.3	1.38	8.9	B090	8	10	10.5	20	350
R-014	6/9/2003	8/20/2004	8/31/2004	4/19/2005	5/4/2005	6/7/2006	18.7	49	0.7	8.6	D060	12	12	12	33	400
R-015/R-016	6/9/2003	9/2/2004	9/24/2004	4/18/2005	5/4/2005	9/29/2005	8.46	33	0.96	7.7	C090	10	17	14.2	34	472.3
R-019	6/10/2003	1/4/2005	1/4/2005	5/4/2005	5/18/2005	9/29/2005	1.99	9.9	1.46	2.9	A'060	1	2	1.33	10	44.5
R-020	6/25/2003	12/21/2004	1/10/2005	5/4/2005	5/18/2005	10/5/2005	8.62	19	1.53	7.2	B180	9	9	9	33	300
R-021	6/24/2003	1/5/2005	1/12/2005	5/4/2005	5/18/2005	9/29/2005	2.56	5.1	1.66	5.1	C090	2	7	3.7	31	522
R-022	6/26/2003		4/15/2005	2.98			8.1	2.9		B060	2	2.5		83.3		
R-028	6/24/2003	9/3/2004	12/16/2004	4/26/2005	5/4/2005	10/5/2005	14.92	41	1.54	6.4	E120	9	14	11.3	37	377.9
R-029	6/11/2003	9/9/2004	9/20/2004	4/19/2005	5/4/2005	10/5/2005	12.51	26	0.85	7.9	A060	12	16	15.43	35	514.3
R-030	6/23/2003	8/12/2005	8/23/2005	9/2/2005	9/6/2005	7/26/2006	3.78	11	1.59	5.3	A030	4	4	4	13	133.33
R-032	6/26/2003	10/7/2004	10/12/2004	4/19/2005	5/10/2005	9/29/2005	8.95	42	1.36	3.8	S001	5	5	5	16	166.7
R-033	7/1/2003	9/27/2004	10/5/2004	4/19/2004	5/10/2005	9/29/2005	17.84	68	0.1	1.2	C030	12	11	12	16	400
R-034	7/8/2003	8/27/2004	9/7/2004	4/19/2005	5/4/2005	9/29/2005	8.07	27	1.84	7.4	D120	5	6	6	20	200
R-035	7/15/2003	9/7/2004	9/15/2004	10/25/2004	5/10/2005	9/29/2005	10.83	20	1.19	8.2	C030	13	14	14	29	466.6
R-036	7/22/2003	9/16/2004	9/23/2004	10/25/2004	5/10/2005	9/29/2005	11.15	27	1.54	7.9	C060	10	12	10.5	35	350
R-037	7/22/2003	9/24/2004	10/8/2004	10/25/2004	5/10/2005	9/29/2005	7.63	16	1.3	7.1	C060	8	9	8.8	51	294.4
R-039	7/1/2003	10/5/2004	11/12/2004	11/30/2004	5/10/2005	9/29/2005	8.79	21	1.42	8.7	J120	7	21	16.8	79	560
R-041	7/7/2003	11/4/2004	12/16/2004	4/15/2005	5/10/2005	9/29/2005	5.34	25	1.54	6.5	A000	2	2	2	8	66.66
R-043	7/8/2003	11/9/2004	11/10/2004	11/24/2004	5/10/2005	9/29/2005	2.42	4.9	1.59	4.3	D030	2	2	2.5	6	83.3
R-047	7/14/2003	12/8/2004	12/8/2004	4/15/2005	5/18/2005	No S/T	2.2	14	1.59	5.6	B030	1	1	1	5	33.3
R-060	12/8/2004	4/27/2005	5/10/2005	5/18/2005	6/22/2005	No S/T	8.3	27	1.65	8	G060	19	20	20	79	296
R-061	10/19/2006	10/30/2006	11/2/2006	11/6/2006	11/10/2006	6/7/2007	2.9	9.8	1.68	5.9	B080	10	12	11.16	29	165.2
R-062	10/18/2004	4/21/2005	4/27/2005	5/4/2005	5/18/2005	No S/T	2.4	10.9	1.72	6.3	B160	5	11	8.25	33	122.2
R-063	10/13/2004	5/23/2005	6/7/2005	6/7/2005	6/22/2005	7/26/2006	6.4	26.3	1.65	4.7	D020A	11	12	11	24	162.8
R-064	10/13/2004	5/18/2005	6/6/2005	6/7/2005	6/22/2005	No S/T	4.5	18	1.8	7.7	I140	27	31	29.5	83	437
R-065	11/4/2004	5/5/2005	5/6/2005	5/10/2005	5/18/2005	No S/T	2.1	8.9	1.4	3.3	AE000	1	1	1	9	14.8
R-066	10/12/2004	5/11/2005	5/20/2005	6/1/2005	6/22/2005	7/26/2006	4.4	14.7	1.71	8.2	J180	18	20	20	58	296
R-067	10/12/2004	4/21/2005	4/28/2005	5/5/2005	5/10/2005	No S/T	4.8	14	1.71	5.6	D020	15	16	16	45	236.8
R-068	10/11/2004	5/9/2005	5/10/2005	5/12/2005	5/18/2005	7/26/2006	2.2	10.6	1.66	5.2	F080	2	2	2	10	29.6
R-069	10/11/2004	4/28/2005	5/4/2005	5/5/2005	5/19/2005	7/26/2006	4.6	17.6	1.72	4.9	F040	13	14	14	50	207.2

ID = Identification.

PA/SI = Preliminary Assessment/Site Investigation.

No S/T = No shrubbery/tree installation required.

PCB = Polychlorinated Biphenyl (Aroclor 1254).

* PA/SI activities were conducted on Property R-008 during the Phase 1 PA/SI. Removal activities were conducted on Property R-008 during the Phase 4 Removal Action.

Numbers were compiled based on information obtained from the U.S. Environmental Protection Agency On-Scene Coordinator.

ppm = parts per million.

No. = Number.

yd³ = Cubic Yards.

**Table 2
Baldwinville Residential Properties Table**

Property ID	PA/SI Sample Date	Excavation Start Date	Excavation Complete	Loam & Backfill Complete	Seeding Complete	Shrubbery & Tree Installation Complete	Pre-Excavation PCB Average (ppm)	Pre-Excavation PCB Maximum (ppm)	Post-Excavation PCB Average (ppm)	Post-Excavation PCB		No. of Grids Planned to Excavate	No. of Grids Accessed for Removal	No. of Grids Actually Excavated	Total No. of Samples (Removal)	Volume Excavated (yd ³)
										Maximum (ppm)	Sample Location					
R-070	10/11/2004	5/16/2005	5/16/2005	5/18/2005	6/22/2005	7/26/2006	2.1	11	1.72	3.1	A000	2	2	2	7	29.6
R-071	10/14/2004	5/11/2005	5/16/2005	5/23/2005	6/22/2005	7/26/2006	4	25.6	1.82	5.7	G040	8	8	8	23	118.4
R-073	10/18/2004	6/3/2005	6/20/2005	6/30/2005	7/29/2005	7/26/2006	4.2	12.2	1.26	6.8	D060	7	11	11.75	26	173.9
R-076	10/19/2004	6/7/2005	6/7/2005	6/17/2005	7/29/2005	No S/T	2.1	6	1.32	5.3	C000	1	2	2	7	29
R-077	10/19/2004	6/9/2005	6/10/2005	6/20/2005	No Seeding	No S/T	2	4.2	1.64	3.4	D060	1	3	2.5	16	37
R-078	10/20/2004	6/21/2005	6/28/2005	7/7/2005	7/29/2005	No S/T	3.1	13.1	1.69	6.6	D020	7	13	11.5	42	170
R-079	10/25/2004	6/8/2005	6/20/2005	6/24/2005	7/29/2005	No S/T	2.6	17	1.75	7.6	S000	17	18	18	70	266.4
R-080	10/26/2004	6/21/2005	6/22/2005	7/8/2005	7/29/2005	No S/T	3.6	18	1.63	6	H060	5	6	6	25	88.8
R-081	10/20/2004	6/23/2005	6/30/2005	7/13/2005	7/29/2005	No S/T	4.1	10.3	1.56	5.8	F080	14	15	16	54	236.8
R-082	10/20/2004	7/6/2005	7/13/2005	7/20/2005	7/29/2005	7/26/2006	7.9	83	1.66	8.7	D020	15	16	16	51	236.8
R-083A **	10/28/2004	7/12/2005	8/11/2005	8/24/2005	9/21/2005	7/26/2006	15.8	110	1.75	8.9	M100	67	70	68	171	1006
R-083B **	6/14/2006	7/31/2006	8/17/2006	9/11/2006	9/11/2006	6/7/2007	6.49	42	1.85	7.7	A260	47	47	46.7	150	691.2
R-084	10/26/2004	7/7/2005	7/15/2005	7/25/2005	7/29/2005	7/26/2006	3.4	18	1.69	6.2	A040	6	7	7	22	103.6
R-085	10/21/2004	6/30/2005	7/6/2005	7/21/2005	7/29/2005	No S/T	2.9	15	1.52	7	A000	4	5	5	16	74
R-089	6/28/2006	9/13/2006	9/21/2006	9/28/2006	10/5/2006	10/5/2006	5.7	42.9	1.73	7.8	D340	24	26	26	80	384.8
R-090	10/19/2005	4/25/2006	4/26/2006	5/2/2006	5/3/2006	No S/T	2.79	4.9	0.8	4.9	B060	4	4	2.3	8	34
R-091	11/2/2005	5/11/2006	5/19/2006	6/30/2006	6/30/2006	9/15/2006	7.57	42.5	1.53	6.52	E000	10	13	12.5	25	185
R-092	11/2/2005	5/16/2006	5/22/2006	6/30/2006	6/30/2006	9/15/2006	3.11	7.92	1.55	7.92	C000	6	9	9	21	133.2
R-093	11/3/2005	5/23/2006	5/24/2006	6/30/2006	6/30/2006	9/15/2006	2.73	16.9	1.72	7.59	C060	5	5	5	16	74
R-102	10/25/2005	6/1/2006	6/2/2006	6/30/2006	6/30/2006	9/15/2006	2.03	2.55	1.61	2.35	A000	1	1	1	5	14.8
R-103	11/2/2005	5/25/2006	6/1/2006	6/30/2006	6/30/2006	9/15/2006	2.69	11.1	1.67	4.38	D000	6	7	7	17	103.6
R-108	11/1/2005	4/20/2006	4/24/2006	5/30/2006	5/30/2006	No S/T	2.64	15.59	1.78	4.88	D060	4	4	4	13	59.2
R-109	10/20/2005	6/7/2006	6/12/2006	6/30/2006	6/30/2006	9/15/2006	2.9	15	1.65	4.4	D080	6	7	7	19	103.9
R-111	10/19/2005	6/2/2006	6/6/2006	6/30/2006	6/30/2006	9/15/2006	2.39	10	1.68	6.2	G100	4	5	5	16	74
R-119	10/19/2005	4/27/2006	5/8/2006	5/30/2006	5/30/2006	9/15/2006	3.19	9.3	1.63	5	B060	6	8	8	20	118.4
R-120	10/18/2005	5/4/2006	5/9/2006	5/30/2006	5/30/2006	9/15/2006	2.25	6.4	1.75	4.4	I040	3	6	5.4	12	79.9
R-121	10/31/2005	5/9/2006	5/11/2006	5/30/2006	5/30/2006	9/15/2006	2.82	11.91	1.55	4.45	D000	2	3	3	10	44.44
R-122	4/17/2006	6/13/2006	6/16/2006	6/28/2006	6/29/2006	9/15/2006	2.44	9.8	1.06	5.92	C120	5	6	6	20	88.8
R-123	5/8/2006	6/19/2006	7/28/2006	8/9/2006	8/9/2006	6/7/2007	1.82	17	0.93	8.7	J180	8	8	8	30	118.4
R-145	5/9/2006	6/20/2006	7/20/2006	9/6/2006	9/8/2006	9/15/2006	8.46	90	1.13	8.19	I100	29	29	29	81	429.2

ID = Identification.

PA/SI = Preliminary Assessment/Site Investigation.

No S/T = No shrubbery/tree installation required.

PCB = Polychlorinated Biphenyl (Aroclor 1254).

** Both PA/SI and Removal Site activities were performed on Property R-083 during Phase 2 and Phase 4 of the project. The Table ID R-083A denotes the section of the property on which activities were conducted during the Phase 2 PA/SI and Phase 2 Removal. The ID R-083B denotes the section of the property on which activities were conducted during the Phase 4 PA/SI and Phase 4 Removal.

Numbers were compiled based on information obtained from the U.S. Environmental Protection Agency On-Scene Coordinator.

ppm = parts per million.

No. = Number.

yd³ = Cubic Yards.