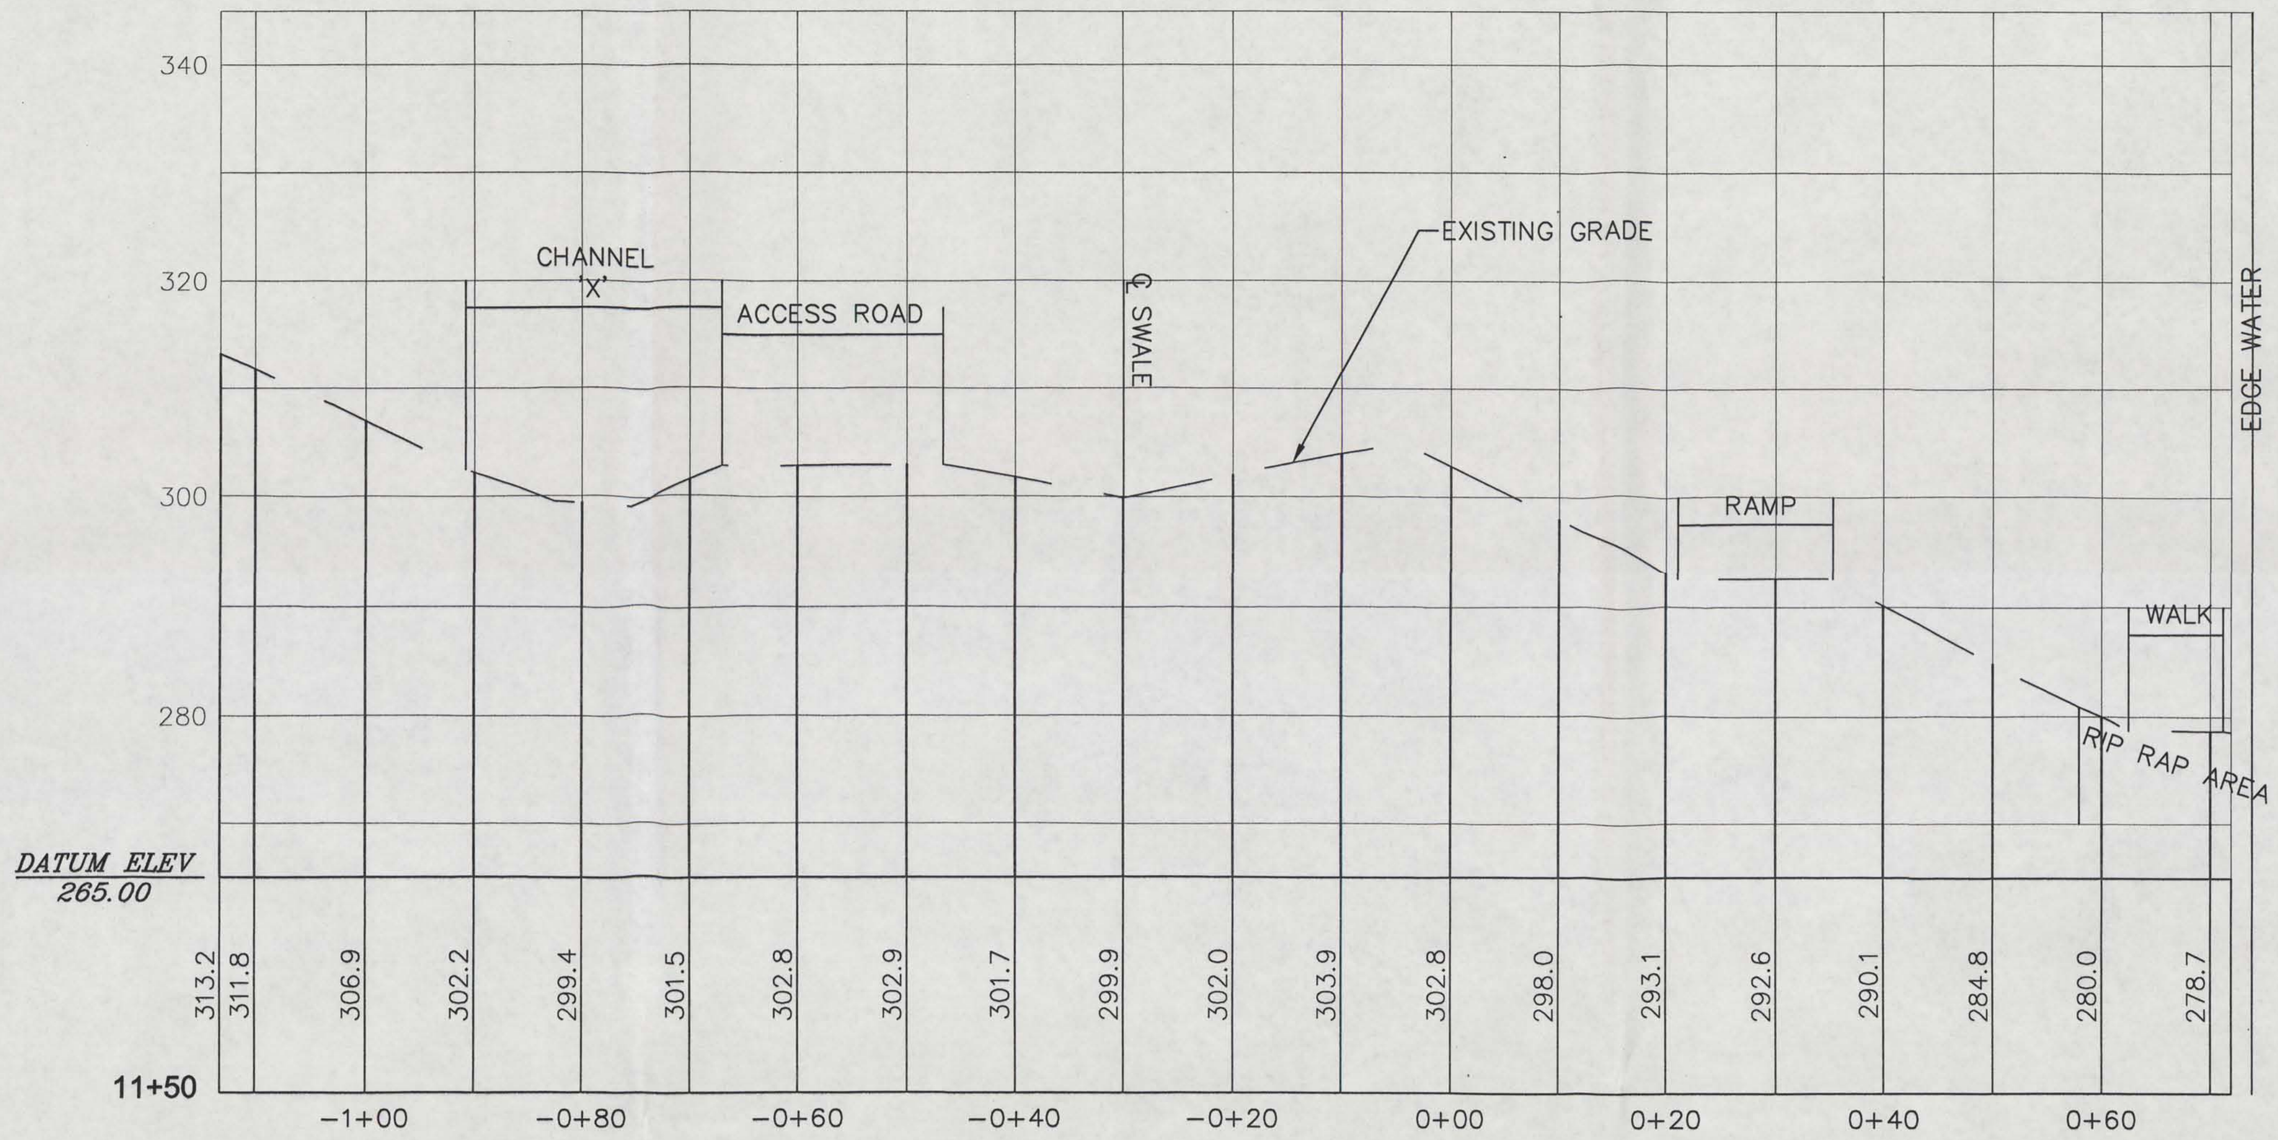

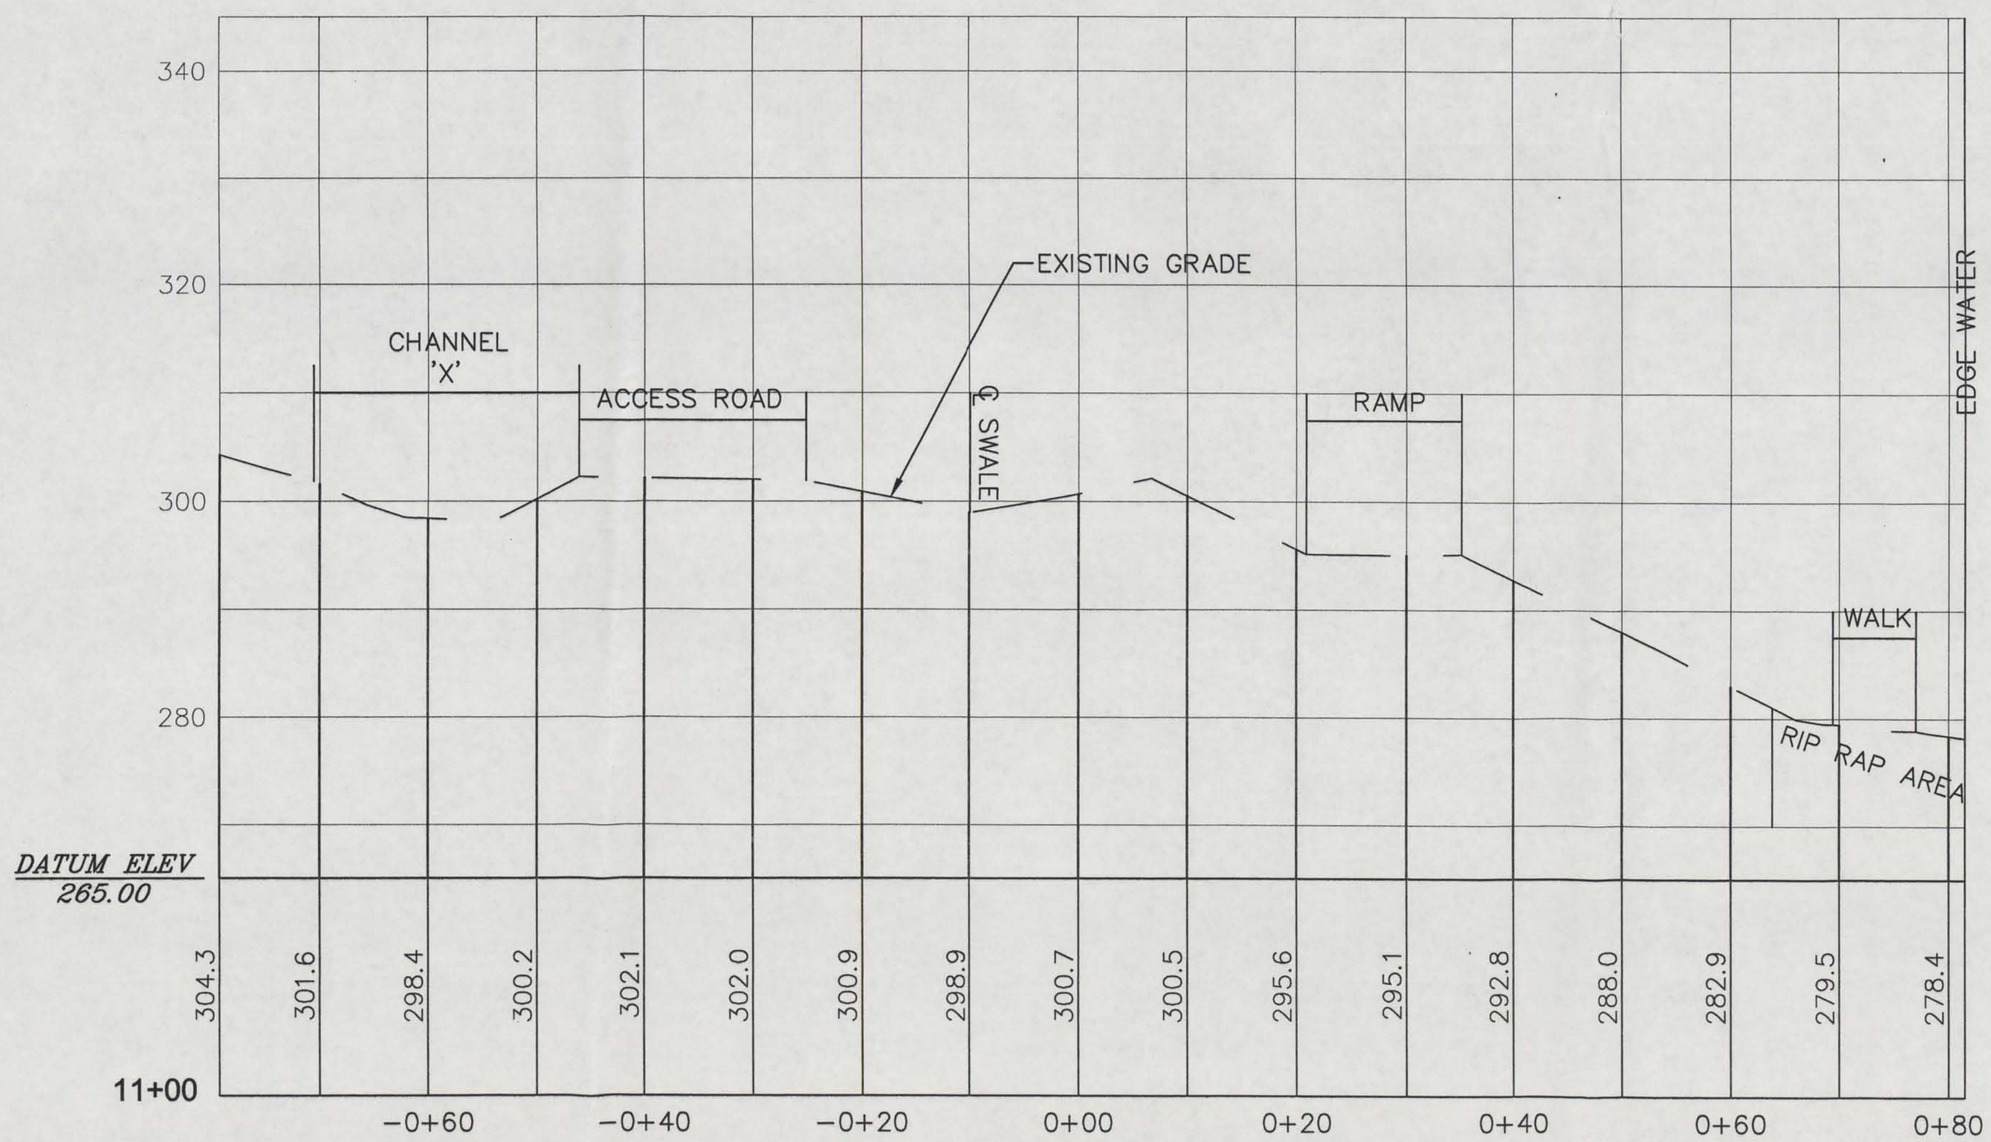

Utilities Disclaimer:
The underground utilities shown have been located from field survey information and existing drawings. The surveyor makes no guarantee that the underground utilities shown comprise all such utilities in the area either in service or abandoned. The surveyor further does not warrant that the underground utilities shown are in the exact location indicated although he does declare that they are located as accurately as possible from information available. The surveyor has not physically located the underground utilities.

REVISIONS TO THESE PLANS BY ANYONE OTHER THAN KJA SHALL MAKE THESE PLANS NULL AND VOID. KJA SHALL TAKE NO RESPONSIBILITY FOR SAID REVISIONS.

REVISION:
REVISION:
REVISION:
REVISION:
PROJECT: 202\CST\watertown-201382-chasebra
DRAWN BY:
SEAL:

SURVEY NOTES:
THIS MAP HAS BEEN PREPARED IN ACORDANCE WITH THE "MINIMUM STANDARDS FOR SURVEYS AND MAPS IN THE STATE OF CONNECTICUT" AS ADOPTED FOR USE BY THE REGULATIONS OF CONNECTICUT STATE AGENCIES ON SEPTEMBER 26, 1996. (CT SECTIONS 20-300b-1 TO 20-300b-20).

THE TYPE OF SURVEY PERFORMED IS AN: IMPROVEMENT LOCATION MAP.

BOUNDARY DETERMINATION IS BASED UPON: A DEPENDENT RESURVEY.

THIS SURVEY CONFORMS TO A: CLASS A-2 &T-2.

TO THE BEST OF MY KNOWLEDGE AND BELIEF THIS MAP IS SUBSTANTIALLY CORRECT AS NOTED HEREON.

James N. Sokonchick
CT P.E. & L.S. #11302

kratzert, jones & associates, inc.
CIVIL ENGINEERS • LAND SURVEYORS
SITE PLANNERS • BUILDING ENGINEERS
P.O. BOX 337
1755 MERIDEN-WATERBURY RD.
MILLDALE, CT 06467-0337
PHONE: (860) 621-3638
FAX: (860) 621-9609
EMAIL: KJA5@AOL.COM

AS-BUILT CROSS SECTIONS

for
Watertown Construction

CHASE BRASS AND COPPER SITE

WATERBURY, CT

SCALE: 1" = 10'
DATE: MAY 13, 2002

HALF | ONE INCH | TWO INCH
INCHES ON ORIGINAL

KJA FILE NO. : 201-382
DRAWING NO. : CS-6

K:\202\CST\watertown-201382-chasebrass\dwg\CROSS SECTIONS.dwg Mon May 13 11:55:09 2002