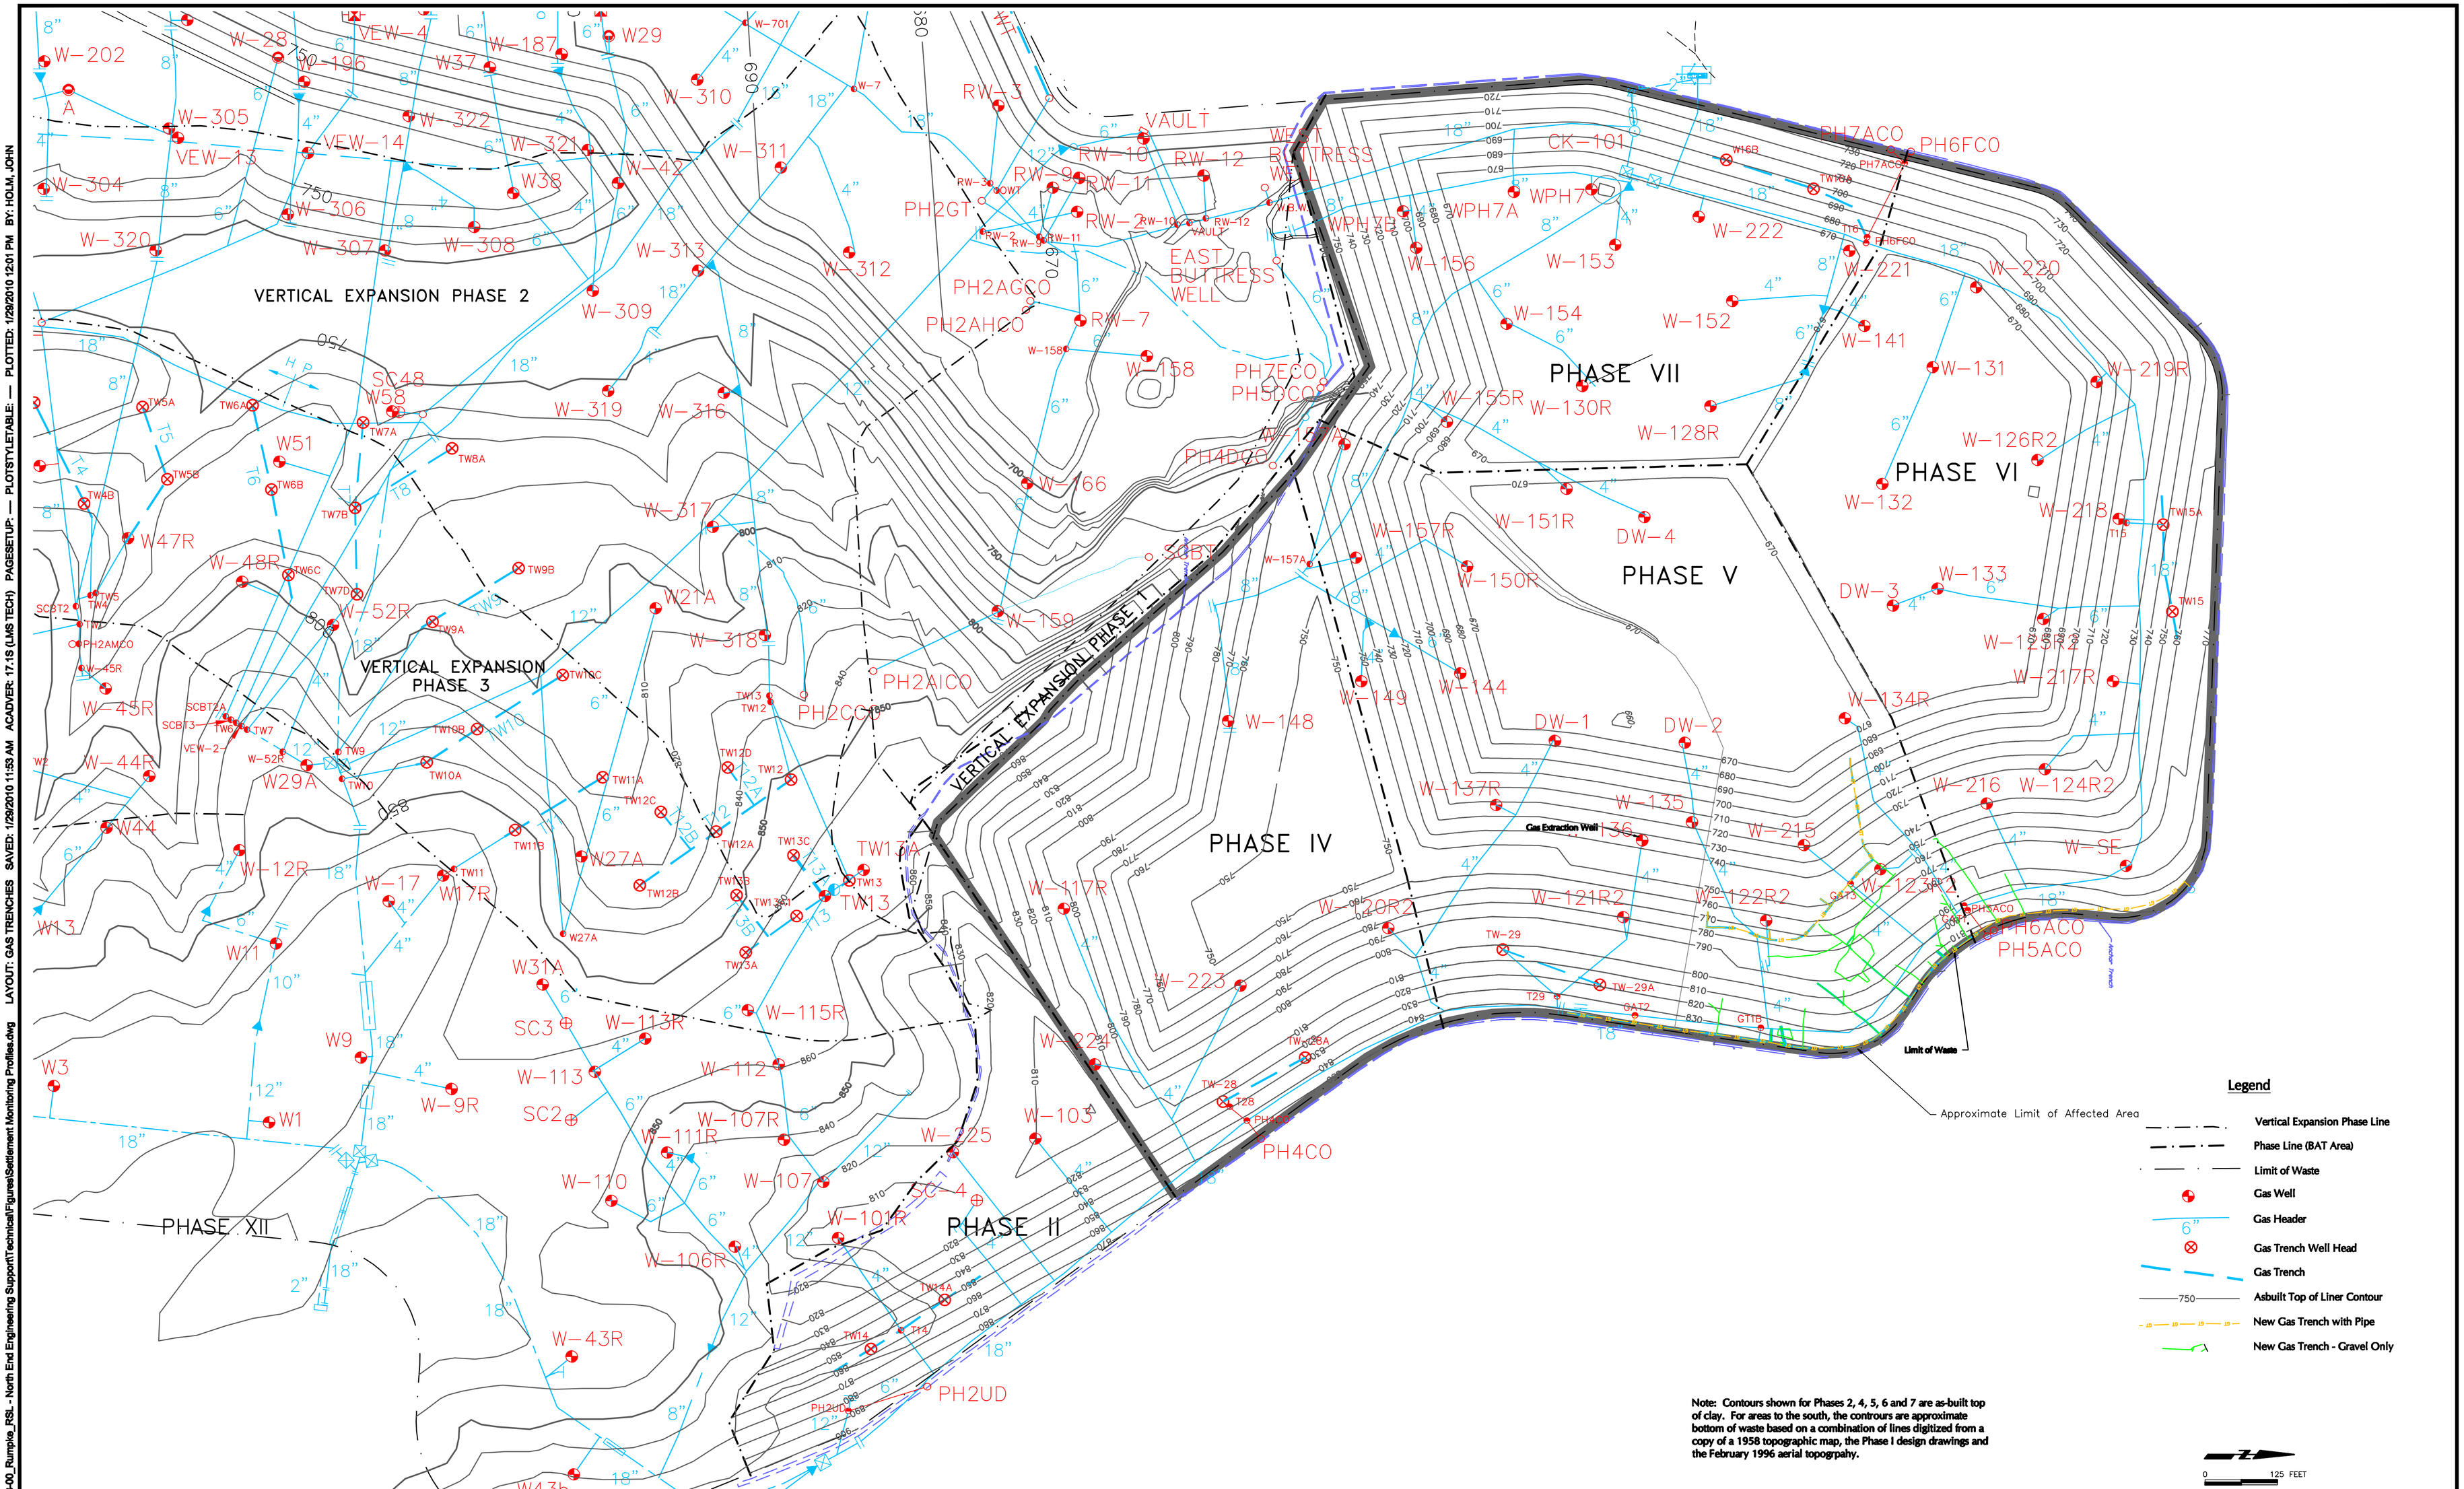

Note: Contours shown for Phases 2, 4, 5, 6 and 7 are as-built top of clay. For areas to the south, the contrours are approximate bottom of waste based on a combination of lines digitized from a copy of a 1958 topographic map, the Phase I design drawings and the February 1996 aerial topogrpahy.

G:\LFR\Projects\034-00158-00_Rumpke_RSL - North End Engineering Support\Technical\Figures\Settlement Monitoring Profiles.dwg, Gas Trenches, 1/28/2010 12:20:41 PM
G:\LFR\Projects\034-00158-00_Rumpke_RSL - North End Engineering Support\Technical\Figures\Settlement Monitoring Profiles.dwg LAYOUT: GAS TRENCHES SAVED: 1/28/2010 11:53 AM ACADVER: 17.1S (LMS TECH) PAGESETUP: ---- PLOTSTYLETABLE: ---- PLOTTED: 1/28/2010 12:01 PM BY: HOLM, JOHN

SCALE(S) AS INDICATED

THIS BAR REPRESENTS ONE INCH ON THE ORIGINAL DRAWING: USE TO VERIFY FIGURE REPRODUCTION SCALE

No.	Date	Revisions	By	Ckd

THIS DRAWING IS THE PROPERTY OF THE ARCADIS ENTITY IDENTIFIED IN THE TITLE BLOCK AND MAY NOT BE REPRODUCED OR ALTERED IN WHOLE OR IN PART WITHOUT THE EXPRESS WRITTEN PERMISSION OF SAME.

Professional Engineer's Name: JOHN HOLM
Professional Engineer's No.

State	Date Signed	Project Mgr.
		RJK
Designed by	Drawn by	Checked by
	MJH	JWH

ARCADIS
ARCADIS U.S., INC.

RUMPKE SANITARY LANDFILL • COLERAIN TWP., HAMILTON CO., OHIO

NEW GAS TRENCH ASBUILT AS OF 1-20-10
NORTH END ENGINEERING SUPPORT

ARCADIS Project No. HA100158.0000.00000
Date 1-15-2010

ARCADIS
4665 CORNELL ROAD
SUITE 350
CINCINNATI, OHIO 45241
TEL. 513.860.8700